



Room 120 411 West First Street Duluth, Minnesota 55802



Addendum #1 Bid 21-0293 Steam to Hot Water Building Conversion Phase 3, Group D (Wells Fargo Bldg)

This addendum serves to notify all bidders of the attached changes to the solicitation documents.

Please acknowledge receipt of this Addendum by checking the acknowledgment box within the www.bidexpress.com solicitation.

Posted: 4/9/21

Date of issuance: April 09, 2021

Duluth Energy Services Hot Water Conversion Wells Fargo Building

Addendum. One

TO: ALL PLAN HOLDERS

FROM: VAA, LLC

Project. No. 210057

SUBJECT: Revision to Mechanical Bid Set

.....

This Revision is to a Issued for Bid Package Document (IFB) and may apply to any or all Contracts and Subcontracts. Unless otherwise specified herein or shown on the attached drawings (if any), all work required by this Revision shall be in complete accordance with the IFB and subsequent Revisions thereto.

Please attach this Revision to your copy of the IFB package dated 3-30-2021.

1. LIST DOCUMENTS


- 1.1. Updates to Rev levels to originally issued Drawing MEC-000 Rev C dated 3-30-2021 is attached to this addendum.
- 1.2. Changes to originally issued Drawing MEC-100 Rev C dated 3-30-2021 is attached to this addendum to provide clarification for the replacement of the steam coils serving existing air handling unit A.C. Unit No. 1.
- 1.3. Corrections to originally issued Drawing MEC-200 Rev C dated 3-30-2021 is attached to this addendum and indicates corrected size of steam lines serving stair tower heaters.
- 1.4. Corrections to originally issued Drawing MEC-210 Rev C dated 3-30-2021 is attached to this addendum and indicates addition of tie point TP-32.

End of Addendum

DULUTH ENERGY SYSTEMS HOT WATER CONVERSION WELLS FARGO BUILDING

DULUTH, MINNESOTA



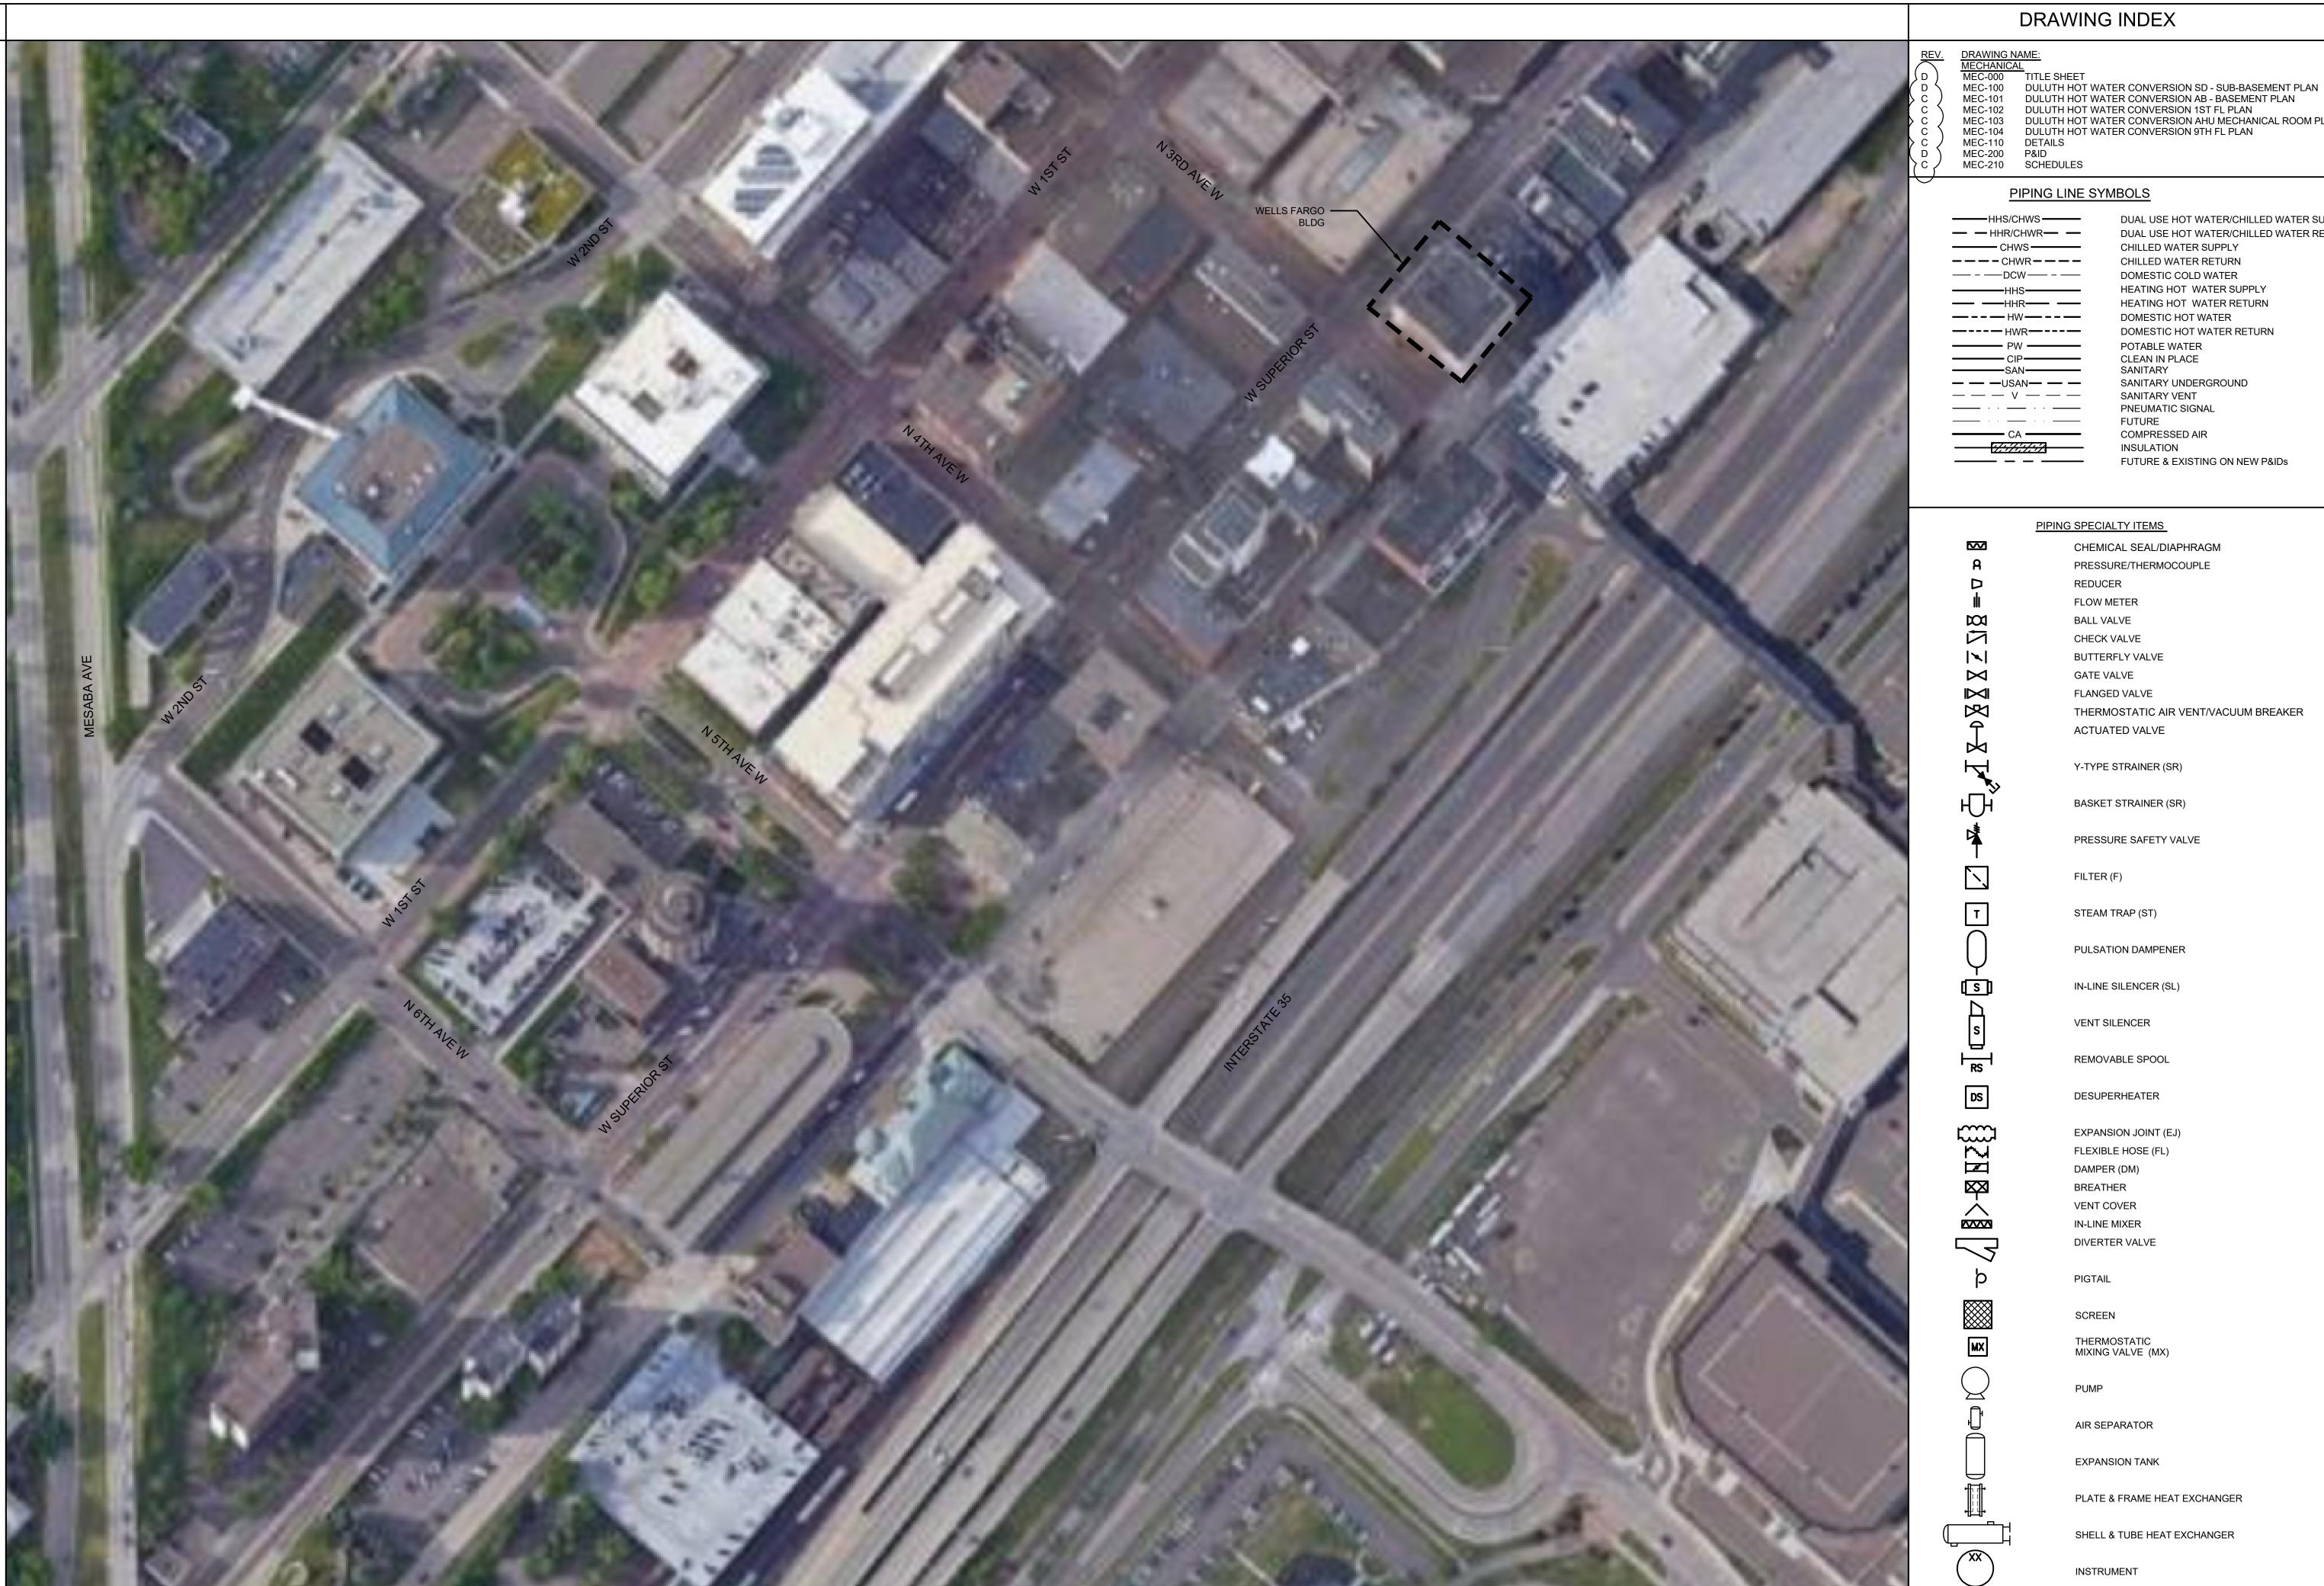



PIPING LINE SYMBOLS

DULUTH HOT WATER CONVERSION AB - BASEMENT PLAN

CHILLED WATER SUPPLY

CHILLED WATER RETURN

DOMESTIC HOT WATER

SANITARY UNDERGROUND

POTABLE WATER

CLEAN IN PLACE

SANITARY VENT

CHEMICAL SEAL/DIAPHRAGM

PRESSURE/THERMOCOUPLE

PIPING SPECIALTY ITEMS

REDUCER

FLOW METER

BALL VALVE

PNEUMATIC SIGNAL

HEATING HOT WATER SUPPLY

HEATING HOT WATER RETURN

DOMESTIC HOT WATER RETURN

FUTURE & EXISTING ON NEW P&IDs

DUAL USE HOT WATER/CHILLED WATER SUPPLY

DUAL USE HOT WATER/CHILLED WATER RETURN

DULUTH ENERGY

CLIENT PROJECT NO:

PROJECT:

DULUTH HOT WATER CONVERSION

2300 Berkshire Lane N, Suite 200 www.vaaeng.com

Plymouth, MN 55441

WA Firm Registration No. 3035

NOTICE: THE DESIGN SHOWN AND DESCRIBED HERE
DRAWINGS, DETAILS, DEVELOPMENTS, GRAPHICS AN
EXCLUSIVE PROPERTY OF VAA, LLC, AND CAN'T BE C
OR COMMERCIALLY EXPLOITED. IN WHOLE OR IN P

	CHECK VALVE
 ∞	BUTTERFLY VALVE
\bowtie	GATE VALVE
	FLANGED VALVE
	THERMOSTATIC AIR VENT/VACUUM BREAKER
T	ACTUATED VALVE
\bowtie	
H.,	Y-TYPE STRAINER (SR)
Ψ̈́,	BASKET STRAINER (SR)
	PRESSURE SAFETY VALVE
	FILTER (F)
Ţ	STEAM TRAP (ST)
Q	PULSATION DAMPENER
[S]	IN-LINE SILENCER (SL)
s	VENT SILENCER
RS	REMOVABLE SPOOL
DS	DESUPERHEATER
[EXPANSION JOINT (EJ)
M	FLEXIBLE HOSE (FL)
	DAMPER (DM)
\boxtimes	BREATHER
	VENT COVER
	IN-LINE MIXER
\Box	DIVERTER VALVE
þ	PIGTAIL
	SCREEN
MX	THERMOSTATIC MIXING VALVE (MX)
	PUMP
	AIR SEPARATOR
	EXPANSION TANK
	PLATE & FRAME HEAT EXCHANGER
	SHELL & TUBE HEAT EXCHANGER
	INSTRUMENT
<u> </u>	CHILLER
FROM BLDG DHW HEATER	OFF PAGE CONNECTOR
	AREA OF DEMOTION

Α	03/08/2021	ISSUED FOR 60% REVIEW	WFD
В	03/11/2021	ISSUED FOR BID	WFD
С	03/30/2021	ISSUED FOR BID CLIENT CHANGES	WFD
D	04/09/2021	ISSUED FOR CLARIFICATIONS	WFD
			l
CERT	ΓΙΓΙCATION:		
i hei	eby certify that	this plan, specification, or report was prep	ared
L		direct supervision and that I am a duly lice	

NO DATE ISSUE/REVISION

DETAILS, DEVELOPMENTS, GRAPHICS AND MODELS THEREOF, ARE THE EXCLUSIVE PROPERTY OF AUTHORIZED IN WRITING BY VAA, LLC. COPYRIGHT VAA, LLC 2020 - ALL RIGHTS RESERVED

COFTRIGHT VAA, LLC 2020	ALL NIGHTS RESERV	ED.	
DATE: 03/30/21		DRAWN: DGJ	
DESIGNED:	CHECKE	D:	APPROVED:


DRAWING TITLE:


DULUTH HOT WATER CONVERSION SITE PLAN

PROJECT NO: 210057 MEC-000 SCALE: AS NOTED

WELLS FARGO HOT WATER CONVERSION SITE PLAN

MEC-000 SCALE: NONE

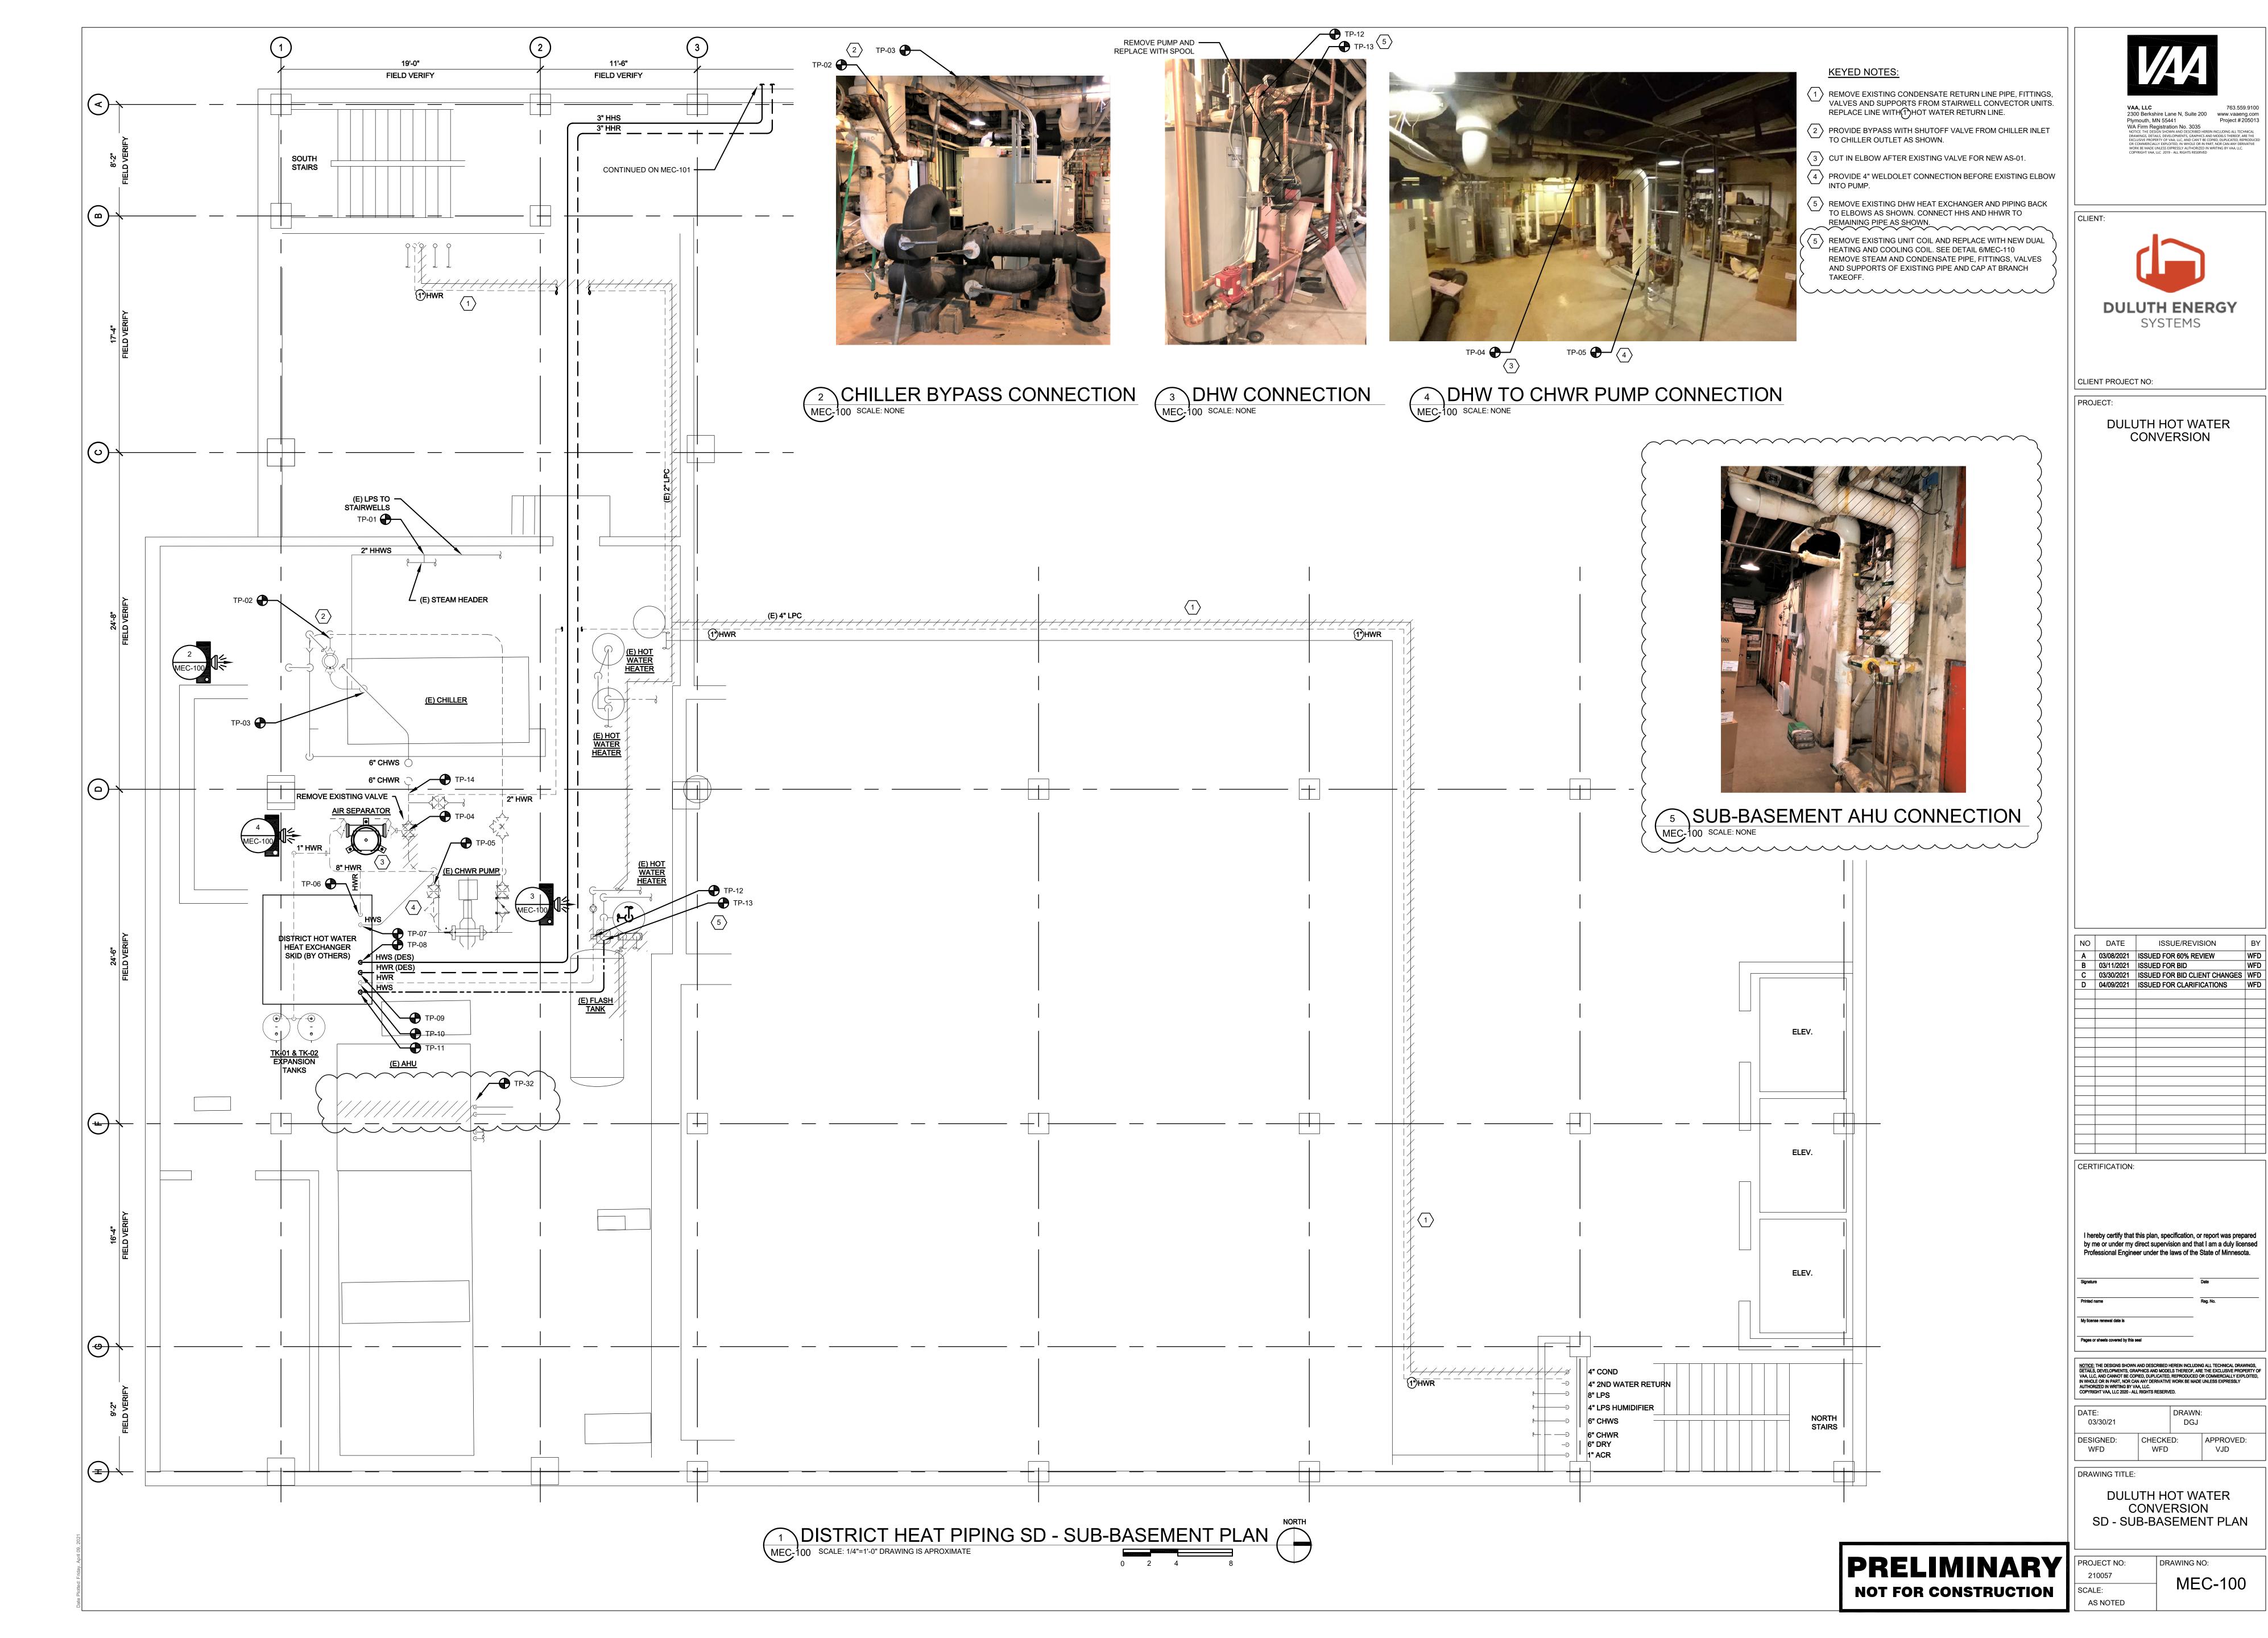

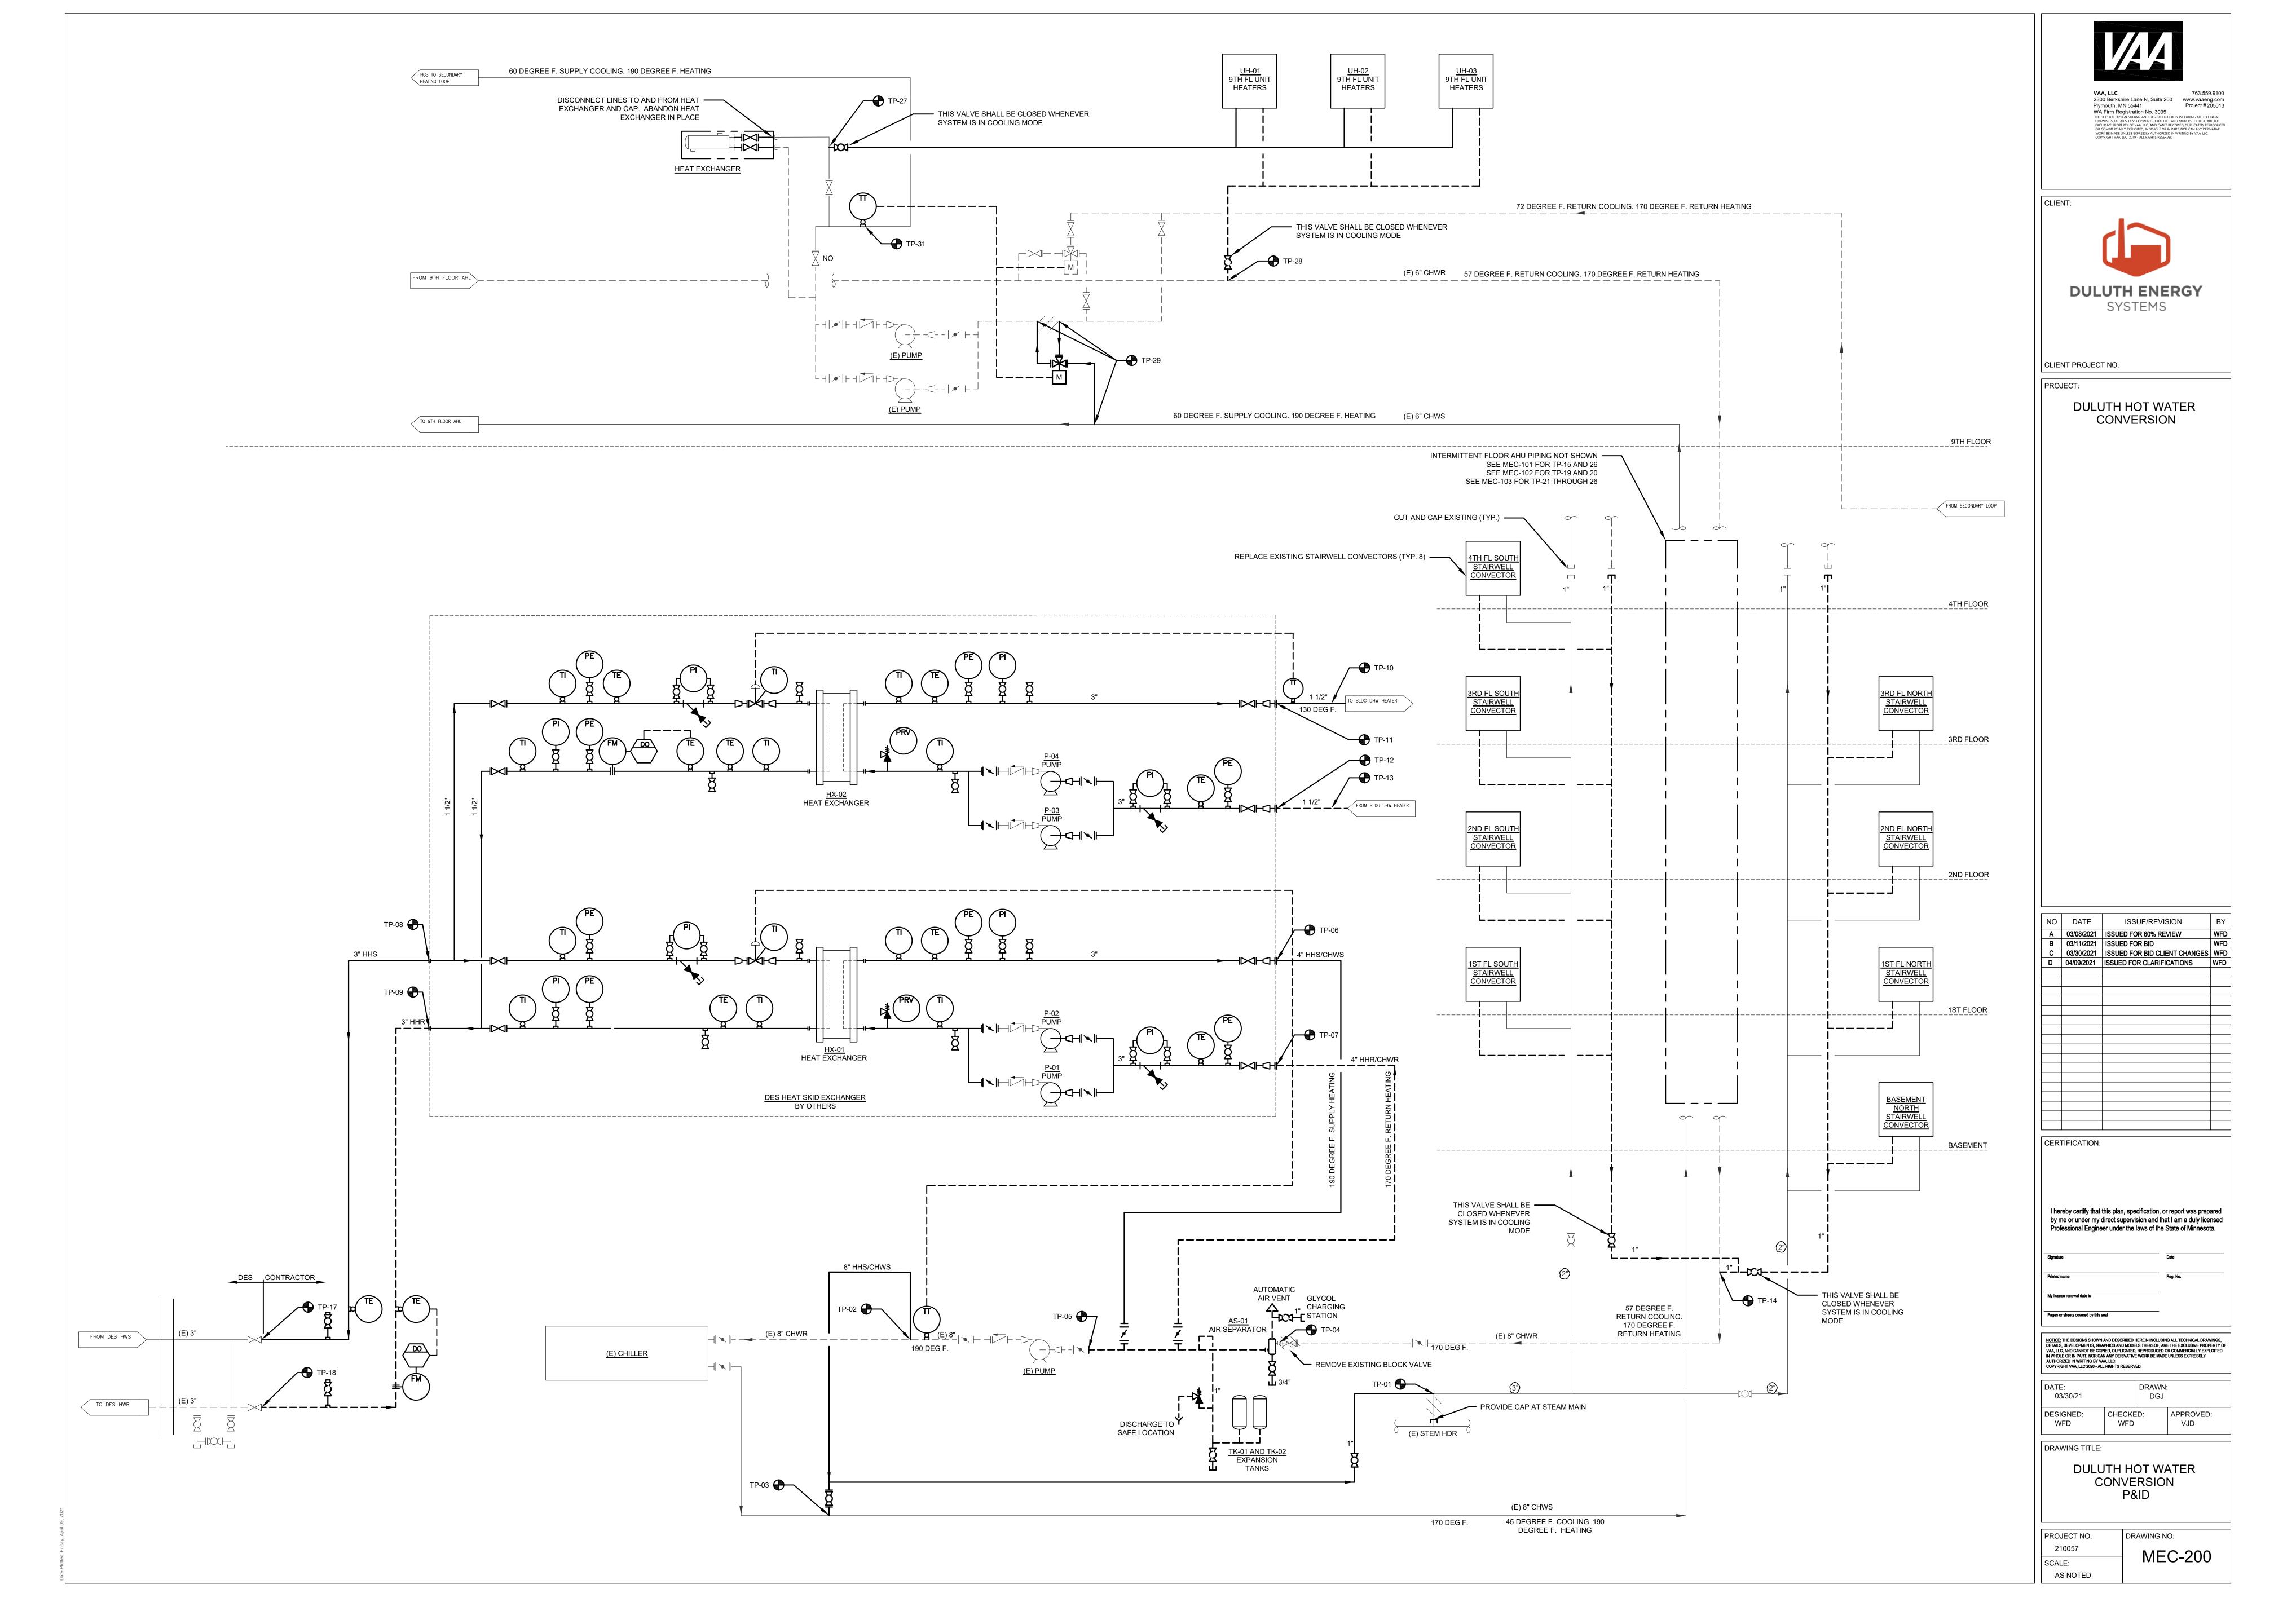

	FAN COIL UNIT SCHEDULE																							
PLAN MARK	SERVICE	SUPPLY (CFM)	MIN O.A (CFM)	EXT. ST. PRESSURE	FAN QUANTITY	MAX BHP	VOLT	TS PHASE	MAX FACE VEL. (FPM)	COOLING E.A.T. (°F) (DB)	COOLING E.A.T. (°F) (WB)	COOLING L.A.T. (°F) (DB)	COOLING L.A.T. (°F) (WB)	COOLING SENSIBLE LOAD (MBH)	COOLING TOTAL LOAD (MBH)	HEAT OUTPUT (MBH)	HEATING E.A.T. (°F)	HEATING L.A.T. (°F)	LENGTH (FT)	WIDTH (FT)	HEIGHT (FT)	WEIGHT (LBS)	MANUFACTURER & MODEL NO.	REMARKS
FCU-1	AB OFFICE AREA	6000	600	1.25	1	3.75	460	3	500	86.4	64.4	55.0	53.1	203.5	213.3	72.0	60.0	71.1	7.00	2.33	7.33	1084	TRANE UCCAM12C0F0EAL73	1,2,3,4,6,7,8,9
FCU-2	AB OFFICE AREA	6000	600	1.25	1	3.73	460	3	500	86.4	64.4	55.0	53.1	203.5	213.3	72.0	60.0	71.1	7.00	2.33	7.33	1084	TRANE UCCAM12C0F0EAL73	1,2,3,4,6,7,8,9
FCU-3	FRONT LOBBY	660	0	0.5	1	0.5	460	3	500	N/A	N/A	N/A	N/A	N/A	N/A	15.7	68.0	90.0	2.00	3.92	1.00	81	AE-AIR PHBC-HBC	1,3,4,6,8,9,10
REMAR	KS:	•		•				•	-	•	_	_	NOTES:					-						•

1. UNIT SHALL BE FURNISHED WITH PREMIUM EFFICIENCY BLOWER MOTORS WITH FACTORY-MOUNTED AND WIRED VARIABLE FREQUENCY DRIVE.

2. UNIT COIL IS TO BE UTILIZED FOR HEATING AND COOLING.

3. UNIT SHALL BE FURNISHED WITH SINGLE POINT POWER CONNECTION, 24V CONTROL TRANSFORMER, UNIT-MOUNTED AND WIRED FUSED SERVICE DISCONNECT.

4. UNIT COIL TO BE SUPPLIED WITH 45 DEGREE CHILLED GLYCOL WHEN COOLING AND 160 DEGREE HEATED GLYCOL WHEN HEATING.

MAXALLOWABLE GLYCOL PRESSURE DROP 7 PSIG. (30% PROPYLENE GLYCOL). 5. UNIT COILS SHALL BE SIZED FOR A 12 DEGREE F TEMP DROP WHEN COOLING AND A 20 DEGREE TEMP DROP WHEN HEATING

6. UNIT'S INTERNAL STATIC PRESSURE IS TO INCLUDE DIRTY FILTER LOADING.

7. UNIT IS TO BE A VERTICAL CONFIGURATION WITH TOP DISCHARGE.

8. DIMENSIONS INDICATED ARE ALLOWABLE MAXIMUMS.

9. UNIT SHALL BE FURNISHED WITH MINIMUM MERV 8 FILTERS. 10. UNIT SHALL BE PROVIDED WITH HEATING COIL ONLY.

1. ALL EQUIPMENT AND ACCESSORIES SHALL BE FURNISHED BY MECHANICAL CONTRACTOR UNLESS NOTED OTHERWISE

2. MAKE AND MODEL OF EQUIPMENT, ELECTRICAL REQUIREMENTS, AND PHYSICAL DIMENSIONS AT THIS SCHEDULE ARE THE BASIS OF DESIGN. EQUIPMENT SUPPLIER AND PROCURING CONTRACT

RESPONSIBLE FOR SUBMITTAL OF EQUIPMENT CUT SHEETS AND DRAWINGS FOR ENGINEER'S

APPROVAL PRIOR TO FABRICATION. SEE SUBMITTAL LOG ON SHEET M0.00.

				EΣ	(PANSION TANK	SCHEDULE				
		ACCEPTANCE	TOTAL							
		CAPACITY	CAPACITY	DIAMETER						
PLAN MARK	TYP.	(GAL)	(GAL)	(IN)	HEIGHT (IN)	WEIGHT	MODEL No.	MANUFACTURER		REMARI
TK-1	BLADDER	132.0	132.0	24.0	78.0	328.0	B-500	BELL & GOSSETT	1	
TK-2	BLADDER	132.0	132.0	24.0	78.0	328.0	B-500	BELL & GOSSETT	1	
1. INSTALL PER	MANUFACTUR	RER INSTRUCTION	IS.							

ENERGY SKID UNIT SCHEDULE (PROVIDED FOR REFERENCE ONLY)

		DISTRICT HEAT LOOP					BUILDING HEATING LOOP					
PLAN MARK	SERVES	MBH	Temp in.	Temp Out	PRESS. DROP (ft.)	GPM	MBH	Temp in.	Temp Out	PRESS. DROP (ft.)	GPM	Remarks
-IX-01	BUILDING HEATED GLYCOL LOOP	2,699	205	155	7	108.1	2,699	170	190	7	279	1,2
-IX-02	DOMESTIC HOT WATER HEATING	1,346	205	155	7	53.9	1,346	56	135	7	35	2,4
	HX-01	HX-01 BUILDING HEATED GLYCOL LOOP	HX-01 BUILDING HEATED GLYCOL LOOP 2,699	PLAN MARKSERVESMBHTemp in.HX-01BUILDING HEATED GLYCOL LOOP2,699205	PLAN MARKSERVESMBHTemp in.Temp OutHX-01BUILDING HEATED GLYCOL LOOP2,699205155	PLAN MARKSERVESMBHTemp in.Temp OutPRESS. DROP (ft.)HX-01BUILDING HEATED GLYCOL LOOP2,6992051557	PLAN MARKSERVESMBHTemp in.Temp OutPRESS. DROP (ft.)GPMHX-01BUILDING HEATED GLYCOL LOOP2,6992051557108.1	PLAN MARK SERVES MBH Temp in. Temp Out PRESS. DROP (ft.) GPM MBH HX-01 BUILDING HEATED GLYCOL LOOP 2,699 205 155 7 108.1 2,699	PLAN MARK SERVES MBH Temp in. Temp Out PRESS. DROP (ft.) GPM MBH Temp in. HX-01 BUILDING HEATED GLYCOL LOOP 2,699 205 155 7 108.1 2,699 170	PLAN MARK SERVES MBH Temp in. Temp Out PRESS. DROP (ft.) GPM MBH Temp in. Temp Out HX-01 BUILDING HEATED GLYCOL LOOP 2,699 205 155 7 108.1 2,699 170 190	PLAN MARK SERVES MBH Temp in. Temp Out PRESS. DROP (ft.) GPM MBH Temp in. Temp Out PRESS. DROP (ft.) HX-01 BUILDING HEATED GLYCOL LOOP 2,699 205 155 7 108.1 2,699 170 190 7	PLAN MARK SERVES MBH Temp in. Temp Out PRESS. DROP (ft.) GPM MBH Temp in. Temp Out PRESS. DROP (ft.) GPM HX-01 BUILDING HEATED GLYCOL LOOP 2,699 205 155 7 108.1 2,699 170 190 7 279

PLAN MARK	SERVES	GPM	HEAD	REMARKS
P-01	HX-01	279.0	40	3
P-02	HX-01	279.0	40	3
P-03	HX-02	35.0	28	3
P-04	HX-02	35.0	28	3

1. HEATED GLYCOL LOOP IS TO BE SIZED FOR 30% PROPYLENE GLYCOL.

2. UNIT IS TO BE PROVIDED AS A PART OF THE DISTRICT ENERGY SKID.

3. PUMPS ARE TO ALTERNATE OPERATION ONE RUNNING ONE IN STAND BY.

4. HEAT EXCHANGER PLATES ARE TO BE DESIGNED TO MEET MINNESOTA PLUMBING CODE REQUIREMENTS FOR HEATING OF DOMESTIC WATER.

					CONVECTOR	UNIT SCH	EDULE					
PLAN MARK	SERVES	BTUH	Temp in.	Temp Out	PRESS. DROP (ft.)	GPM	LENGTH (in.)	DEPTH (in.)	HEIGHT (in.)	MODEL NO.	MANUFACTURE	R Remarks
CV-1	NORTH EAST STAIR TOWER	8950	160	150	7	1.9	48.0	8.0	32.0	FL-8-48-32-D	AIREDALE	1,2,3,4,5,6
CV-2	NORTH EAST STAIR TOWER	8950	160	150	7	1.9	48.0	8.0	32.0	FL-8-48-32-D	AIREDALE	1,2,3,4,5,6
CV-3	NORTH EAST STAIR TOWER	8950	160	150	7	1.9	48.0	8.0	32.0	FL-8-48-32-D	AIREDALE	1,2,3,4,5,6
CV-4	NORTH EAST STAIR TOWER	8950	160	150	7	1.9	48.0	8.0	32.0	FL-8-48-32-D	AIREDALE	1,2,3,4,5,6
CV-5	SOUTH WEST STAIR TOWER	8950	160	150	7	1.9	48.0	8.0	32.0	FL-8-48-32-D	AIREDALE	1,2,3,4,5,6
CV-6	SOUTH WEST STAIR TOWER	8950	160	150	7	1.9	48.0	8.0	32.0	FL-8-48-32-D	AIREDALE	1,2,3,4,5,6
CV-7	SOUTH WEST STAIR TOWER	8950	160	150	7	1.9	48.0	8.0	32.0	FL-8-48-32-D	AIREDALE	1,2,3,4,5,6
CV-8	SOUTH WEST STAIR TOWER	8950	160	150	7	1.9	48.0	8.0	32.0	FL-8-48-32-D	AIREDALE	1,2,3,4,5,6
CV-9	SIX FLOOR MENS ROOM	920	160	150	7	0.2	24.0	4.0	24.0	FL-4-24-24-D	AIREDALE	1,2,3,4,5,6
CV-10	SEVENTH FLOOR MENS ROOM	920	160	150	7	0.2	24.0	4.0	24.0	FL-4-24-24-D	AIREDALE	1,2,3,4,5,6
CV-11	EIGHT FLOOR MENS ROOM	920	160	150	7	0.2	24.0	4.0	24.0	FL-4-24-24-D	AIREDALE	1,2,3,4,5,6

1. UNIT TO PROVIDED WITH 30% PROPYLENE GLYCOL.

2. UNIT IS TO BE SURFACE MOUNTED WITH FRONT SUPPLY AND RETURN GRILLES.

3. UNIT IS TO BE SUPPLIED WITH INTEGRAL THERMOSTAT. 4. UNIT TO HAVE FRONT INLET AND OUTLET GRILLES.

5. UNIT TO HAVE ACCESS DOOR ON PIPING CONNECTION SIDE.

6. UNIT COLOR TO BE IVORY.

	UNIT HEATER SCHEDULE											
PLAN MARK	SERVES	BTUH	Temp in.	Temp Out	PRESS. DROP (ft.)	GPM	CFM	FAN HP	VOLTS / PH	MODEL NO.	MANUFACTURER	Remarks
UH-01	NINTH FLOOR MECH ROOM	12150	160	150	7	2.5	630.0	1/25	110 / 1	HS-33	MODINE	1,2,3,4,5,6
UH-02	NINTH FLOOR STORAGE	24290	160	150	7	5.0	680.0	1/12	110 / 1	HS-63	MODINE	1,2,3,4,5,6
UH-03	NINTH FLOOR STORAGE	24290	160	150	7	5.0	680.0	1/12	110 / 1	HS-63	MODINE	1,2,3,4,5,6

1. UNIT TO PROVIDED WITH 30% PROPYLENE GLYCOL.

2. UNIT IS TO BE HUNG FROM STRUCTURE 3. UNIT IS TO BE SUPPLIED WITH INTEGRAL THERMOSTAT.

							REPLACEN	MENT COILS					
		OVE	RALL				SUF	PPLY AIR					
PLAN MARK	CFM	LENGTH	HEIGHT	NO COILS	MBH	TEMP IN.	TEMP OUT	AIR PRES. DROP (in. w.c.)	TEMP IN.	TEMP OUT	PRESS. DROP (ft.)	GPM	REMARKS
AC-1	11,025	7.00	3.50	4	350	59.2	88.6	0.625	190	170	7	36.2	1,2,3,4
AC-2	4,860	4.80	2.25	2	183	59.2	94.1	0.625	190	170	7	19.0	1,2,3,4
AC-3	12,206	7.75	3.50	4	433	59.2	92.0	0.625	190	170	7	44.8	1,2,3,4
AC-4	12,206	7.75	3.50	4	475	59.2	95.2	0.625	190	170	7	49.2	1,2,3,4
AC-5	12,206	7.75	3.50	4	490	59.2	96.3	0.625	190	170	7	50.7	1,2,3,4
AC-6	7,250	9.67	1.67	2	208	59.2	85.7	0.625	190	170	7	21.5	1,2,3,4
AC-8	24,225	9.50	5.67	2	410	59.2	74.9	0.625	190	170	7	42.5	1,2,3,4

1. CONFIRM SPACE AVAILABLE TO PULL EXISTING STEAM COILS.

2. CONFIRM ACTUAL SIZE AND SPACE AVAILABLE FOR INSTALLATION OF NEW HEATED GLYCOL COILS IN THE FIELD PRIOR TO MANUFACTURING NEW COILS.

3. PROVIDE INTERNAL COIL PIPING AS INDICATED ON COIL DETAIL 4. UNIT TO BE SUPPLIED WITH 30% PROPYLENE GLYCOL.

TIE POINT LIST TIE POINT# DESCRIPTION LEVEL LOCATION EXISTING STEAM HEADER TIE IN FOR STAIRWELL SD SUB BASEMENT SD SUB BASEMENT CHILLED WATER INLET BYPASS SD SUB BASEMENT CHILLED WATER OUTLET BYPASS CONNECTION FOR NEW AIR SEPARATOR BEFORE THE EXISTING PUMP SD SUB BASEMENT SD SUB BASEMENT CONNECTION FOR NEW AIR SEPARATOR AND SKID AT EXISTING PUMP CONNECT 4" HWR TO SKID SD SUB BASEMENT SD SUB BASEMENT CONNECT 4" HWS TO SKID CONNECT TO DES 3" HHS TO SKID SD SUB BASEMENT SD SUB BASEMENT CONNECT TO DES 3" HHR TO SKID SD SUB BASEMENT CONNECT DWH RETURN TO SKID SD SUB BASEMENT CONNECT DHW SUPPLYS TO SKID SD SUB BASEMENT CONNECTION TO DHWR SD SUB BASEMENT CONNECTION TO DHWS SD SUB BASEMENT CONNECT STAIRWELL CONVECTORS TO RETURN CONNECT NEW 2" TO EXISTING CHWS FOR NEW FCU-01 AND 02 AB BASEMENT AB BASEMENT CONNECT NEW 2" TO EXISTING CHWR FOR NEW FCU-01 AND 02 AB BASEMENT CONNECT TO DES 3" HHS TP-18 AB BASEMENT CONNECT TO DES 3" HHR 1ST FLOOR PLAN CONNECT TO EXISTING CHWR FOR NEW FAN COIL 1ST FLOOR PLAN CONNECT TO EXISTING CHWS FOR NEW FAN COIL 3RD FLOOR PLAN CONNECT TO EXISTING CHWS/R FOR NEW AHU COIL 3RD FLOOR PLAN CONNECT TO EXISTING CHWS/R FOR NEW CONVECTOR 5th FLOOR PLAN CONNECT TO EXISTING CHWS/R FOR NEW AHU COIL 5th FLOOR PLAN CONNECT TO EXISTING CHWS/R FOR NEW AHU CONVECTOR 7th FLOOR PLAN CONNECT TO EXISTING CHWS/R FOR NEW AHU COIL CONNECT TO EXISTING CHWS/R FOR NEW AHU CONVECTOR 7th FLOOR PLAN 9TH FLOOR CONNECT 1" HHS TO NEW UNIT HEATERS 9TH FLOOR CONNECT 1" HHR TO NEW UNIT HEATERS SECONDARY LOOP THREE WAY VALVE 9TH FLOOR CONNECT TO EXISTING CHWS/R FOR NEW AHU COIL 9TH FLOOR TP-31 TT-FOR THREE WAY VALVE 9TH-FLOOR 9TH-FLOOR CONNECT TO EXISTING CHWS/R FOR NEW AHU COIL SD SUB BASEMENT

2300 Berkshire Lane N, Suite 200 www.vaaeng.com
Plymouth, MN 55441 Project #205013 PIYITIOUII, MIN 3044 I
WA Firm Registration No. 3035
NOTICE THE DESIGN SHOWN AND DESCRIBED HEREIN I
DRAWINGS, DETAILS, DEVELOPMENTS, GRAPHICS AND N
EXCLUSIVE PROPERTY OF VAA, ILC, AND CAN'T BE COPI
OR COMMERCIALLY EXPLOITED, IN WHOLE OR IN PART,



CLIENT PROJECT NO:

DULUTH HOT WATER CONVERSION

NO	DATE	ISSUE/REVISION	BY
Α	03/08/2021	ISSUED FOR 60% REVIEW	WFD
В	03/11/2021	ISSUED FOR BID	WFD
С	03/30/2021	ISSUED FOR BID CLIENT CHANGES	WFD
D	04/09/2021	ISSUED FOR CLARIFICATIONS	WFD

CERTIFICATION:

I hereby certify that this plan, specification, or report was prepared by me or under my direct supervision and that I am a duly licensed Professional Engineer under the laws of the State of Minnesota.

My license renewal date is

NOTICE: THE DESIGNS SHOWN AND DESCRIBED HEREIN INCLUDING ALL TECHNICAL DRAWINGS, DETAILS, DEVELOPMENTS, GRAPHICS AND MODELS THEREOF, ARE THE EXCLUSIVE PROPERTY OF VAA, LLC, AND CANNOT BE COPIED, DUPLICATED, REPRODUCED OR COMMERCIALLY EXPLOITED, IN WHOLE OR IN PART, NOR CAN ANY DERIVATIVE WORK BE MADE UNLESS EXPRESSLY AUTHORIZED IN WRITING BY VAA, LLC. COPYRIGHT VAA, LLC 2020 - ALL RIGHTS RESERVED.

DGJ 03/30/21 DESIGNED: CHECKED: APPROVED: WFD WFD VJD

DRAWING TITLE:

DULUTH HOT WATER CONVERSION SCHEDULES

PROJECT NO: DRAWING NO: 210057 SCALE: AS NOTED

VAA FCU 1500 CFM March 11, 2021

Product Data:

PHBC - HBC Models

Qty Description Model Number

1 PHBC - HBC Models 08APHBCP12003RHSMXXX

Tag(s):

Item Tag(s):

Selected Options

08 Size : 08

P Motor Option : PSC

120 Voltage : 120V-1-60

03 Coil : 2 Pipe 3-Row

RH Handing : Right Hand

S Drain Pan : Stainless Steel

M Control Voltage : 120V/24V

X Foil Option : None

VAA FCU 1500 CFM March 11, 2021



Tag:

08PHBC

<u>Qty</u>	<u>Model</u>	<u>Size</u>	Unit Configuration	Unit Dimensions (in.)	Shipping Weight* (lbs.)
1	PHBC	80	Supply	L=22.75 W=46.13 H=10	81

Electrical Data

Unit \	<u>/oltage</u>	Unit Amps - FLA	Min. Cir. Amps - MCA	Max. Fuse Size - MOP
115-1	-60	3	4	15

General Information

Air Flow:	919	CFM	Fluid Type:	
ESP:	0.01	in. H2O	Glycol %:	%
Altitude:	0	Feet		



Horizontal Fan Coil with Plenum - Chilled / Hot Water

Fan Performance

Fan Speed:	High	
Fan Motor BHP:	0.00	BHP
Fan RPM	0	RPM
External Static Presssure:	0.01	in. H2O


Motor Data


Description	<u>Qty</u>	<u>HP (ea.)</u>	FLA (ea.)
PSC	1	1/5	3

Hot Water

Total Capacity:	27.2	MBH
Entering Air Temp:	68.00	°F
Leaving Air Temp:	94.6	°F
Entering Fluid Temp:	180.00	°F
Fluid Flow:	1.0	GPM
Leaving Fluid Temp:	122.4	°F
Coil Rows:	3	
Fluid Pressure Drop:	0.42	ft. H2O
Air Pressure Drop:	0.31	ft. H2O

Fan Curve

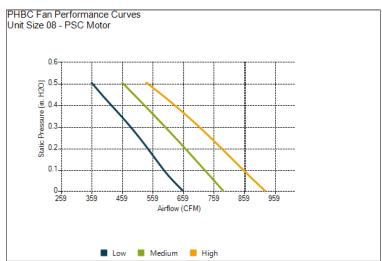


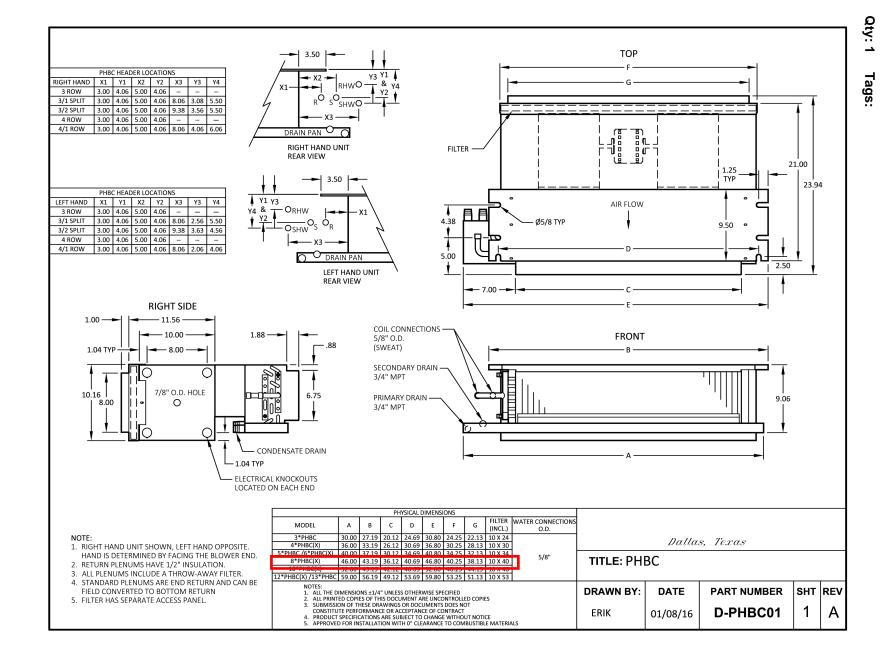

VAA FCU 1500 CFM March 11, 2021

WD45P005

Qty: 1 Tags:

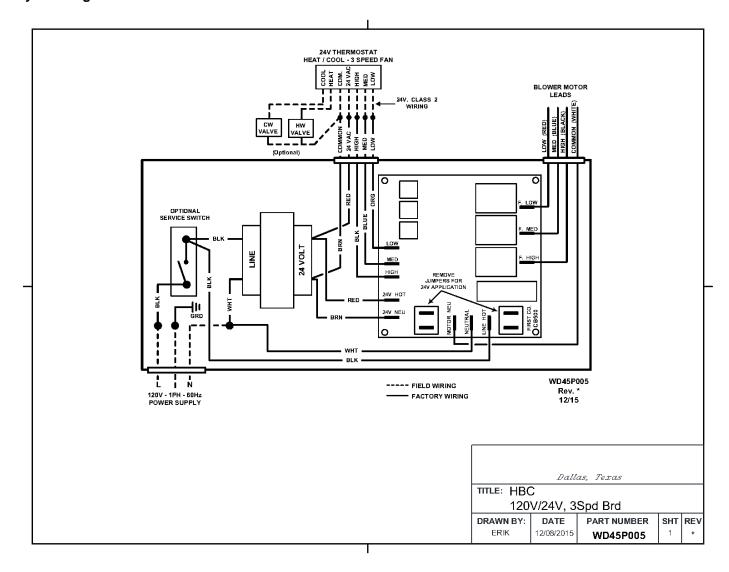

VAA FCU 1500 CFMMarch 11, 2021

Mechanical Specification: HBC - HBC Models

System Description

Horizontal, 2-pipe or 4-pipe above ceiling furred-in room fan coil unit or above ceiling with plenum for ducting or recessed cabinet for ducting, or with cabinet for exposed ceiling installations.

Quality Assurance

Unit shall be tested and certified in accordance with AHRI Standard 440, latest edition and base unit ETL certified. (Units with special features may not have ETL certification.) Each coil shall be factory tested for leakage at 350 PSIG air pressure with coil submerged under water. Insulation and adhesive shall meet NFPA 90A requirements for flame spread and smoke generation. All equipment wiring shall comply with NEC requirements.

Delivery, Storage and Handling

Each unit shall be individually packaged from point of manufacture. Unit shall be handled and stored in accordance with the manufacturer's instructions.

General Product Information

Factory-assembled, horizontal, blow-thru type fan coil for furred-in, exposed ceiling or ducted installations. Unit shall be complete with water coil(s), fan (s), motor(s), drain pan, and all required wiring, piping, and special features. Standard insulation shall be dual density 1/2" Tuf-Skin RX™ fiberglass insulation that includes an acrylic coating that is formulated with and EPA registered anti-microbial agent. The insulation meets the erosion requirements of UL 181. It has a flame spread of less than 25 and a smoke developed classification of less than 50 per ASTM E-84 and UL 723. 1" fiberglass air filters are provided and factory installed.

Fans

Direct-driven, double width, double inlet (DWDI), forward curved, centrifugal type. They are statically and dynamically balanced for smooth, quiet operation. The housing is constructed of heavy gauge galvanized steel with die-formed inlet cones. Fan wheels shall be constructed of galvanized steel.

Coil

Coils are staggered tube type construction with seamless copper tubes and headers, and deep corrugated aluminum fins with straight edges. Fins are manufactured with full depth collars, drawn in the fin stock to provide accurate control of fin spacing and completely cover the copper tubes to lengthen coil life. The tubes are to be mechanically expanded into the fins for a permanent primary to secondary surface bond, assuring maximum heat transfer efficiency. The coils are to be tested at 350 PSIG air pressure for operation at 300 PSIG maximum working pressure. Coils include manual air vents.

Motor Option : PSC

Fan motors shall be 3-speed, 120V, single-phase, 60 Hz, permanent split capacitor (PSC), with sleeve type bearings, and oversized oil reservoirs to ensure lubrication.

Coil: 2 Pipe 3-Row

A single circuit-coil unit installed in a 2-pipe system shall be capable of providing heating or cooling as determined by the operating mode of the central water supply system.

Drain Pan : Stainless Steel

The drain pan shall be constructed of stainless steel, extending the entire length and width of the coil(s), and shall be pitched for positive drainage. The inside surface of the drain pan shall be coated with closed-cell fire-retardant foam insulation. Drain pan shall include a secondary drain connection located above the primary drain connection to act as an indicator that the main primary is plugged. Drain pans are removable without removing coils.

Control Voltage: 120V/24V

Fan controls shall include a factory mounted and wired 24V transformer and three speed control board.