

3716 Oneota Street
Duluth, MN 55807
O 218.722.3775
F 218.722.3778
www.krausanderson.com

KRAUS-ANDERSON® CONSTRUCTION COMPANY

ADDENDUM NO. 2

May 31, 2013

Duluth International Airport
New Parking Structure and Exterior Wayfinding Signage
Bid Package 2D
Duluth, MN 55811

TO ALL CONTRACTORS:

The following are clarifications and/or changes to the Plans and Specifications, dated May 15, 2013, to be Bid on June 11, 2013, for the above named Project. Acknowledge receipt of this Addendum in the space provided on the Bid Form. Failure to do so may subject the Bidder to disgualification.

- 1. A specific Bid Form Packet is <u>required</u> for the Prime Contractor's bid submission on this project. Bidders <u>must</u> contact Kim Lofquist, Kraus-Anderson® Construction Company, at 218-722-3775 or <u>kim.lofquist@krausanderson.com</u> to obtain the required Bid Form Packet.
 - A. Bid Form Packet documents can be found in Volume 1 of the Project Manual, following is a list of those documents included in the Bid Form Packet: City of Duluth cover page; Bid Form; City of Duluth Purchasing Division General Specifications; AIA Document A310 Bid Bond; Affidavit of Non-Collusion; EEO Affirmative Action Policy Statement & Compliance Certificate; Forms 1 & 2 for Demonstration of Good Faith Efforts, Good Faith Efforts Affidavit and Certificate of Good Faith Efforts.

2. Section 00 41 00 - Bid Form

A. Bid Form

Bid Form replaced in its entirety.

3. Section 01 01 40 Work Scope Descriptions

A. Work Scope Index

- Work Scope 3.40D Precast Wall Panel & Floor Plank Delete reference to Specification Section 03 41 01 Precast Hollow Core Slabs.
- Work Scope 5.10D Struct. Steel & Misc. Metal Fabrication & Erection –
 Delete Specification Section and Remarks: "05 75 13 Wire Cloth Complete"
 and replace with the following "05 75 12 Wire Cloth Complete, As It Relates
 to Alternate No. 10B and 11A."
- Work Scope 7.10D Metal Panels & Roofing Add the following under Specification Sections and Remarks: "05 75 12 Wire Cloth Complete, As It Relates to Alternate No. 10C and 11B."
- Work Scope 7.10D Metal Panels & Roofing Add the following under Specification Sections and Remarks: "05 50 00 Metal Fabrications Complete, As It Relates to Alternate No. 12B."

B. Work Scope Descriptions

- Work Scope 3.40D Precast Wall Panel & Floor Plank:
 - a. Delete Specification Section reference "03 41 01 Precast Hollow Core Slabs Complete." This section is no longer included.
 - Add the following to Par. 1.03, M. Coordination of Openings
 Required by Others, Item 2 to read: "Include required sleeves in Precast Floor Plank as shown on Sheet E101 for electrical conduit."
- Work Scope 5.10D Struct. Steel & Misc. Metal Fabrication & Erection:
 - a. Delete Specification Section reference "05 75 13 Wire Cloth Complete" and replace with the following "05 75 12 Wire Cloth Complete, As It Relates to Alternate No. 10B and 11A."
 - b. Add the following to Par. 1.02, R. Equipment Screen, Item 4 to read: "All work associated with the Equipment Screen is to be included in Alternate No. 12A. Do not include this in base bid."
- Work Scope 7.10D Metal Panels & Roofing:
 - a. Add the following under Specification Sections: "05 75 12 Wire Cloth Complete, As It Relates to Alternate No. 10C and 11B."
 - b. Add the following under Specification Sections: "05 50 00 Metal Fabrications Complete, As It Relates to Alternate No. 12B."

- 4. Work Scope 10.20D Interior & Exterior Wayfinding Signage:
 - a. Add the following to Par. 1.07 Unit Prices and Cost Break Downs, Item B to read: "Provide a breakout price on the Construction Manager issued Bid Form for all work associated with the construction of the Exterior Wayfinding Signage. This price should include all material, labor, equipment, and overhead and profit."
- 5. Work Scope 26.10D Electrical Systems:
 - a. Add the following to Par. 1.07 Unit Prices and Cost Break Downs, Item B to read: "Provide a breakout price on the Construction Manager issued Bid Form for all work associated with the construction of the Exterior Wayfinding Signage. This price should include all material, labor, equipment, and overhead and profit."
 - b. Add the following Paragraph to Section 1.03 Special Coordination or Installation Requirements, Item J to read: "J. Communication Tie In to Existing Terminal: Reference reflective ceiling plan, sheet A210 – For Reference, that is included with this addendum for work associated with communication wiring tie in to existing terminal. A site visit is encouraged to review the as-built conditions. All the work associated with the removal and reinstallation of finishes is to be included with this work."

5. **General Information**

- A. See attached Pre-Bid Meeting Sign-In Sheet.
- B. See attached Kraus-Anderson® Construction Company *Pre-Bid Meeting Agenda*.
- C. The Pre-Bid Meeting clarification: The Pre-Bid Meeting was not mandatory; however, contractors are still required to review the Sign-In Sheet and Agenda. A site visit is also recommended to ensure contractors have an understanding of the existing conditions.
- D. Add Reynolds, Smith & Hills, Inc.'s, Addendum No. 2 dated May 31, 2013, in its entirety.

END OF ADDENDUM NO. 2

(Bidder may copy this form on his own letterhead) **SUBMIT IN DUPLICATE**

BID FORM

BID TO:	Duluth Airport Authority; By the City Purchasing Agent Room 100 City Hall Duluth, MN 55802 Duluth, MN 55802
BID FROM:	Actual Bid Form Actual Bid Form MUST be obtained through Company
	Kraus-Andersone Construction Company

In accordance with the Invitation to Bid and the proposed Contract Documents prepared by Reynolds, Smith and Hills, Inc., relating to the construction of:

Duluth International Airport New Parking Structure and Exterior Wayfinding Signage Bid Package 2D Duluth, Minnesota

the undersigned, having visited the site of proposed construction and having become thoroughly familiar with local conditions affecting the cost and performance of the Work and with all requirements of the Contract Documents and related Addenda, hereby proposes and agrees to provide all labor, materials, equipment, applicable permits and taxes required to construct and complete the Work in accordance with the Contract Documents and Addenda for the following amounts:

Base Bids:

Instructions for Submitting Base Bids:

- Base Bid includes the Parking Structure and Skywalk.
- Provide Skywalk and Exterior Wayfinding Signage breakdown in space provided.
 These costs are to be included in the base bid and broken out in the space provided.
- Note: Cost breakdowns are for funding purposes only. These will not have an impact on award.
- For bidders wishing to submit bids on more than one Work Scope, space has been provided to submit bids for Multiple Work Scopes on the same Bid Form.
- State Base Bid in both words and figures in spaces provided.

DULUTH INTERNATIONAL AIRPORT NEW PARKING STRUCTURE AND EXTERIOR WAYFINDING SIGNAGE BID PACKAGE 2D ISSUE FOR BID SECTION 00 41 00 - 1

00 41 00 - BID FORM

1.	Base Bid for Work Scope No. 2.20D Title Civil, Site Work, & Bui	<u>lding Earthwork</u>
	Bid Amount:	\$
	a. Cost Breakdown No. 1: Skywalk (Part of Unit Price 71) Breakdown Amount:	\$
2.	Base Bid for Work Scope No. 2.90D Title Landscaping	
	Bid Amount:	\$
	a. Cost Breakdown No. 1: Skywalk	
	Breakdown Amount:	\$
3.	Base Bid for Work Scope No. 3.30D Title Concrete	
	Bid Amount:	\$
	a. Cost Breakdown No. 11 Skywark	
	2:04:40:117 11:104:140	\$
4.	Base Bid for Work Scope No. 8 400 Title Precast Wall Panel &	Roor Plank
	Bid Amount:	\$
	a. Cost Breakdown Amount:	\$ <u> </u>
	Breakdown Amount:	\$
5.	Base Bid for Work Scape No. 4.20D Title Unit Masonry Bid Amount	
	Bid Amount	\$
	a. Cost Breakdown No. 1: Skywalk	
	Breakdown Amount:	\$
6.	Base Bid for Work Scope No. 5.10D Title Struct. Steel & Misc. M	letal Fabrication &
	<u>Erection</u>	
	Bid Amount:	\$
	a. Cost Breakdown No. 1: Skywalk	
	Breakdown Amount:	\$

00 41 00 - BID FORM

7.	Base Bid for Work Scope No. 7.10D Title Metal Panels & Roofin	<u>g</u>
	Bid Amount:	\$
	a. Cost Breakdown No. 1: Skywalk	
	Breakdown Amount:	\$
8.	Base Bid for Work Scope No. 8.22D Title Overhead Coiling Doo	<u>rs</u>
	Bid Amount:	\$
	a. Cost Breakdown No. 1: Skywalk	
	Breakdown Amount:	\$
9.	Base Bid for Work Scope No. 8.30D Title Doors, Frames, Hardw	vare, & Misc.
	Specialties (Materials Only)	
	Bid Amount:	\$
	a. Cost Breakdown No. P. Skywark	
	Breakdown Amount:	\$
10.	Base Bid for Work Scope No. 8.40D Title Aluminum Ramed Au	itomatic Entrances,
	Storefronts, and Glass of be obtained the control of the control o	COLUID GII I A
	Bid Amount:	~\$
	a. Cost Breakdown No. 1: Program Breakdown And Grant	•
	[Zi -	\$
11.	Base Bid for Work Scope No. <u>9.20D</u> Title <u>Metal Studs & Drywa</u>	¯.
	Bid Amount:	\$
	a. Cost Breakdown No. 1: Skywalk	•
	Breakdown Amount:	\$
12.	Base Bid for Work Scope No. <u>9.60D</u> Title <u>Terrazzo</u>	•
	Bid Amount:	\$
	a. Cost Breakdown No. 1: Skywalk Breakdown Amount:	\$
	DIESKOOWO AUIOUUT	.n

DULUTH INTERNATIONAL AIRPORT NEW PARKING STRUCTURE AND EXTERIOR WAYFINDING SIGNAGE BID PACKAGE 2D ISSUE FOR BID

00 41 00 - BID FORM

13.	Base Bid for Work Scope No. <u>9.65D</u> Title <u>Flooring</u>	
	Bid Amount:	\$
	a. Cost Breakdown No. 1: Skywalk	
	Breakdown Amount:	\$
14.	Base Bid for Work Scope No. 9.90D Title Painting	
	Bid Amount:	\$
	a. Cost Breakdown No. 1: Skywalk	
	Breakdown Amount:	\$
15.	Base Bid for Work Scope No. 10.20D Title Interior & Exterior W	ayfinding Signage
	Bid Amount:	\$
	a. Cost Breakdown No. 1: Skywall DEN CE	
	Breakdown Amount OR REFERENCE	\$
	b. Cost Breakdown No. 2: Extend to a signage of the	∂
	Breakdown Amount:	\$
4.0		<u>ÇOWBSILIA</u>
16.	Base Bid for Work School To 14200 Title Elevator Bid Amount:	&
	a derening of	Ψ
	a. Cost Breakdown Na M Skywalk Breakdown Amount:	¢
		Φ
17.	Base Bid for Work Scope No. <u>21.10D</u> Title <u>Fire Suppression Sy</u> Bid Amount:	
	Bid Amount.	\$
	a. Cost Breakdown No. 1: Skywalk	
	Breakdown Amount:	\$
18.	Base Bid for Work Scope No. <u>22.10D</u> Title <u>Mechanical Systems</u>	
	Bid Amount:	\$
	a. Cost Breakdown No. 1: Skywalk	
	Breakdown Amount:	\$

DULUTH INTERNATIONAL AIRPORT NEW PARKING STRUCTURE AND EXTERIOR WAYFINDING SIGNAGE BID PACKAGE 2D ISSUE FOR BID SECTION 00 41 00 - 4

19. Base Bid for Work Scope No. <u>26.10D</u> Title <u>Electrical Systems</u> Bid Amount:	\$
a. Cost Breakdown No. 1: Skywalk Breakdown Amount:	\$
b. Cost Breakdown No. 2: Exterior Wayfinding Signage Breakdown Amount:	\$
Combined Base Bid:	
Work Scope Numbers and Titles on which Combined Bid is based:	
Work Scope No Title:	
Work Scope No Title:	
Work Scope No.	
Work Scope No. 10 Title: 1	
Work Scope No	
Combined Bid Amount: Alternates: A dorson® Construction	
Alternates: Refer to Secretaria 23 00 for complete description of Alternates.	
ADD	
Alternate No. 1A to Work Scope 8.40D \$	
Alternate No. <u>1B</u> to Work Scope <u>26.10D</u> \$	
Alternate No. 2 to Work Scope 3.40D \$	
Alternate No. 3A to Work Scope 9.60D \$	
Alternate No. 3B to Work Scope 9.65D \$	
Alternate No. 4 to Work Scope 26.10D \$	
Alternate No. 5 to Work Scope 26.10D \$	
DULUTH INTERNATIONAL AIRPORT S NEW PARKING STRUCTURE AND EXTERIOR WAYFINDING SIGNAGE BID PACKAGE 2D	ECTION 00 41 00 - 5

			ADD	
Alternate No	6 to Work	Scope <u>26.10D</u>	\$	
Alternate No	7 to Work	Scope <u>26.10D</u>	\$	
Alternate No	8 to Work	Scope <u>26.10D</u>	\$	
Alternate No	9 to Work	Scope <u>26.10D</u>	\$	
Alternate No.	10A to Work	Scope <u>3.40D</u>	\$	
Alternate No.	10B to Work	Scope <u>5.10D</u>	E ONLY	
Alternate No.	10C to Work	Score X 100	\$	
Alternate No.	11A to Work	Scope 5000		
Alternate No.	11B to Work	Scope 7.10D	<u>\$_4 {hrough</u>	
Alternate No.	12A to Weski	stope <u>G000</u>		olubgij)
Alternate No.	12B 10 Work	Scope 3.100	rstruction e	
1/106	ius-Ande	rsollo o	u -	
Addenda: WRec	eipt of the folio	wing Addenda to	o the Contract Docu d (provide Addenda	ments and their costs numbers below):
Addenda No.	<u>Dated</u>		Addenda No.	<u>Dated</u>

<u>Bid Acceptance</u>: If written notice of the acceptance of this Bid is received by the undersigned within 60 days after date set for opening of this Bid, or at any other time thereafter before Bid is withdrawn, the undersigned agrees to enter into and execute a Contract with the Owner in accordance with this Bid as accepted and in a form acceptable to Owner, and to furnish and deliver to the Construction Manager the Performance Bond, Payment Bond, and proof of insurance coverage, all within 10 days after notice of acceptance of this Bid.

DULUTH INTERNATIONAL AIRPORT NEW PARKING STRUCTURE AND EXTERIOR WAYFINDING SIGNAGE BID PACKAGE 2D ISSUE FOR BID **Execution of Proposal:** The entity(ies) signing this proposal is fully authorized to sign on behalf of the named firm and to fully bind the named firm to all of the conditions and provisions of the Contract. This proposal shall remain valid and not be withdrawn for 60 calendar days after bid due date.

Submitted this	day of	, 20
Name of Firm:		
Street Address:		_
City:	State:	Zip:
Phone Number:	Fax Numb	er:
Bidder is: (check one)	- PEDENCE OF	
☐ Individual	REFERENCE Partnership	☐ Corporation
names of president and	n, give legal name of corporation d secretary of a partnership of firm. If an individual, give first a	n, state where incorporated, and give names of all individual conditions in full.
	1051 po constru	CIION COLUR
Kraus-	Moreone Come	
Name (typed or printed):		
Signature:		
Title:		

END OF DOCUMENT



Closer to everywhere.

PRE-BID MEETING SIGN-IN SHEET

"Duluth International Airport – New Parking Structure and Exterior Wayfinding Signage"
"Bid Package 2D"

Name	Company	Address	Phone Number	Fax Number	E-Mail Address	Bidding Work Scope(s)
1 John E. Hippchen	RS&H	4525 Airport Approach Rd Duluth MN 55811	218-722-1227	218-722-1052	john.hippchen@rsandh.com	10.20D
2 BARREN OK	SEN Summit	SIGNS SOST MILLERT	RUN 390-6839	728.263	WOISENESUMMI	T-SIGNS SIGNS
3 Musty Mans	Huu Samm	45igns	11	/4	(/	
4 Milke Holz	NASIR GOTHAL	4 Diew Mech				P+H+F.A.
5 Chrs The	eker Laborei	s union #109/	218-428-787	16		
6 Try Western	lock Bodrack	Flind Inc. 4204 Enterpise	o circle 218-720-	3948 720-349 ₂	BFT 4204 Dyahoo.Co	om Div.4
7 Beas WERNER	Kouther	· · · · · · · · · · · · · · · · · · ·		0-6772 890.55	al browning Ken	LENGLONSELLETION DIVI
8 Drew Johnson	St. Germain's	Glass See Card				
· PAUL ZUJA	C JAMAO	2 100F	3911	3222		
10 lim HORN	UEIT		Z18-348-8226		Thorne veitusa,	con EARTH



Closer to everywhere.

PRE-BID MEETING SIGN-IN SHEET

"Duluth International Airport – New Parking Structure and Exterior Wayfinding Signage"
"Bid Package 2D"

Name	Company	Address	Phone Number	Fax Number	E-Mail Address	Bidding Work Scope(s)
11 Lagra Andre	Hoiso City Myon, In	610 South Center for D. Cot	4 215-6285686	218-128-3706	roger charborcity www.	u, la W
12 Mike St. Cyr	Hunt Electric	4330 west 1st Street	214-624-6505	-	MSt.Cyr @ hunter	ec. Com
13 Bill Cox	Lesavers 1091	2002 Lordon nd	218-728-513	57	Billuge Lua	colicum
14						
15					na sa ang ang ang ang ang ang ang ang ang an	The state of the s
16						701
17				***************************************	TOWARD A STREET	
<u>18</u>			_		770.07d	700
19					(TAME)	
20						



Closer to everywhere.

PRE-BID MEETING SIGN-IN SHEET

"Duluth International Airport – New Parking Structure and Exterior Wayfinding Signage"
"Bid Package 2D"

Name	Company	Address	Phone Number	Fax Number	E-Mail Address	Bidding Work Scope(s)
21 Cree Peter:	son HMI	90 BOX 16212	SS816 218,7	122-6181	491 grage HMIDI	u wat, con concreto
22 Jeff W	son HMI Idness HMI	1(218 34	38299 11	((((
23 Kun Schla			onse Crele 218	218·740 740·4412 4413	Kschlasso som	wither. con #21
24 Andrew Elfs	1 4N5ON 516NSOWA	.cE 7660 Quotle	o Dr. Chanha:	740.4412 4413 952-9 55en 763-232-99	08-9102 TY andrewhe	Sign-source, com
25						
<u>26</u>						
<u>27</u>			-			
<u>28</u>						
29						
30						
31						



Closer to everywhere.

PRE-BID MEETING SIGN-IN SHEET

"Duluth International Airport – New Parking Structure and Exterior Wayfinding Signage"
"Bid Package 2D"

Name	Company	Address	Phone Number	Fax Number	E-Mail Address	Bidding Work Scope(s)
32 Heath Line	KGM	9211 HW453 Angera MN	(218)666.5698	(218)666-5708	neath @ Igmcontractors.com	Libil
33 NEAL HOR	METNON SC KORTBEIN	HIADLER ELEVATUR	(651) 406-5300			is.schindler.aum Elevater
34 35 Steve of	Ison Itanson	Precast Made Corone Mu	763-493-6218	763-425-177	7 Steve.olson@	chauson com precast
36						
37						
38						- 1841
39						744
40						
41		***************************************				
42						



Closer to everywhere.

PRE-BID MEETING SIGN-IN SHEET

"Duluth International Airport – New Parking Structure and Exterior Wayfinding Signage"
"Bid Package 2D"

Name 43 CR41G		mpany MBJ	Address 501 LAKE AVE SOUTH #300 DULUTH, MN 55804	Phone Number 218-722- 1056	Fax <u>Number</u> 2/8-722 — 9306	E-Mail Address CBURSCH C WBJENG. COM	Bidding Work Scope(s)
14 Chal	5+0/0	James 1 states of 3		281-393 6936 218 879-97 2204	112	chal. stilp Ojamurcompan	
46	Adatisen		S TO				TO IS
<u>48</u>							
<u>49</u> <u>50</u>					· without de		
<u>51</u> <u>52</u>	· · · · · · · · · · · · · · · · · · ·						



Closer to everywhere.

PRE-BID MEETING SIGN-IN SHEET

"Duluth International Airport – New Parking Structure and Exterior Wayfinding Signage"
"Bid Package 2D"

<u>Name</u>	Company	Address	Phone Number	Fax Number	E-Mail Address	Bidding Work Scope(s)
53 DAVID	NELSON VLIPA	10 P.O.Box 340 Clos	Z/8-384.	-4266 384-4/10	WELDOWD VILLA	
55 Prav / 15 /					RIGHIOS 16ANDE	9 WEUSCONGRETE, COM
54 RICK OSTE	MANO WELLS	CONQUETE 623 N. LILAC MPLS, MN 5	ba. 612-756	. 4662 763.54	14.0642	ONEUSCONARTE COM
,	•	MPLS, MN 5	5449		•	
55						29
56				· ************************************	, , , , , , , , , , , , , , , , , , ,	
57						
<u> </u>						
58						
59						1995
<u>60</u>			· · · · · · · · · · · · · · · · · · ·	······································		1744, 1
61						
<u>~</u>				*****		
62						



Closer to everywhere.

PRE-BID MEETING SIGN-IN SHEET

"Duluth International Airport – New Parking Structure and Exterior Wayfinding Signage"
"Bid Package 2D"

Kraus-Anderson_® Construction Company Work Site Trailer

May 23, 2013

<u>Name</u>	Company	Address	Phone Number	Fax Number	E-Mail Address	Bidding Work Scope(s)
1 John E. Hippchen	RS&H	4525 Airport Approach Rd Duluth MN 55811	218-722-1227	218-722-1052	john.hippchen@rsa	ndh.com 10.20D
2 John Venglarek	HAZNON	7844 W Central Ave Was	8 H, 43571 419	1-410-1315 419-841-	760 John .Veng	icircle (O Haizmonsigu. com 10.20, D
3					1994 A	
4					The state of the s	
5			-	11 TO 12		
6		,		, was foods to		——————————————————————————————————————
7				***************************************		
8						100
9						
10				*****	N-1-	





Pre-Bid Meeting Agenda May 29, 2013 @ 2:00 p.m.



Duluth International Airport New Parking Structure and Exterior Wayfinding Signage BP-2D

Attendance Sheet

1. Everyone must sign the attendance sheet. Make sure to write clearly and write down what Work Scope(s) you are bidding along with your contact information.

Project Team

- 1. Owner Duluth Airport Authority:
 - a. Tom Werner Executive Director.
 - b. Blaine Peterson Operations Director.
 - c. Ryan Welch Airport Facilities Manager.
- 2. Design Team:
 - a. Marc Godzina Aviation Architect Reynolds, Smith & Hills, Inc.
 - b. John Hippchen Civil and Aviation Engineer Reynolds, Smith & Hills, Inc.
 - c. Brian Morse Senior Registered Architect TKDA Architects.
 - d. Paul Johnson Structural Engineer Meyer Borgman Johnson.
- 3. Construction Manager Kraus-Anderson® Construction Company:
 - a. Mike Dosan Sr. Project Manager.
 - b. Andy Towner Project Manager.
 - c. Steve Bergerson Project Superintendent.
 - d. Kim Lofquist Project Assistant.

Project Description

- 1. The bidding is for BP-2D New Parking Structure and Exterior Wayfinding Signage. This project is a New project, completely separate from the Terminal project.
- 2. The parking structure is a four-story structure consisting of cast-in-place below grade footings, foundations, and slab; and, three levels of precast walls and planks above grade. There are two circulation towers with an elevator in the Northeast tower. The DAA maintenance area will be enclosed and tempered. All other areas are open air.
- 3. The skywalk will connect the parking structure to the second floor mezzanine of the existing terminal. This work is not scheduled to start until June of 2014.
- 4. The signage package consists of both interior signage and exterior wayfinding signage.

Work Scope Overview

- 1. There is a total of 19 Work Scopes for bidders to submit their bids on.
- 2. See Specification section 01 01 40 for Work Scope Descriptions and Work Scope Index for quick reference as to the Specification sections you will be responsible for bidding.
- 3. Review Work Scopes from PowerPoint to better inform bidders.

Bidding Requirements

- 1. Bid Form Packet Sent after last Addendum has been issued:
 - a. Affidavit of Non-Collusion.
 - b. EEO Certificate.
 - c. DBE Utilization Form.
 - d. Letter of Intent Certificate of Good Faith Effort.
 - e. Bid Form.
- 2. Bid Due Date June 11, 2013 @ 2:00 p.m. at the City of Duluth Purchasing.
- 3. This project has a Project Labor Agreement that will be signed after award.
- 4. Buy American Certification Skywalk Only. See under Mandatory Contract Provisions.

Schedule


- 1. See Civil Plans for civil and utility demolition phasing.
- 2. Parking Structure Milestone Schedule:
 - a. Site work starts July 15, 2013.
 - b. Concrete footings and foundations complete by September 30, 2013.
 - c. Precast construction complete by December 27, 2013.
 - d. Parking structure substantial completion by March 14, 2013.
 - e. Parking structure final completion by April 18, 2013.
- 3. All work associated with the Skywalk will not start until June of 2014.

Other Issues

- 1. Safety.
- 2. Security John Hippchen and Andy Towner explanation to bidders.
- 3. Coordination with Owner, Architect, Engineers, and Construction Manager.
- 4. Issuing of Final Addendums Addendum #1 already issued, Addendum #2 Friday, May 31, 2013. Addendum #3 by Friday, June 7, 2013.
- 5. All questions are due to Kim Lofquist, @ kim.lofquist@krausanderson.com, by 5PM on June 5th. Answers will be issued with the final addendum.
- 6. DAA Items Blaine and Ryan

Questions & Closing Comments

- 1. Bidder questions.
- 2. Additional site visits coordinate with Construction Manager.
- 3. Tour of building hard hats, vests, and safety glasses required.

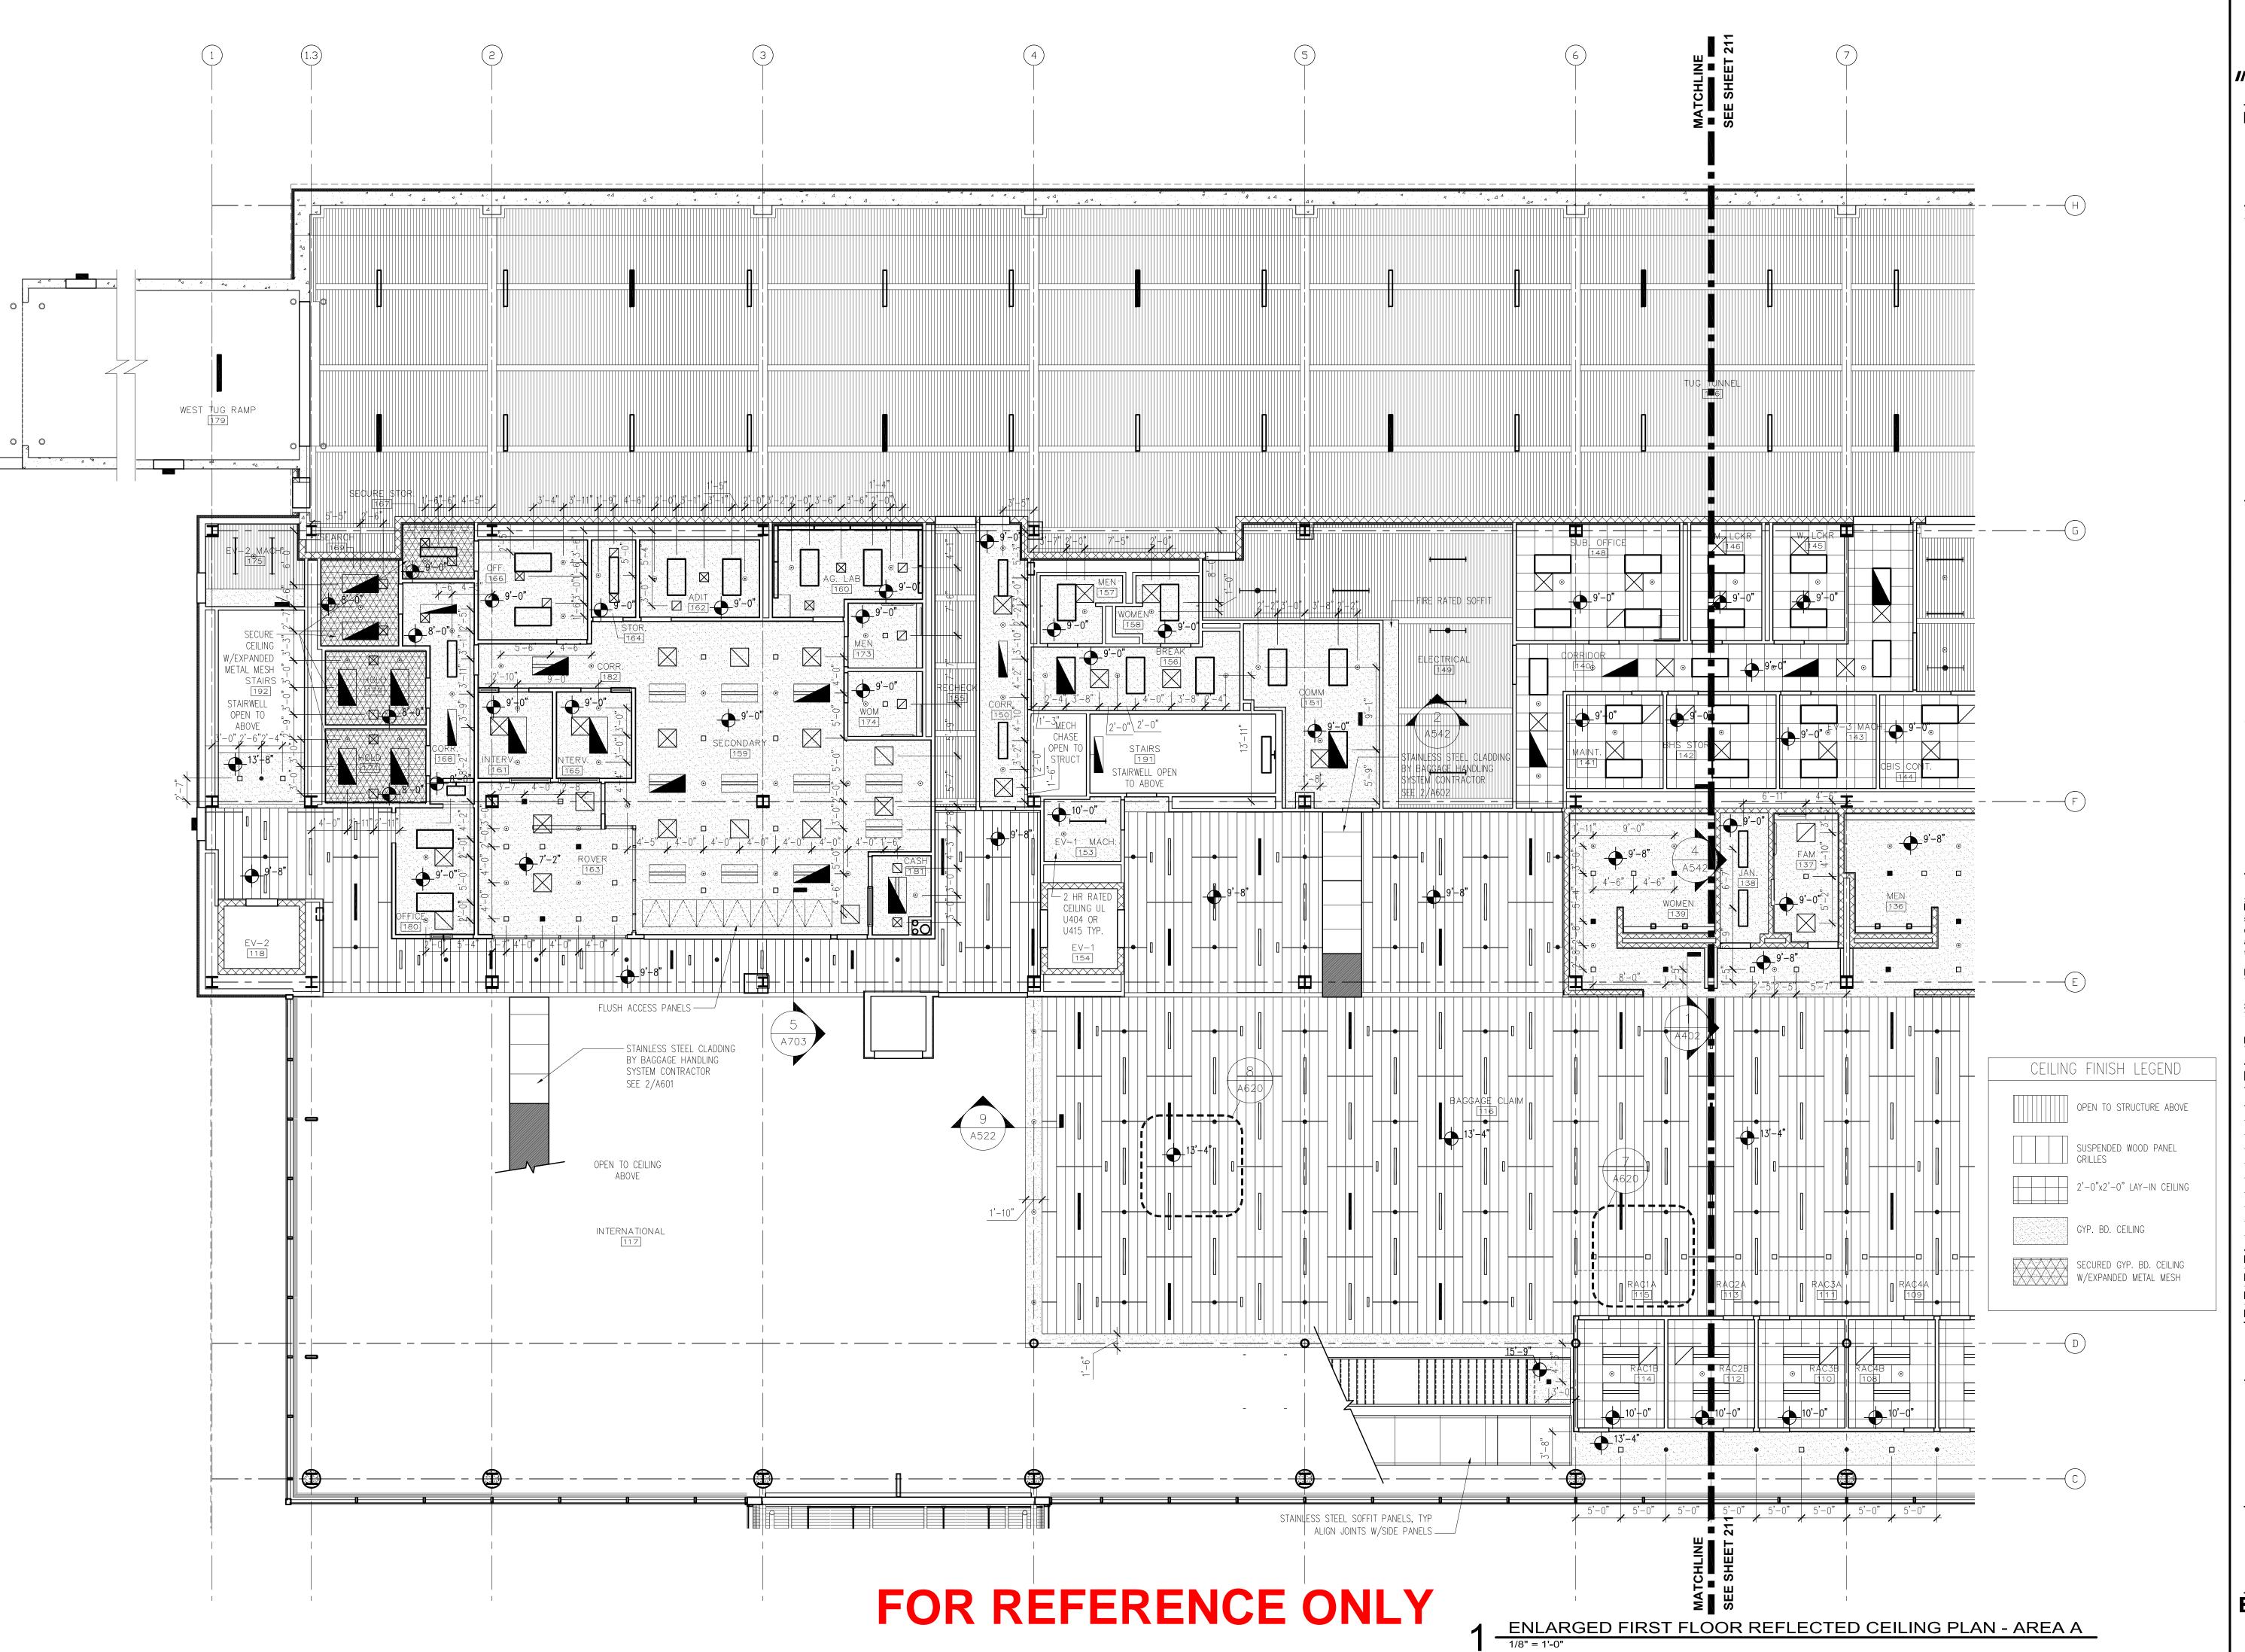



Reynolds, Smith and Hills, Inc.

4525 Airport Approach Rd, Ste A
Duluth, Minnesota 55811

218-722-1227 Fax: 218-722-1052 www.rsandh.com



DULUTH INTERNATIONAL AIRPORT DULUTH, MN

NEW PASSENGER TERMINAL

CONSULTANTS

Interior Architects:

SJA ARCHITECTS

11 E Superior Street Suite 340, Duluth MN 55802
TEL: (218) 724-8578 / FAX: (218) 724-8717

Structural Engineers:

MBJ CONSULTING ENG.

501 Lake Avenue South, Suite 300, Duluth MN 55802

TEL: (218) 722-1056 / FAX: (218) 722-9306

M/E/P/FP Engineers:

COSENTINI ASSOCIATES INC.

1 South Wacker Drive, 37th Floor, Chicago IL 60606
TEL: (312) 201-7408 / FAX: (312) 201-0031

Baggage Handling Systems Consultants:
BNP ASSOCIATES INC.

101 East Ridge Office Park, Suite 103, Danbury CT 06810
TEL: (203) 792-3000 / FAX: (203) 792-4900

Landscaping Consultants:

APPOLD DESIGN

2432 East First Street, Duluth MN 55812

TEL: (218) 591-5079

ARCHITECTURAL CERTIFICATION
I hereby certify that the architectural plans, specifications or report was prepared by me or under my direct supervision and that I am a duly licensed Professional Architect under the laws of the State of Minnesota.

Print Name: Mark Ip

Date: 06-03-10 Reg. No.: 46001

NO.	DESCRIPTION	DATE
	100% REVIEW	12.15.10
	BID PACKAGE 2A	1.24.11
1	BP2A - ADDENDUM 6	3.11.11
	BP2A CONFORMANCE SET	5.2.11
	BID PACKAGE 2B REVIEW	7.6.11
	BID PACKAGE 2B	8.23.11
2	BP2B ADDENDUM 2	9.15.11
	BP2B CONFORMANCE	10.21.11
	BID PACKAGE 2C	2.10.12
	BP2C CONFORMANCE	3.20.12

DATE ISSUED: 03-20-12
REVIEWED BY: TC

DRAWN BY: MKG/MI
DESIGNED BY: TC

AEP PROJECT NUMBER

213-1882-091 © 2010 REYNOLDS, SMITH AND HILLS INC.

SHEET TITLE

ENLARGED
FIRST FLOOR
REFLECTED CEILING
PLAN AREA A

SHEET NUMBER

A210

BID PACKAGE 2C CONFORMANCE

Drawing: T:\P\2131882.091 Duluth New Terminal\Cad\A\Sheets\A210 Enlarged First Floor RCP Area A.dwg Plotted on: 3/21/2012 9:07 PM



Date: May 31, 2013

RE: City of Duluth Bid #13-4401

New Parking Structure and Exterior Wayfinding Signage

Bid Package 2D

Addendum No. 2

TO: Prospective Bidders

This Addendum forms a part of the Contract Documents and modifies the original Bidding Documents dated April 15, 2013. Acknowledge receipt of this Addendum in the space provided on the Bid Form. Failure to do so may subject the Bidder to disqualification.

1.0 PROJECT MANUAL

1.1 Bid Form:

1.2 Table of Contents:

<u>Volume 2 of 2 – Part 11 Division 03 Concrete:</u> **Delete Section 03 41 01 Precast Hollow Core Slab** from Table of Contents.

<u>Volume 2 of 2 – Part 11 Division 01 General Requirements:</u> Add Section 01 23 00 Alternates to the table of contents.

1.3 Technical Specifications:

<u>Volume 1 – Part 9 Special Provisions, SP 7.3 Salvage and Reinstall Gate Operator w/New Loops:</u>

Add the following text: Contractor shall also relocate and reconnect the existing communication conduit and wire to the gate arm at the new location. Additional conduit, communication wire and handholds will be incidental to the cost. (See attached drawing for reference).

<u>Volume 1 – Part 11 Division 1-49 Technical Specifications, Division 1 – General Requirements:</u>

Add: Specification Section 01 23 00 Alternates in its entirety. (5 pages)

<u>Volume 2 – Part 11 Division 1-49 Technical Specifications Division 03 Concrete:</u>

Delete Specification Section 03 41 01 Precast Hollow Core Slab in its entirety.

<u>Volume 2 – Part 11 Division 1-49 Technical Specifications Division 03 Concrete:</u>

Revise Specification Section 03 45 00 Architectural Wall Panels: Delete Section 1.5.A, items 2, 3, and 4.

Volume 2 - Part 11 Division 1-49 Technical Specifications Division 03 Concrete:

Section 03 41 00 Precast Structural Concrete: Section 1.2A1 add the following to read:

- 1. Precast structural concrete as indicated on drawings. Examples could include:
 - (a) Solid and hollow core flat slabs
 - (b) Single and double tees
 - (c) Columns, beams and spandrels
 - (d) Stairs and risers
 - (e) Structural (non-architectural) solid or insulated flat wall panels
 - (f) All other structural precast elements not specifically noted above

DULUTH AIRPORT AUTHORITY NEW PARKING STRUCTURE AND EXTERIOR WAYFINDING SIGNAGE BID PACKAGE 2D ADDENDUM NO. 2 DATED MAY 31, 2012. REYNOLDS, SMITH & HILLS, INC. KRAUS-ANDERSON CONSTRUCTION CO.



Volume 2 – Part 11 Division 1-49 Technical Specifications Division 09 Painting:

Revise Specification Section 09 91 00 Painting:

Add Section 1.1.A, item 4, to read:

4. Parking stall lines and markings.

Add Section 3.5.F, to read:

- F. Parking Stall Lines and Markings:
 - 1. 1 coat PPG Zoneline Traffic and Zone Marking Paint, Latex.
 - 2. Follow manufacturers' recommendations for surface cleaning/preparation and application.
 - 3. Typical line markings to be 11-53 White.
 - 4. No parking / access aisle markings to be 11-54 Yellow
 - 5. Handicap symbols and line marking to be 11-55 Handicap Blue

2.0 DRAWINGS: Replace drawings listed below with sheets included with this Addendum No. 2

Structural Drawings: Replace (S-Series) in its entirety - 17 sheets.

Drawing A701:

Door Schedule: Remove Note 3 from Door 301

Replace original issue for bid drawings with sheets included with this addendum No. 2:

A104 Enlarged Skywalk Plans
A302 Enlarged Skywalk Elevation

E002 Luminaire Schedule and Notes

E010 Electrical Site Plan

E100 Lower Level Electrical Plan

E101 First Level Electrical Plan

E102 Second Level Electrical Plan

E103 Third Level Electrical Plan

E104 Skywalk Electrical Plan

E601 Electrical and Communication Riser Diagrams

E701 Electrical Panel Schedules

3.0 OTHER:

END OF ADDENDUM NO. 2

NEW PARKING STRUCTURE AND EXTERIOR WAYFINDING SIGNAGE DULUTH INTERNATIONAL AIRPORT DULUTH. MINNESOTA

SECTION 01 23 00 - ALTERNATES

PART 1 - GENERAL

1.1 RELATED DOCUMENTS

A. Drawings and general provisions of the Contract, including General and Supplementary Conditions and other Division 1 Specification Sections, apply to this Section.

1.2 SUMMARY

A. This Section includes administrative and procedural requirements for alternates.

1.3 DEFINITIONS

- A. Alternate: An amount proposed by bidders and stated on the Bid Form for certain work defined in the Bidding Requirements that may be added to or deducted from the Base Bid amount if Owner decides to accept a corresponding change either in the amount of construction to be completed or in the products, materials, equipment, systems, or installation methods described in the Contract Documents.
 - A. The cost or credit for each alternate is the net addition to or deduction from the Contract Sum to incorporate alternate into the Work. No other adjustments are made to the Contract Sum.

1.4 PROCEDURES

- A. Coordination: Modify or adjust affected adjacent work as necessary to completely integrate work of the alternate into Project.
 - A. Include as part of each alternate, miscellaneous devices, accessory objects, and similar items incidental to or required for a complete installation whether or not indicated as part of alternate.
- B. Notification: Immediately following award of the Contract, notify each party involved, in writing, of the status of each alternate. Indicate if alternates have been accepted, rejected, or deferred for later consideration. Include a complete description of negotiated modifications to alternates.
- Execute accepted alternates under the same conditions as other work of the Contract.
- D. Schedule: A Schedule of Alternates is included at the end of this Section. Specification Sections referenced in schedule contain requirements for materials necessary to achieve the work described under each alternate.

PART 2 - PRODUCTS (Not Used)

PART 3 - EXECUTION

3.1 SCHEDULE OF ALTERNATES

A.	Alternate No. 1A: Work Scope 8.40D
	Replace aluminum-framed entrances as shown on A701 and specified in 08 41 13 with sliding automatic entrances as shown on A701 (remark note 3) and A703 and specified in 08 42 29.23 for the parking structure and skywalk.
	Add the sum of:Dollars (\$).
B.	Alternate No. 1B: Work Scope 26.10D
	Provide and install automatic door operator circuit as required at all sliding automatic entrances. Refer to the door schedule on A701 (remark note 3), A703 details, and electrical plans for the extent of this alternate.
	Add the sum of:Dollars (\$).
C.	Alternate No. 2: Work Scope 3.40D
	Provide an acid etch / sand blast with integral color finish as outlined in specification section 03 45 00 and shown on architectural plans in lieu of "As-Cast" panel finish.
	Add the sum of:Dollars (\$).
D.	Alternate No. 3A: Work Scope 9.60D
	Replace linoleum flooring with thin set epoxy terrazzo floor in the skywalk to match existing terminal mezzanine terrazzo. Note: Terrazzo inside existing terminal (north of door 302C) is to be included in base bid.
	Add the sum of:Dollars (\$).
E.	Alternate No. 3B: Work Scope 9.65D
	Replace linoleum flooring with thin set epoxy terrazzo floor in the skywalk to match existing terminal mezzanine terrazzo. Note: Terrazzo inside existing terminal (north of door 302C) is to be included in base bid.
	Add the sum of:Dollars (\$).


F.	Alternate No. 4: Work Scope 26.10D	
	Replace metal halide light fixtures in the as shown on the electrical plans.	ne Parking Structure with LED light fixtures
	Add the sum of:	_Dollars (\$).
G.	Alternate No. 5: Work Scope 26.10D	
	Replace fluorescent light fixtures in the on the electrical plans.	e Skywalk with LED light fixtures as shown
	Add the sum of:	_Dollars (\$).
H.	Alternate No. 6: Work Scope 26.10D	
	Provide and install exterior light fixture shown on electrical plan and schematic	es Type F1, wiring, and control wiring as control diagram.
	Add the sum of:	_Dollars (\$).
I.	Alternate No. 7: Work Scope 26.10D	
		tlets as shown on electrical plans wired to is pathway for comm, so work associated ampleted until the summer of 2014.
	Add the sum of:	_Dollars (\$).
J.	Alternate No. 8: Work Scope 26.10D	
	using CAT6 wire in conduit. Provid supply, setup, licenses, and any softw. Management System. Note: Undersid	as shown on electrical plan wired to GCTC e CCTV 24 port POE switch with power are additions necessary for Terminal Video e of skywalk is pathway for comm, so work will not be completed until the summer of
	Add the sum of:	_Dollars (\$).
K.	Alternate No. 9: Work Scope 26.10D	
		ards as shown on electrical prints. Include rete, and backfill work associated with the on E150 and E002.
	Add the sum of:	Dollars (\$).


L.	Alternate No. 10A: Work Scope 3	3.40D			
	others) along grid line B instead	cast panels with openings for mesh infill (by l of solid concrete panels with no openings. l. The panels on the north wall of DAA Parking this space is tempered.			
	Add the sum of:	Dollars (\$).			
M.	Alternate No. 10B: Work Scope 5	5.10D			
	Provide and install wire mesh infills along grid line B as shown on architecturary plans and specified in section 05 75 12 "Wire Cloth". The panels on the north wall of DAA Parking 104 are not to receive openings as this space is tempered Note: This alternate is only for the wire mesh infill at grid line B. Reference Alternate No. 11 for wire mesh infill at exterior walls.				
	Add the sum of:	Dollars (\$).			
N.	Alternate No. 10C: Work Scope 7	7.10D			
	plans and specified in section 05 wall of DAA Parking 104 are not t	Ils along grid line B as shown on architectural 75 12 "Wire Cloth". The panels on the north o receive openings as this space is tempered. The wire mesh infill at grid line B. Reference I at exterior walls.			
	Add the sum of:				
Ο.	Alternate No. 11A: Work Scope 5	5.10D			
		infill at exterior wall panels as shown on section 05 75 12 "Wire Cloth". This alternate line B.			
	Add the sum of:	Dollars (\$).			
P.	Alternate No. 11B: Work Scope 7	7.10D			
		infill at exterior wall panels as shown on section 05 75 12 "Wire Cloth". This alternate line B.			
	Add the sum of:	Dollars (\$).			

Q.	Alternate No. 12A: Work Scope 5.10	D
		System as shown on A522 and specified in ons". Include coordination with roofing
	Add the sum of:	_Dollars (\$).
R.	Alternate No. 12B: Work Scope 7.10	D
	Provide and install Louvered Screen Section 05 50 00 "Metal Fabrications".	System as shown on A522 and specified in
	Add the sum of:	_Dollars (\$).

END OF SECTION 01 23 00

FOR REFERENCE ONLY

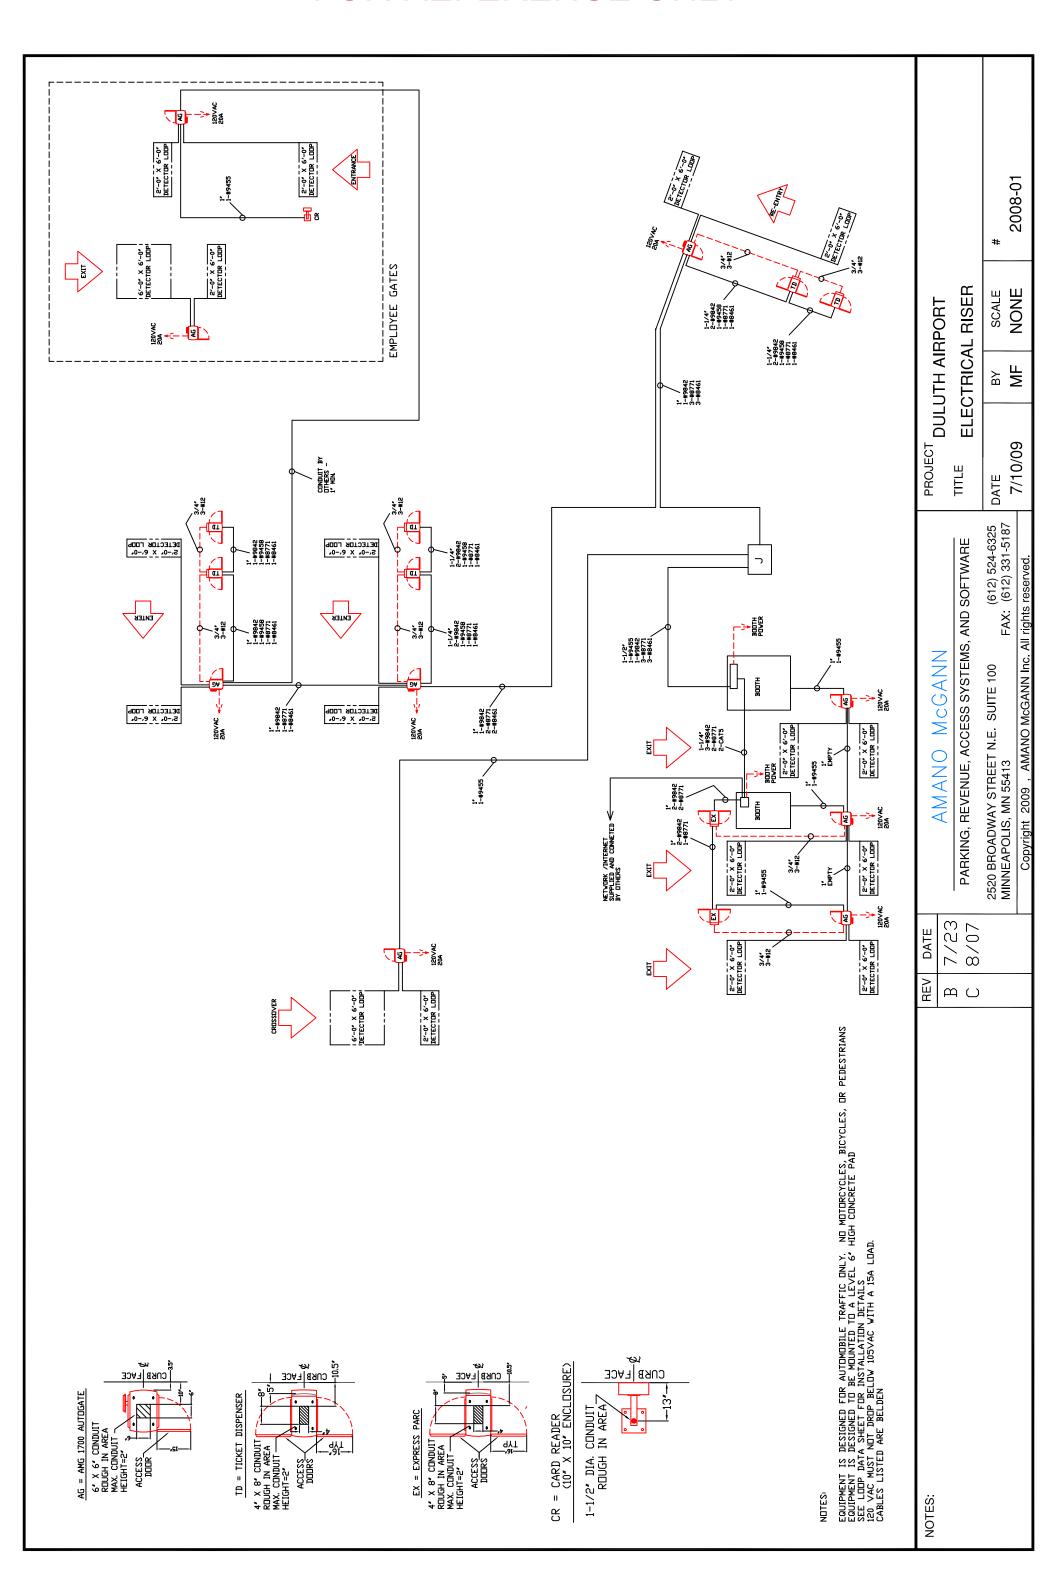

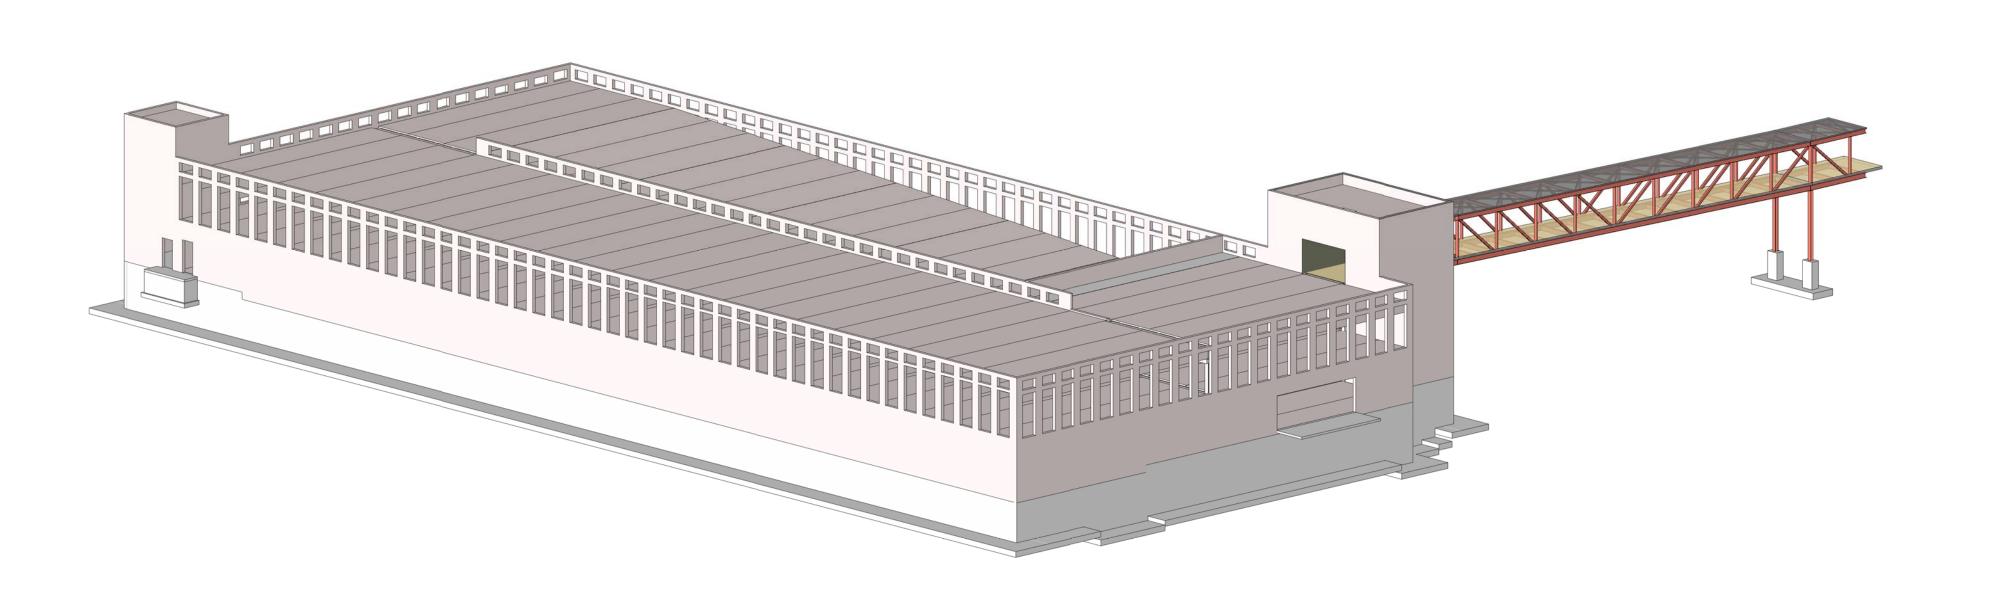

SHEET LIST

SHEET#	SHEET NAME
S001	TITLE SHEET
S002	GENERAL STRUCTURAL NOTES
S100	FOUNDATION PLAN
S101	FIRST LEVEL FRAMING PLAN
S101A	FIRST LEVEL LOAD MAP
S102	SECOND LEVEL FRAMING PLAN
S102A	SECOND LEVEL LOAD MAP
S103	THIRD LEVEL FRAMING PLAN
S103A	THIRD LEVEL LOAD MAP
S104	SKYWALK FLOOR AND ROOF FRAMING PLANS
S301	TRUSS ELEVATION AND DETAILS
S401	SCHEDULES
S501	STRUCTURAL FOUNDATION DETAILS
S502	STRUCTURAL FOUNDATION DETAILS
S503	STRUCTURAL FOUNDATION DETAILS
S701	STRUCTURAL FRAMING DETAILS
S702	STRUCTURAL FRAMING DETAILS

STRUCTURAL ABBREVIATIONS:

GAGE/GAUGE

GALVANIZED

GRADE BEAM

GENERAL CONTRACTOR GLUE LAMINATED BEAM

GENERAL STRUCTURAL NOTES
GYPSUM WALL BOARD

		Н		Q	
DL J	ADDITIONAL ADJACENT	HK HORIZ	HOOK HORIZONTAL	QTY	QUANTITY
Ī	ALTERNATE	HSA	HEADED STUD ANCHOR	R	
JM	ALUMINUM	HSS	HOLLOW STRUCTURAL SHAPE	R	RADIUS
CH	ANCHOR ROD ARCHITECT	HT	HEIGHT	RD	ROOF DRAIN
JI I	ARGITLET	1		REF	REFERENCE
		1		REINF	REINFORCEMENT/REINFORCING
		ID	INSIDE DIAMETER	REQD	REQUIRED
=	BOTTOM OF DECK ELEVATION	ISF	INSIDE FACE	RO	ROUGH OPENING
_	BEAM			RTU	ROOF TOP UNIT
l	BOTTOM BEARING PLATE / BASE PLATE	J		S	
	BOTTOM REINFORCING		100.17		
VN	BETWEEN	JT JBE	JOINT JOIST BEARING ELEVATION	SB	SOIL BORING
		JDE	JOIST BEARING ELEVATION	SC	SLIP CRITICAL
		K		SCHED	SCHEDULE
NTL	CANTILEVER			SER SF	STRUCTURAL ENGINEER OF RECORI SQUARE FOOT
	CENTER TO CENTER	K	KIPS	SIM	SIMILAR
	CAST IN PLACE	KLF	KIPS PER LINEAL FOOT	SL	SNOW LOAD
3	CENTER OF GRAVITY STRAND	KSF	KIPS PER SQUARE FOOT	SOG	SLAB ON GRADE
	CONTROL JOINT COMPLETE JOINT PENETRATION	KSI KO	KIPS PER SQUARE INCH	SPA	SPACES
	CENTER LINE	NU	KNOCK OUT	SPEC	SPECIFICATION
2	CLEAR	L		SPF	SPRUCE PINE FIR
J	CONCRETE MASONRY UNIT			SS SSLT	STAINLESS STEEL SHORT-SLOT LOAD TRANSVERSE
_	COLUMN	LB(S)	POUND(S)	STD	STANDARD
IC	CONCRETE	LL	LIVE LOAD	STIFF	STIFFENER
IN(S)	CONNECTION(S)	LLH LLV	LONG LEG HORIZONTAL LONG LEG VERTICAL	STL	STEEL
IST IT	CONSTRUCTION CONTINUOUS	LONG	LONGITUDINAL	STRUCT	STRUCTURE / STRUCTURAL
• •	CONTINUOUS	LSL	LAMINATED STRAND LUMBER	SYM	SYMMETRICAL
		LWT	LIGHT WEIGHT	SYP	SOUTHERN YELLOW PINE
		LVL	LAMINATED VENEER LUMBER	Т	
	NAIL DIAMETER			<u>'</u>	
	BAR DIAMETER	M		T/G	TOUNGE AND GROOVED
١.	DEFORMED BAR ANCHOR DOUBLE	MAX	MAXIMUM	TBE	TOP OF BEAM ELEVATION
3	DEGREE	MECH	MECHANICAL	TDE	TOP OF DECK ELEVATION
ЙO	DEMOLITION	MEP	MECHANICAL, ELECTRICAL & PLUMBING	TEMP	TEMPORARY
	DOUGLAS FIR-LARCH	MEZZ	MEZZANINE	TFE	TOP OF FOOTING ELEVATION
	DIAMETER	MFR	MANUFACTURER	TGBE TPCE	TOP OF GRADE BEAM ELEVATION TOP OF PILE CAP ELEVATION
3	DIAGONAL	MIN	MINIMUM	TPE	TOP OF PIER ELEVATION
	DEAD LOAD	MISC MTL	MISCELLANEOUS METAL	TR	TOP REINFORCING
		IVIIL	WETAL	TRANS	TRANSVERSE
	EACH	N		TSE	TOP OF SLAB ELEVATION
	EACH FACE			TWE	TOP OF WALL ELEVATION
_	ELEVATION	NIC N.S	NOT IN CONTRACT NORTH - SOUTH DIRECTION	TYP	TYPICAL
C	ELECTRICAL	N-S NTS	NOT TO SCALE	U	
:V	ELEVATOR EXPANSION JOINT	NWT	NORMAL WEIGHT		
BED	EMBEDMENT			UNO U	NLESS NOTED OTHERWISE
	EQUAL	0		URM U	NREINFORCED MASONRY
JIP	EQUIPMENT		ON CENTER	1.7	
	EACH SIDE	OC OD	ON CENTER OUTSIDE DIAMETER	V	
ı	EACH WAY	OSF	OUTSIDE DIAMETER OUTSIDE FACE	VERT	VERTICAL
1	EAST - WEST DIRECTION EXISTING	OPNG	OPENING	V = 1 \ 1	
)	EXPANSION	OPP	OPPOSITE	W	
	_,	O/O	OUT TO OUT	18.7	
		Р		W/	WITH
				W/O WD	WITHOUT WOOD
	FOUNDATION	PAF	POWER ACTUATED FASTENER	WF	WIDE FLANGE
	FLOOR DRAIN	PC	PRECAST CONCRETE	WL	WIND LOAD
	FINISHED FLOOR ELEVATION	PL	PLATE	WP	WORK POINT
	FLOOR	PLF BLVWD	POUNDS PER LINEAL FOOT	WT	WEIGHT
	FOOTING STEP	PLYWD PRE FAB	PLYWOOD PREFABRICATED	WWF	WELDED WIRE FABRIC
	FEET	PROJ	PROJECTION		
	FOOTING FIELD VERIFY	PSF	POUNDS PER SQUARE FOOT		
	LICED VEIGHT	PSI	POUNDS PER SQUARE INCH		
		PSL	PARALLEL STRAND LUMBER		
		PT	POST TENSIONED		


MARKS AND SYMBOLS LEGEND:

MARI	KS:	GENERAL S'	YMBOLS:
B1001	CONCRETE BEAM MARK NUMBER		APPROXIMATE LOCATION OF DRAIN TILE
BP1	BEARING / BASE PLATE MARK NUMBER		MATCH LINE
BRF1	BRACE FRAME MARK NUMBER		
BR1	MILD STEEL BOTTOM REINFORCING MARK NUMBER		LINE OF DEMOLITION
C1	COLUMN MARK NUMBER	(5,-5,,)	SLAB STEP LOCATION WITH ELEVATIONS
CC1	CONCRETE COLUMN MARK NUMBER		
D1	STEEL DECK MARK NUMBER		SLAB STEP LOCATION
DC1	DROP CAPITAL MARK NUMBER		CHANGE IN SLAB SLOPE
DP1	DRILLED PIER MARK NUMBER	····//	
EP1	EMBEDDED PLATE MARK NUMBER	777	CHANGE IN SLAB THICKNESS
F1	SPREAD FOOTING MARK NUMBER		
GB1	GRADE BEAM MARK NUMBER	(1)	KEY NOTE MARK NUMBER
HCP	HOLLOW CORE PLANK		
HD1	HOLD DOWN MARK NUMBER	(0)— – —	NEW BUILDING GRID LINE
J10	JOIST MARK NUMBER		
L1	LINTEL MARK NUMBER	[0]	EXISTING BUILDING GRID LINE
LC1	LIGHT GAGE COLUMN MARK NUMBER		
MC1	MASONRY COLUMN MARK NUMBER	•	- ELEVATION MARKER
MF1	MOMENT FRAME MARK NUMBER		
P1	PIER MARK NUMBER		SHADED AREA INDICATES EXISTING CONSTRUCTION
PC1	PILE CAP MARK NUMBER	₩ 1 —	WALL MARK NUMBER
PTB101	POST TENSIONED CONCRETE BEAM MARK NUMBER	WI	<u></u>
S1	SLAB MARK NUMBER	EEEER	APPROXIMATE LOCATION OF UTILITY PIPE PENETRATION THROUGH FOUNDATION WALL
SC1	STEEL COLUMN MARK NUMBER	<u> </u>	FENETRATION THROUGHT CONDATION WALL
SR1	STUD RAIL REINFORCING MARK NUMBER	FS	FOOTING STEP LOCATION
SW1	SHEAR WALL MARK NUMBER	SB1	APPROXIMATE LOCATION OF SOIL BORING
T1	TRUSS MARK NUMBER	()	COMPRESSION PILE
TR1	MILD STEEL TOP REINFORCING MARK NUMBER	()	COMPRESSION FILE
W1	WALL MARK NUMBER	$(\overline{1})$	TENSION / COMPRESSION PILE
WC1	WOOD COLUMN MARK NUMBER	45	
WF1	WALL FOOTING MARK NUMBER	\otimes	TEST PILE
WO1	WEB OPENING	_	SPAN DIRECTION OF ELEMENT
WSW1	WOOD SHEAR WALL MARK NUMBER	~	
			EXTENT OF ELEMENT


CONTINUOUS EXTENT OF ELEMENT

PLAN SYMBOLS LEGEND:

FOUNDATION SYSTEM:

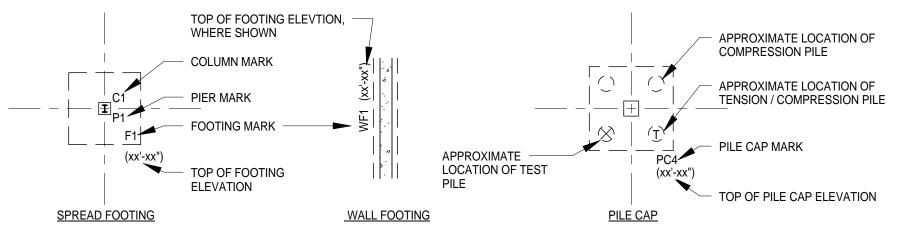

PRECAST CONCRETE FRAMING SYSTEM:

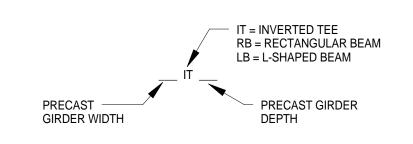


NOTES:


1. PRECAST GIRDER WIDTHS AT INTERIOR BEAM LINES MAY BE ADJUSTED BASED ON THE PRECAST SUPPLIER'S STANDARD

TO STANDARD DEPTHS MAY NOT EXCEED DEPTHS NOTE: 2. PRECAST GIRDER DEPTHS MAY NOT EXCEED DEPTHS NOTED.

STEEL FRAMING SYSTEM:

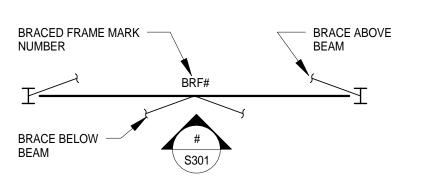

BRACE FRAME

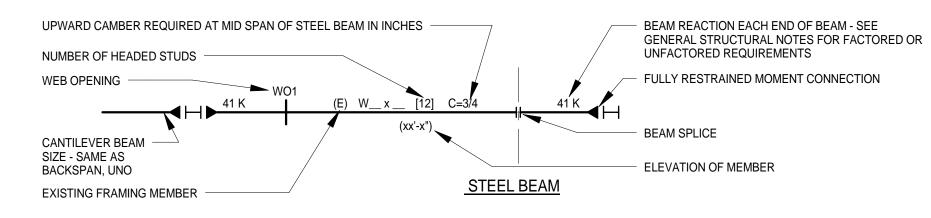



Reynolds, Smith and Hills, Inc.

4525 Airport Approach Rd, Ste A Duluth, Minnesota 55811 218-722-1227 FAX 218-722-1052 www.rsandh.com



DULUTH INTERNATIONAL **AIRPORT DULUTH, MN**

NEW PARKING STRUCTURE AND EXTERIOR WAYFINDING SIGNAGE

CONSULTANTS

Interior Architects: TKDA ARCHITECTS 11 E Superior Street Suite 340, Duluth MN 55802 TEL: (218) 724-8578 / FAX: (218) 724-8717

Structural Engineers: **MEYER BORGMAN JOHNSON** 501 Lake Avenue South, Suite 300, Duluth MN 55802 TEL: (218) 722-1056 / FAX: (218) 722-9306

Landscape Architects: ARCHITECTURAL RESOURCES 126 East Superior Street, Duluth MN 55802 TEL: (218) 727-8481 / FAX: (218) 727-8483

I hereby certify that this plan, specification, or report was prepared by me or under my direct supervision and that I am a duly licensed Professional Engineer under the laws of the State of Minnesota.

Print Name: Paul A. Johnson

Reg. No.: 20379

REVISIONS

Date: 05-15-13

NO.	DESCF	RIPTION	DATE
DATE ISSUED:		05/15/2013	
REVIEWED BY:		PAJ	
DD AWN BV:		Q II	

DRAWN BY: SJL **DESIGNED BY:** MDN / PAJ AEP PROJECT NUMBER

213-1882-114 (C) 2012 REYNOLDS, SMITH AND HILLS INC.

SHEET TITLE TITLE SHEET

SHEET NUMBER

S001

These notes specify the requirements for the design represented in these documents. The construction and materials shall comply with all the pertinent codes and references, plans, and details, including (but not limited to) those shown in architectural, civil, mechanical and electrical drawings.

The contractor shall verify all dimensions and existing conditions in the field that affect construction prior to commencing work on the affected element or shop drawing submittals. Resolve any discrepancies with the architect prior to construction.

The contract structural drawings and specifications represent the completed structure. The contractor is responsible for bracing and

shoring (without overstressing) all structural elements as necessary at any stage of construction until completion of the project. The Structural Engineer is not responsible for the contractor's means, methods, sequences or procedures of construction. Contractor shall recognize and consider effects of thermal movements of structural elements during construction period.

The contractor is solely responsible for site safety including all temporary precautionary measures and safety programs. Site observation visits by the Structural Engineer do not include review of the contractor's safety precautions.

Refer to architectural, mechanical and electrical drawings for locations, elevations, dimensions, and details of sleeves, inserts, openings, recesses, curbs, housekeeping pads, etc. that are not shown on the structural drawings and do not damage structural

Information shown in the structural drawings regarding existing conditions represents the current and general field conditions related to the new work, to the best of our knowledge. Report all discrepancies to the Architect for resolution prior to performing related

Requests for information shall be submitted in writing and shall reference the part of the construction documents that is in question.

<u>SPECIAL INSPECTIONS</u>

Contractor shall read and understand their duties in the specification and under the building code for special inspections and coordinate as necessary the owner's responsibilities.

The special inspectors shall be provided and shall only use approved shop drawings.

Special inspection reports are to be submitted immediately to the SER, Architect, and Contractor daily when inspections are performed.

The general contractor shall provide timely notice to the special inspector and sufficient time for the inspector to perform their inspection.

All engineering design provided by others and submitted for review shall bear the certification stamp and signature of a qualified professional engineer who is licensed in the state where the project is located.

Submit shop drawing schedule with construction schedule that includes consideration for review period. See specification for

SPECIAL INSPECTION SCHEDULE:

4 Stool *	Continuous	Periodic	Not Req'd	See Arch.	T-11- 4704.0
1. Steel * 1.1 Welding		_			Table 1704.3
1.2 Details				님	
1.3 High-strength Bolts			H	H	
2. Concrete					Table 1704.4
2.1 Reinforcing steel including Prestressing tendons					
2.2 Bolts installed in concrete					
2.3 Required design mix					
2.4 Sampling					
2.5 Shotcrete					
2.6 Curing techniques					
2.7 Prestressed concrete					
forces and grouting		_	_		
2.8 Erection of precast concrete members					
2.9 Verification of IN-SITU concrete strength					
3. Masonry					
3.1 Level 1 Special Inspection *					1704.5.1, 1704.5.2, Table 1704.5.
3.2 Level 2 Special Inspection					1704.5.3, Table 1704.5.
4. Wood	П	П		П	1704.6
5. Soils	Π		F	П	1704.7
6. Pile Foundations					1704.8
7. Pier Foundations					1704.9
8. Wall Panel and Veneers					1704.10
Sprayed Fire-Resistant Materials					1704.11
Exterior Insulation and Finish Systems (EIFS)					1704.12
1. Special Cases					1704.13
Smoke Control Systems					1704.14

* Please see referenced tables for exceptions.

DEFERRED SUBMITTALS: The following items shall be issued as deferred submittals per IBC:

Precast Concrete Steel Connections

All items issued as deferred submittals shall be issued a minimum of 30 days prior to installation and shall not be installed until their design and submittal documents have been reviewed for general conformance to the drawings by the general contractor, the engineer of record and the building official. A copy of the deferred submittal shall be forwarded to the city after the engineer of record has reviewed the documents and prior to erection of the deferred submittal items.

DESIGN CODES AND STANDARDS

Minnesota State Building Code, MSBC 2007 2006 International Building Code, as amended and adopted by the MSBC 2007

ACI 318-05 Building Code Requirements for Reinforced Concrete

ACI 530-05 Building Code Requirements for Masonry Structures, Allowable Stress Design

ACI 530.1-05 Masonry Structures

AISC 360-05 Specification for Structural Steel Buildings

AISI NAS-01 North American Specification for the design of Cold-Formed Steel Structural Members including 2004 supplement ASCE 7-05 Minimum design loads for buildings and other structures including supplement NO. 1 and excluding Chapter 14 and Appendix 11A.

ASCE 3-01 Structural Design of Composite Slabs

Grade B Round HSS

Grade B Steel Pipe

Typical (all reinforcing and accessories

MATERIAL PROPERTIES	<u>3:</u>
Reinforcing Steel (Fv):	_

shall be epoxy coated) Weldable	60,000 psi 60,000 psi	ATSM A615 Grade 60 ASTM A706 Grade 60
Cast-in-Place Concrete (f'c) at 28 days, UNO:		
Controlled Low Strength Material (CLSM) Footings Concrete for Underpinning Piers, Walls, Slabs and Beams Columns Concrete placed over Metal Floor Deck 4,000 ps Slabs on Grade Exterior Concrete Masonry Corefill Concrete All Concrete not otherwise noted	1,200 psi Maximur 50 psi Minimum 4,000 psi 3,000 psi 4,000 psi 4,000 psi 4,000 psi 4,000 psi 4,000 psi 3,000 psi 4,000 psi	
Concrete Masonry- Prism (f'm): Typical Units:	2,000 psi	
Structural Steel (Fy): Wide Flanges Angles, Channels, Plates, and Bars Grade B Rectangular HSS	50,000 psi 36,000 psi 46,000 psi	ASTM A992 ASTM A36 ASTM A500

42,000 psi

35,000 psi

ASTM A500

ASTM A53

MATERIAL PROPERTIES (Cont):

ctural Fasteners:		
Typical High-Strength Bolts	92,000 psi	ASTM A325
High-Strength Bolts as noted on plan	150,000 psi	ASTM A490
Grade 36 Anchor Rods, UNO	36,000 psi	ASTM F1554
Threaded Rods	36,000 psi	ASTM A36
Anchor Rods, Grade 55 as noted on plan	55,000 psi	ASTM F1554
Anchor Rods Grade 105 as noted on plan	105,000 psi	ASTM F1554
Direct -Tension Indicator Washers as noted of	n plan	ASTM F959
-formed Light Gauge Metal Framing (Fy):		
Studs, Joists, Braces-16 ga. and heavier	50,000 psi	ASTM A653
Studs, Joists, Braces-18 ga. and lighter	33,000 psi	ASTM A653

33,000 psi

and to indicate on shop drawings.

ASTM A653

Primary Frame Wind Data: Basic Wind Speed: 90 mph Wind Importance Factor: 1.0

Track, Channels and Accessories

Primary Seismic Data: No design required

Exposure:

Component Loads: Supplier to develop based on MSBC 2007 Exterior Component/Cladding:

GRAVITY LOADS:	
Roof Snow Load:	
Ground Snow Load, Pg:	60 psf
Flat-Roof Snow Load, Pf:	42 psf
Snow Exposure Factor, Ce:	1.0
Snow Load Importance Factor, I:	1.0
Unbalanced/Drift Snow Load:	Refer to plan, UNO
Stairs, Corridors and Lobbies:	100 psf
Stair Tread Concentrated Load:	300 lbs
Machanical Danner	405
Mechanical Rooms:	125 psf
Mechanical Room Hanging Loads:	40 psf
Supported Parking Loads:	
Parking Deck, Covered (non-reducib	ole): 40 psf
Parking Deck, Uncovered (non-reduc	
Drive Lane;	42 psf
Parking Stall:	82 psf
Vehicle Impact at 18" AFF:	6000 lbs
Parking Concentrated Load:	2000 lbs
Exterior Site Surcharge Loads:	
Fire Trucks:	250 psf

Sidewalk:

Refer to Geotechnical report number DU-12-02390 prepared by Braun Intertec, dated 9/28/2012.

The contractor shall verify the location of all existing and new underground utilities and tanks prior to beginning excavation and contact Gopher State One Call.

250 psf

The minimum dimension from exterior grade to bottom of footing and foundation shall be 60" adjacent to heated areas, and 72" in unheated areas unless frost protection is provided by insulation

For underground utilities adjacent to foundations and through foundations reference drawings for detail showing step footings below utilities as required to avoid undermining of structure by utilities.

Footings are designed for a minimum allowable soil bearing pressure of 4000 pounds per square foot. It shall be the owner's responsibility to retain a Geotechnical Engineer to verify that this value may be achieved at the bottom of footing elevation without damaging, differential settlement.

All topsoil, fill, organic swamp deposits, and/or other unsuitable bearing material shall be removed below the footings and/or within the building area to the depths indicated in the geotechnical engineering report and extent of removal shall be field verified by the

All excavations shall be observed by a qualified Geotechnical Engineer to verify removal of all unsuitable material, and confirm the proper preparation of bearing conditions. Rock excavation for individual footings is not expected. Blasting is not permitted.

For footings that do not bear on natural undisturbed soil, extend engineered fill laterally beyond bottom edge of footing for a distance equal to the depth of engineered fill. Reference drawings for details.

Foundation and retaining walls shall be back filled with free draining fill approved by the Geotechnical Engineer. Provide drain tile

required by the contract documents and verify with architect and civil engineer.

Backfill equally on both sides of foundation walls to prevent overturning or lateral wall movement, or brace as necessary.

For stepping of wall footings reference drawings for detail.

The detailing, fabrication and erection of all reinforcing shall be done in accordance with the latest edition of ACI-315, "Manual of Standard Practice for Detailing Reinforced Concrete Structures and ACI-318, "Building Code Requirements for Structural

All reinforcing bars are deformed and continuous, unless noted otherwise. Refer to drawings for reinforcing lap length schedule.

Provide suitable wire spacers, chairs, etc. for support of reinforcing steel in proper position while placing concrete. All bars shall be tied to prevent displacement while placing concrete. All chairs and slab bolsters shall be plastic or steel with plastic tips. When reinforcing steel is epoxy coated or p/t tendons are fully encapsulated, all chairs and slab bolsters shall be epoxy coated or plastic and all support bars shall be epoxy coated. Chairs are to be stable and resist tipping. Acceptable products are GTI or

The fabricator shall submit a complete list of accessories and placing details with the shop drawings.

No horizontal construction joints shall be placed in beams, joists, or slabs, unless shown on drawings.

Locate vertical construction joints in beams and slabs at central one third of span. Refer to drawings for details. Submit proposed construction joint locations to the Structural Engineer of Record for review prior to placement of concrete. Where new concrete is placed against existing concrete, the existing concrete shall be roughened to a minimum 1/4" amplitude.

Refer to drawings and ACI 318 Chapter 6 for placement guidelines of embedded pipes, sleeves, and conduits. Conduits are not permitted in slabs 3 inches or less in thickness.

Provide a 3/4 inch chamfer for all exposed concrete corners. See Architectural drawings for details and additional requirements. The general contractor shall notify the Special Inspector a sufficient period in advance of placing concrete to allow required

inspections and testing to occur in a timely fashion.

Aluminum conduit, aluminum sleeves and aluminum embeds are not permitted in concrete. Exterior concrete to have 6% +/- 1% entrained air. All concrete used in parking ramp slabs, beams and columns to contain

Calcium chloride is not permitted as a concrete additive.

Concrete Cover on Reinforcing:

corrosion inhibiting admixtures.

Topping Slab: 3/4" clear top Slab on Grade: upper third of slab Concrete covers are intended to meet the requirements of the IBC 2000 section 719 prescriptive fire protection.

Footings and Caissons: 3" clear bottom and sides 2" clear top

#5 and smaller 1 1/2" clear earth or weather face #6 and greater 2" clear earth or weather face 3/4" interior face Columns and Beams: 1 1/2" clear to ties or stirrups 1" clear top 3/4" clear bottom and sides 1" clear top 3/4" clear bottom carbonate aggregate

1" clear bottom siliceous aggregate

PRECAST CONCRETE - STRUCTURAL:

provide a fully functional diaphragm.

Comply with MNL-116 and /or MNL-117 of the Precast Concrete Institute, ACI- 318, and "Recommendations for Concrete Members Prestressed with Unbonded Tendons" by ACI-ASCE Joint Committee 423.

Precast, prestressed members shall be design for "in place" loads, including superimposed loads shown on the drawings.

Prestressing strands shall conform to the ASTM - A416, "Standard Specification for Steel Strand, Uncoated Seven-Wire for Prestressed Concrete" (including supplements) Grade 250K or 270K.

Precast manufacturer is to design, provide calculations, and furnish steel headers for openings as necessary or as shown on the drawings. Refer to the architectural drawings for fire protection requirements for the steel headers.

The welders for steel connections in precast shall be certified in accordance with AWS D1.1.

Refer to Architectural drawings for fire rating requirements. All members, planks and beams, shall be designed for unrestrained

Provide dovetail masonry anchor slots in precast, prestressed concrete members when used as back-up for masonry veneer.

Professional Engineer who is registered in the state where the project occurs. Precast elements used as a diaphragm system shall be designed to resist all lateral forces as noted on the documents. The precast manufacturer shall be responsible for the complete design of the precast components and all connections necessary to

The precast manufacturer shall submit for review certified shop drawings and design calculations prepared by a qualified

Precast wall elements used as part of the lateral load resisting system shall be designed to resist all diaphragm reactions. The precast manufacturer shall be responsible for the complete design of the elements and all connections necessary to support in plane and out of plane forces.

Wall panels and connections to roof and floor structure shall be designed for lateral loads required by the referenced building code as well as the loads shown on plan. Where no load is shown parallel to the wall panels, design for a minimum in-plane load of 50 plf over the entire wall length. Anchorage of each wall panel to the structure at each level shall include a minimum design load of 200 pounds per linear foot perpendicular to the plane of the wall. (REVIEW ACI 16.5.1.2)

CONCRETE SLABS ON GRADE: he control or construction joints shall be placed as shown on the drawings. The joints shall be spaced at 12'-0" on center each

Refer to the drawings for the typical slab on grade construction and saw cut control joint detail. Control and construction joints

must be continuous and not offset.

The panels formed by control or construction joints shall not be "L" shaped and a rectangular panel's aspect ratio shall not

Refer to drawings for detail of isolation diamonds or circles at columns.

Refer to drawings for reinforcing at re-entrant corners. Bend bars as necessary at obstructions

Refer to the specification for the existence, type, and thickness of interior ground vapor retard. Locate a vapor retarder directly beneath the slab on grade on top of a 6 inch compactable granular base. Refer to the specification for requirements for the compactable granular base.

Mechanically vibrate concrete around trench drains, floor ducts, construction joint dowels, loading docks, architectural features and other embedded items.

Refer to the specification for slab on grade pre-pour meeting.

Refer to the specification for acceptable methods of curing the concrete.

Refer to flooring manufacturer's specification for levelness, flatness and curing of concrete slabs on grade to receive special architectural floor finishes.

All masonry units are placed in running bond fashion. Corners shall have a standard bond by overlapping units.

Special shapes shall be provided for jambs, columns, pilasters, control joints, corners, and lintels.

All masonry walls shall have horizontal joint reinforcing spaced at 16" o.c. Horizontal joint reinforcing shall be truss style and fabricated with galvanized nine-gauge wire and shall include corner and intersecting wall pieces. Provide minimum 6" laps at all

Vertical reinforcing shall be held in place by rebar positioners, crossties, chairs, or tying to every other layer of horizontal reinforcing steel. Refer to the detail in the drawings for vertical reinforcing bar location in a core.

Provide concrete cover of minimum 1/2" to face shell.

Refer to detail in the drawings for reinforcing bar lap lengths.

Extend vertical reinforcing from footings to 2" clear top of wall or to beam bearing. Extend vertical reinforcing into the next level of construction and lap in accordance with the lap schedule.

When typical vertical wall reinforcing is interrupted by long wall openings, provide typical vertical wall reinforcing above and below opening, and extend into horizontal bond beams. Refer to the schedule on the drawings, for masonry wall opening lintels. Refer to the detail in the drawings for masonry openings minimum jamb reinforcing.

Provide vertical reinforcing at the ends of walls and at wall intersections to match specified reinforcing. Run reinforcing full height of walls.

All masonry units shall be placed with full face shell mortar coverage on horizontal and vertical face shells. Webs shall also have full mortar coverage around all grouted cells.

Fill block core at vertical reinforcing (8" minimum length along wall) with concrete grout. Filling cores with mortar is not allowed. Vibrate in place. Roding and puddling are not allowed. Maximum lift height is four feet. For concrete core fill pour height up to maximum 8'-0", provide cleanouts if pour height exceeds

Masonry cement mortar is not allowed.

Calcium chloride or admixtures containing chloride shall not be used in mortar or grout.

For reinforced masonry bond beams, provide bent corner bars at corners and intersections that match reinforcing. Step bond beams as necessary to match roof slopes. Lap reinforcing bars per schedule.

For construction of masonry control joints refer to detail in drawings.

Unless noted otherwise on the drawings place control joints in masonry walls such that no straight run of wall exceeds 24'-0" and within 4'-0" of corners. Do not place control joints within 48 inches of a masonry opening jamb or a steel bearing plate.

Place bond beam reinforcing continuously through control joints. Do not splice bond beam reinforcing within 6'-0" of a control Provide bond beam with reinforcing at all floor lines, mid-height between floor lines, roof lines, and top of walls. Refer to details

in the drawings.

Grout below steel bearing plate and refer to the drawings for additional information.

Refer to drawings for reinforcing schedule, top of wall bracing, thickened bearing slab and lintel schedule for non-bearing masonry walls. Refer to Architectural drawings for location and extent.

MASONRY BEAMS (HIGH-LOW BOND BEAMS): For all masonry beams use lintel blocks.

Masonry beams are to bear 8" minimum at jambs. Extend vertical reinforcing through masonry beam bearing.

Extend horizontal reinforcing full length. Refer to detail in the drawings for stirrup configuration.

Grout masonry beams solid. Mechanically vibrate grout in place.

For brick angle supported by masonry refer to detail in the drawings.

Provide brick expansion joint vertically at the edge of the masonry opening. Stop brick angle at expansion joint. Refer to plan for wall elevation detail. Locate other brick expansion joints per architectural drawings.

LOOSE ANGLE BRICK LINTELS:

Fit lintel such that vertical leg is tight to back of brick, locate brick ties to backup at first bed joint above angle's vertical leg and provide minimum 8" support each end.

Refer to architectural drawing for locations and to drawings for size span criteria, and

EXPANSION AND ADHESIVE ANCHORS: Anchors in concrete or concrete masonry when not exposed to earth, weather, or corrosive environment shall be as noted

Expansion anchors shall be stud type with a single piece three section wedge and zinc plated in accordance with ASTM B633.

Threaded anchor rod for adhesive anchors in concrete shall be ASTM A193, Grade B7, or ASTM A36, as noted in the drawings. The adhesive used for anchors shall be a structural grade, two part epoxy or acrylic material that meets the requirement of ASTM C-881 Types I, II, IV, and V, Grade 3, Classes B and C as noted on plans.

Holes shall be drilled with a bit and cleaned using a method that complies with the manufacturer's guidelines, and specifications. Do not cut or damage reinforcing steel or P-T tendons.

Upon the request of the structural engineer the anchors shall be proof tested by the manufacturer to verify capacity of anchors that do not meet the conditions in the construction documents.

Minimum embedment depths in concrete and concrete masonry for expansion and adhesive anchors shall be as noted below:

For 1/2", 5/8", and 3/4" diameter expansion anchors provide 4 3/4" embed, UNO on plan.

For 1/2" and 5/8" diameter adhesive anchors provide 5" embed. For 3/4" diameter adhesive anchors provide 7" embed, UNO on plan.

Grouted solid concrete masonry unit material: For 1/2", 5/8", and 3/4" diameter expansion anchors provide 4 3/4"embed, UNO on plan.

For adhesive anchors refer to the product's ICBO Report.

Pre-approved manufacturer are as follows: HILTI, ITWR Ramset/Redhead, Powers Fasteners, and Simpson Strong-Tie. For review of alternate products, submit manufacture's product data and product's current ICBO report prior to construction.

Anchors in concrete or concrete masonry when exposed to earth, weather, or corrosive environment shall be manufactured from AISI 304/316 Stainless Steel.

Structural steel shall be detailed, fabricated and erected in compliance with AISC Specification for the design, fabrication, erection of structural steel for building, and Code of standard practice, and OSHA steel erection standards.

All beams and girders shall be cambered at mid-span as indicated on the structural drawings. The cambers indicated shall be present in the beam in its erected position after completion of the end connections and shall be verified prior to placing concrete. Cambering tolerances shall be (-0", +1/4"). No center point cambering allowed.

Splicing structural members where not detailed on the drawings is prohibited without prior approval of the structural engineer.

Modification of structural steel members in the field is not allowed without written approval by the structural engineer. All composite beams using the concrete slab as a compression flange are designed for unshored construction unless noted

Anchor rods shall be minimum 3/4" diameter or as detailed in drawings.

STRUCTURAL STEEL CONNECTIONS

All steel connections shall be designed by the steel fabricator for the criteria indicated on the drawings unless noted or detailed otherwise. Connection design shall conform to the requirements of the AISC Specifications for the design, fabrication, erection of structural and OSHA regulations. Submit calculations certified by a Professional Engineer who is licensed in the state where

Non-composite beams: Unless noted otherwise, design simple beam shear connections per the AISC Manual connection tables. The required end reaction shall be based on the maximum allowable uniform load for the given span or the reactions indicated on the plans. Design connections for the reactions based on the above or for the minimum connection requirements indicated in the Connection Schedule, whichever provides the greater capacity.

Composite beams: Design simple composite beam shear connections per the AISC Manual connection tables UNO. Design connections for the reactions indicated on the plans or the minimum connection requirements indicated in the Connection Schedule, whichever provides the greater capacity.

All beam web copes must be made to a 1 inch minimum radius. Welded connections shall be made in accordance with ANSI/AWS D1.1 Structural Welding Code using E70XX electrodes unless noted otherwise. Weld sizes not shown or controlled by the required forces shall be AWS code minimum size. Welds shall be visually inspected for compliance with the AWS code visual inspection criteria. Welders shall be qualified in accordance with ANSI/AWS D1.1 and shall be experienced in weld in structural steel.

Full penetration welds shall be tested using NDT methods such as ultrasonic, magnetic particle or other methods referenced in the AWS code. Welds subject to NDT methods shall also have been found compliant with the AWS visual inspection criteria.

Unless detailed otherwise, beam shop connections may be welded or bolted and field connections are to be bolted. Bolts shall

be a minimum 3/4" diameter for connections specified or detailed in the drawings. The fabricator may submit an alternate

connection with the calculations that is certified by a professional engineer who is licensed in the state where the project is

Manufacturer shall be a current member of the Steel Deck Institute (SDI).

Detail, manufacture and install steel roof deck and accessories in accordance with the SDI specifications and codes and OSHA requirements.

Steel roof deck shall be as noted on plan.

requirements with the architect.

Welding shall be in accordance with AWS D1.3. Welders shall be qualified in accordance with AWS D1.3.

Where spray-on fireproofing of the deck is required, the contractor shall verify that the deck finish is compatible with the proposed fireproofing material to ensure proper bonding of the fireproofing. Coordinate fireproofing locations and

All steel deck shall span a minimum of three spans, unless otherwise approved by the engineer. Deck ends are to be

lapped over supports. Contractor shall verify the location and extent of acoustical steel deck with the architectural drawings.

Reference drawings for detail on steel roof deck fastening requirements unless noted otherwise. Powder actuated or pneumatically driven fasteners are not allowed.

COMPOSITE STEEL FLOOR DECK: Manufacturer shall be a current member of the Steel Deck Institute (SDI).

Provide reinforcement or frames for deck openings as indicated on the drawings.

Composite steel floor deck shall be as noted on plan. Detail, manufacture and install composite steel floor deck and accessories in accordance with the SDI specifications,

codes and OSHA steel erection standards. Refer to drawings for composite steel floor deck fastening requirements unless noted otherwise. Powder actuated or

pneumatically driven fasteners are not allowed. Provide and install pour stops, column closures, end closures, cover plates and girder fillers and other accessories as

required by the SDI unless otherwise indicated or detailed. Where spray-on fireproofing of the deck is required, the contractor shall verify that the deck finish is compatible with the proposed fireproofing material to ensure proper bonding of the fireproofing. Coordinate fireproofing locations and

requirements with the architect. Provide reinforcement or frames for deck openings as indicated on the drawings. IMPROVING YOUR WORLD

Reynolds, Smith and Hills, Inc.

4525 Airport Approach Rd, Ste A Duluth, Minnesota 55811 218-722-1227 FAX 218-722-1052 www.rsandh.com



DULUTH INTERNATIONAL **AIRPORT** DULUTH, MN

NEW PARKING STRUCTURE AND EXTERIOR WAYFINDING SIGNAGE

CONSULTANTS

Structural Engineers:

MEYER BORGMAN JOHNSON

501 Lake Avenue South, Suite 300, Duluth MN 55802

TEL: (218) 722-1056 / FAX: (218) 722-9306

TEL: (218) 727-8481 / FAX: (218) 727-8483

Interior Architects: TKDA ARCHITECTS 11 E Superior Street Suite 340, Duluth MN 55802 TEL: (218) 724-8578 / FAX: (218) 724-8717

Landscape Architects: ARCHITECTURAL RESOURCES 126 East Superior Street, Duluth MN 55802

I hereby certify that this plan, specification, or report was prepared by me or under my direct supervision and that I am a duly licensed Professional Engineer under the

laws of the State of Minnesota. Print Name: Paul A. Johnson

Date: 05-15-13 Reg. No.: 20379 **REVISIONS**

DESCRIPTION

DATE ISSUED: 05/15/2013

REVIEWED BY: PAJ

DESIGNED BY: MDN / PAJ


DRAWN BY:

AEP PROJECT NUMBER 213-1882-114

SJL

(C) 2012 REYNOLDS, SMITH AND HILLS INC. SHEET TITLE **GENERAL STRUCTURAL**

SHEET NUMBER

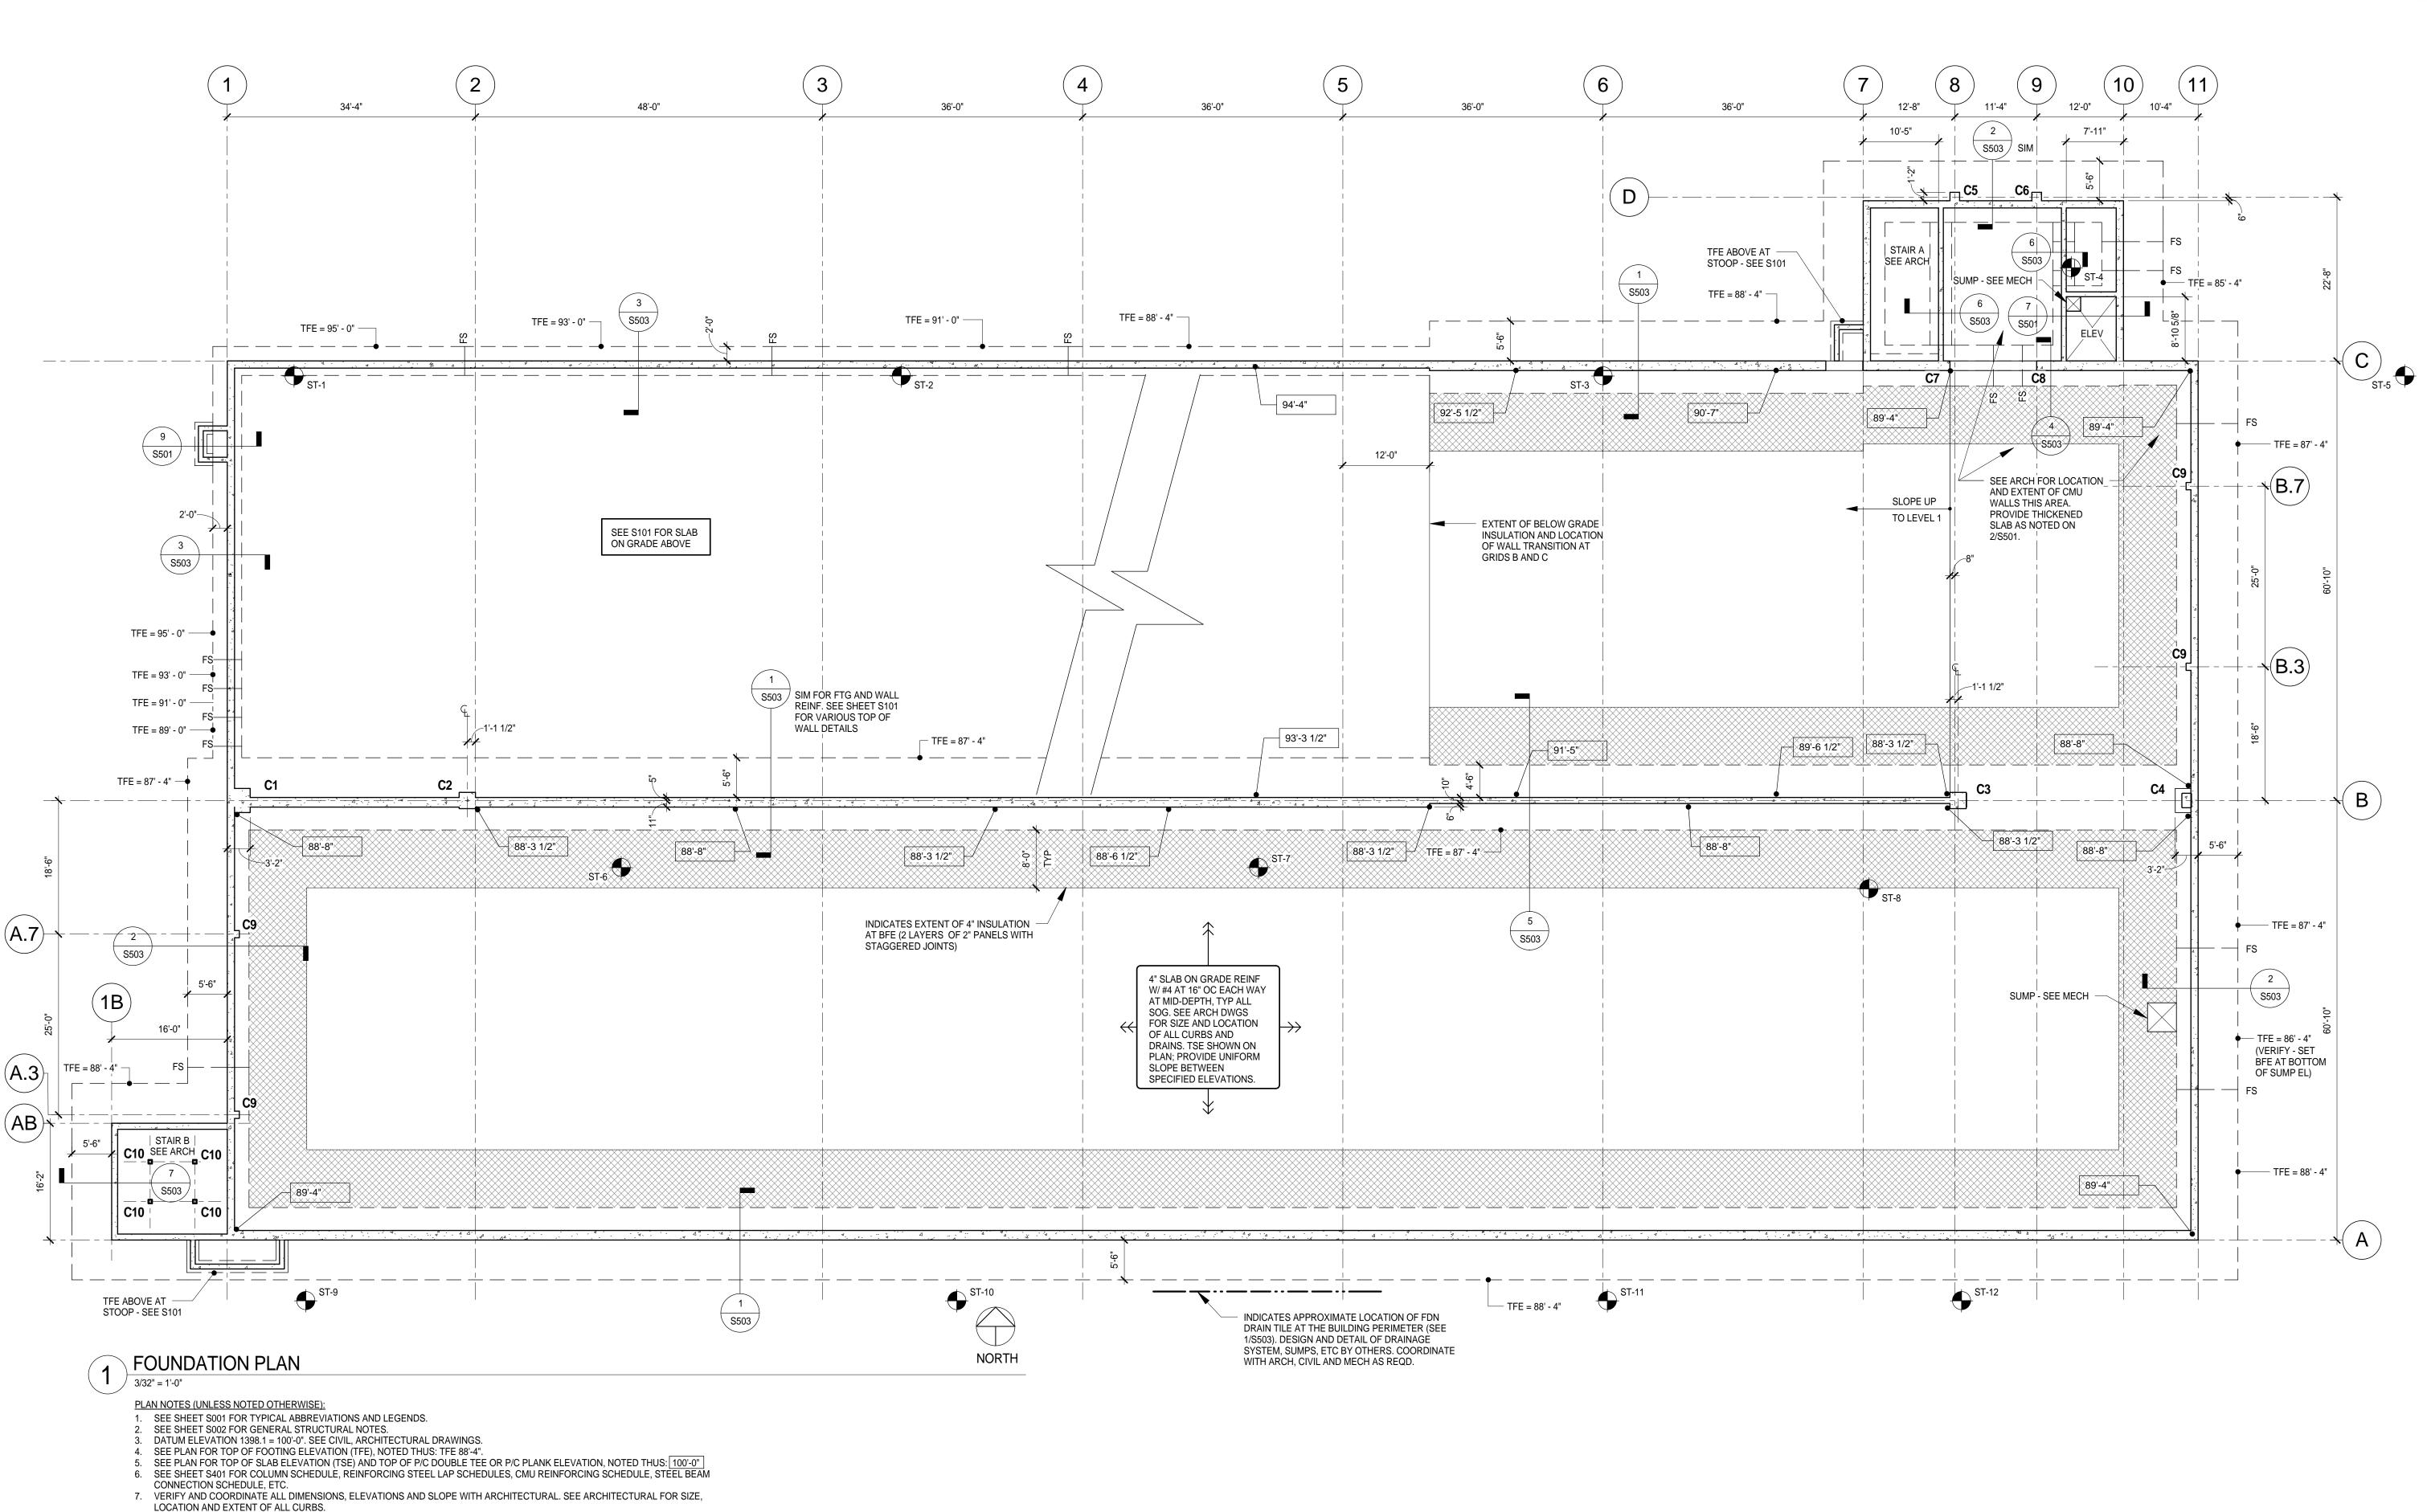

B. 💮 FD ON PLAN INDICATES APPROXIMATE LOCATION OF FLOOR DRAIN. VERIFY WITH ARCHITECTURAL AND MECHANICAL.

SEE SHEET S501 FOR TYPICAL DETAILS NOT CUT ON PLAN; INCLUDING TYPICAL FOOTING STEP, TYPICAL SLAB ON GRADE CONTROL/CONSTRUCTION JOINTS, TYPICAL WALL CONTROL/CONSTRUCTION JOINTS, UTILITY PENETRATIONS, ETC.
 VERIFY AND COORDINATE LOCATION, QUANTITY AND ELEVATION OF ALL UTILITIES, SUMPS, DRAINS, ETC WITH CIVIL, MECHANICAL, ELECTRICAL AND ARCHITECTURAL DRAWINGS. THE APPROXIMATE LOCATION OF UTILITY PENETRATIONS THROUGH FOUNDATIONS SHOWN ON STRUCTURAL DRAWINGS IS FOR CONVENIENCE ONLY AND MAY NOT BE COMPLETE.

13. ALL REINFORCING STEEL EXCEPT THAT CONTAINED ENTIRELY WITHIN FOOTINGS AND PLACED NORTH OF GRID C SHALL BE

12. SKYWALK FOUNDATIONS AT THE EXISTING AIRPORT TERMINAL ARE SHOWN ON \$104.

STRUCTURAL NOTES.

EPOXY COATED.

9. ST-1 ON PLAN INDICATES APPROXIMATE LOCATION OF SOIL BORING. SEE PROJECT GEOTECHNICAL REPORT AND GENERAL



Reynolds, Smith and Hills, Inc.

4525 Airport Approach Rd, Ste A Duluth, Minnesota 55811 218-722-1227 FAX 218-722-1052 www.rsandh.com



DULUTH
INTERNATIONAL
AIRPORT
DULUTH, MN

NEW PARKING STRUCTURE AND EXTERIOR WAYFINDING SIGNAGE

CONSULTANTS

Interior Architects: **TKDA ARCHITECTS**11 E Superior Street Suite 340, Duluth MN 55802
TEL: (218) 724-8578 / FAX: (218) 724-8717

Structural Engineers:

MEYER BORGMAN JOHNSON

501 Lake Avenue South, Suite 300, Duluth MN 55802
TEL: (218) 722-1056 / FAX: (218) 722-9306

Landscape Architects:

ARCHITECTURAL RESOURCES

126 East Superior Street, Duluth MN 55802
TEL: (218) 727-8481 / FAX: (218) 727-8483

I hereby certify that this plan, specification, or report was prepared by me or under my direct supervision and that I am a duly licensed Professional Engineer under the laws of the State of Minnesota.

Print Name:	Paul A. Johnsor
Signature: Tull	a phonon
,	- /

Reg. No.: 20379

REVISIONS

Date: 05-15-13

RIPTION	DATI
05/15/2013	
PAJ	

DRAWN BY: SJL
DESIGNED BY: MDN / PAJ

AEP PROJECT NUMBER 213-1882-114


213-1882-114

© 2012 REYNOLDS, SMITH AND HILLS INC.

FOUNDATION PLAN

SHEET NUMBER

S100

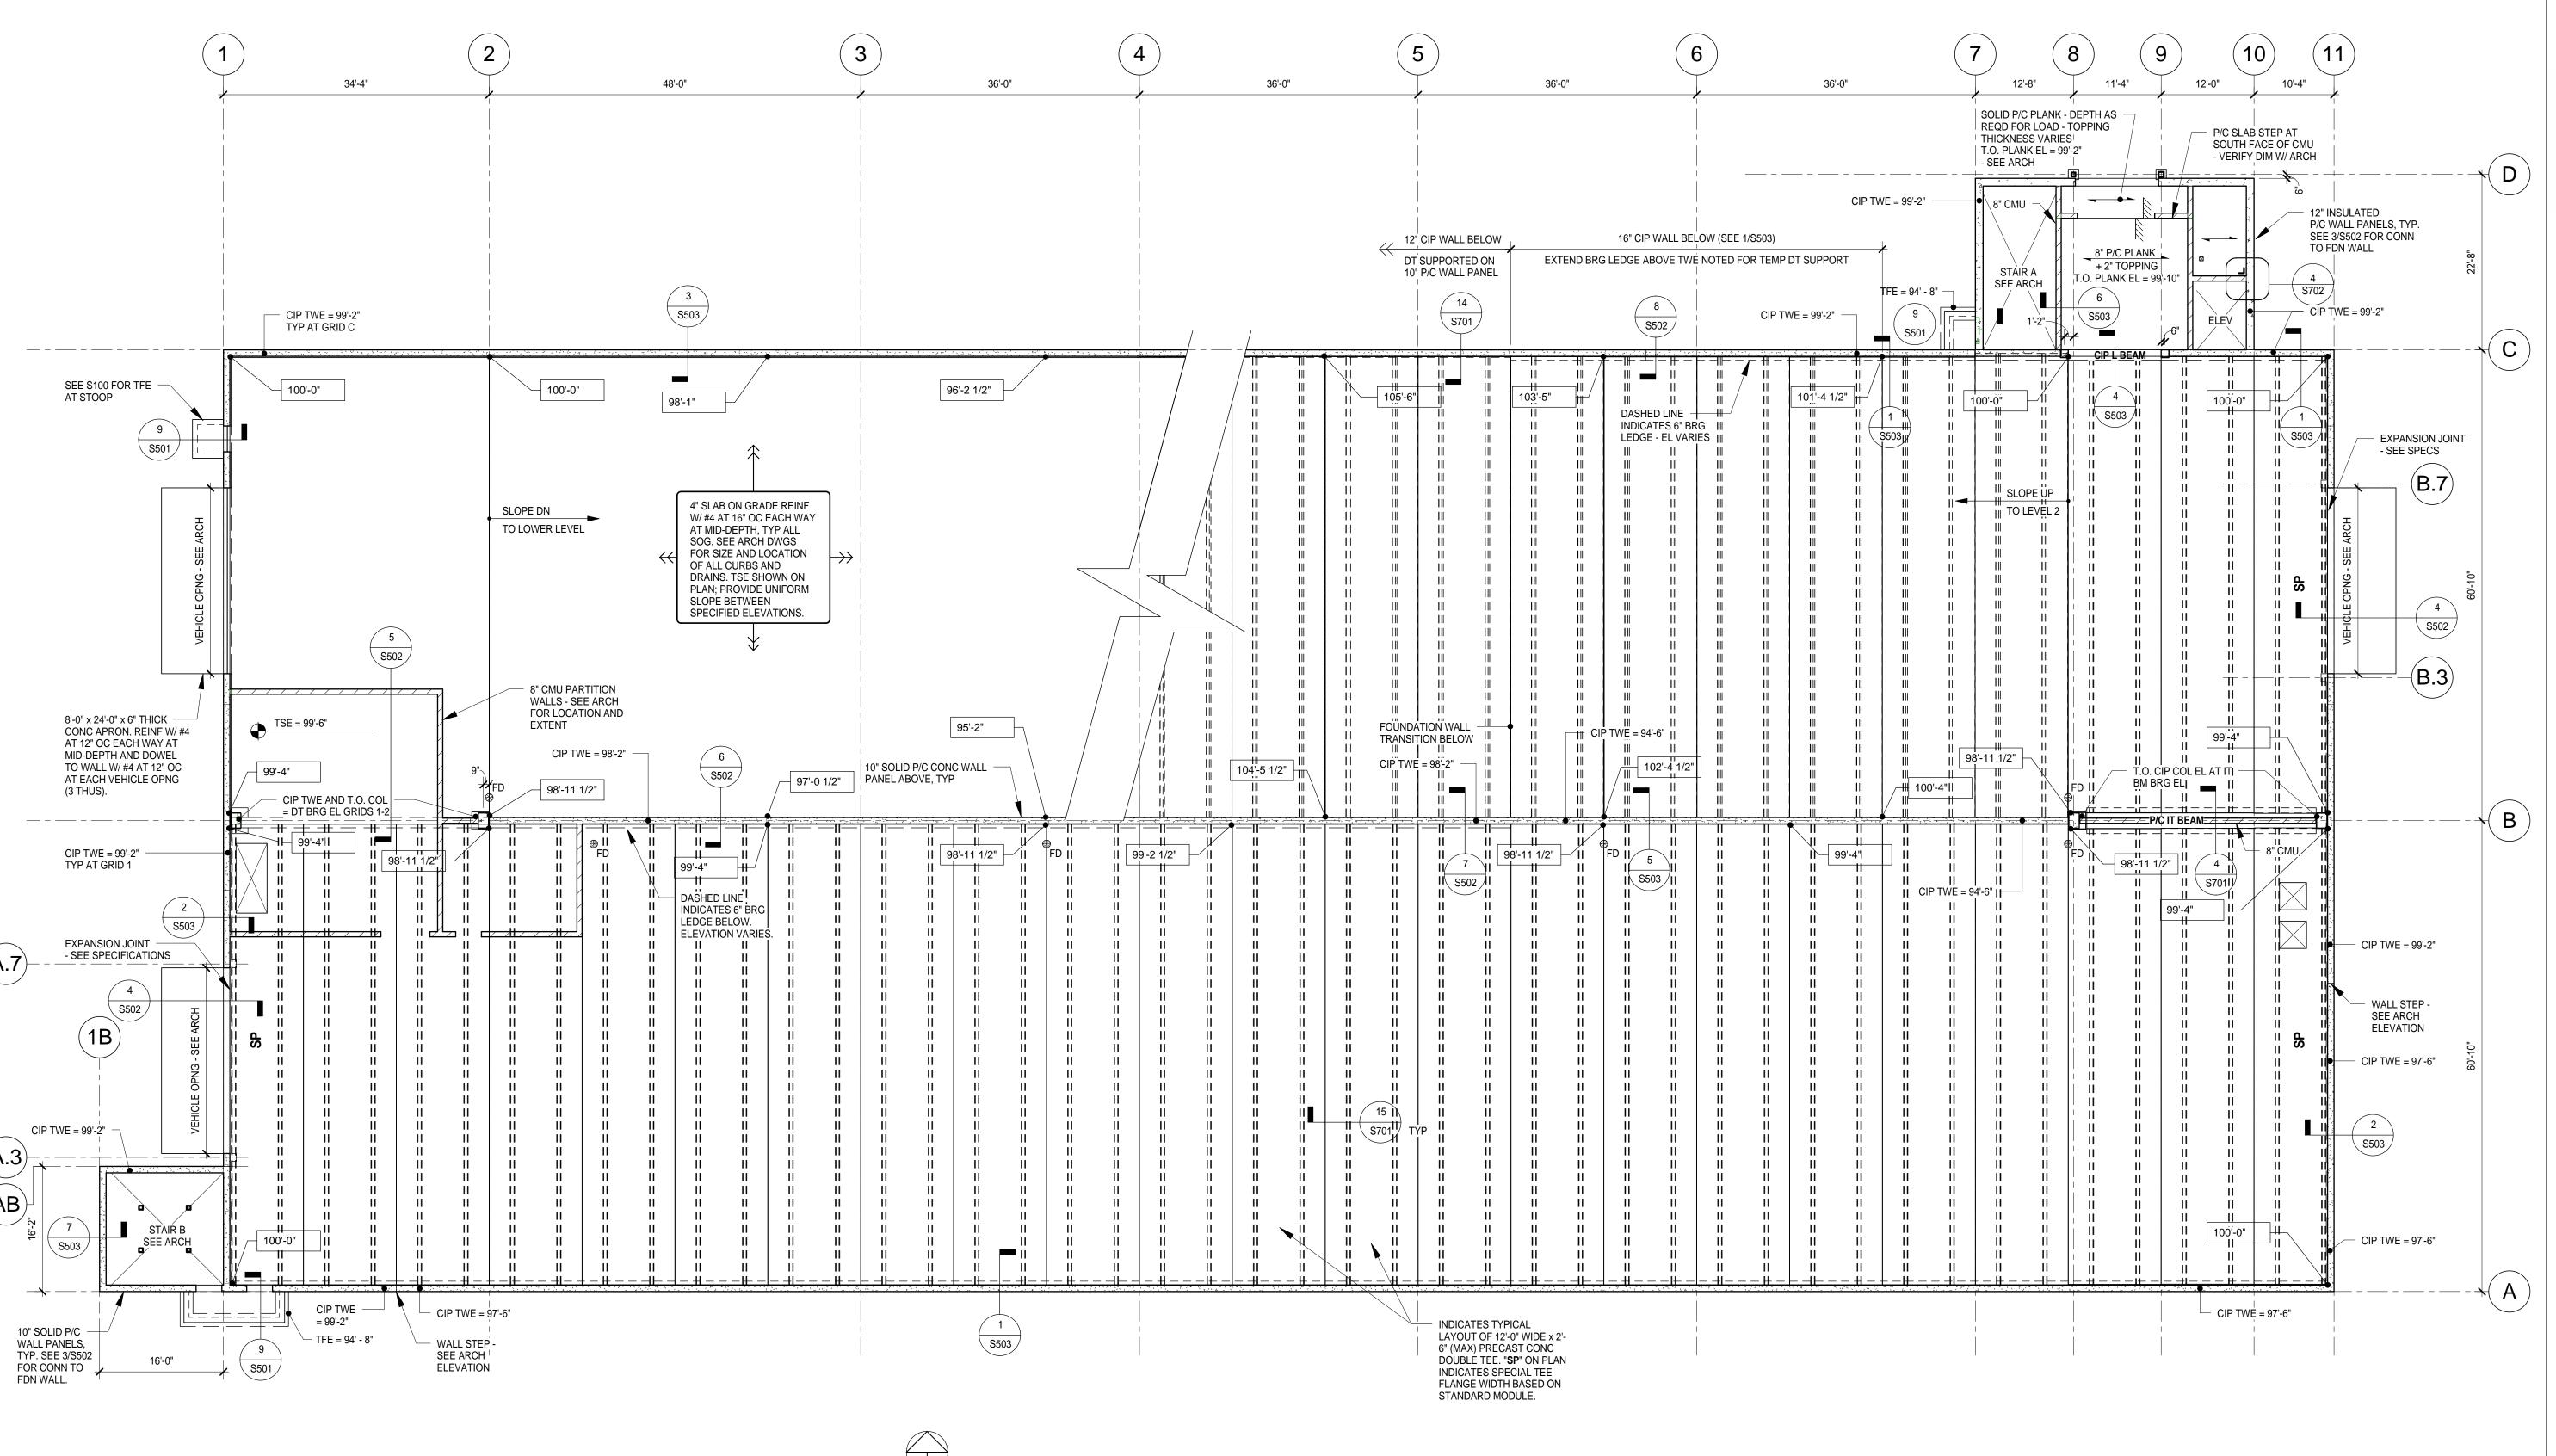

FIRST LEVEL FRAMING PLAN

 CANTILEVERED CONCRETE FOUNDATION WALLS ARE NOT DESIGNED FOR P/C ERECTION CRANES OR OTHER HEAVY EQUIPMENT SURCHARGES. MAINTAIN MINIMUM 20' CLEAR FROM FACE OF FOUNDATION WALLS TO EDGE OF ANY HEAVY EQUIPMENT.
 SEE S101A, S102A, S103A FOR LOAD MAPS SHOWING GRAVITY AND LATERAL DESIGN LOADS FOR P/C ELEMENTS AND SYSTEMS.

1. SEE SHEET S100 FOR TYPICAL PLAN NOTES.

3/32" = 1'-0"

PLAN NOTES:

RS&FT.
IMPROVING YOUR WORLD

Reynolds, Smith and Hills, Inc.

4525 Airport Approach Rd, Ste A Duluth, Minnesota 55811 218-722-1227 FAX 218-722-1052 www.rsandh.com



DULUTH
INTERNATIONAL
AIRPORT
DULUTH, MN

NEW PARKING
STRUCTURE
AND EXTERIOR
WAYFINDING SIGNAGE

CONSULTANTS

Interior Architects: **TKDA ARCHITECTS**11 E Superior Street Suite 340, Duluth MN 55802
TEL: (218) 724-8578 / FAX: (218) 724-8717

Structural Engineers:

MEYER BORGMAN JOHNSON

501 Lake Avenue South, Suite 300, Duluth MN 55802
TEL: (218) 722-1056 / FAX: (218) 722-9306

Landscape Architects:

ARCHITECTURAL RESOURCES

126 East Superior Street, Duluth MN 55802
TEL: (218) 727-8481 / FAX: (218) 727-8483

I hereby certify that this plan, specification, or report was prepared by me or under my direct supervision and that I am a duly licensed Professional Engineer under the laws of the State of Minnesota.

Print Name: Paul A. Johnson

Signature: All Alphunon

Reg. No.: 20379

REVISIONS

Date: 05-15-13

· \ L \	71010110		
NO.	DESCR	RIPTION	DATE
DATE ISSUED:		05/15/2013	
REVIEWED BY:		PAJ	
DRAWN BY:		SJL	

AEP PROJECT NUMBER


213-1882-114

© 2012 REYNOLDS, SMITH AND HILLS INC.

FIRST LEVEL FRAMING PLAN

SHEET NUMBER

S101

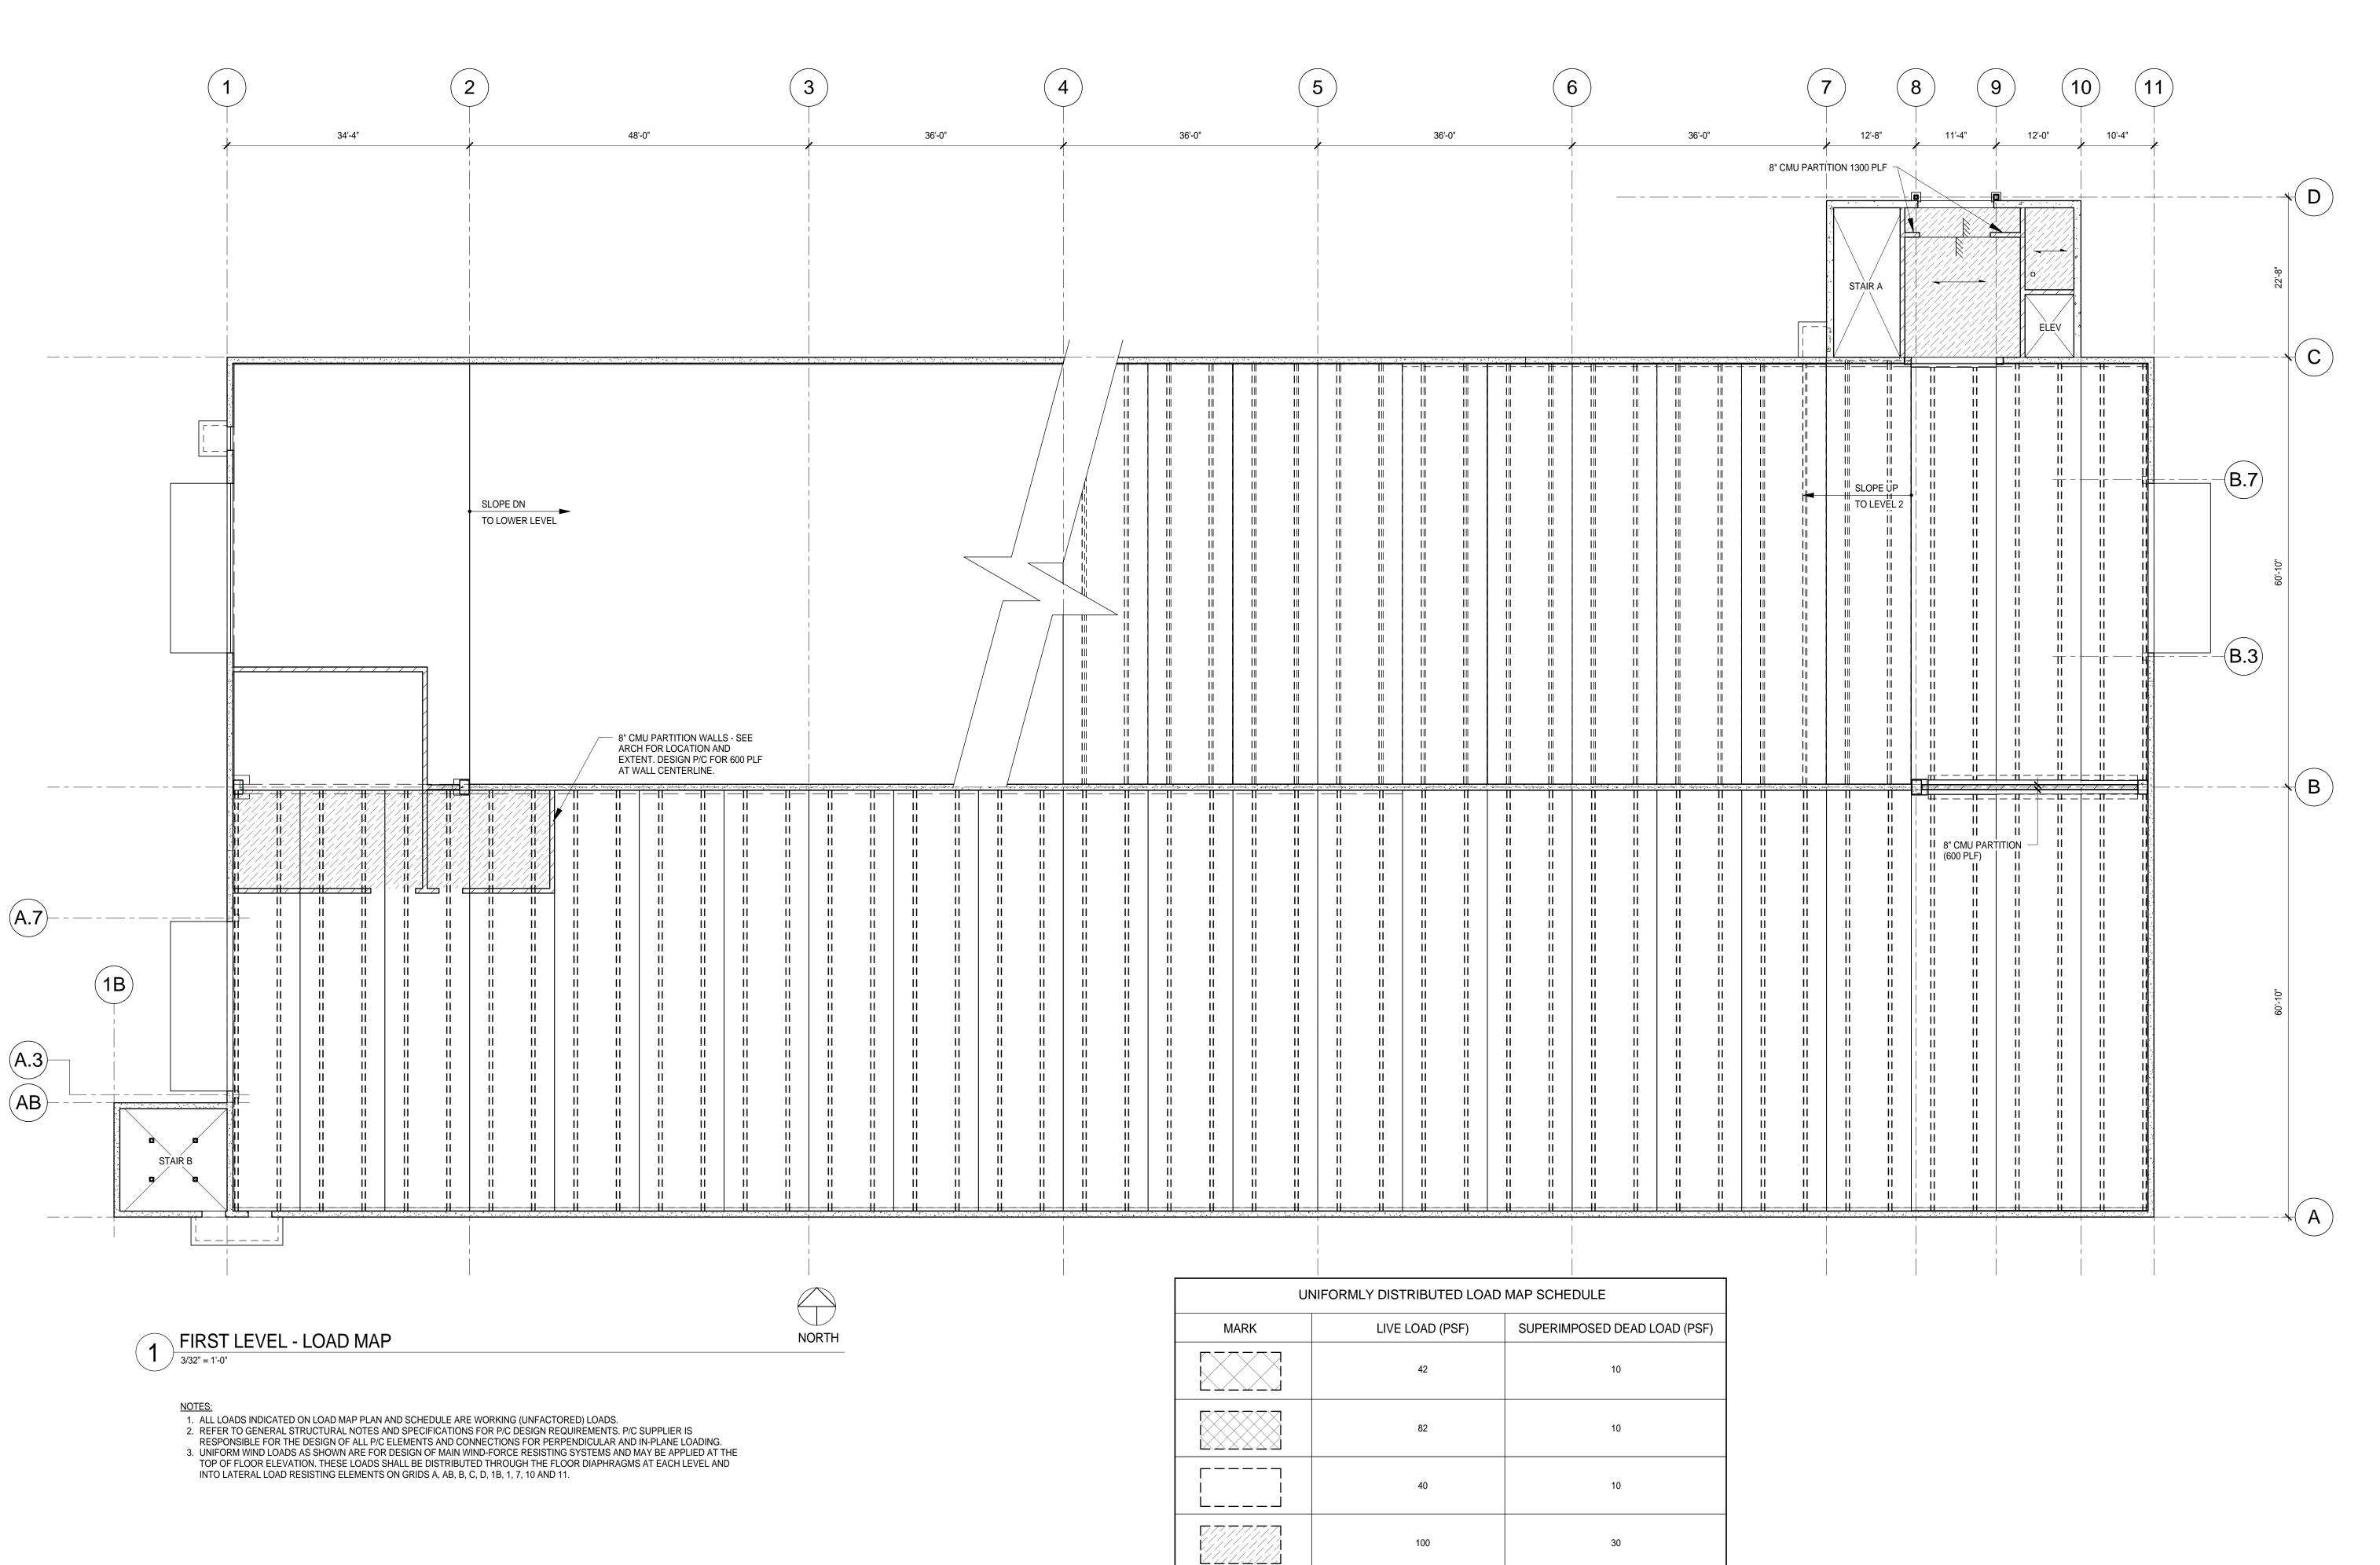



Reynolds, Smith and Hills, Inc.

4525 Airport Approach Rd, Ste A Duluth, Minnesota 55811 218-722-1227 FAX 218-722-1052 www.rsandh.com



DULUTH INTERNATIONAL AIRPORT DULUTH, MN

NEW PARKING STRUCTURE **AND EXTERIOR** WAYFINDING SIGNAGE

CONSULTANTS

Interior Architects: **TKDA ARCHITECTS** 11 E Superior Street Suite 340, Duluth MN 55802 TEL: (218) 724-8578 / FAX: (218) 724-8717

Structural Engineers: **MEYER BORGMAN JOHNSON** 501 Lake Avenue South, Suite 300, Duluth MN 55802 TEL: (218) 722-1056 / FAX: (218) 722-9306

Landscape Architects: ARCHITECTURAL RESOURCES 126 East Superior Street, Duluth MN 55802 TEL: (218) 727-8481 / FAX: (218) 727-8483

I hereby certify that this plan, specification, or report was prepared by me or under my direct supervision and that I am a duly licensed Professional Engineer under the laws of the State of Minnesota.

Print Name: Paul A. Johnson

Date: 05-15-13 Reg. No.: 20379

REVISIONS

NO.	DESCF	RIPTION	DATE
DATE IS	SSUED:	05/15/2013	
REVIEV	VED BY:	PAJ	
DD AMA	I DV.	C II	

DRAWN BY:

DESIGNED BY: MDN / PAJ AEP PROJECT NUMBER


213-1882-114 C) 2012 REYNOLDS, SMITH AND HILLS INC.

SHEET TITLE FIRST LEVEL

LOAD MAP

SHEET NUMBER

S101A

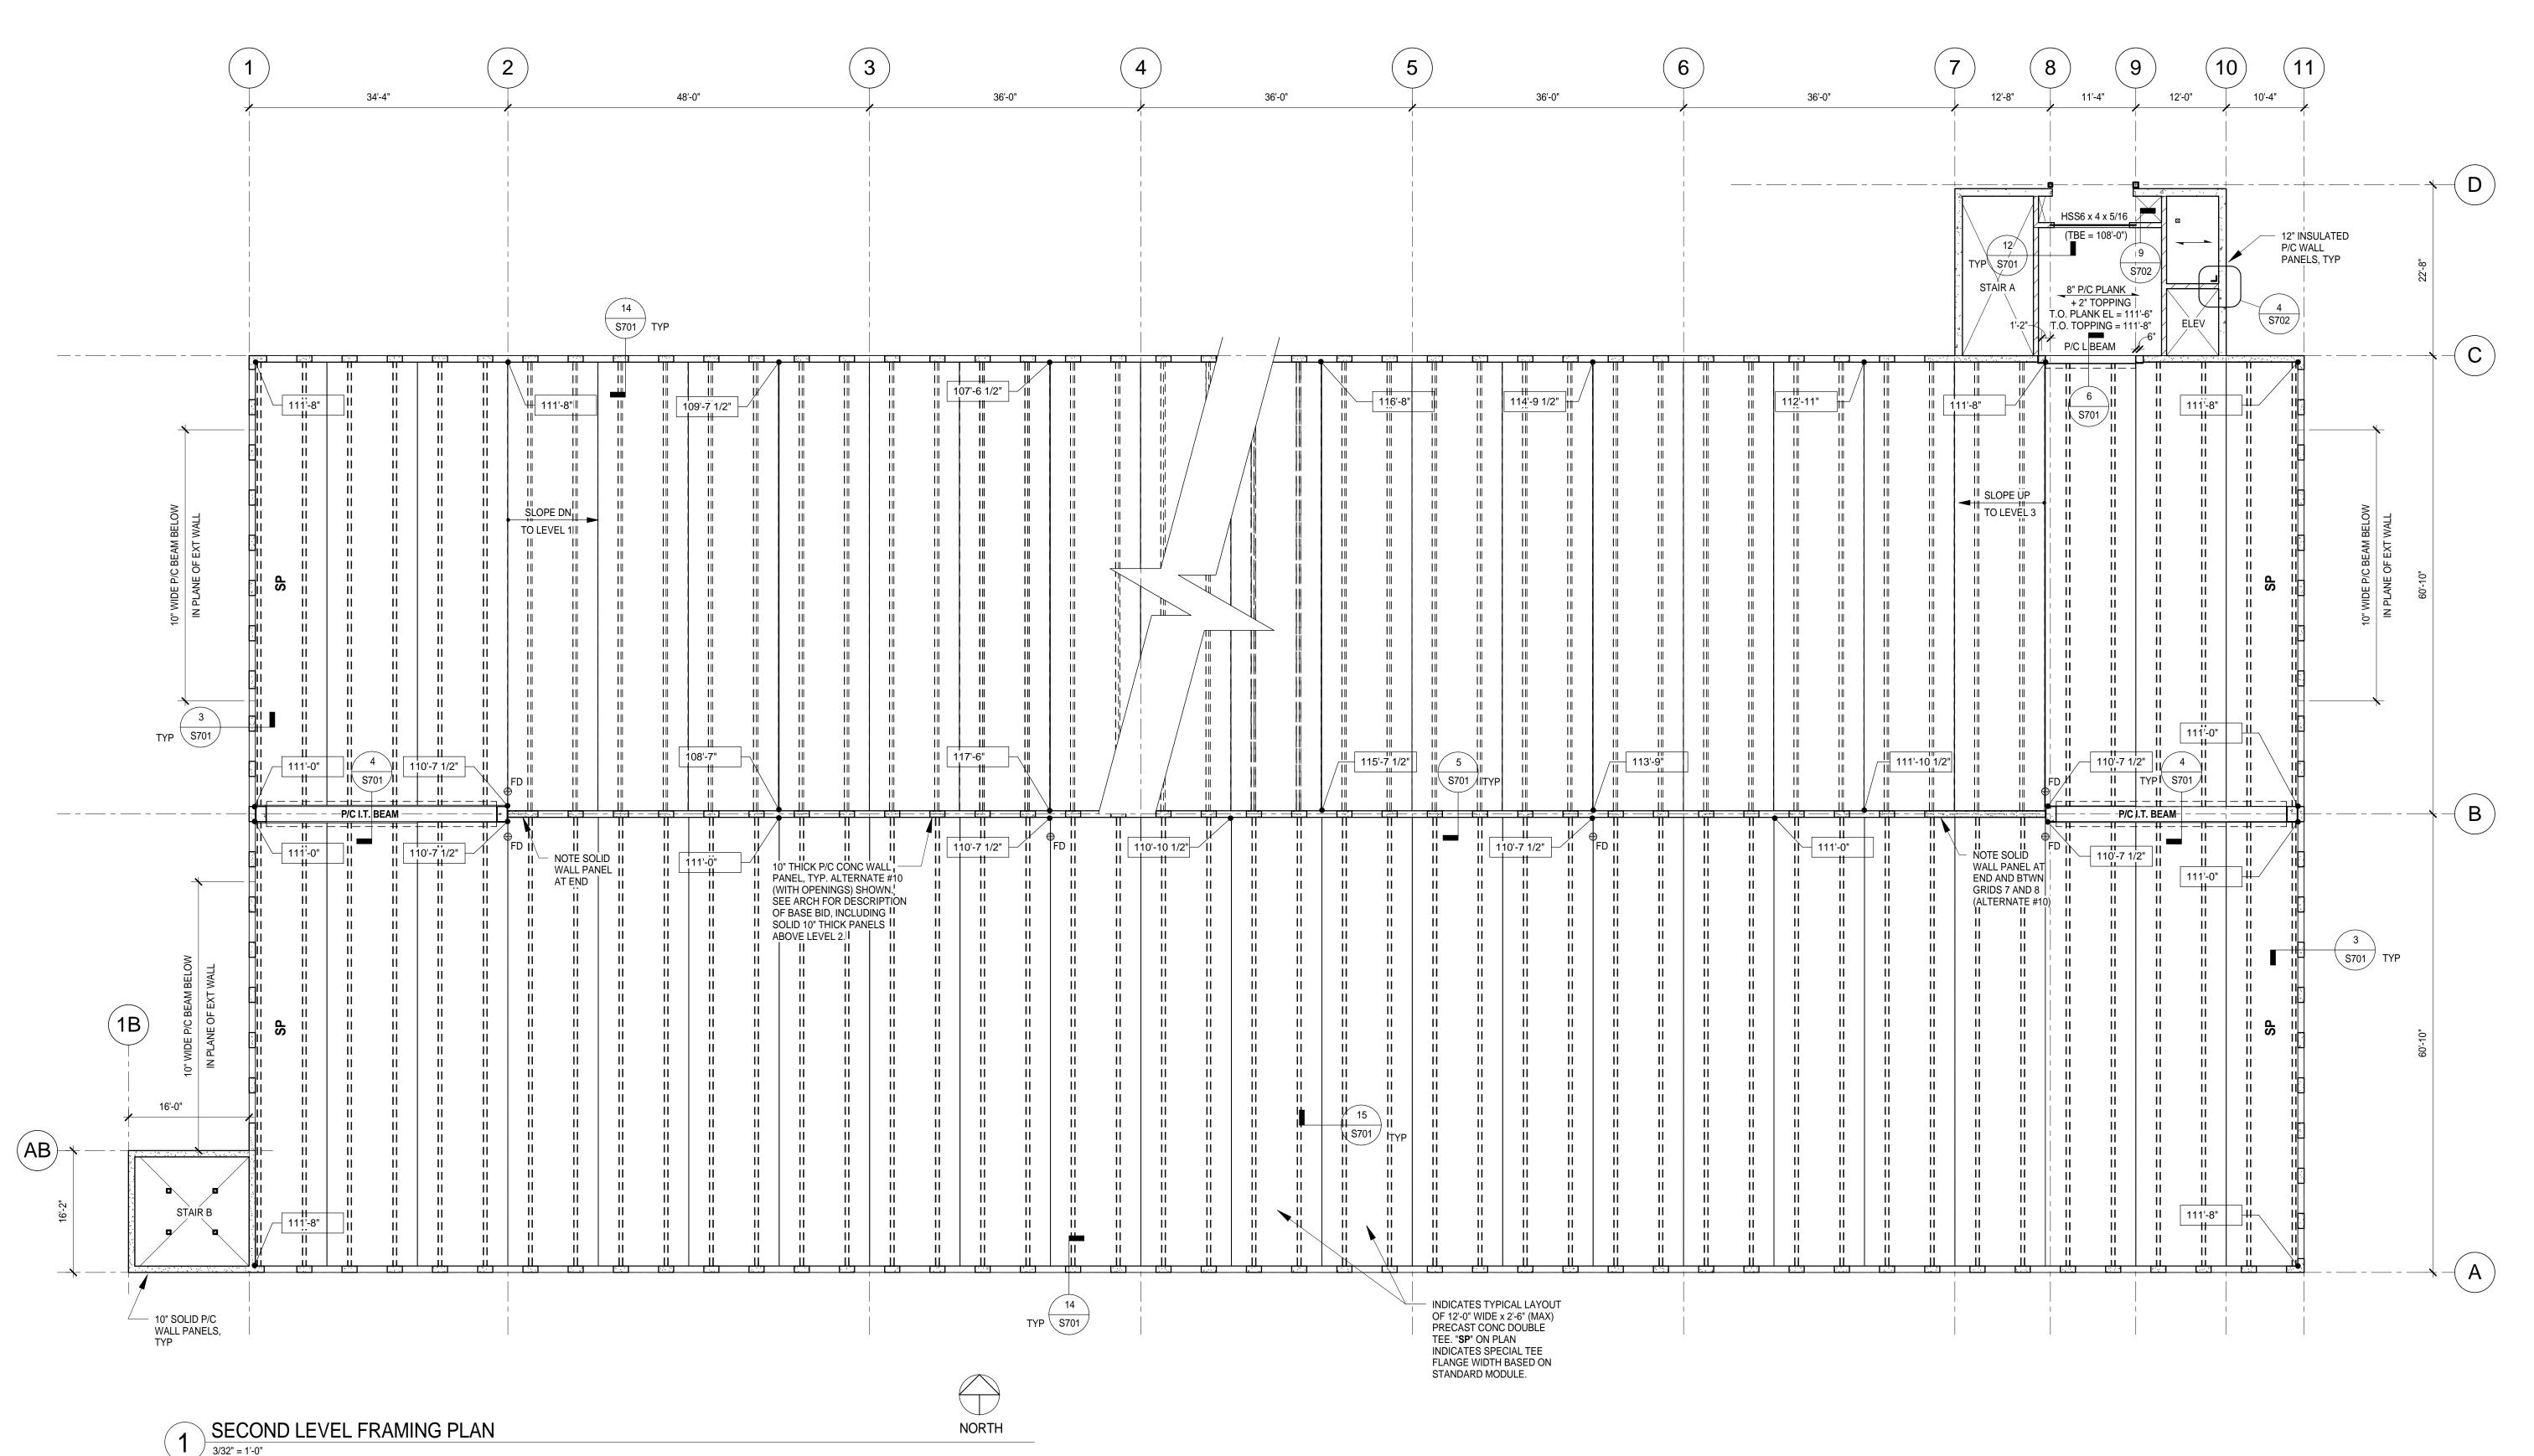

PLAN NOTES:

SEE SHEET S100 FOR TYPICAL PLAN NOTES.
 SEE S101A, S102A, S103A FOR LOAD MAPS SHOWING GRAVITY AND LATERAL DESIGN LOADS FOR P/C ELEMENTS AND SYSTEMS.

RSEH.

IMPROVING YOUR WORLD

Reynolds, Smith and Hills, Inc.

4525 Airport Approach Rd, Ste A Duluth, Minnesota 55811 218-722-1227 FAX 218-722-1052 www.rsandh.com



DULUTH INTERNATIONAL AIRPORT DULUTH, MN

NEW PARKING STRUCTURE AND EXTERIOR WAYFINDING SIGNAGE

CONSULTANTS

Interior Architects: **TKDA ARCHITECTS**11 E Superior Street Suite 340, Duluth MN 55802
TEL: (218) 724-8578 / FAX: (218) 724-8717

Structural Engineers:

MEYER BORGMAN JOHNSON

501 Lake Avenue South, Suite 300, Duluth MN 55802

TEL: (218) 722-1056 / FAX: (218) 722-9306

Landscape Architects:

ARCHITECTURAL RESOURCES

126 East Superior Street, Duluth MN 55802
TEL: (218) 727-8481 / FAX: (218) 727-8483

I hereby certify that this plan, specification, or report was prepared by me or under my direct supervision and that I am a duly licensed Professional Engineer under the laws of the State of Minnesota.

Print Name:	Paul A. Johns
9	10/1
Signature: J au	ll (1/phonon
	//

Date: 05-15-13 Reg. No.: 20379

REVISIONS

NO.	DESC	RIPTION	DATE
DATE	ISSUED:	05/15/2013	
REVII	EWED BY:	PAJ	
DRAV	VN BY:	SJL	
DESI	GNED BY:	MDN / PAJ	

AEP PROJECT NUMBER

213-1882-114


© 2012 REYNOLDS, SMITH AND HILLS INC.

SHEET TITLE

SECOND LEVEL FRAMING PLAN

SHEET NUMBER

S102

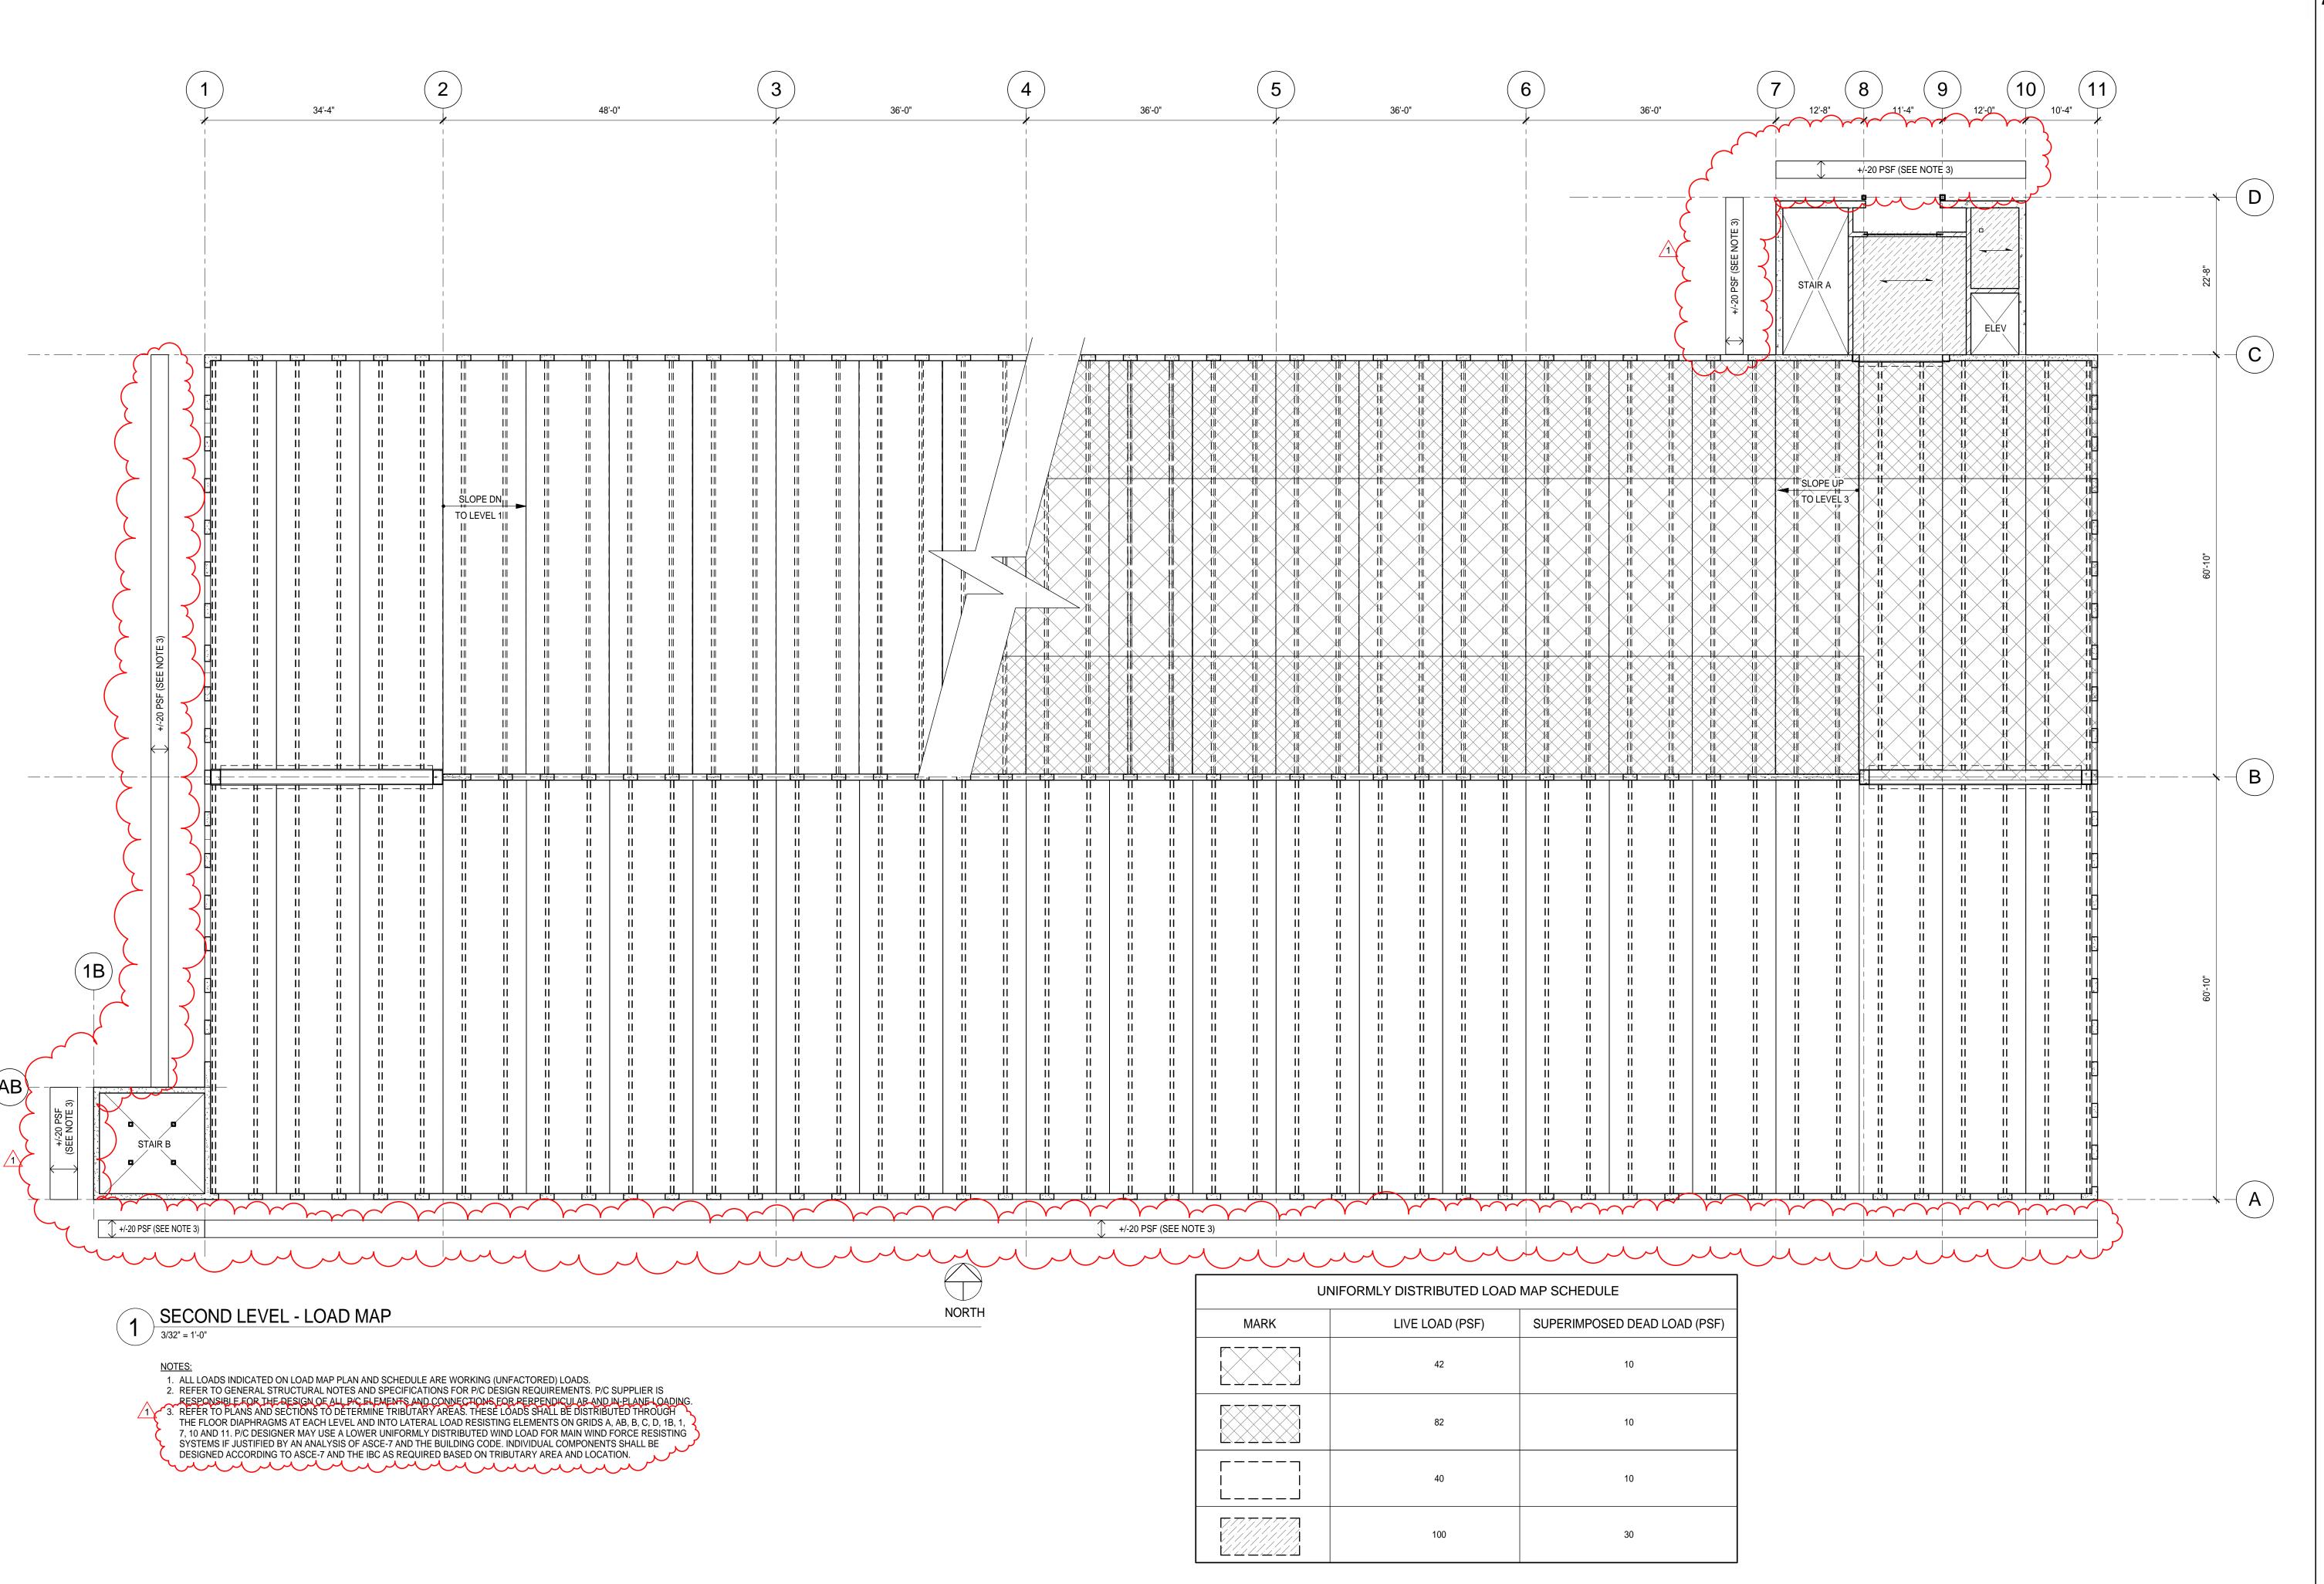



Reynolds, Smith and Hills, Inc.

4525 Airport Approach Rd, Ste A Duluth, Minnesota 55811 218-722-1227 FAX 218-722-1052 www.rsandh.com



DULUTH INTERNATIONAL **AIRPORT DULUTH, MN**

NEW PARKING STRUCTURE AND EXTERIOR WAYFINDING SIGNAGE

CONSULTANTS

Interior Architects: **TKDA ARCHITECTS** 11 E Superior Street Suite 340, Duluth MN 55802 TEL: (218) 724-8578 / FAX: (218) 724-8717

Structural Engineers: **MEYER BORGMAN JOHNSON** 501 Lake Avenue South, Suite 300, Duluth MN 55802 TEL: (218) 722-1056 / FAX: (218) 722-9306

Landscape Architects: ARCHITECTURAL RESOURCES 126 East Superior Street, Duluth MN 55802 TEL: (218) 727-8481 / FAX: (218) 727-8483

I hereby certify that this plan, specification, or report was prepared by me or under my direct supervision and that I am a duly licensed Professional Engineer under the laws of the State of Minnesota.

Print Name:	Paul A. Johnson
O1a	//
Signature: Tull (1)	phonon

Reg. No.: 20379 Date: 05-15-13

RE'	VISIONS		
NO.	DESCF	RIPTION	DATE
1	ADDENDU	<i>1</i> 2	5-31-13
DATI	E ISSUED:	05/15/2013	
REVI	EWED BY:	PAJ	
DD VWN BA		S II	

DRAWN BY: DESIGNED BY: MDN / PAJ

AEP PROJECT NUMBER


213-1882-114 (C) 2012 REYNOLDS, SMITH AND HILLS INC.

SHEET TITLE **SECOND LEVEL**

LOAD MAP

SHEET NUMBER

S102A

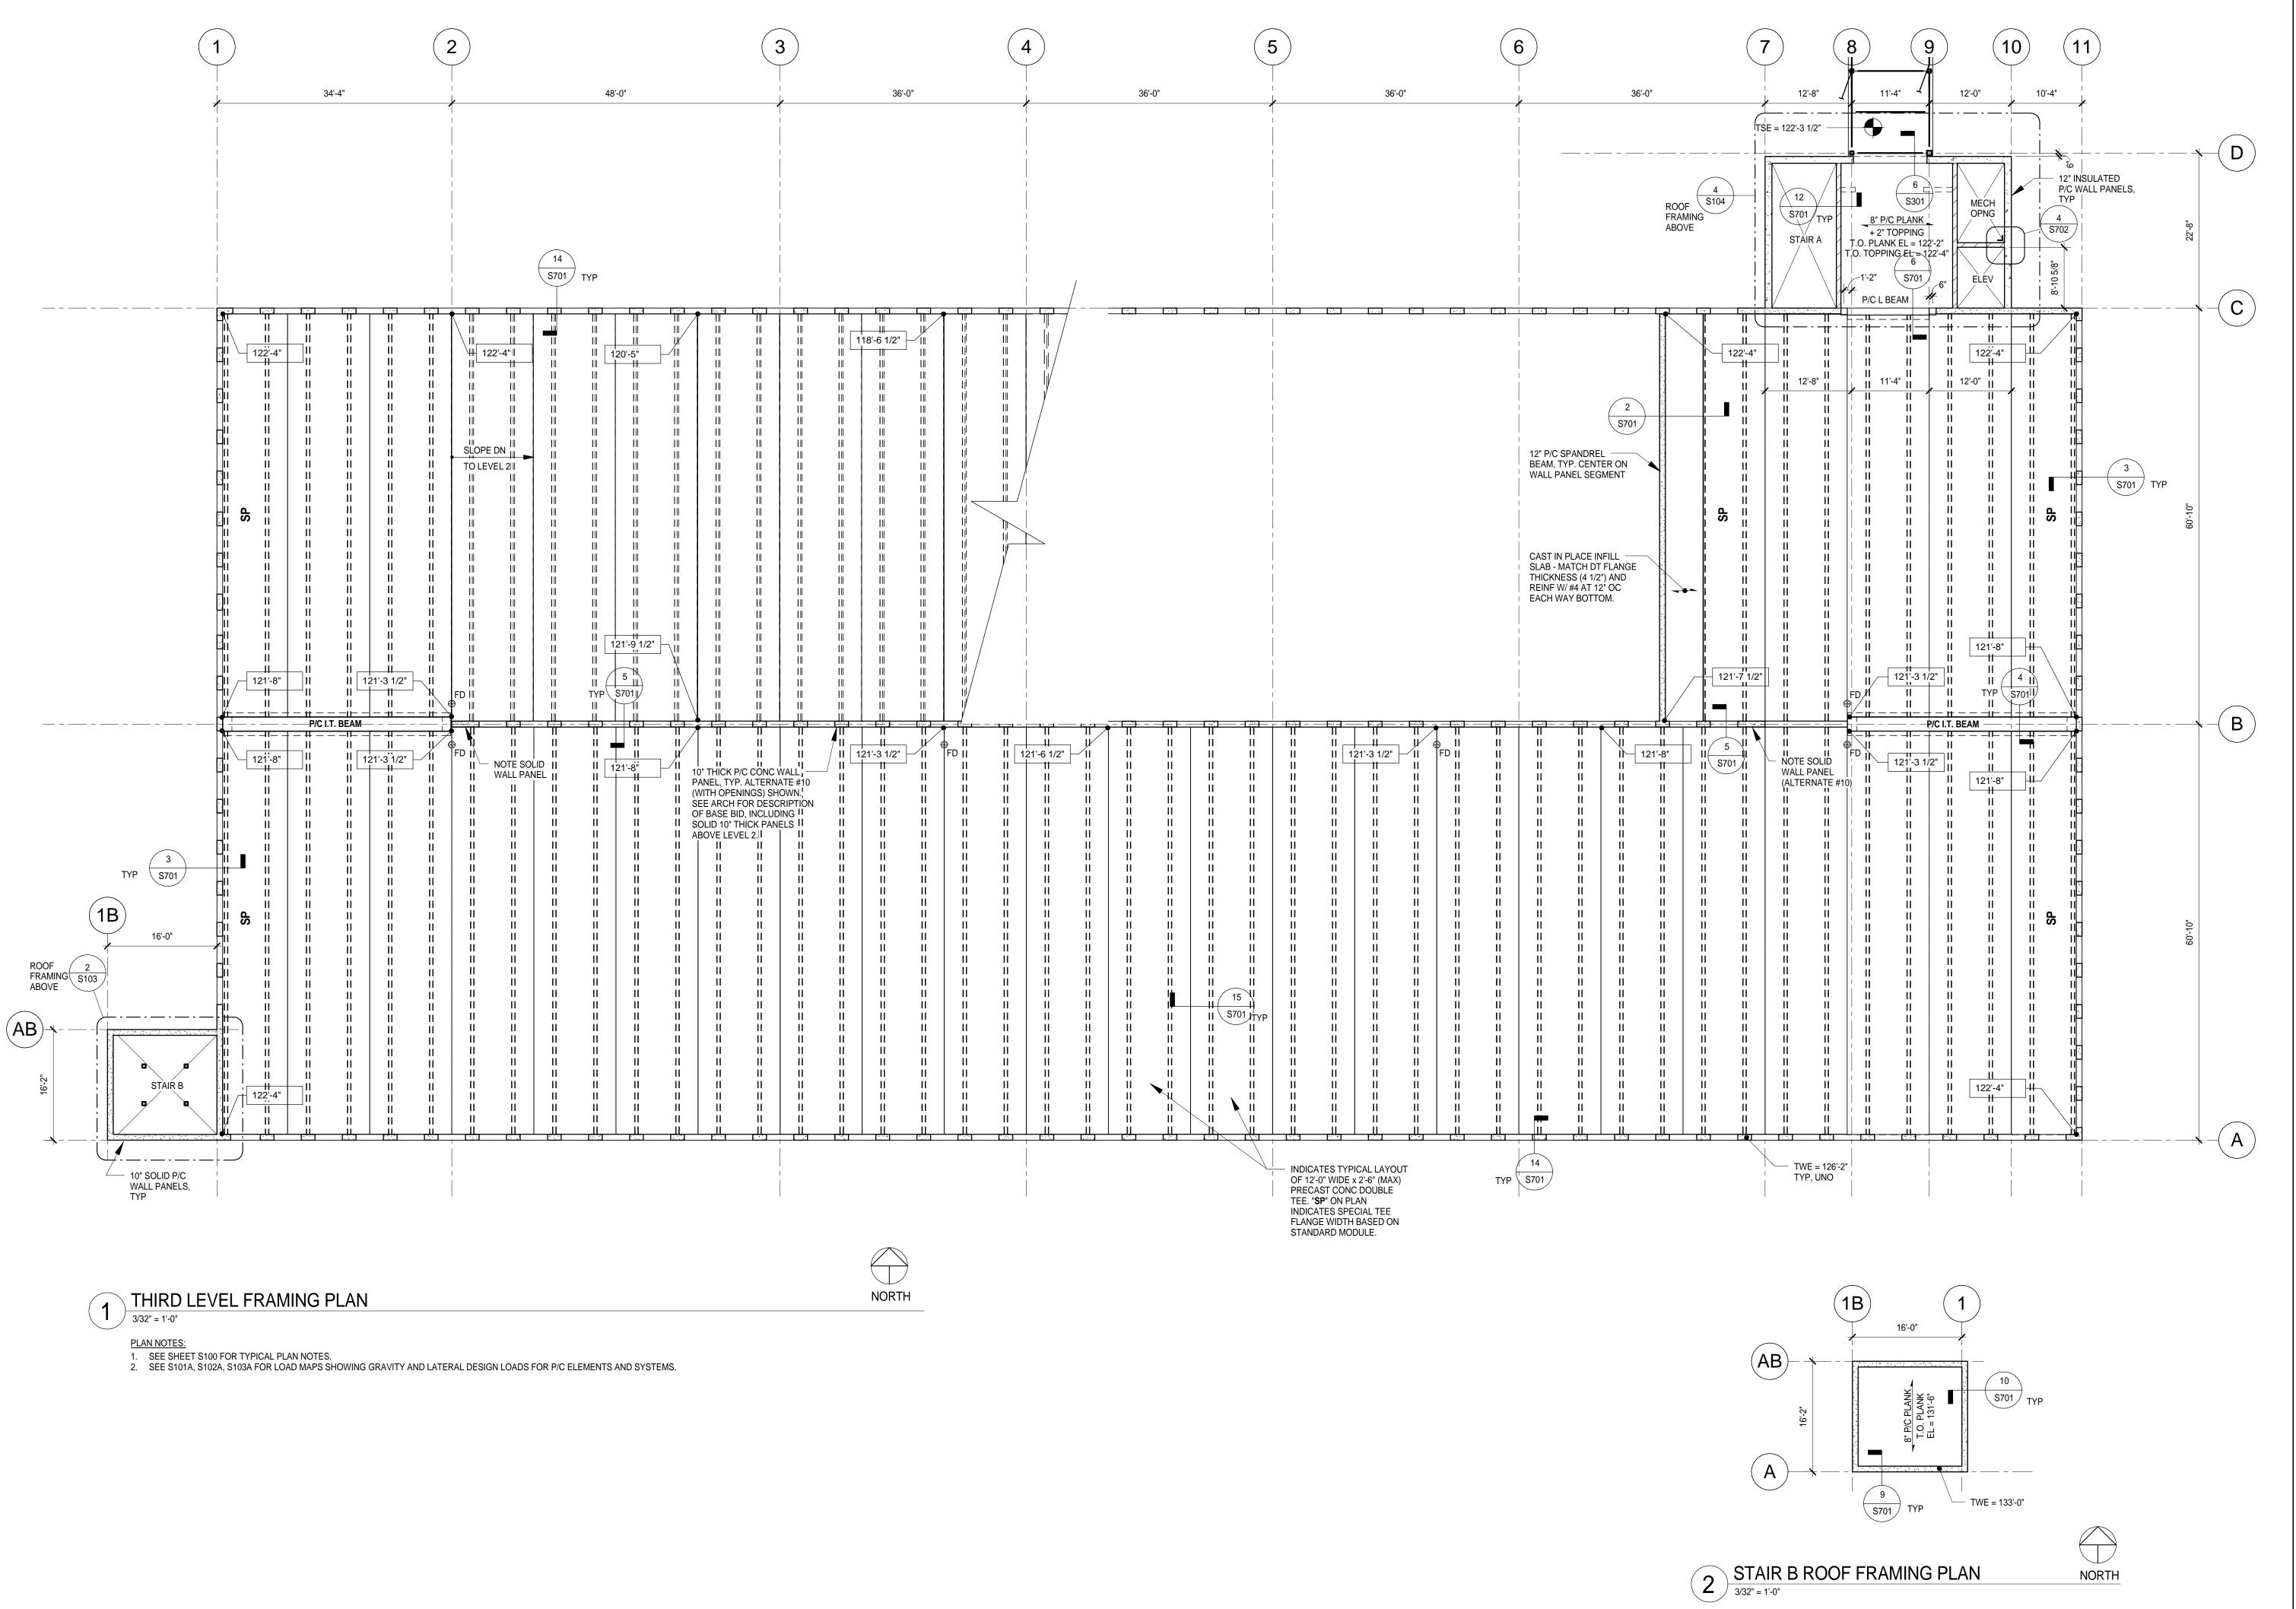

IMPROVING YOUR WORLD

Reynolds, Smith and Hills, Inc.

4525 Airport Approach Rd, Ste A Duluth, Minnesota 55811 218-722-1227 FAX 218-722-1052 www.rsandh.com



DULUTH INTERNATIONAL **AIRPORT** DULUTH, MN

NEW PARKING STRUCTURE **AND EXTERIOR WAYFINDING SIGNAGE**

CONSULTANTS

Interior Architects: TKDA ARCHITECTS 11 E Superior Street Suite 340, Duluth MN 55802 TEL: (218) 724-8578 / FAX: (218) 724-8717

Structural Engineers: **MEYER BORGMAN JOHNSON** 501 Lake Avenue South, Suite 300, Duluth MN 55802 TEL: (218) 722-1056 / FAX: (218) 722-9306

Landscape Architects: ARCHITECTURAL RESOURCES 126 East Superior Street, Duluth MN 55802 TEL: (218) 727-8481 / FAX: (218) 727-8483

I hereby certify that this plan, specification, or report was prepared by me or under my direct supervision and that I am a duly licensed Professional Engineer under the laws of the State of Minnesota.

Print Name: Paul A. Johnson

Date: 05-15-13 Reg. No.: 20379

REVISIONS

NO.	DESCRIPTION	DATE
DATE	TICCLIED. OF/AF/2042	

DATE ISSUED: 05/15/2013 **REVIEWED BY:** PAJ

DRAWN BY: SJL **DESIGNED BY:** MDN / PAJ AEP PROJECT NUMBER

213-1882-114

(C) 2012 REYNOLDS, SMITH AND HILLS INC

SHEET TITLE


THIRD LEVEL **FRAMING PLAN**

SHEET NUMBER

S103

ISSUED FOR BID

NORTH

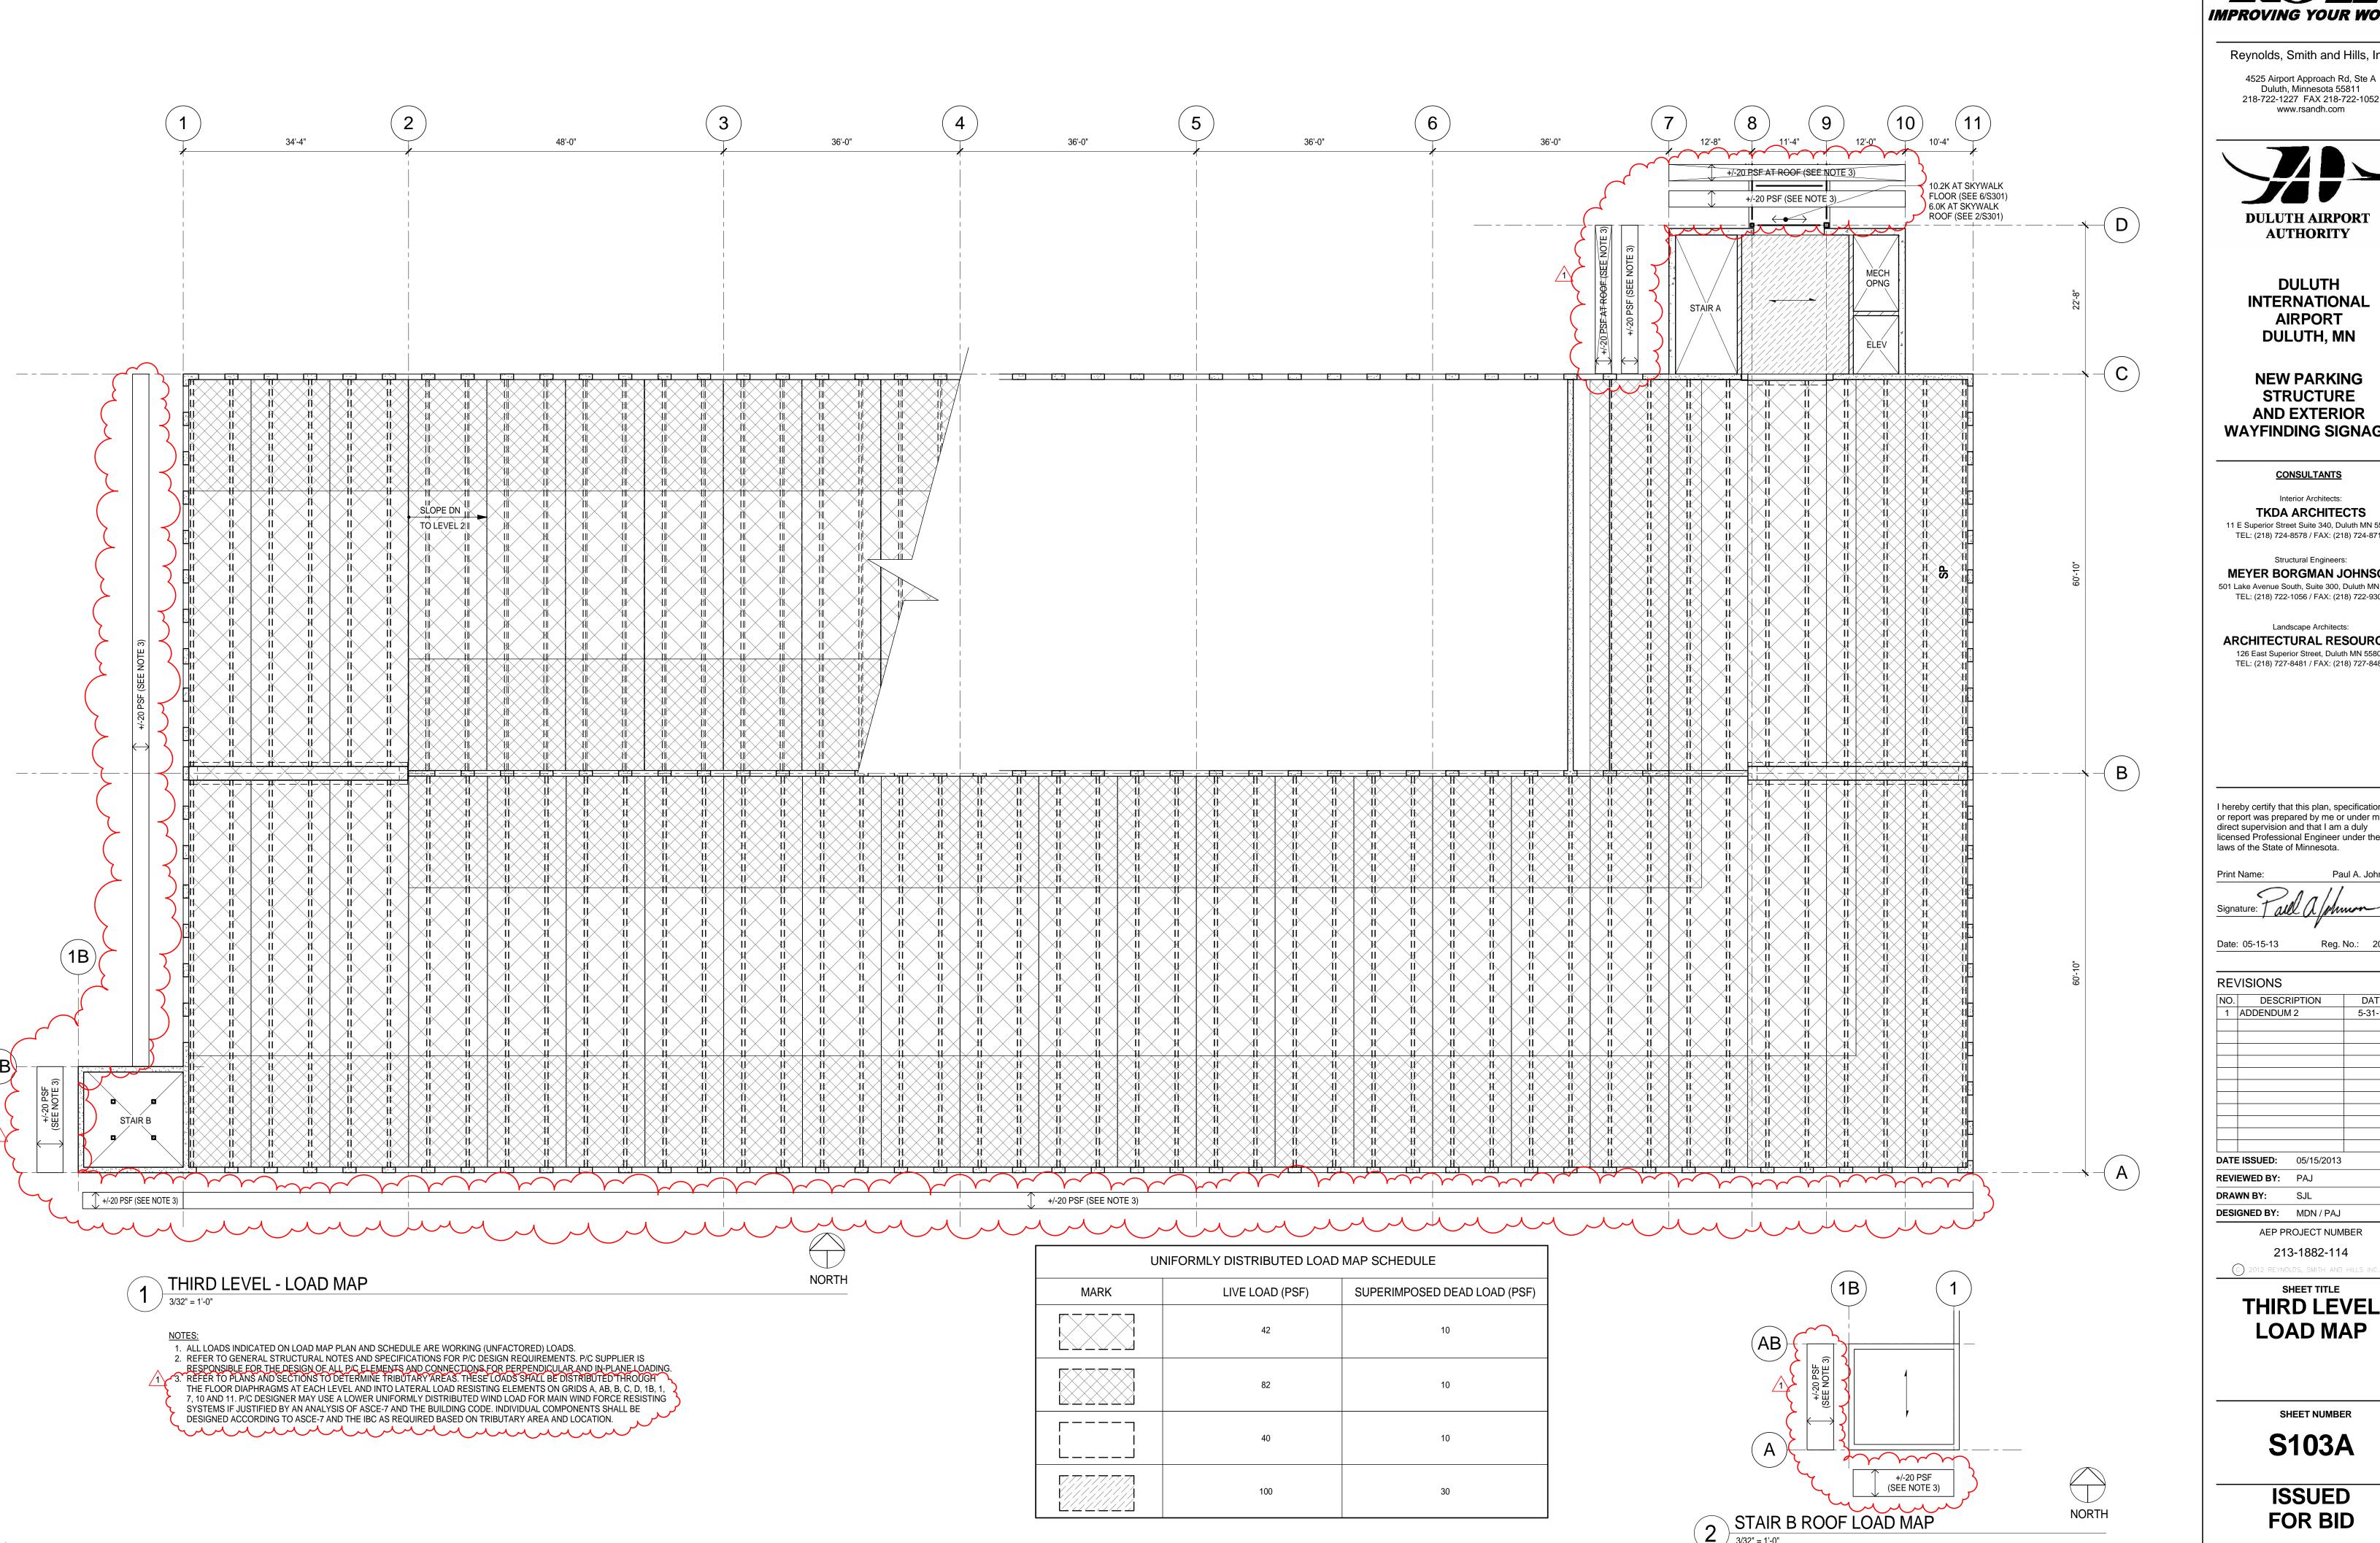



Reynolds, Smith and Hills, Inc.

4525 Airport Approach Rd, Ste A Duluth, Minnesota 55811 218-722-1227 FAX 218-722-1052 www.rsandh.com



DULUTH INTERNATIONAL AIRPORT DULUTH, MN

NEW PARKING STRUCTURE AND EXTERIOR WAYFINDING SIGNAGE

CONSULTANTS

Interior Architects: TKDA ARCHITECTS 11 E Superior Street Suite 340, Duluth MN 55802 TEL: (218) 724-8578 / FAX: (218) 724-8717

Structural Engineers: **MEYER BORGMAN JOHNSON** 501 Lake Avenue South, Suite 300, Duluth MN 55802 TEL: (218) 722-1056 / FAX: (218) 722-9306

Landscape Architects: ARCHITECTURAL RESOURCES 126 East Superior Street, Duluth MN 55802 TEL: (218) 727-8481 / FAX: (218) 727-8483

I hereby certify that this plan, specification, or report was prepared by me or under my direct supervision and that I am a duly licensed Professional Engineer under the laws of the State of Minnesota.

Paul A. Johnson

Reg. No.: 20379 Date: 05-15-13

10.	DESC	RIPTION	DATE
1	ADDENDU	Л 2	5-31-13
ATE	ISSUED:	05/15/2013	
EVI	EWED BY:	PAJ	

DESIGNED BY: MDN / PAJ AEP PROJECT NUMBER


213-1882-114

SJL


SHEET TITLE THIRD LEVEL **LOAD MAP**

SHEET NUMBER


S103A

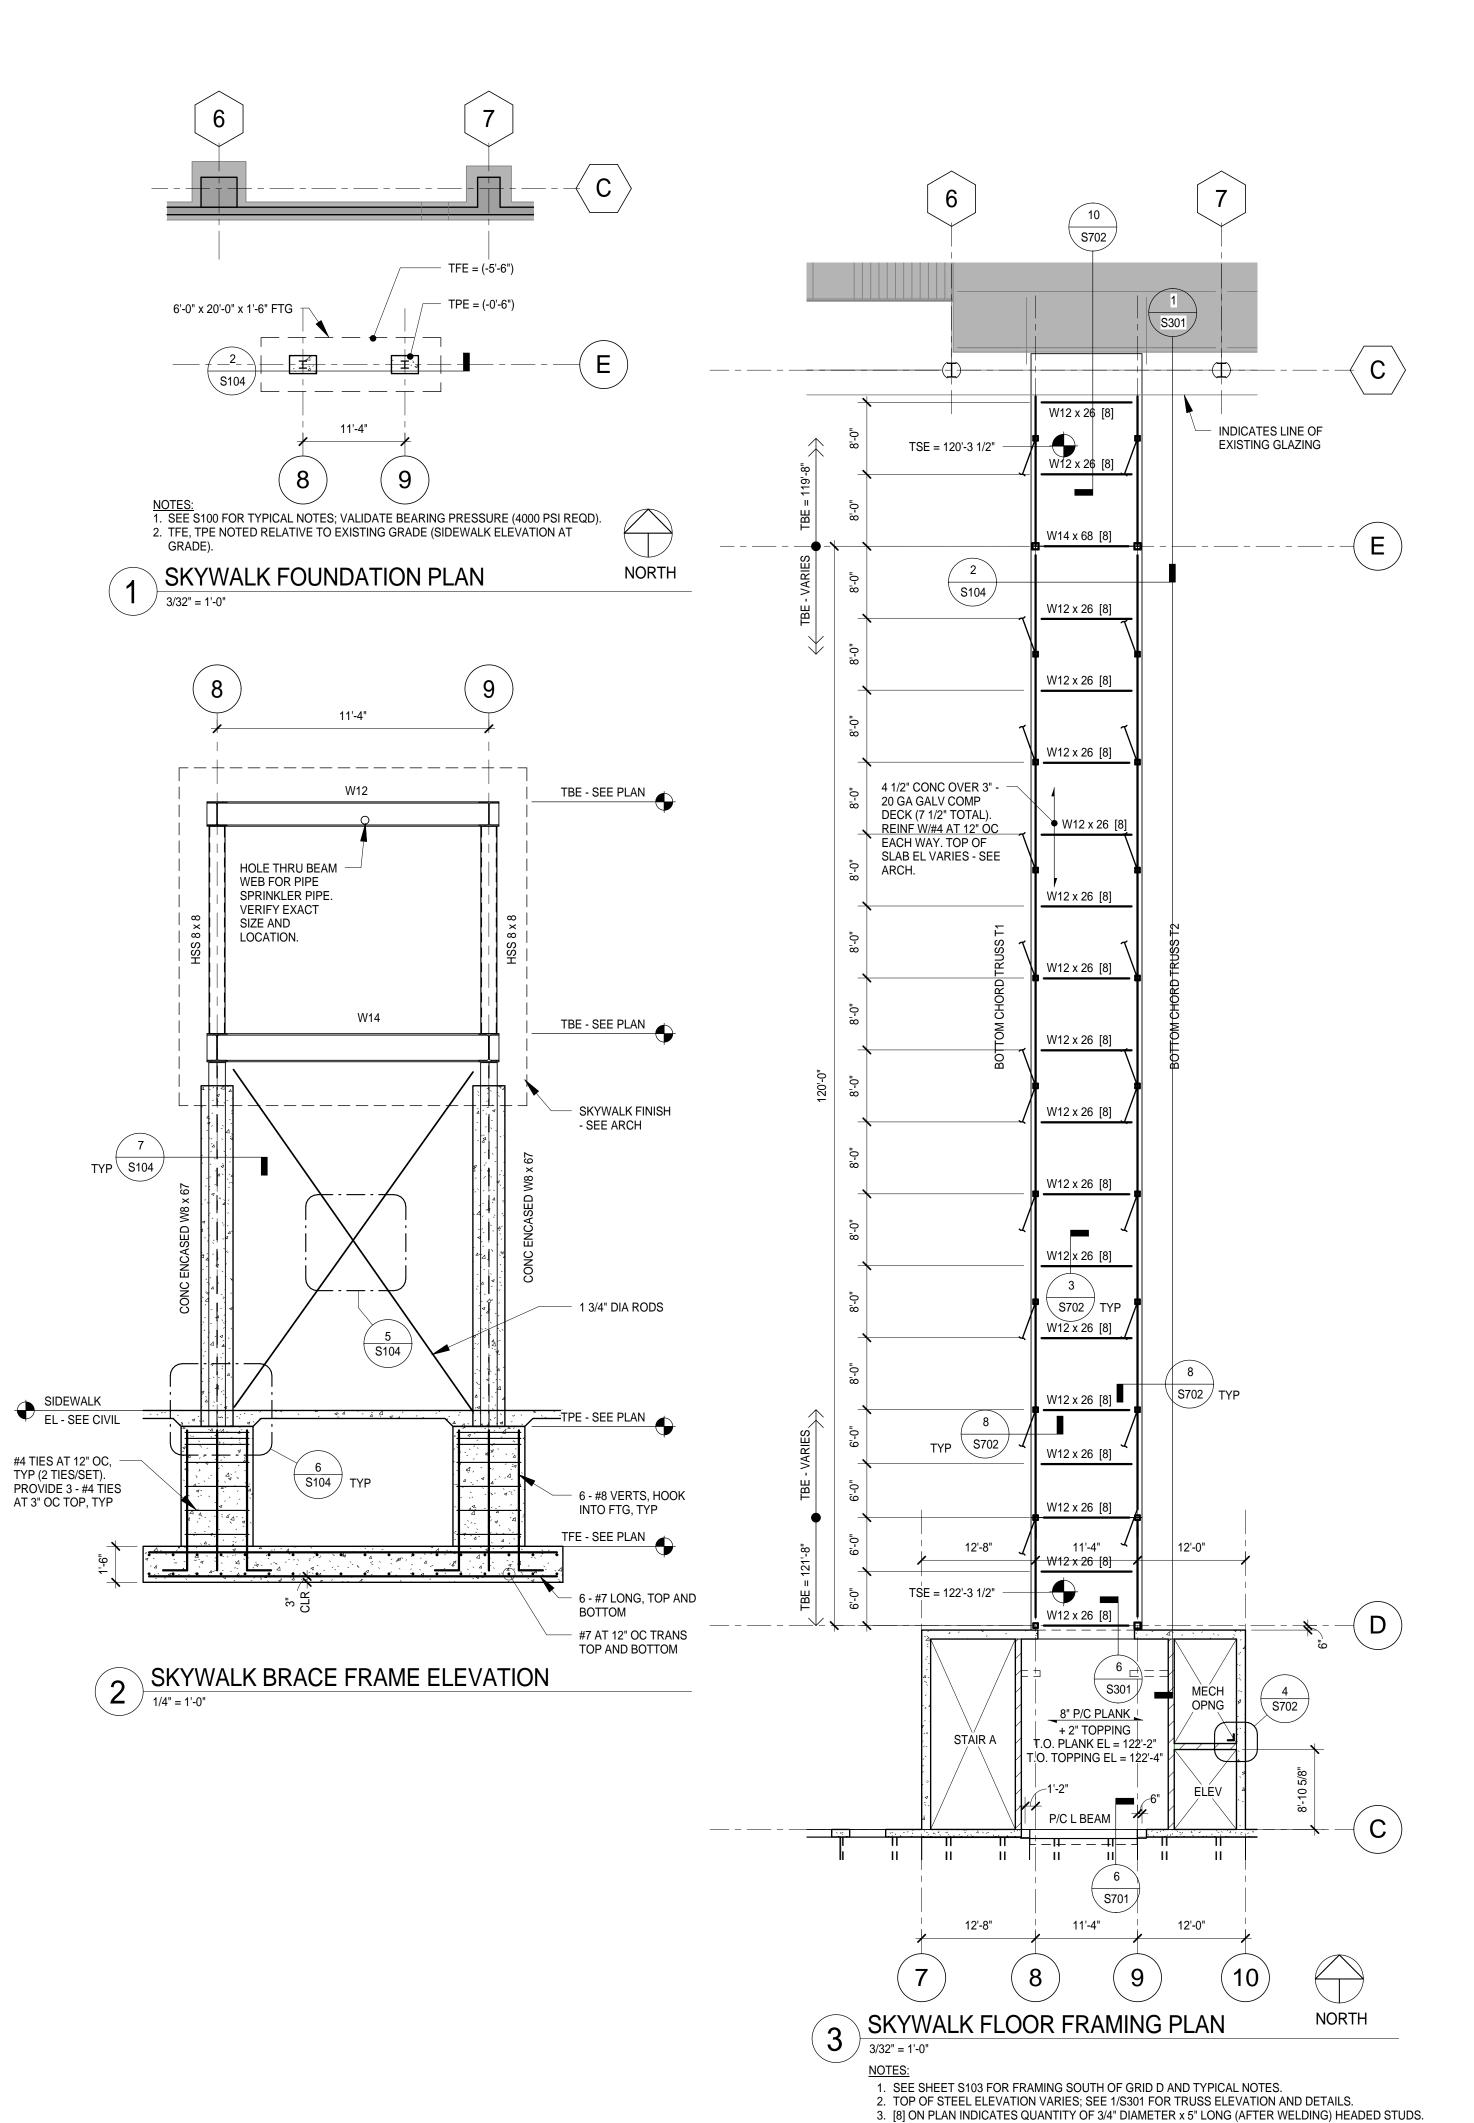

SEE 3/S702 AND GENERAL STRUCTURAL NOTES.

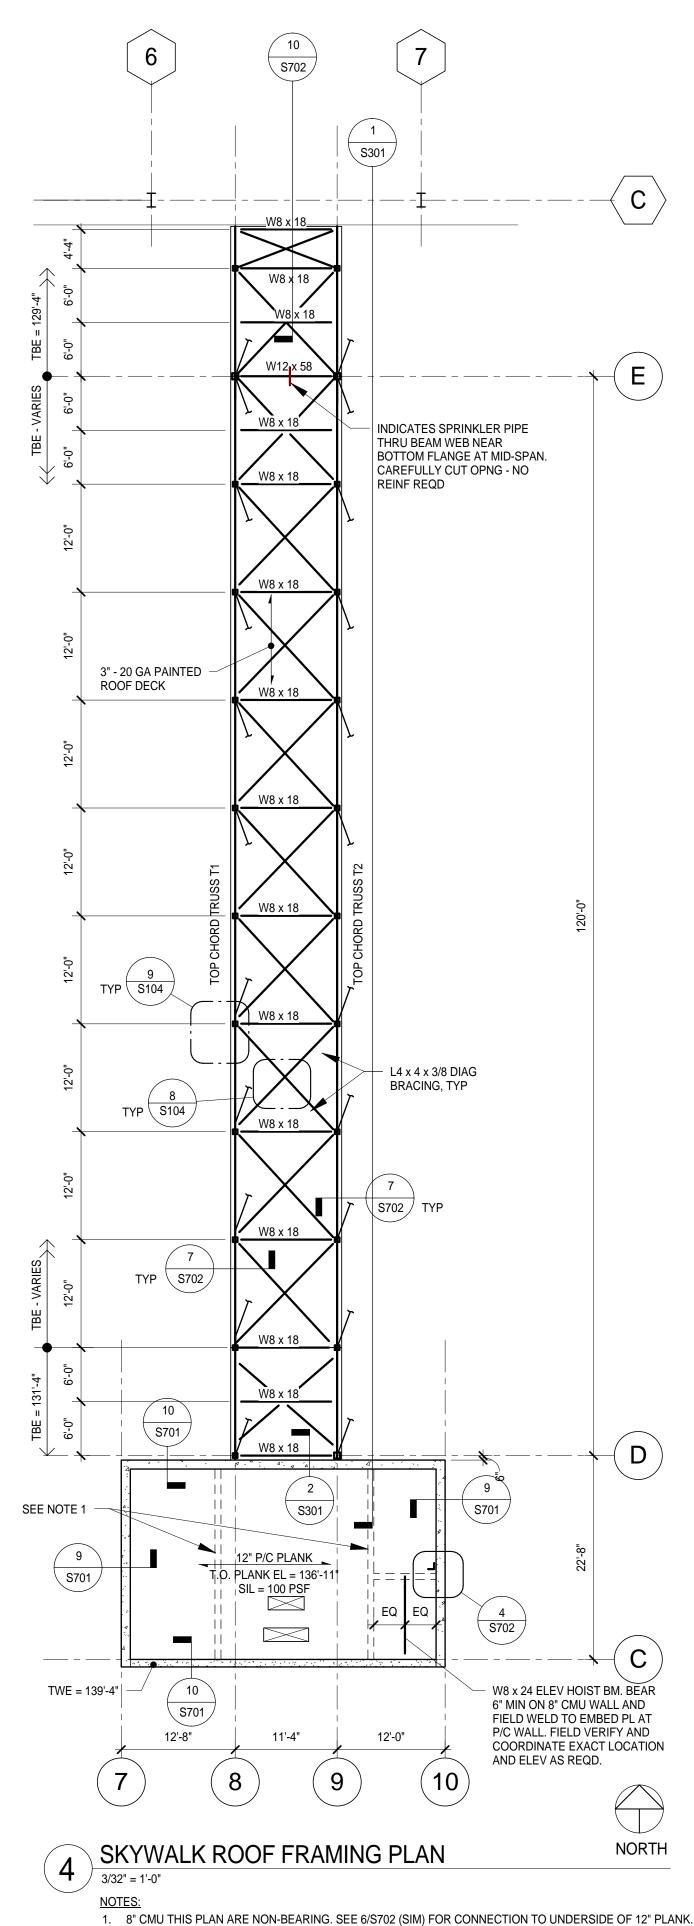


2. SEE 11/S701 FOR OPENING DETAIL THROUGH PLANK.

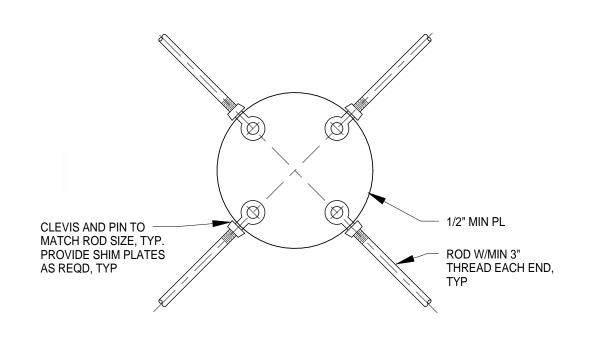


5 SECTION AT BRACING INTERSECTION

3/4" = 1'-0"

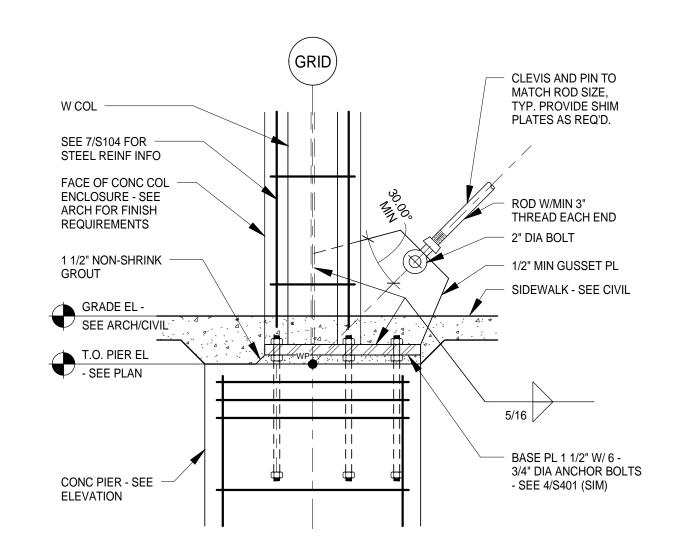


6 SECTION AT COLUMN BASE
3/4" = 1'-0"

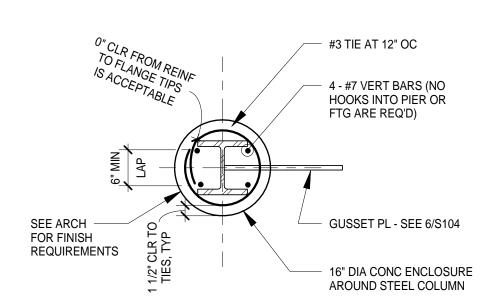

NOTES:

1. SEE PLAN FOR LOCATIONS.

7 CONCRETE ENCASED WIDE FLANGE COLUMN
3/4" = 1'-0"

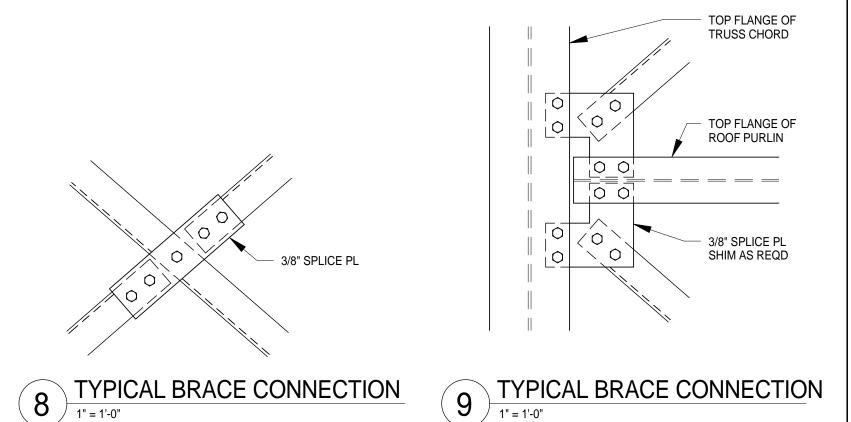

ISSETT.

IMPROVING YOUR WORLD

Reynolds, Smith and Hills, Inc.

4525 Airport Approach Rd, Ste A Duluth, Minnesota 55811 218-722-1227 FAX 218-722-1052 www.rsandh.com



DULUTH
INTERNATIONAL
AIRPORT
DULUTH, MN

NEW PARKING STRUCTURE AND EXTERIOR WAYFINDING SIGNAGE

CONSULTANTS

Interior Architects: **TKDA ARCHITECTS**11 E Superior Street Suite 340, Duluth MN 55802

TEL: (218) 724-8578 / FAX: (218) 724-8717

Structural Engineers:

MEYER BORGMAN JOHNSON

501 Lake Avenue South, Suite 300, Duluth MN 55802
TEL: (218) 722-1056 / FAX: (218) 722-9306

Landscape Architects:

ARCHITECTURAL RESOURCES

126 East Superior Street, Duluth MN 55802
TEL: (218) 727-8481 / FAX: (218) 727-8483

I hereby certify that this plan, specification, or report was prepared by me or under my direct supervision and that I am a duly licensed Professional Engineer under the laws of the State of Minnesota.

Paul A. Johnso
/
hum

Date: 05-15-13 Reg. No.: 20379

REVIS	SIONS		
NO.	DESCF	RIPTION	DATE
DATE IS	SSUED:	05/15/2013	
REVIEW	/ED BY:	PAJ	
DRAWN	BY:	SJL	

PAJ

DRAWN BY: SJL

DESIGNED BY: MDN / PAJ

AEP PROJECT NUMBER


AEP PROJECT NUMBE 213-1882-114

SHEET TITLE

SKYWALK FLOOR AND ROOF FRAMING PLANS

SHEET NUMBER

S104

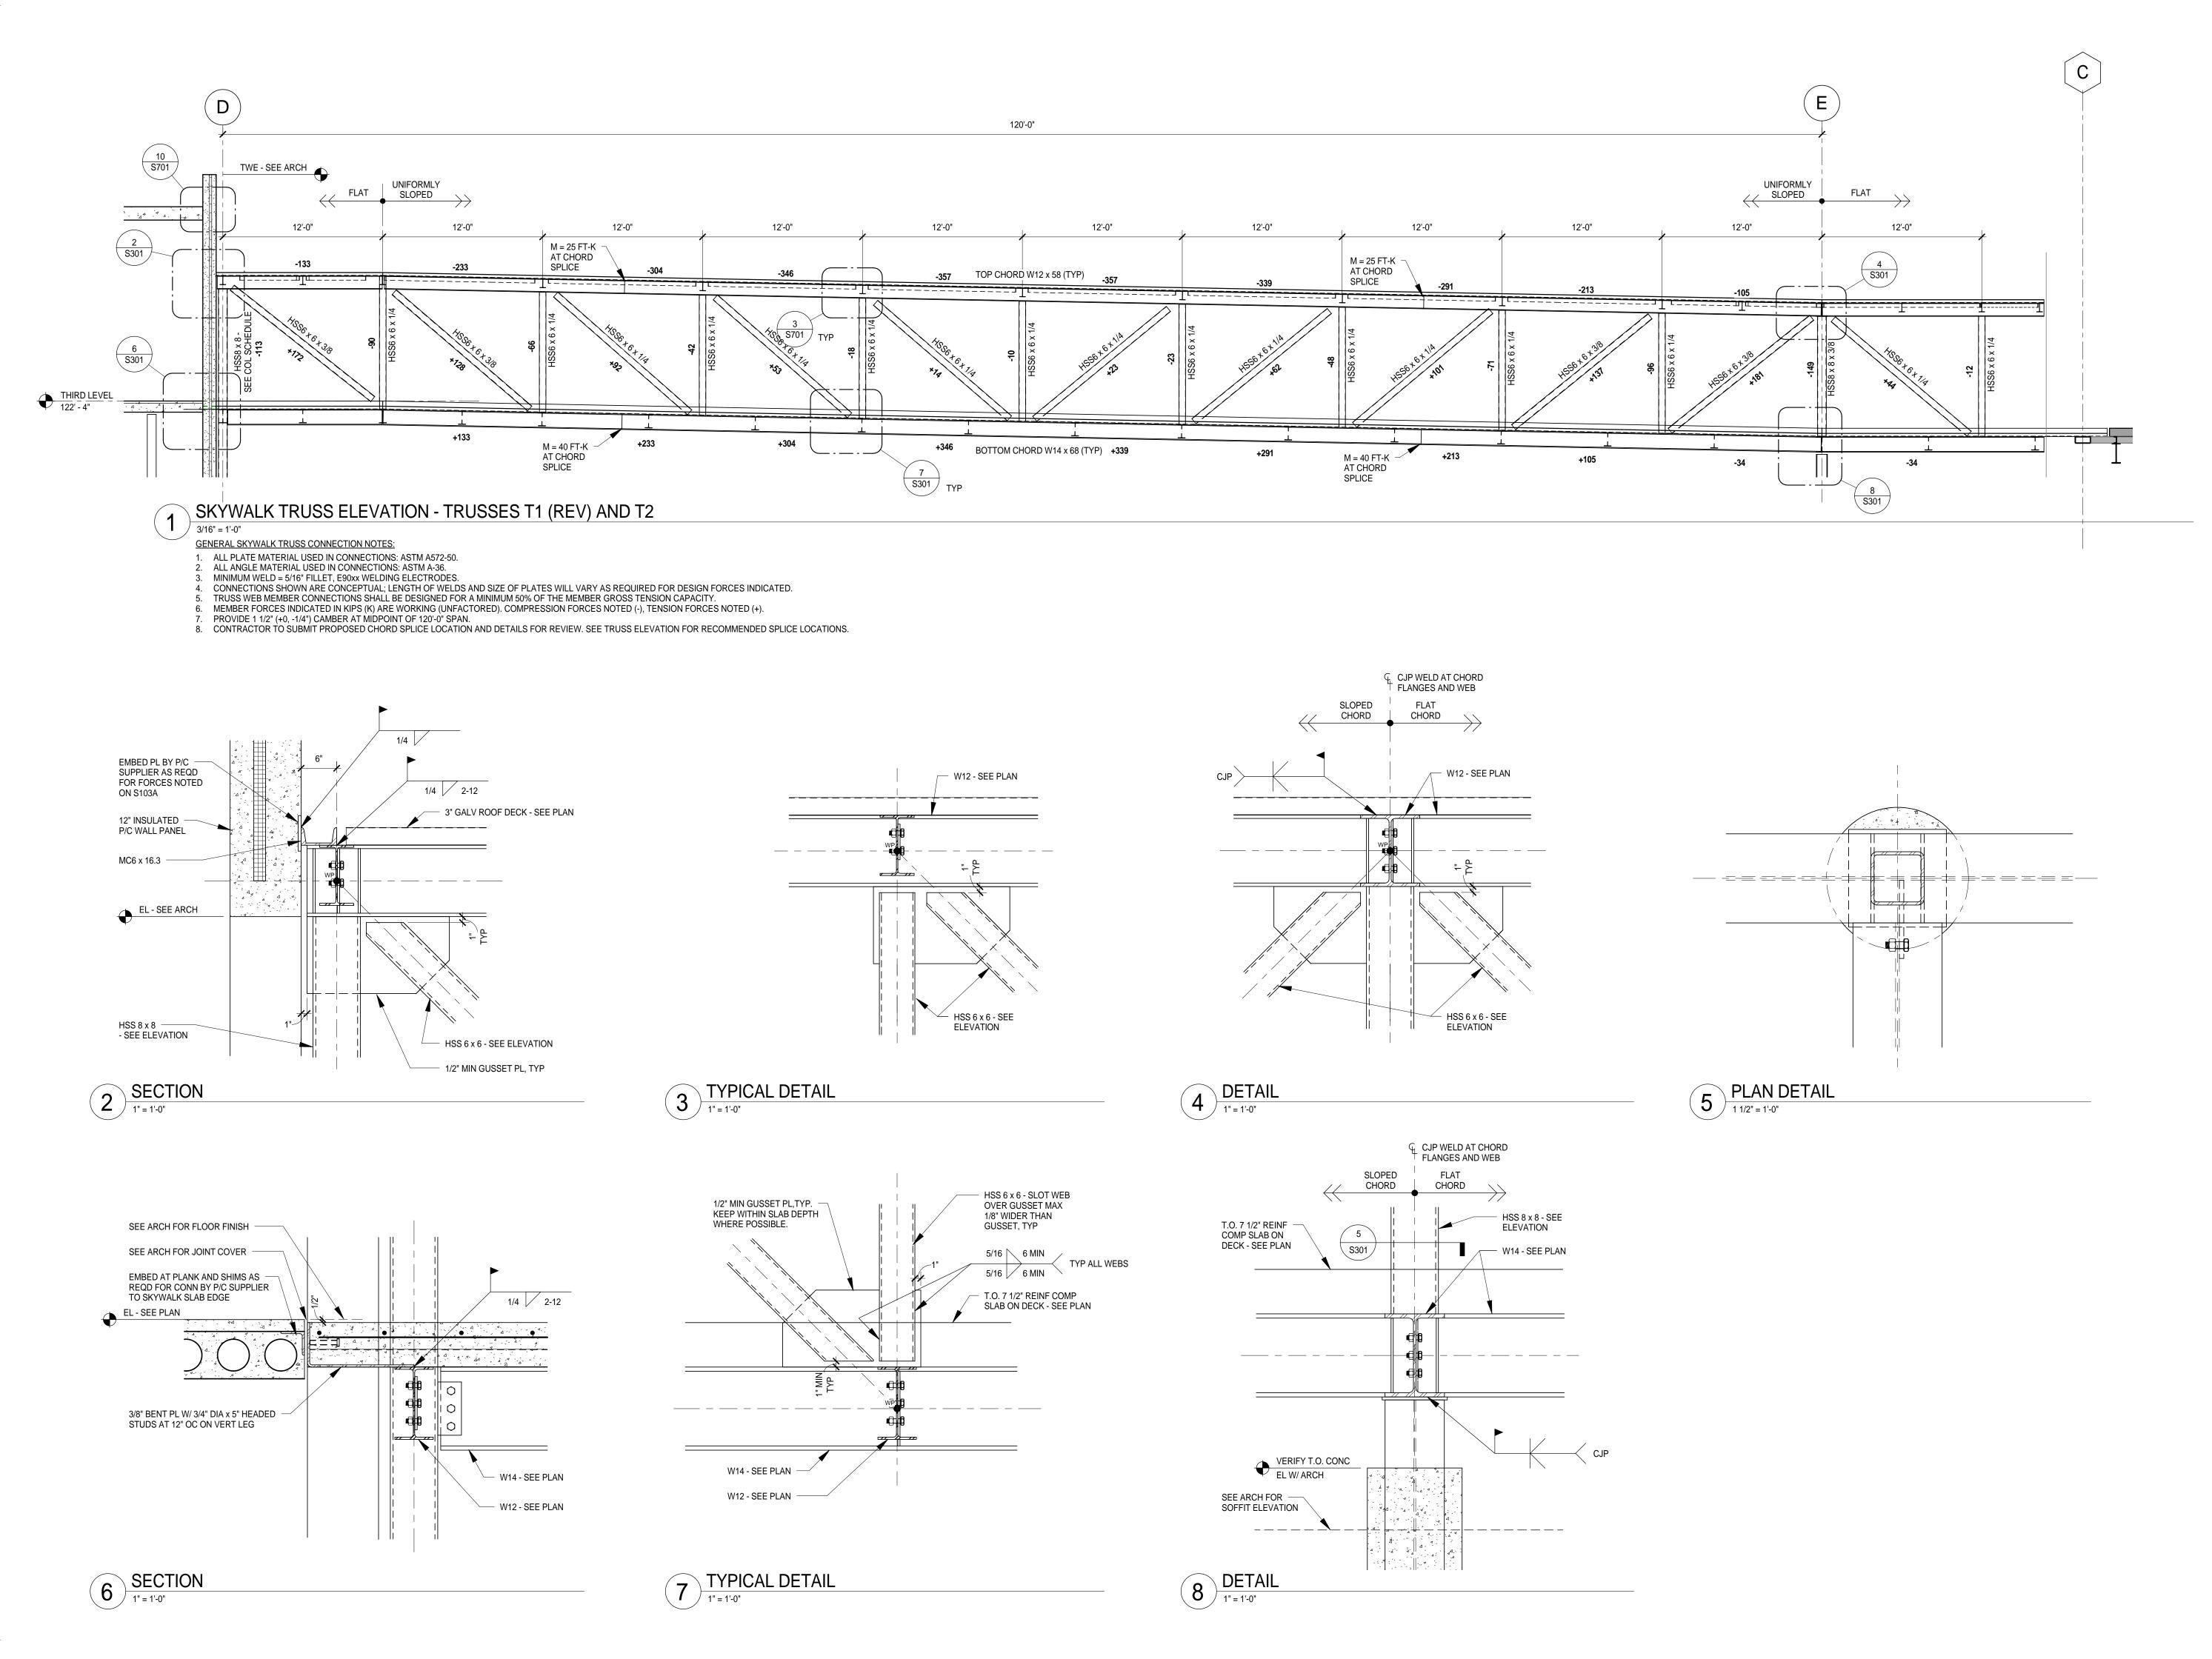



Reynolds, Smith and Hills, Inc.

4525 Airport Approach Rd, Ste A Duluth, Minnesota 55811 218-722-1227 FAX 218-722-1052 www.rsandh.com



DULUTH
INTERNATIONAL
AIRPORT
DULUTH, MN

NEW PARKING
STRUCTURE
AND EXTERIOR
WAYFINDING SIGNAGE

CONSULTANTS

Interior Architects: **TKDA ARCHITECTS**11 E Superior Street Suite 340, Duluth MN 55802

TEL: (218) 724-8578 / FAX: (218) 724-8717

Structural Engineers:

MEYER BORGMAN JOHNSON

501 Lake Avenue South, Suite 300, Duluth MN 55802
TEL: (218) 722-1056 / FAX: (218) 722-9306

Landscape Architects:

ARCHITECTURAL RESOURCES

126 East Superior Street, Duluth MN 55802
TEL: (218) 727-8481 / FAX: (218) 727-8483

I hereby certify that this plan, specification, or report was prepared by me or under my direct supervision and that I am a duly licensed Professional Engineer under the laws of the State of Minnesota.

Print Name:	Paul A. Johnso
	71-11
Signature:	Tall a phonon
,	- //

Date: 05-15-13 Reg. No.: 20379

RE\	/ISIONS		
NO.	DESC	RIPTION	DATE
DATE	LISSUED:	05/15/2013	<u>I</u>

DESIGNED BY: MDN / PAJ

AEP PROJECT NUMBER

SJL

REVIEWED BY: PAJ

DRAWN BY:

213-1882-114
© 2012 REYNOLDS, SMITH AND HILLS INC

TRUSS
ELEVATION AND
DETAILS

SHEET NUMBER

S301

C	CONCRETE REINFORCING BAR LAP SPLICE SCHEDULE									
DAD 017E	f'c = 3,000 PSI		00 PSI f'c = 4,000 PS		f'c = 5,000 PSI		f'c ≥ 6,000 PSI			
BAR SIZE	CLASS A	CLASS B	CLASS A	CLASS B	CLASS A	CLASS B	CLASS A	CLASS B		
#3	18"	22"	16"	20"	14"	18"	12"	16"		
#4	22"	30"	20"	26"	18"	22"	16"	20"		
#5	28"	36"	24"	32"	22"	28"	20"	26"		
#6	34"	44"	30"	38"	26"	34"	24"	32"		
#7	48"	64"	42"	54"	38"	50"	34"	44"		
#8	56"	72"	48"	62"	44"	56"	40"	52"		
#9	62"	82"	54"	70"	48"	64"	44"	58"		
#10	70"	92"	62"	80"	54"	70"	50"	64"		
#11	78"	102"	68"	88"	60"	78"	56"	72"		

1. REINFORCING BAR LAP SPLICE SCHEDULE APPLIES TO UNCOATED, GRADE 60 REINFORCING BARS IN

NORMAL WEIGHT CONCRETE. 2. PROVIDE CLASS A LAP UNLESS NOTED OTHERWISE

C1

COLUMN MARK

3. FOR EPOXY COATED BAR, MULTIPLY THE ABOVE LENGTHS BY 1.5.

REINFORCING BAR LAP SPLICE SCHEDULE

4. FOR LIGHT WEIGHT CONCRETE, MULTIPLY THE ABOVE LENGTHS BY 1.3. 5. MAXIMUM SPACING OF BARS BEING LAPPED IS ONE FIFTH THE LAP SPLICE LENGTH, NOT TO EXCEED 6".

C2

CAST IN PLACE AND PRECAST COLUMN SCHEDULE

CMU REINFORCING BAR LAP SPLICE SCHEDULE: f'm = 2000 PSI						
6" CMU	8" CMU					
14"	14"					
21"	18"					
32"	22"					
<u>-</u>	38"					
<u>-</u>	52"					
	-					
	f'm = 2000 PS 6" CMU 14" 21"					

ONE BAR PER CELL LOCATED IN THE CENTER OF THE CELL

C10

1. REINFORCING BAR DEVELOPMENT LENGTH SCHEDULE APPLIES TO UNCOATED, GRADE 60 REINFORCING BARS IN ASTM C 90 HOLLOW UNITS.

- 2. FOR EPOXY COATED BAR, MULTIPLY THE ABOVE LENGTHS BY 1.5. 3. MAXIMUM SPACING OF BARS BEING LAPPED IS ONE FIFTH THE LAP SPLICE LENGTH,
- NOT TO EXCEED 8".
- 4. REINFORCING BARS SHALL BE LAPPED IN THE SAME CMU CELL. 5. ALL BARS MUST BE PLACED IN FULLY GROUTED CELLS OR BOND BEAMS.

C7, C8


CMU REINFORCING BAR LAP SPLICE SCHEDULE

C9

BEAM SHEAR CONNECTION SCHEDULE							
BEAM SIZE	MINIMUM ROWS OF BOLTS	MINIMUM DESIGN [SERVICE CAPACITY] (KIPS)	COMMENTS				
W8	2	8					
W10	2	8					
W12	3	16					
W14	3	16					
W16	3	26					
W18	4	26					

1. CONTRACTOR/FABRICATOR SHALL DESIGN CONNECTIONS FOR THIS PROJECT. CONNECTION TYPES SHALL CONFORM TO AISC STANDARD SHEAR CONNECTIONS.

3. ALL BOLTS SHALL BE 3/4" DIA A325-N (MINIMUM) UNLESS NOTED OTHERWISE ON DRAWINGS.

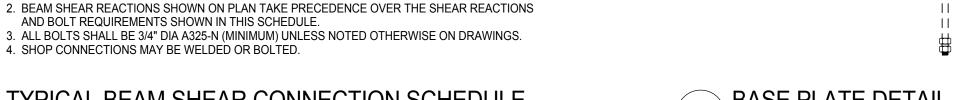

5/16

T.O. CONC

EL - SEE PLAN

4'-0" MAX TO

-END OF WALL

OR CORNER

CONTROL JOINT THROUGH BOND BEAM PLAN DETAILS FOR REINFORCING REQUIREMENTS

SEE TYPICAL CMU WALL

CONTROL JOINT - SEE

TYPICAL DETAIL

END OF WALL OR

LINTEL - SEE LINTEL SCHEDULE


END OF WALL OR CORNER


JAMB REINFORCING

- SEE JAMB SCHEDULE

CORNER REINFORCING

- SEE TYPICAL DETAIL

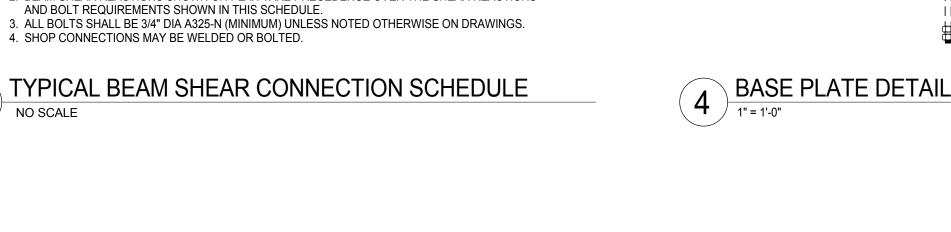

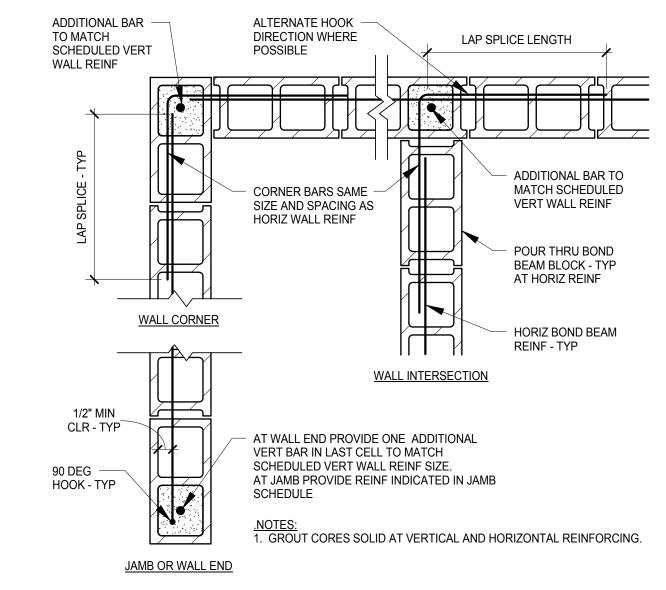

6 TYPICAL CMU WALL REINFORCING PLAN DETAILS
NO SCALE

CONTROL JOINT SPACING

24'-0" MAX

CONTROL JOINT - SEE TYPICAL DETAIL

4'-0" MIN

TO WALL OPENING

NEAREST COLUMN GRID	B-1	B-2	B-8	B-11	D-8, D-11	C-8, C-11	A.3-1, A.7-1, B.3-11, B.7-11	4 THUS AT SW STAIR TOWER
LEVEL 3								.O. COL
LEVEL 2	16 x 24 P/C W/ HAUNCHES (IT BEAM AND DT) AAL AAL	 	24 P/C W/ HAUNCH (IT BEAM ONLY)	 	8/8 × 8 × 8 × 8 × 8 × 8 × 8 × 8 × 8 × 8	16 x 16 P/C W/ HAUNCHES	4 S502	HSS 6 x 6 x 1/4
LEVEL 1						SIP COL CIP WALL		4 S401
TFE 	38 x 40 CIP COL	27 x 27 CIP COL	27 x 27 CIP COL	38 x 40 CIP COL	16 x 26 CIP COL	16 x 16 CIP COL WITHIN 16" CIP WALL	20 × 12 CIP COL 'WITHIN 12" CIP WALL	SIM
CIP COLUMN DETAIL	8 - #9 VERT	8 - #9 VERT	8 - #9 VERT	8 - #9 VERT	4 - #9 VERT	4 - #6 VERT	6 - #6 VERT	
DOWELS TO FOUNDATION	#4 TIES AT 12" OC 3 TIES/SET 8 - #7 W/ HOOK	#4 TIES AT 12" OC 3 TIES/SET 8 - #7 W/ HOOK	#4 TIES AT 12" OC 3 TIES/SET 8 - #7 W/ HOOK	#4 TIES AT 12" OC 3 TIES/SET 8 - #7 W/ HOOK	#4 TIES AT 12" OC 4 - #7 W/ HOOK	#4 TIES AT 12" OC 4 - #5 W/ HOOK	#4 TIES AT 12" OC 6 - #5 W/ HOOK	
DEMARKS	TIES MAY BE			TIES MAY BE			EXTEND WALL REINF	BASE PL 3/4 x 12 x 1'-0"

FABRICATED AND

PLACED FOR 38 x 38 COL

C5, C6

REMARKS

NOTES:

1. REFER TO PLAN FOR TOP OF FOOTING ELEVATION AND TOP OF COLUMN ELEVATIONS. 2. REFER TO GENERAL NOTES FOR CONCRETE STRENGTH AND CONCRETE COVER INFORMATION.

FABRICATED AND

PLACED FOR 38 x 38 COL


- 3. PRECAST COLUMN BASE PL AND ANCHOR BOLT DESIGN BY P/C SUPPLIER, TYPICAL. 4. REFER TO PLAN AND DETAILS FOR BEAM BEARING ELEVATIONS AND ORIENTATION OF HAUNCHES.
- 5. ALL CAST IN PLACE COLUMNS BELOW LEVEL 1 SHALL BE INTEGRAL WITH ADJACENT FOUNDATION WALLS.
- 6. CONCRETE COVER TO TIES SHALL BE 1 1/2" (OR GREATER WHERE NOTED), TYPICAL. 7. PROVIDE CROSS TIES AS INDICATED.

COLUMN SCHEDULE

			C	CMU WALI	REINFO	RCING S	CHEDULE	Ē		
				REINF	ORCING	i				
NONAINIAI						WALL C	PENING	SIZE		
NOMINAL CMU WALL	VERTICAL	≤ 4	'-0"	≤ 8'	'-0"	≤ 12	2'-0"	≤ 16	6'-0"	
THICKNESS	FIELD	LINTEL	JAMB	LINTEL	JAMB	LINTEL	JAMB	LINTEL	JAMB	COMMENTS
6"	#4 AT 48" OC	8" HIGH 1 - #4	8" WIDE 1 - #4	8" HIGH 1 - #6	8" WIDE 1 - #6	16" HIGH 1 - #4	16" WIDE 4 - #4	24" DEEP 1 - #5	24" WIDE 3 - #6	
8" (NON-LOAD BRG)	#5 AT 32" OC	8" HIGH 2 - #5	8" WIDE 1 - #5	8" HIGH 2 - #5	8" WIDE 1 - #5	16" DEEP 2 - #5	8" WIDE 2 - #5	24" DEEP 2 - #5	16" WIDE 4 - #5	PARTITIONS WITHIN THE PARKING AREA
8" (LOAD BRG)	#5 AT 16" OC	8" HIGH 2 - #5	8" WIDE 2 - #5	8" HIGH 2 - #5	8" WIDE 2 - #5	16" DEEP 2 - #5	16" WIDE 2 - #5	24" DEEP 2 - #5	16" WIDE 2 - #5	VERTICAL CIRCULATION TOWER

- 1. WALL HEIGHT INDICATES MAXIMUM ALLOWABLE VERTICAL CLEAR DISTANCE BETWEEN POINTS OF CONTINUOUS LATERAL WALL SUPPORT.
- VERTICAL REINFORCEMENT SHALL BE LOCATED IN THE CENTER OF THE WALL. CMU LINTELS SHALL BE GROUTED SOLID WITH A MINIMUM OF 2" BOTTOM COVER TO REINFORCING.
- PROVIDE 8" BEARING ON JAMBS AT EACH END OF CMU LINTELS. 5. JAMB REINFORCING SPECIFIED SHALL BE EVENLY DISTRIBUTED ALONG THE JAMB WIDTH. AT LOCATIONS WITH 2 BARS PER CELL, BARS SHALL BE PLACED PER CASE 2 OF THE
- CMU REINFORCING BAR LAP SPLICE SCHEDULE. 6. SEE ARCH FOR LOCATIONS AND SIZES OF INTERIOR NON-LOAD BEARING CMU WALLS.
- 7. SEE TYPICAL CMU WALL DETAILS FOR ADDITIONAL INFORMATION.

CMU WALL REINFORCING SCHEDULE NO SCALE

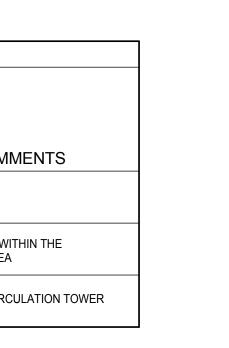

CONT THRU COL

W/ 4 - 3/4" DIA AB

BOND BEAM REINFORCING -

SEE TOP OF WALL DETAILS

LINTEL REINFORCING -

SEE LINTEL SCHEDULE

JAMB REINFORCING

- SEE JAMB SCHEDULE

- SEE WALL DETAILS 1. JAMB AND END OF WALL REINFORCING SHALL BE FULL HEIGHT OF WALL AND SHALL BE IN ADDITION TO TYPICAL VERTICAL WALL REINFORCING. 2. PROVIDE CONTROL JOINTS TO MEET SPACING REQUIREMENTS SHOWN AND AT LOCATIONS WHERE CHANGES IN WALL HEIGHT OCCUR, WHERE CHANGES IN WALL THICKNESS OCCUR, AND WHERE MOVEMENT

JOINTS IN THE FLOOR ABOVE AND/OR BELOW OCCUR. 3. SEE ARCHITECTURAL DRAWINGS FOR CONTROL JOINT LOCATIONS AT NON-LOAD BEARING WALLS NOT SHOWN ON STRUCTURAL DRAWINGS.

— SILL REINFORCING

4. SEE ARCHITECTURAL DRAWINGS FOR WALL OPENINGS NOT SHOWN ON STRUCTURAL DRAWINGS. 5. PROVIDE CLEANOUT AT BOTTOM COURSE FOR GROUT PORES GREATER THAN 5'-0" HIGH.

TYPICAL VERTICAL

WALL REINF - SEE

CMU WALL SCHEDULE

6. SILL REINFORCING SHALL BE LADDER JOINT REINFORCING IN THE FIRST OR SECOND MORTAR JOINT BELOW THE SILL OR A REINFORCED BOND BEAM. SILL REINFORCING SHALL EXTEND BETWEEN CONTROL JOINTS. 7. SEE CMU WALL REINFORCING SCHEDULE FOR LINTEL AND JAMB REINFORCING REQUIRED.

DOWELS TO STRUCTURE BELOW TO

MATCH VERT REINF SIZE AND LOCATION

TYPICAL CMU WALL REINFORCING SCHEMATIC

12" MIN

TYP



HSS COL - SEE PLAN AND SCHEDULE

BASE PL 1 x 14 x 1'-2"

1 1/2" GROUT

4 - 3/4" DIA x 2'-0"

WASHER AND NUT

THREADED AB W/ HEAVY

Reynolds, Smith and Hills, Inc.

4525 Airport Approach Rd, Ste A Duluth, Minnesota 55811 218-722-1227 FAX 218-722-1052 www.rsandh.com



DULUTH INTERNATIONAL **AIRPORT** DULUTH, MN

NEW PARKING STRUCTURE **AND EXTERIOR WAYFINDING SIGNAGE**

CONSULTANTS

Interior Architects: TKDA ARCHITECTS 11 E Superior Street Suite 340, Duluth MN 55802 TEL: (218) 724-8578 / FAX: (218) 724-8717

Structural Engineers: MEYER BORGMAN JOHNSON 501 Lake Avenue South, Suite 300, Duluth MN 55802 TEL: (218) 722-1056 / FAX: (218) 722-9306

Landscape Architects: ARCHITECTURAL RESOURCES 126 East Superior Street, Duluth MN 55802 TEL: (218) 727-8481 / FAX: (218) 727-8483

I hereby certify that this plan, specification, or report was prepared by me or under my direct supervision and that I am a duly licensed Professional Engineer under the

laws of the State of Minne	esota.
Print Name:	Paul A. Johnson
Signature: Pull ()	phonon

Reg. No.: 20379

REVISIONS

Date: 05-15-13

NO.	DESCRIPTION	DATE

DATE ISSUED: 05/15/2013 REVIEWED BY: PAJ

DRAWN BY: SJL

DESIGNED BY: MDN / PAJ AEP PROJECT NUMBER

213-1882-114


(C) 2012 REYNOLDS, SMITH AND HILLS INC. SHEET TITLE

SCHEDULES

SHEET NUMBER


S401

1 TYPICAL COLUMN ISOLATION JOINT NO SCALE

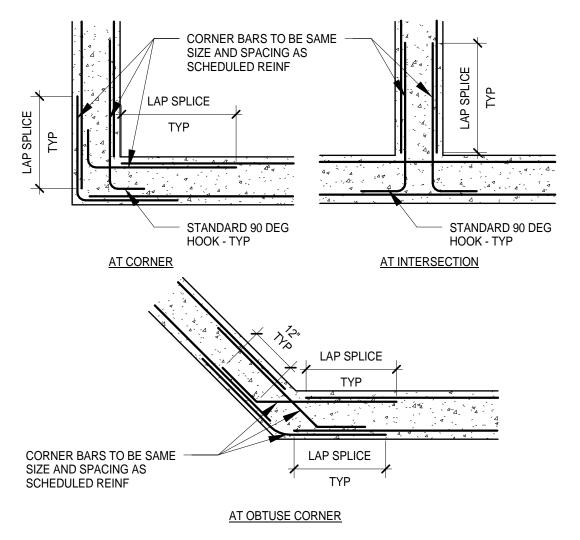


NOTES:
1. VERTICAL REINFORCING NOT SHOWN FOR CLARITY

5 TYPICAL CORNER BAR PLACING DETAIL NO SCALE

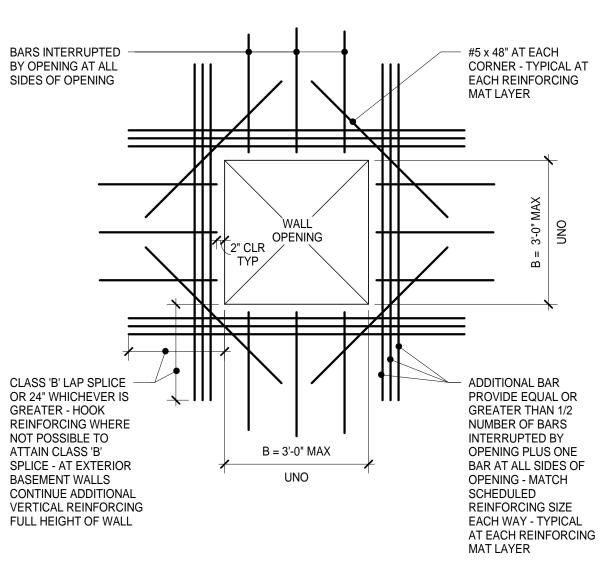

TYPICAL ADDITIONAL BAR PLACING DETAIL FOR WALL OPENING

NO SCALE

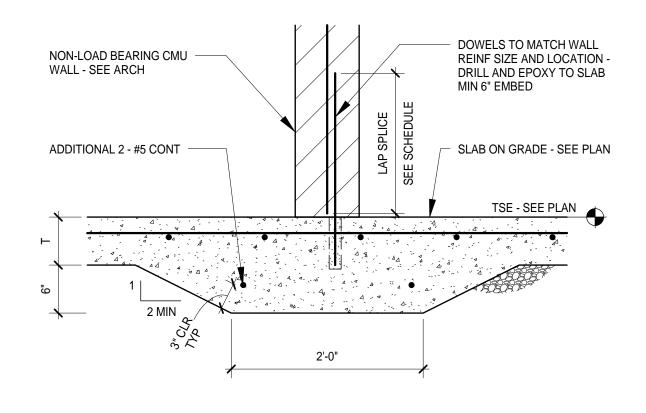


NOTES:

1. SEE NON-LOAD BEARING CMU WALL REINFORCING SCHEDULE FOR ADDITIONAL INFORMATION.

2. THICKENED SLAB SHALL BE CENTERED ON CMU WALL LOCATIONS, UNLESS NOTED OTHERWISE.

3. CONTRACTOR'S OPTION PROVIDE CAST-IN HOOKED DOWELS IN LIEU OF DRILL AND EPOXY DOWELS.

TYPICAL THICKENED SLAB ON GRADE AT INTERIOR NON-LOAD BEARING CMU WALL DETAIL NO SCALE

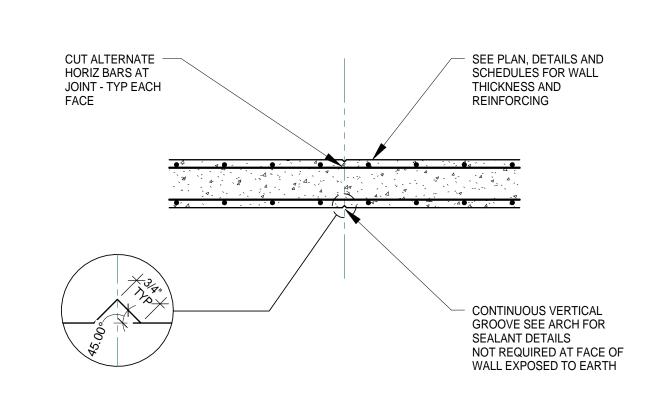

NOTES:


1. SUBMIT PROPOSED JOINT LOCATIONS FOR APPROVAL IF NOT SHOWN ON DRAWINGS.

2. MAXIMUM SPACING OF CONTROL JOINTS IS 20 FT ON CENTER OR 1 1/2 TIMES THE WALL HEIGHT ON CENTER, WHICHEVER IS LESS.

3. DO NOT USE THIS DETAIL FOR SHEAR WALLS OR WALLS THAT SPAN HORIZONTALLY.

TYPICAL VERTICAL CONTROL JOINT FOR CONCRETE WALLS


NO SCALE

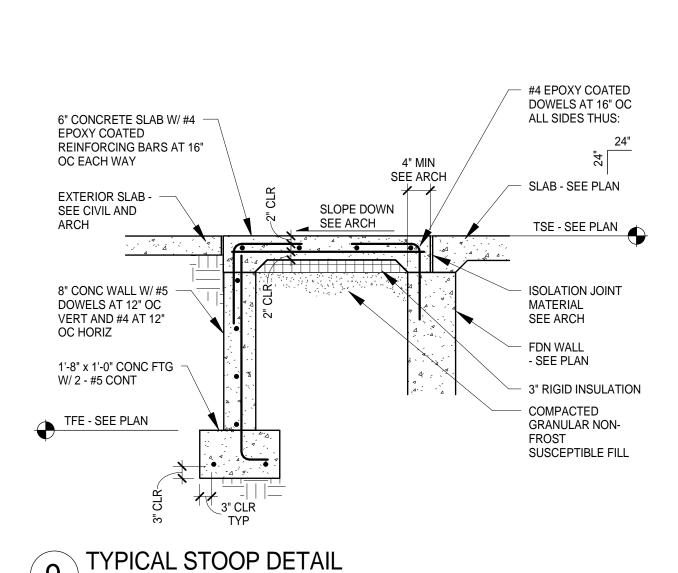

TYPICAL STOOP AND STAIR ON GRADE DETAIL
NO SCALE


NOTES:

1. SEE TYPICAL STOOP DETAIL FOR ADDITIONAL INFORMATION

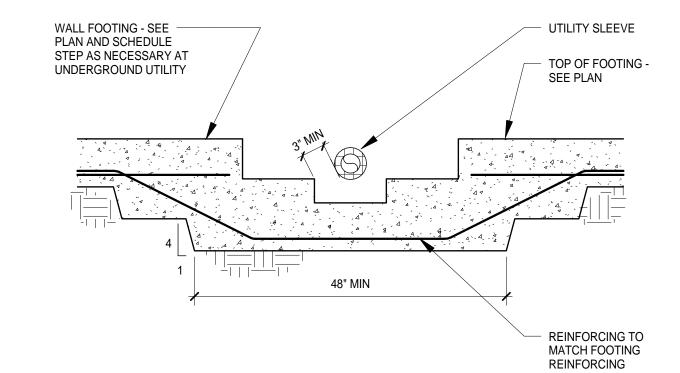

1. SEE TYPICAL WALL FOOTING STEP DETAIL FOR ADDITIONAL INFORMATION.
2. UTILITY SLEEVE DIAMETER TO BE 2" GREATER THAN UTILITY PIPE OUTSIDE DIAMETER. PROVIDE 1"
COMPRESSIBLE MATERIAL BETWEEN SLEEVE AND UTILITY.
3. AT FOOTINGS BELOW CMU WALLS, COORDINATE WALL FOOTING STEP LOCATIONS WITH CMU COURSING.

TYPICAL STEPPED WALL FOOTING AT UTILITIES NO SCALE

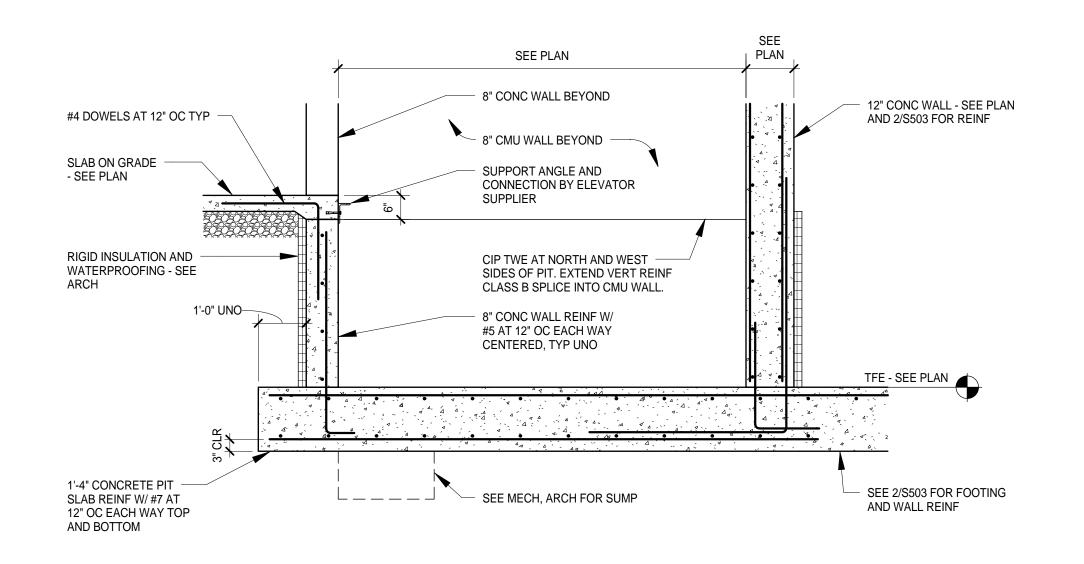

7 SECTION THRU ELEVATOR PIT NO SCALE

SEE ARCH FOR TREAD AND

RISER DIMENSIONS

#4 EPOXY COATED NOSING BAR - TYP

#4 EPOXY COATED

MATERIAL

ON GRADE

2 - #4 CONT

EXTERIOR SLAB

AT 16" OC EACH WAY

CONCRETE WALL

TFE - SEE PLAN

LAP REINFORCING

SEE LAP SPLICE

SCHEDULE - TYP

MATCH SIZE AND

REINFORCING

NO SCALE

SPACING OF FOOTING

NOTES:

1. SEE PLAN FOR FOOTING STEP LOCATIONS.

TYPICAL WALL FOOTING STEP

AND SCHEDULE

FOOTING - SEE PLAN

2S MIN

2. 'S' SHALL NOT EXCEED 16" FOR CMU WALLS OR 24" FOR CAST-IN-PLACE OR PRECAST CONCRETE WALLS.

1 1/2" CLR

- 2 SIDES

TYP

CONSTRUCTION JT

COMPACTED

GRANULAR FILL


2S MIN

TFE - SEE PLAN

CONCRETE WALL

AND SCHEDULE

FOOTING - SEE PLAN

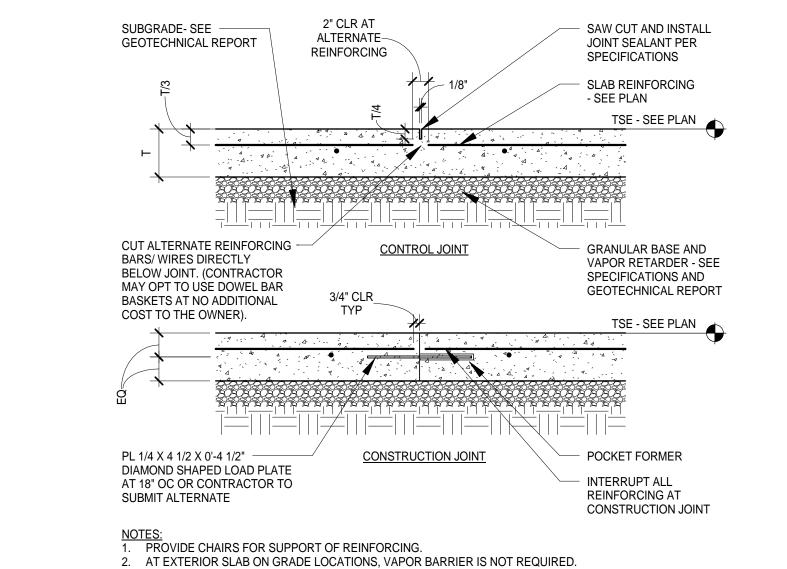

11 TYPICAL SLAB ON GRADE CONSTRUCTION
NO SCALE

3. PROVIDE DIAMOND SHAPED LOAD PLATE COMPLIANT WITH ACI 302.1 R.

ISSETT.

IMPROVING YOUR WORLD

Reynolds, Smith and Hills, Inc.

4525 Airport Approach Rd, Ste A
Duluth, Minnesota 55811
218-722-1227 FAX 218-722-1052

www.rsandh.com



DULUTH INTERNATIONAL AIRPORT DULUTH, MN

NEW PARKING STRUCTURE AND EXTERIOR WAYFINDING SIGNAGE

CONSULTANTS

Interior Architects: **TKDA ARCHITECTS**11 E Superior Street Suite 340, Duluth MN 55802

TEL: (218) 724-8578 / FAX: (218) 724-8717

Structural Engineers:

MEYER BORGMAN JOHNSON

501 Lake Avenue South, Suite 300, Duluth MN 55802
TEL: (218) 722-1056 / FAX: (218) 722-9306

Landscape Architects:

ARCHITECTURAL RESOURCES

126 East Superior Street, Duluth MN 55802
TEL: (218) 727-8481 / FAX: (218) 727-8483

I hereby certify that this plan, specification, or report was prepared by me or under my direct supervision and that I am a duly licensed Professional Engineer under the laws of the State of Minnesota.

Print Name:	Paul A. Johnso
Signature: Pull	A Johnson

Date: 05-15-13 Reg. No.: 20379

REVIS	SIONS			
NO.	DESCF	RIPTION	DATE	
		05/45/0040		
DATE	SSUED:	05/15/2013		
REVIEWED BY: PA		PAJ		

REVIEWED BY: PAJ

DRAWN BY: SJL

DESIGNED BY: MDN / PAJ

AEP PROJECT NUMBER


213-1882-114

SHEET TITLE

STRUCTURAL FOUNDATION DETAILS


SHEET NUMBER

S501

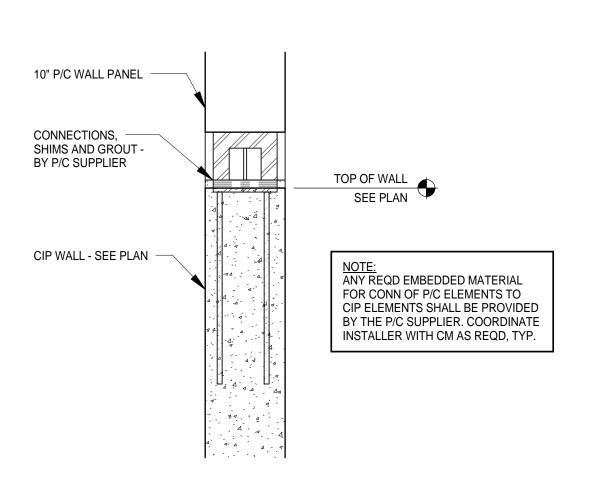

TYPICAL P/C WALL PANEL CONNECTION TO CIP FOUNDATION WALL


NO SCALE

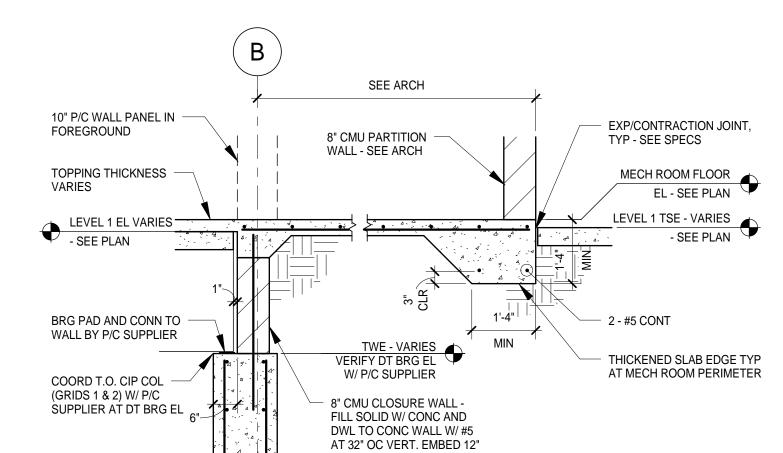


INTO CONC WALL AND SET

5 SECTION


1/2" = 1'-0"

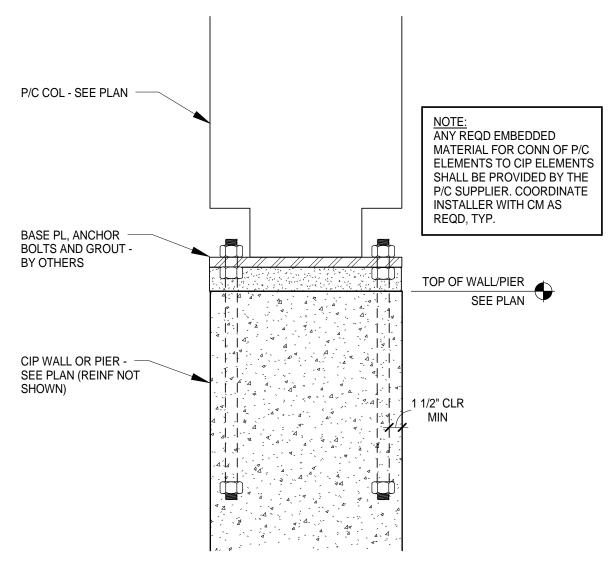


TYPICAL P/C COLUMN CONNECTION TO CIP 2 COLUMN/WALL

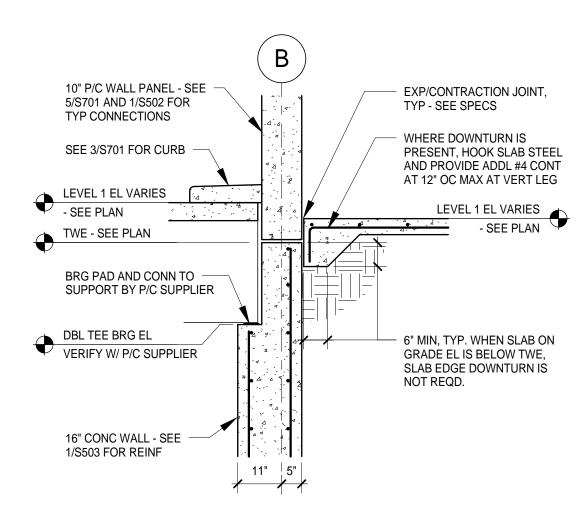


6 SECTION 1/2" = 1'-0"

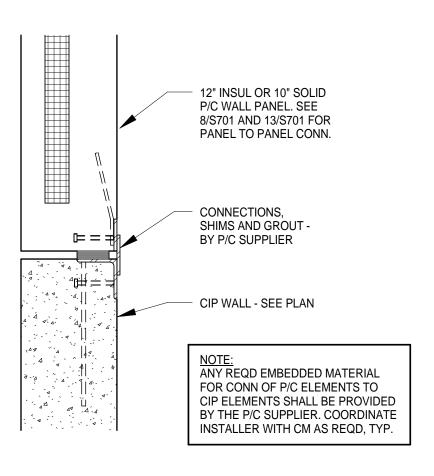


TYPICAL INSULATED P/C WALL PANEL CONNECTION TO CIP FOUNDATION WALL

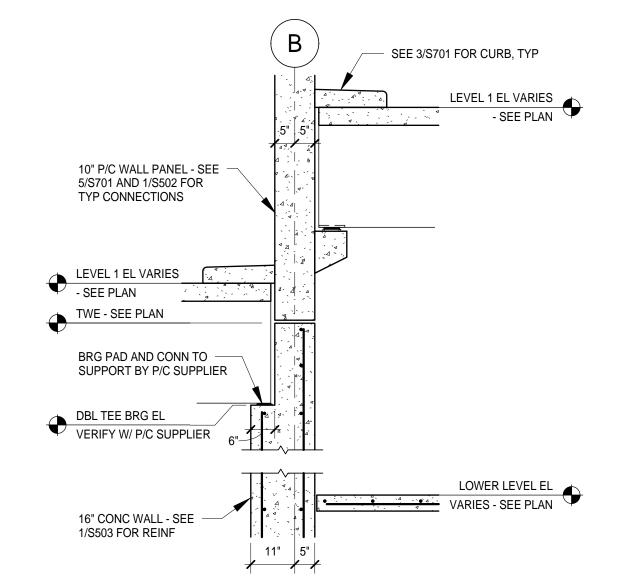

7 SECTION
1/2" = 1'-0"

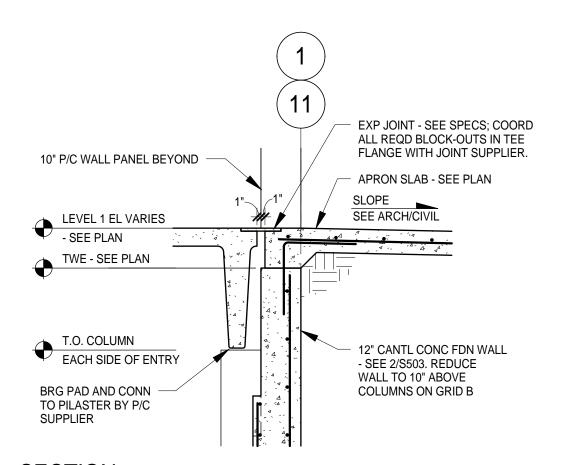



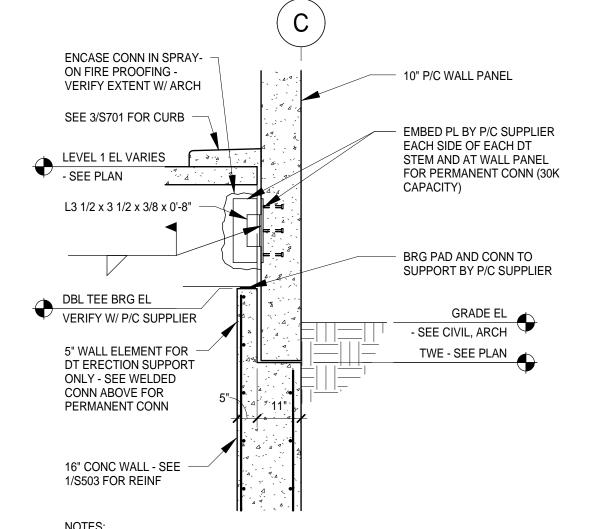

NOTES:

1. DETAIL APPLIES AT FOUR (4) DOUBLE TEES BETWEEN GRIDS 5 AND 7 (SEE PLAN). 2. COORDINATE FIREPROOFING REQUIREMENTS WITH ARCHITECTURAL.

SECTION



Reynolds, Smith and Hills, Inc.

4525 Airport Approach Rd, Ste A Duluth, Minnesota 55811 218-722-1227 FAX 218-722-1052 www.rsandh.com



DULUTH INTERNATIONAL **AIRPORT** DULUTH, MN

NEW PARKING STRUCTURE AND EXTERIOR WAYFINDING SIGNAGE

CONSULTANTS

Interior Architects: TKDA ARCHITECTS 11 E Superior Street Suite 340, Duluth MN 55802 TEL: (218) 724-8578 / FAX: (218) 724-8717

Structural Engineers: **MEYER BORGMAN JOHNSON** 501 Lake Avenue South, Suite 300, Duluth MN 55802 TEL: (218) 722-1056 / FAX: (218) 722-9306

Landscape Architects: ARCHITECTURAL RESOURCES 126 East Superior Street, Duluth MN 55802 TEL: (218) 727-8481 / FAX: (218) 727-8483

I hereby certify that this plan, specification, or report was prepared by me or under my direct supervision and that I am a duly licensed Professional Engineer under the laws of the State of Minnesota.

Print Name:	Paul A. Johnso
Signature:	O a lahmon
	C O C III

Date: 05-15-13 Reg. No.: 20379

REVISIONS NO. DESCRIPTION DATE **DATE ISSUED:** 05/15/2013

REVIEWED BY: PAJ DRAWN BY: SJL **DESIGNED BY:** MDN / PAJ

AEP PROJECT NUMBER


213-1882-114 (C) 2012 REYNOLDS, SMITH AND HILLS INC.

SHEET TITLE

STRUCTURAL FOUNDATION DETAILS

SHEET NUMBER

S502

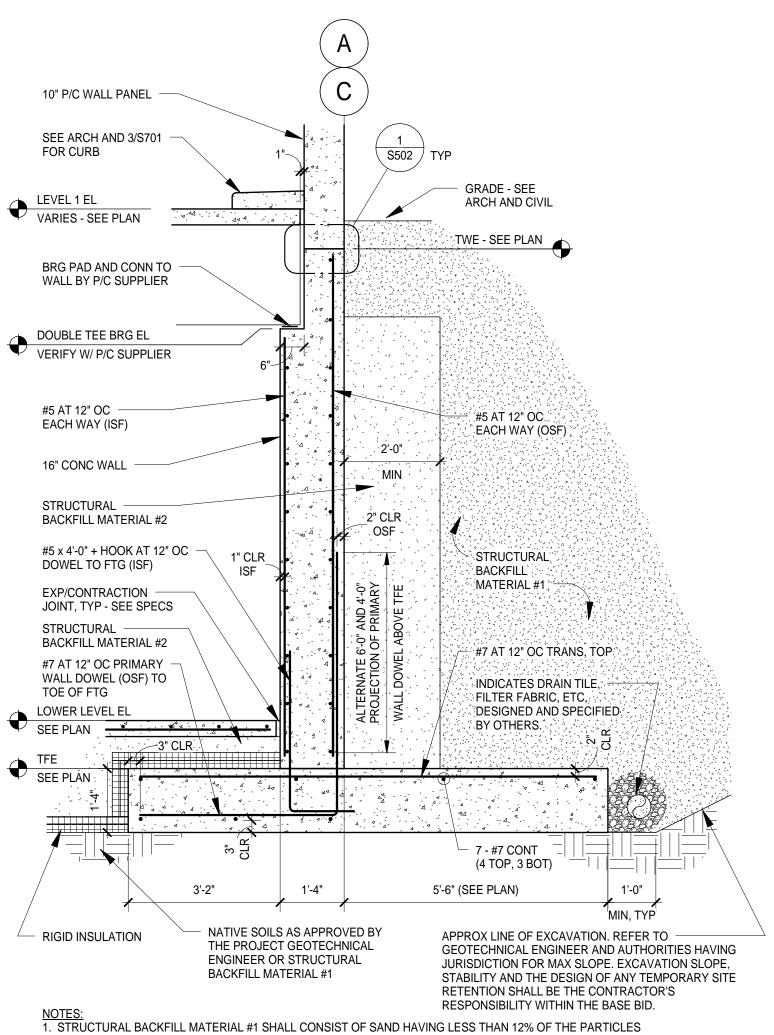

NOTES:


1. STRUCTURAL BACKFILL MATERIAL #1 SHALL CONSIST OF SAND HAVING LESS THAN 12% OF THE PARTICLES BY WEIGHT PASSING A #200 SIEVE. (REFER TO PROJECT GEOTECHNICAL REPORT).

2. STRUCTURAL BACKFILL MATERIAL #2 SHALL CONSIST OF SAND HAVING LESS THAN 50% OF THE PARTICLES BY WEIGHT PASSING A #40 SIEVE AND LESS THAN 5% OF THE PARTICLES BY WEIGHT PASSING A #200 SIEVE. (REFER TO PROJECT GEOTECHNICAL REPORT).


3. REFER TO THE PROJECT GEOTECHNICAL REPORT AND SPECIFICATIONS FOR ADDITIONAL INFORMATION, INCLUDING MAXIMUM BACKFILL LIFTS, COMPACTION, MOISTURE, ETC.

4. SEE ARCHITECTURAL DRAWINGS FOR WATERPROOFING, INSULATION, ETC. SEE S501 FOR CONSTRUCTION JOINT AND OTHER TYPICAL DETAILS.


CURB - SEE ARCH AND -DETAIL 3/S701 GRADE - SEE ARCH AND CIVIL LEVEL 1 EL
SEE PLAN SEE PLAN T.O. CIP COL (GRID B)
AT GRID 1 (NO I.T. BM) STEP 12" CONC WALL TO 10" AT TOP OF COLUMN BEYOND T.O. CIP COL (GRID B)
AT GRID 11 (I.T. BM) #5 AT 12" OC EACH WAY SEE 1/S503 FOR TYPICAL ADDITIONAL INFORMATION 12" CONC WALL #4 AT 12" OC EACH WAY #5 x 4'-0" + HK AT 12" OC DOWEL TO FTG (ISF) - #7 AT 12" OC TRANS TOP SEE PLAN - 7 - #7 CONT (4 TOP, 3 BOT) TFE SEE PLAN 3'-6" 5'-6" (SEE PLAN) #7 AT 12" OC PRIMARY WALL

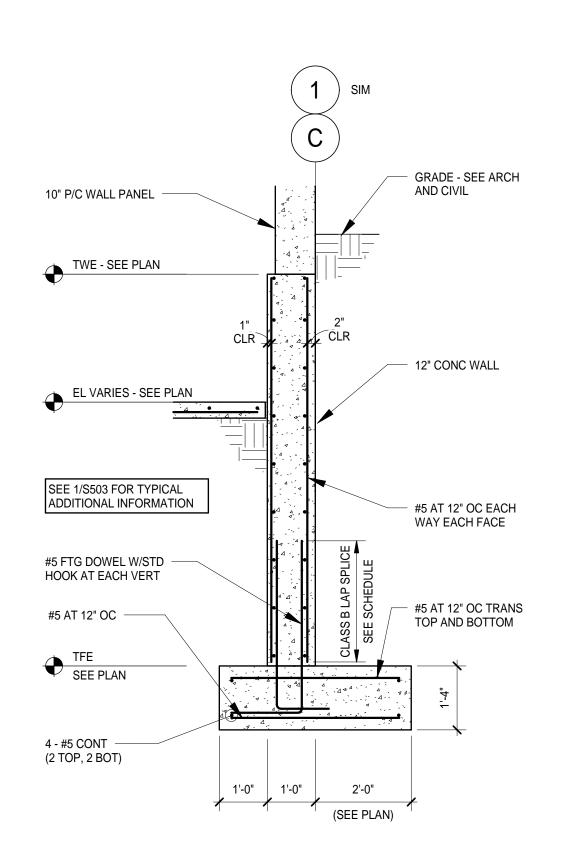

1. MAXIMUM DIFFERENTIAL BACKFILL ELEVATION BETWEEN ISF AND OSF OF WALL = 6'-0" THIS DETAIL ONLY.

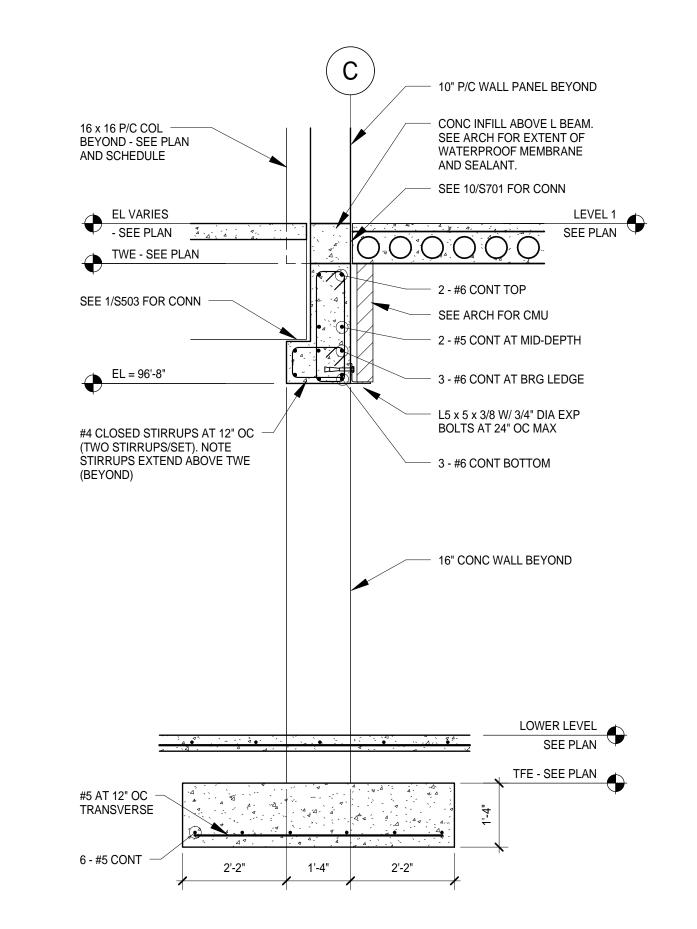


4 SECTION
1/2" = 1'-0"

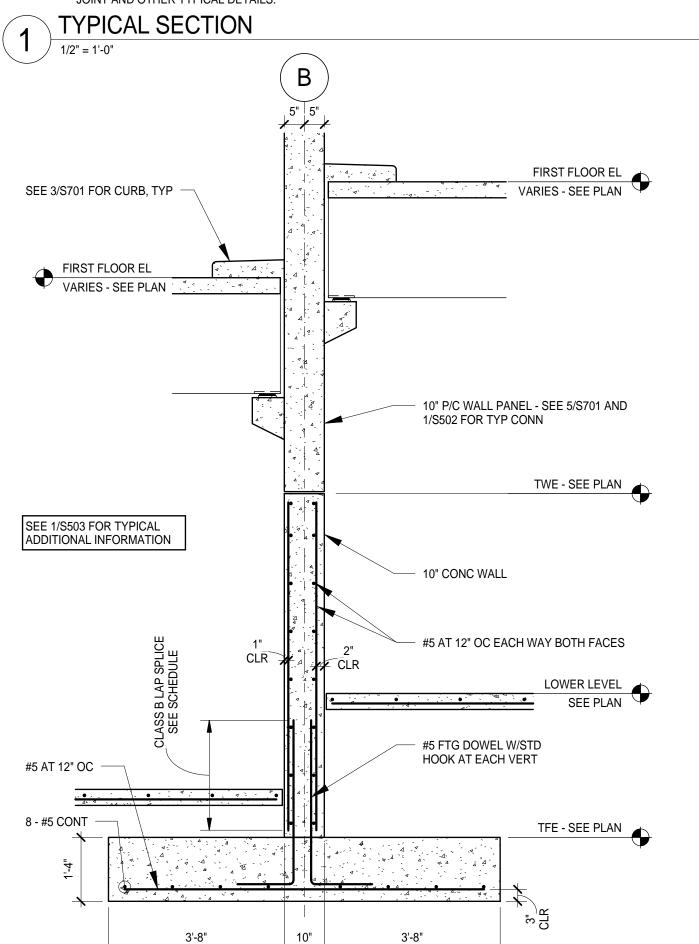

SECTION

1/2" = 1'-0"

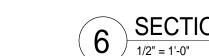

8" CMU WALL (BRG WALL) SEE SCHEDULE FOR REINF #5 x 1'-0" DWL AT 4'-0" MAX OC. FIELD DRILL AND FORCE FIT. 8" P/C PLANK W/ CONT KOROLATH BRG STRIP (4" BRG) SEE 1/S503 FOR TYPICAL ADDITIONAL INFORMATION - STAIR A -8" CONC WALL NOTE: TYPICAL STRINGERS AT STAIR A: C12 x 20.7 - #5 AT 12" OC EACH WAY, CENTERED #5 FTG DOWEL W/STD HOOK AT EACH VERT LOWER LEVEL TFE - SEE PLAN #5 AT 12" OC -1'-2" 8" 1'-2"

10" P/C WALL PANEL -SEE PLAN TWE - SEE PLAN 10" CONC WALL L6 x 3 1/2 x 3/8 x 1'-0" W/ 2 -3/4" DIA EXP BOLTS AT EACH CORNER OF EACH LANDING, TYP (EXP BOLT HSS 6 x 6 - SEE ARCH AND COL SCHEDULE FOR STEEL POST AT OR FIELD WELD TO EMBED NOTE: TYPICAL STRINGERS AT AT P/C WALL PANEL) STAIR B: MC12 x 10.6 #5 AT 12" OC EACH #4 AT 12" OC EACH WAY (OSF) WAY (ISF) STAIR B - SEE — ARCH FOR STAIR SEE 1/S503 FOR **GEOMETRY AND** TYPICAL ADDITIONAL LANDING INFORMATION **ELEVATIONS** STAIR LANDING
SEE ARCH +5 FTG DOWEL W/STD HOOK AT EACH VERT CLASS B LAP SPLICE LOWER LEVEL SEE 1/S503 FOR FTG REINF AND DOWELS TO WALL SEE PLAN TFE - SEE PLAN 5'-6" EXTEND TOE OF EXT WALL FTG AT STAIR TO MATCH WALL FTG AT RAMP.
SUPPLEMENT SPECIFIED REINF TO OBTAIN #7 AT 12" OC EACH WAY TOP SECTION

SEE ARCH

3 SECTION
1/2" = 1'-0"

 $7)\frac{SEC11}{1/2" = 1'-0"}$

I hereby certify that this plan, specification, or report was prepared by me or under my direct supervision and that I am a duly licensed Professional Engineer under the

laws of the State of Minnesota. Print Name: Paul A. Johnson

IMPROVING YOUR WORLD

Reynolds, Smith and Hills, Inc.

4525 Airport Approach Rd, Ste A Duluth, Minnesota 55811 218-722-1227 FAX 218-722-1052

www.rsandh.com

DULUTH AIRPORT

AUTHORITY

DULUTH

INTERNATIONAL

AIRPORT

DULUTH, MN

NEW PARKING

STRUCTURE

AND EXTERIOR

WAYFINDING SIGNAGE

CONSULTANTS

Interior Architects:

TKDA ARCHITECTS 11 E Superior Street Suite 340, Duluth MN 55802 TEL: (218) 724-8578 / FAX: (218) 724-8717

Structural Engineers: **MEYER BORGMAN JOHNSON**

501 Lake Avenue South, Suite 300, Duluth MN 55802

Landscape Architects:

ARCHITECTURAL RESOURCES

126 East Superior Street, Duluth MN 55802

TEL: (218) 727-8481 / FAX: (218) 727-8483

TEL: (218) 722-1056 / FAX: (218) 722-9306

Reg. No.: 20379 Date: 05-15-13

REVISIONS NO. DESCRIPTION **DATE ISSUED:** 05/15/2013 REVIEWED BY: PAJ

DRAWN BY: SJL **DESIGNED BY:** MDN / PAJ

AEP PROJECT NUMBER 213-1882-114

(C) 2012 REYNOLDS, SMITH AND HILLS INC SHEET TITLE

STRUCTURAL FOUNDATION DETAILS


> SHEET NUMBER **S503**

ISSUED FOR BID


SECTION

DWL (OSF) TO TOE OF FTG


2 SECTION
1/2" = 1'-0"

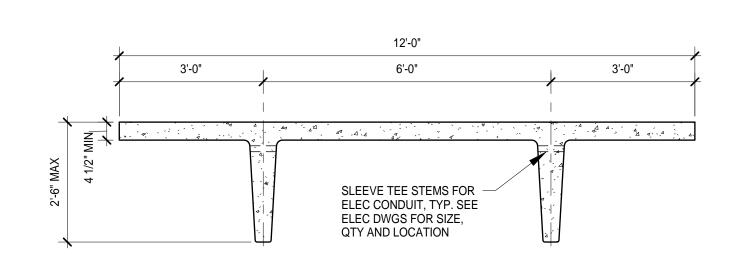


1 TYPICAL PRECAST DOUBLE TEE SCHEMATIC

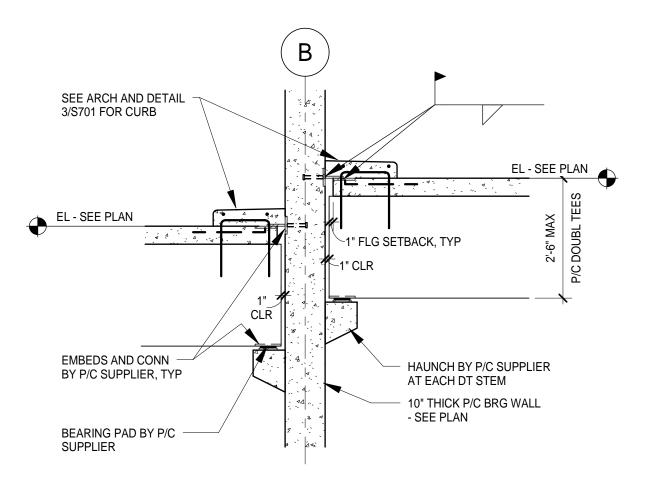


TYPICAL SECTION AT PRECAST BEARING WALL NO SCALE

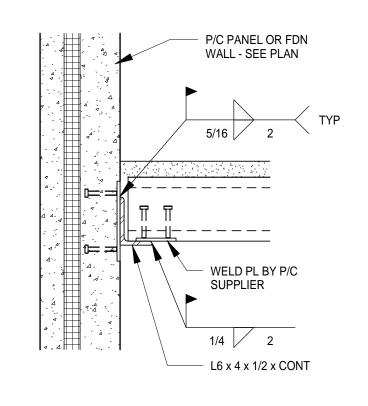


9 TYPICAL SECTION

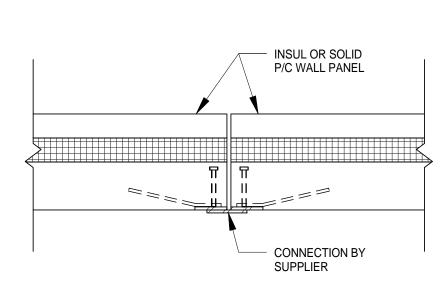


13 WALL PANEL CONNECTION NO SCALE

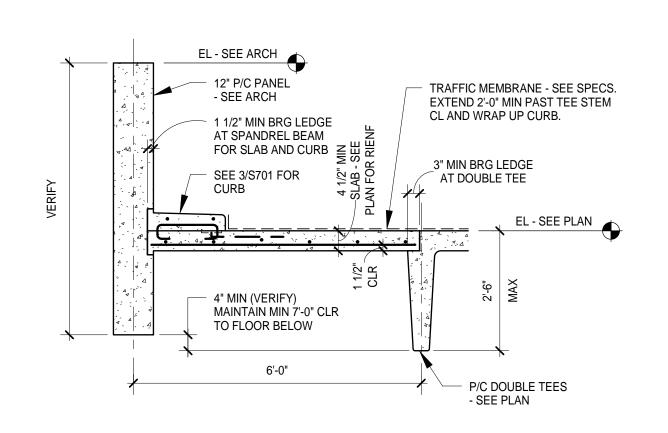


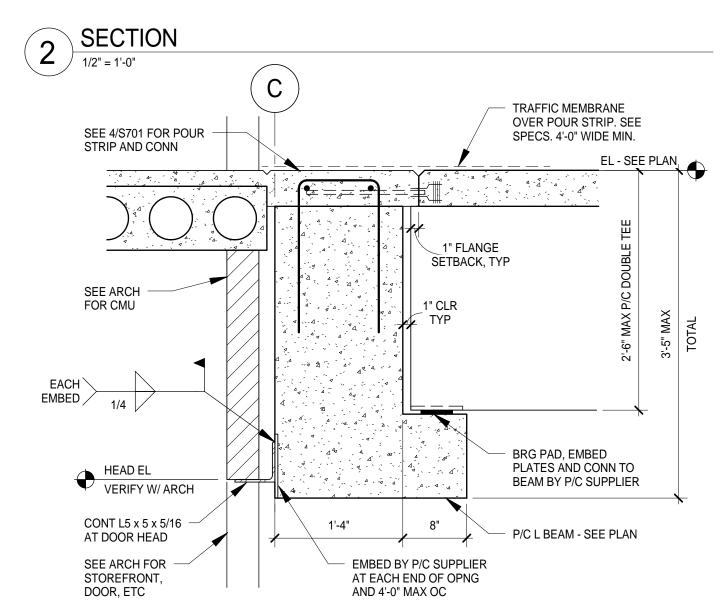

6 TYPICAL SECTION AT PRECAST L BEAM NO SCALE

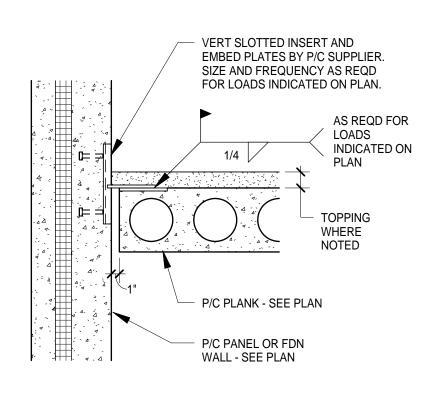


10 TYPICAL SECTION

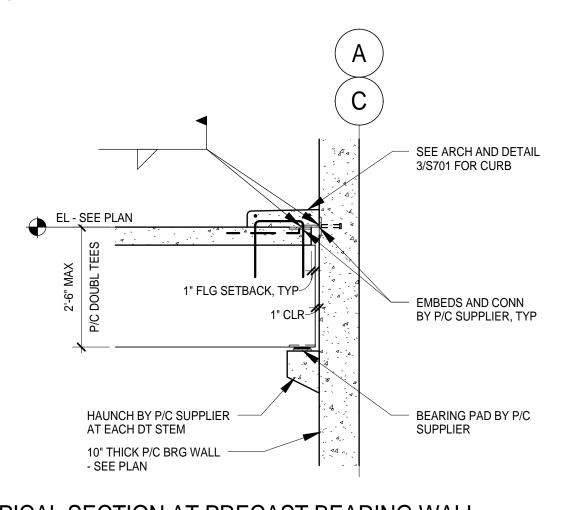


TYPICAL SECTION AT PRECAST BEARING WALL


1/2" = 1'-0"

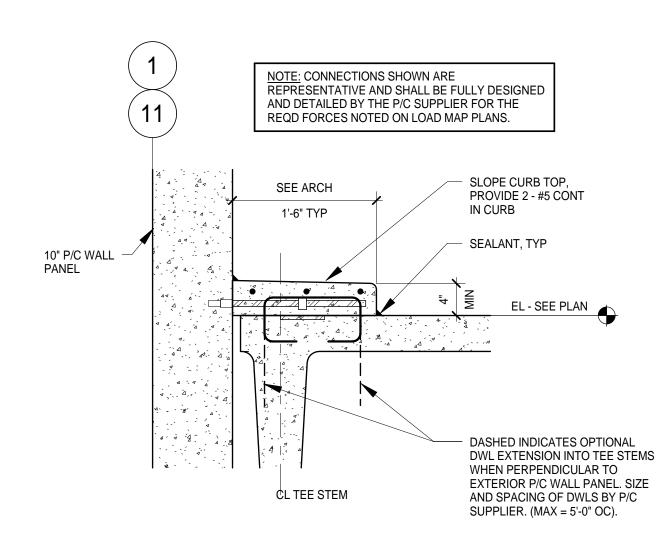


3 TYPICAL SECTION

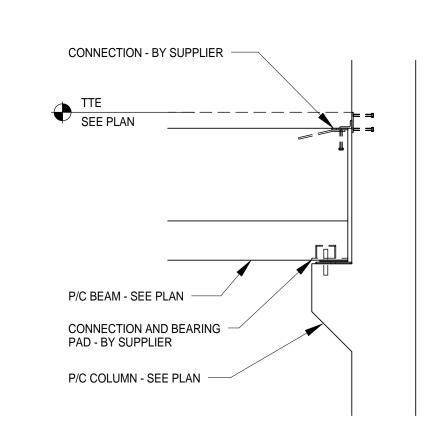


7 BEAM TO SINGLE HAUNCH COLUMN DETAIL

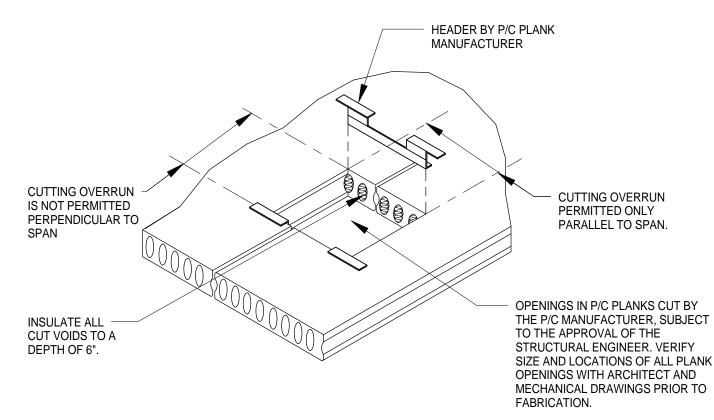


11 TYPICAL OPENING REINFORCING AT PRECAST PLANK

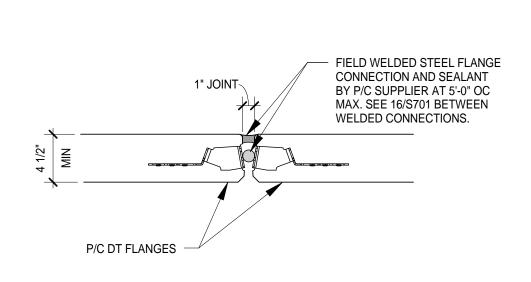


15 TYPICAL P/C JOINT DETAIL AT FLANGE CONNECTION NO SCALE

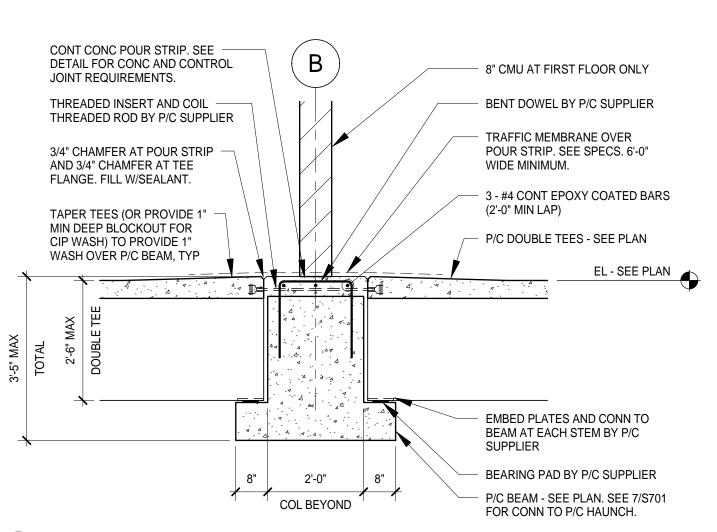


4 TYPICAL SECTION AT PRECAST INVERTED TEE BEAM

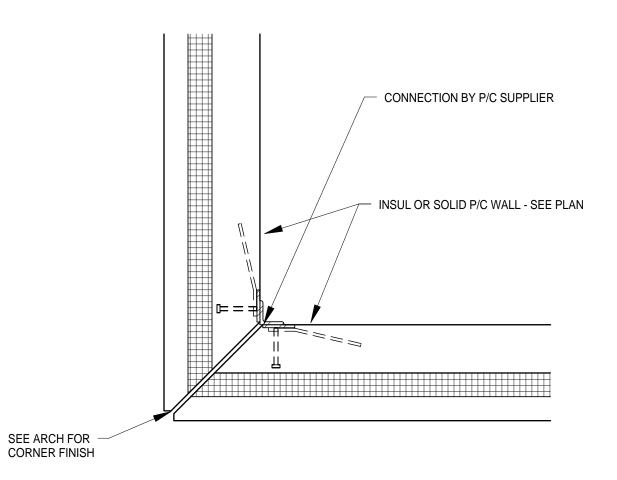

8 TYPICAL CORNER DETAIL

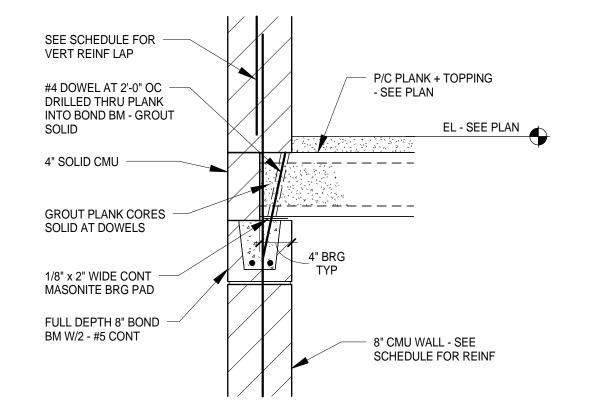

SECTION AT PLANK BEARING

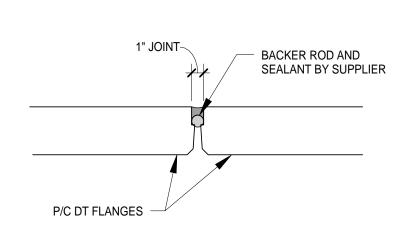

16 TYPICAL P/C JOINT DETAIL AWAY FROM FLANGE CONNECTION NO SCALE

ISSETT.

IMPROVING YOUR WORLD

Reynolds, Smith and Hills, Inc.

4525 Airport Approach Rd, Ste A Duluth, Minnesota 55811 218-722-1227 FAX 218-722-1052 www.rsandh.com



DULUTH
INTERNATIONAL
AIRPORT
DULUTH, MN

NEW PARKING STRUCTURE AND EXTERIOR WAYFINDING SIGNAGE

CONSULTANTS

Interior Architects: **TKDA ARCHITECTS**11 E Superior Street Suite 340, Duluth MN 55802

TEL: (218) 724-8578 / FAX: (218) 724-8717

Structural Engineers:

MEYER BORGMAN JOHNSON

501 Lake Avenue South, Suite 300, Duluth MN 55802
TEL: (218) 722-1056 / FAX: (218) 722-9306

Landscape Architects:

ARCHITECTURAL RESOURCES

126 East Superior Street, Duluth MN 55802
TEL: (218) 727-8481 / FAX: (218) 727-8483

I hereby certify that this plan, specification, or report was prepared by me or under my direct supervision and that I am a duly licensed Professional Engineer under the laws of the State of Minnesota.

Print Name:	Paul A. Johnso
Signature: Tulk	2 a Johnson

REVISIONS

Date: 05-15-13

KE\	/ISIONS		
NO.	DESCF	RIPTION	DATE
DATE	ISSUED:	05/15/2013	
REVIEWED BY:		PAJ	

Reg. No.: 20379

DESIGNED BY: SJL

DESIGNED BY: MDN / PAJ

AEP PROJECT NUMBER


213-1882-114

© 2012 REYNOLDS, SMITH AND HILLS INC.

STRUCTURAL FRAMING DETAILS

SHEET NUMBER


S701

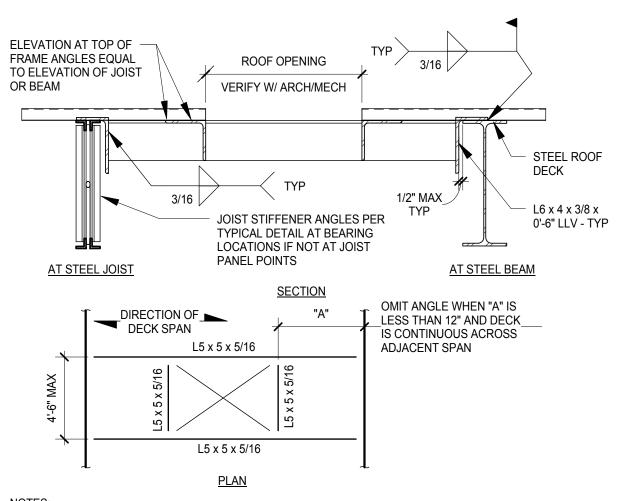

NOTES:

1. VERIFY OPENING SIZES AND LOCATIONS WITH MECHANICAL CONTRACTOR PRIOR TO FABRICATION. 2. WELD DECK AT OPENING AT EACH FLUTE WITH PUDDLE WELDS PER TYPICAL DECK ATTACHMENT DETAILS. 3. DO NOT CUT OPENING IN DECK UNTIL NECESSARY, CONTRACTOR TO COORDINATE. 4. THIS ROOF OPENING FRAME IS NOT DESIGNED TO SUPPORT THE WEIGHT OF ROOF TOP MECHANICAL EQUIPMENT WEIGHING OVER 400 LBS. EQUIPMENT SHALL BE SUPPORTED ON A STRUCTURAL CURB DESIGNED BY THE SUPPLIER TO SPAN TO THE PRIMARY STRUCTURAL FRAMING.


TYPICAL 3" ROOF DECK OPENING DETAIL (≤ 4'-6") NO SCALE

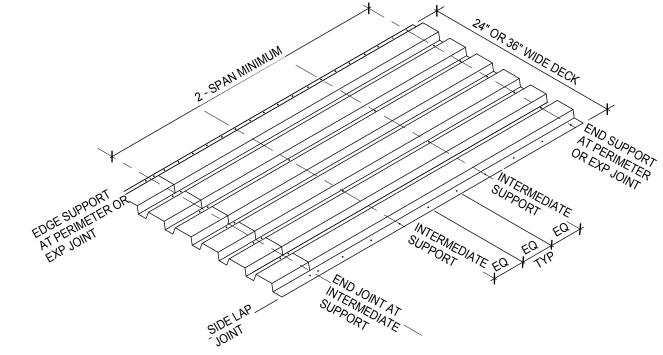

DECK SUPPORT CONDITION	DECK ATTACHMENT
END SUPPORT	PUDDLE WELDS AT EACH LOW FLUTE
EDGE SUPPORT_	PUDDLE WELDS AT 12" OC_
INTERMEDIATE SUPPORT	PUDDLE WELDS AT EACH LOW FLUTE
END JOINT AT INT SUPPORT	PUDDLE WELDS AT EACH LOW FLUTE, EACH SIDE
SIDE LAP JOINT	#10 TEK SCREWS OR 1 1/2" SEAM WELD AT 36" OC MAX

1. ALL PUDDLE (ARC-SPOT) WELDS SHALL BE 5/8" DIAMETER. 2. PROVIDE DECK ATTACHMENTS AT SPACING SHOWN UNLESS NOTED OTHERWISE ON DRAWINGS. 3. DECK SHEETS SHALL BE BUTTED AT END JOINTS. PROVIDE 1 1/2" MINIMUM BEARING. 4. HEADED STUD INSTALLED THROUGH THE DECK MAY BE SUBSTITUTED FOR PUDDLE WELD.


TYPICAL COMPOSITE FLOOR DECK ATTACHMENT DETAIL

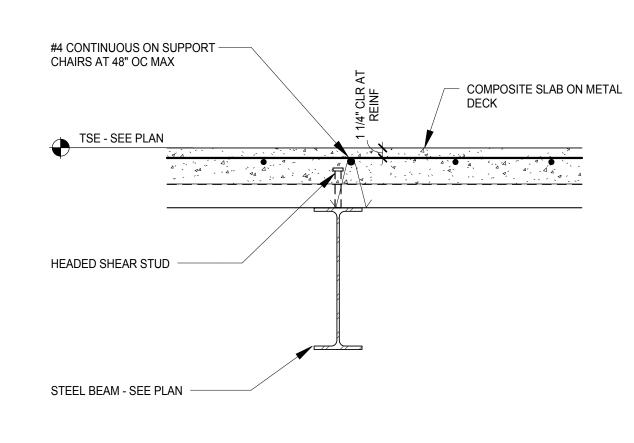


NOTES:

1. SEE TYPICAL DETAILS FOR DECK ATTACHMENT AND HEADED STUD INFORMATION.


TYPICAL COMPOSITE FLOOR DECK PERPENDICULAR TO BEAM DETAIL NO SCALE

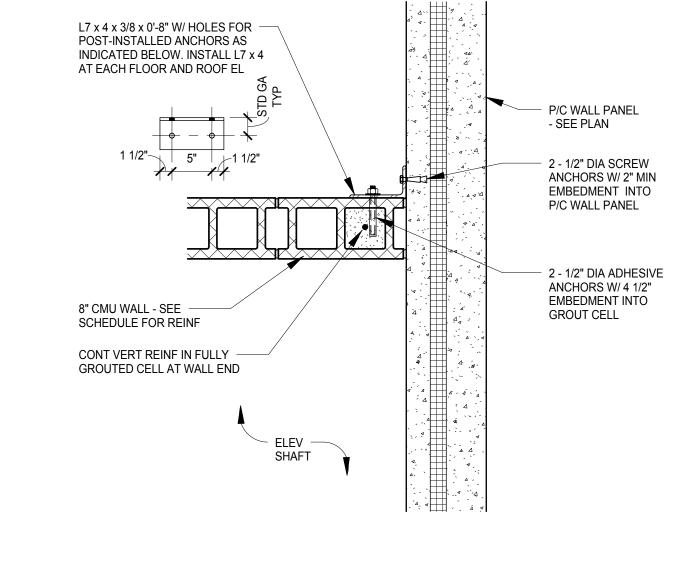


PLAN DETAIL

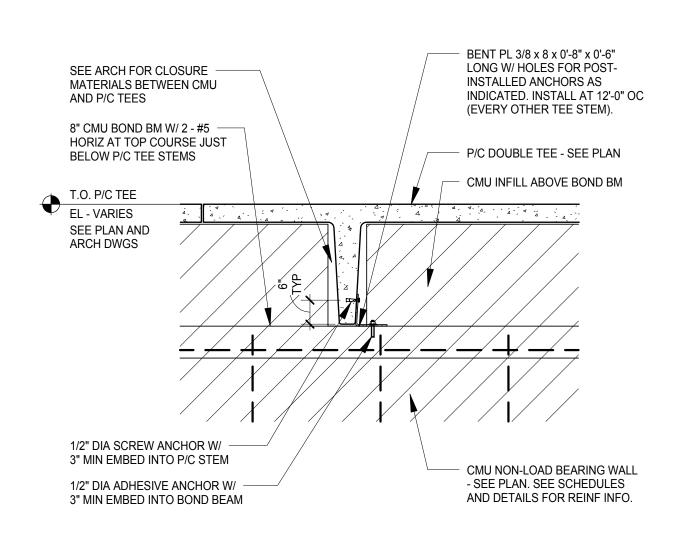


SECTION - TOP OF CMU WALL 5 PERPENDICULAR TO P/C TEES

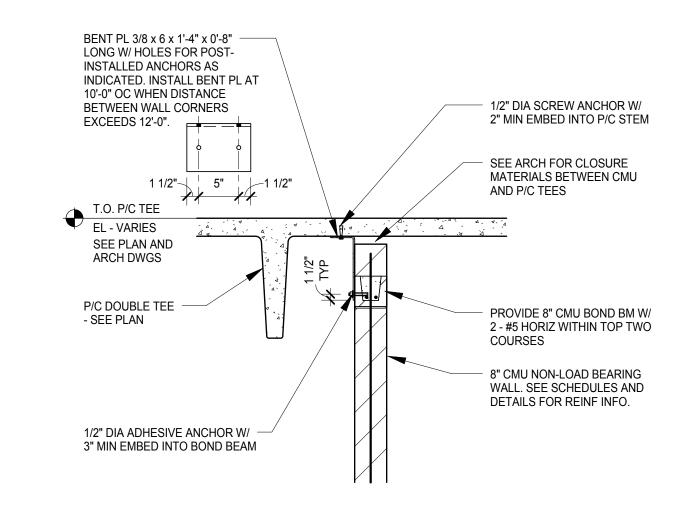



6 SECTION - TOP OF CMU WALL PARALLEL TO P/C TEES

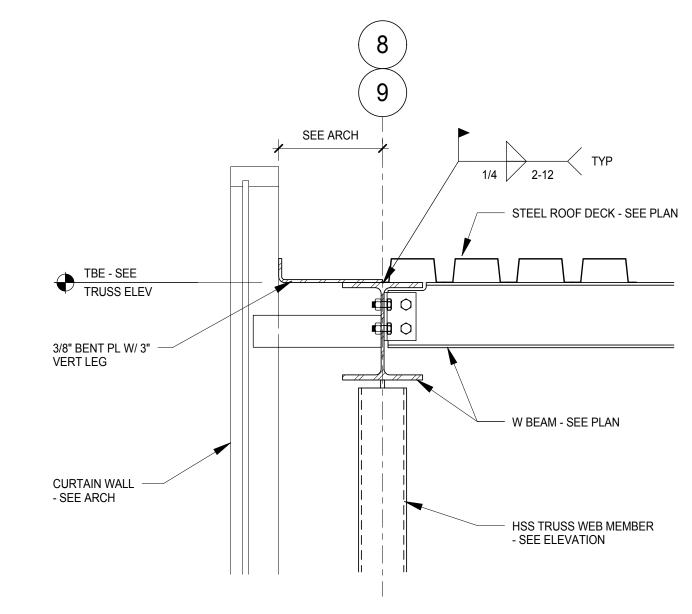

7 SECTION
1" = 1'-0"

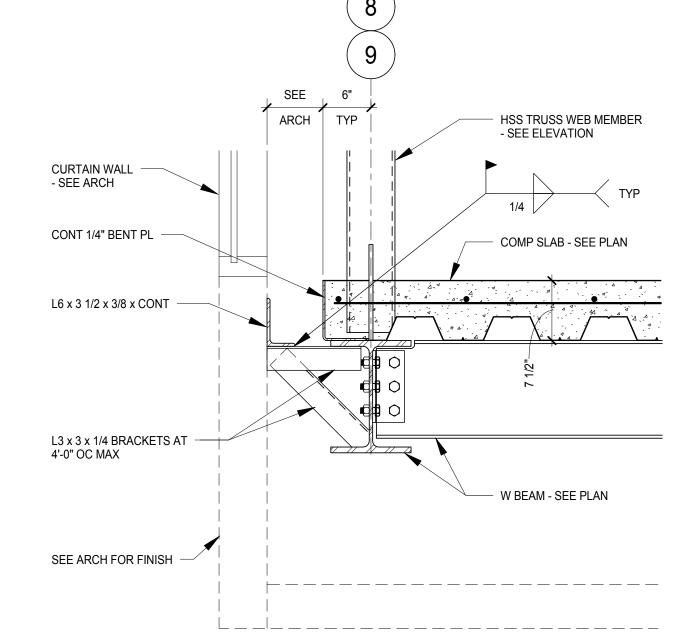

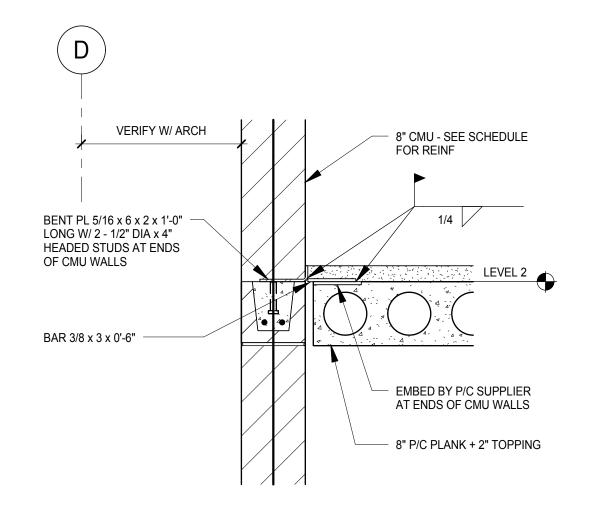

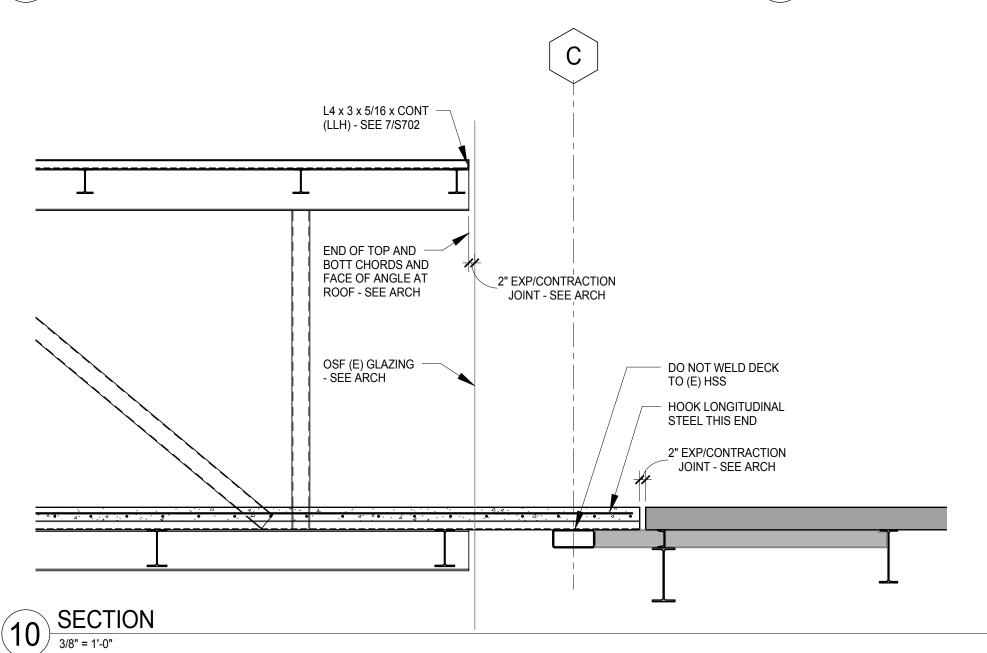

IMPROVING YOUR WORLD

Reynolds, Smith and Hills, Inc.

4525 Airport Approach Rd, Ste A Duluth, Minnesota 55811 218-722-1227 FAX 218-722-1052 www.rsandh.com



DULUTH INTERNATIONAL **AIRPORT** DULUTH, MN

NEW PARKING STRUCTURE AND EXTERIOR WAYFINDING SIGNAGE

CONSULTANTS

Interior Architects: TKDA ARCHITECTS 11 E Superior Street Suite 340, Duluth MN 55802 TEL: (218) 724-8578 / FAX: (218) 724-8717

Structural Engineers: MEYER BORGMAN JOHNSON 501 Lake Avenue South, Suite 300, Duluth MN 55802 TEL: (218) 722-1056 / FAX: (218) 722-9306

Landscape Architects: ARCHITECTURAL RESOURCES 126 East Superior Street, Duluth MN 55802 TEL: (218) 727-8481 / FAX: (218) 727-8483

I hereby certify that this plan, specification, or report was prepared by me or under my direct supervision and that I am a duly licensed Professional Engineer under the laws of the State of Minnesota.

Print Name: Paul A. Johnson Signature:

Reg. No.: 20379

REVISIONS

Date: 05-15-13

_			
NO.	DESC	RIPTION	DATE
DATE IS	SSUED:	05/15/2013	
REVIEV	VED BY:	PAJ	
DRAWN BY:		SJL	
DESIGNED BY:		MDN / DA I	

DESIGNED BY: MDN / PAJ AEP PROJECT NUMBER


213-1882-114


(C) 2012 REYNOLDS, SMITH AND HILLS INC SHEET TITLE

STRUCTURAL FRAMING DETAILS

SHEET NUMBER


S702

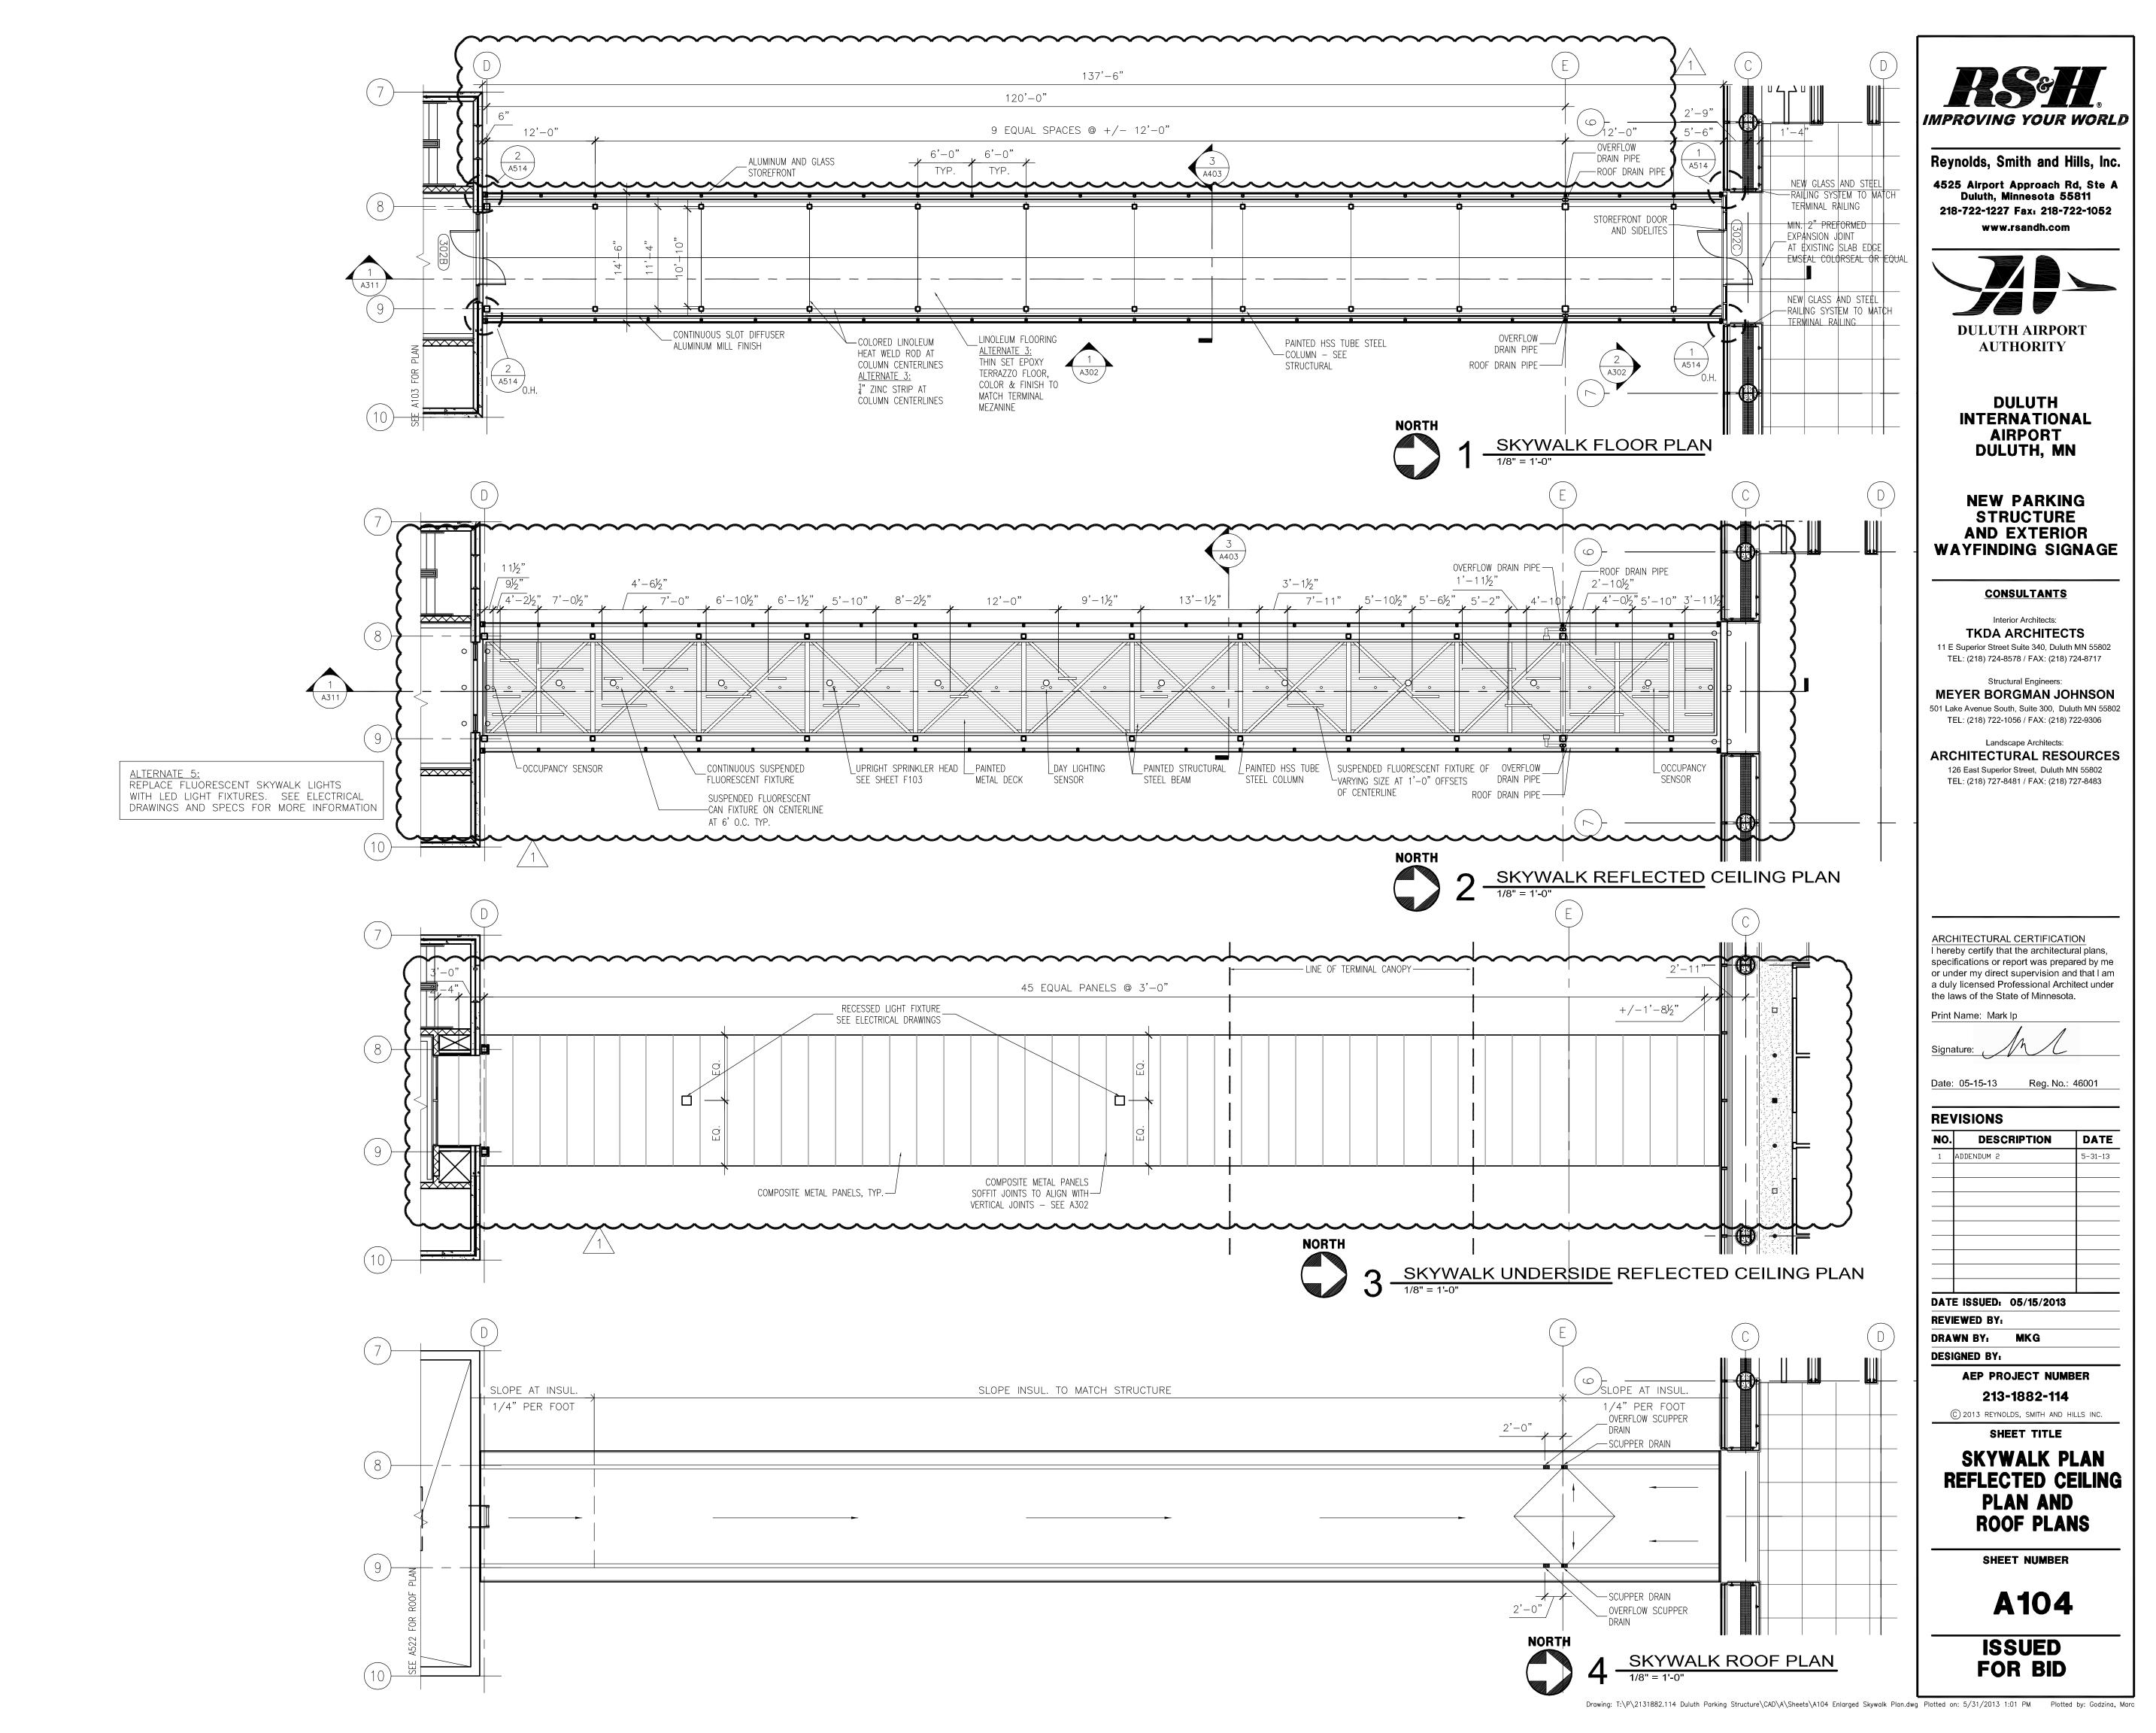

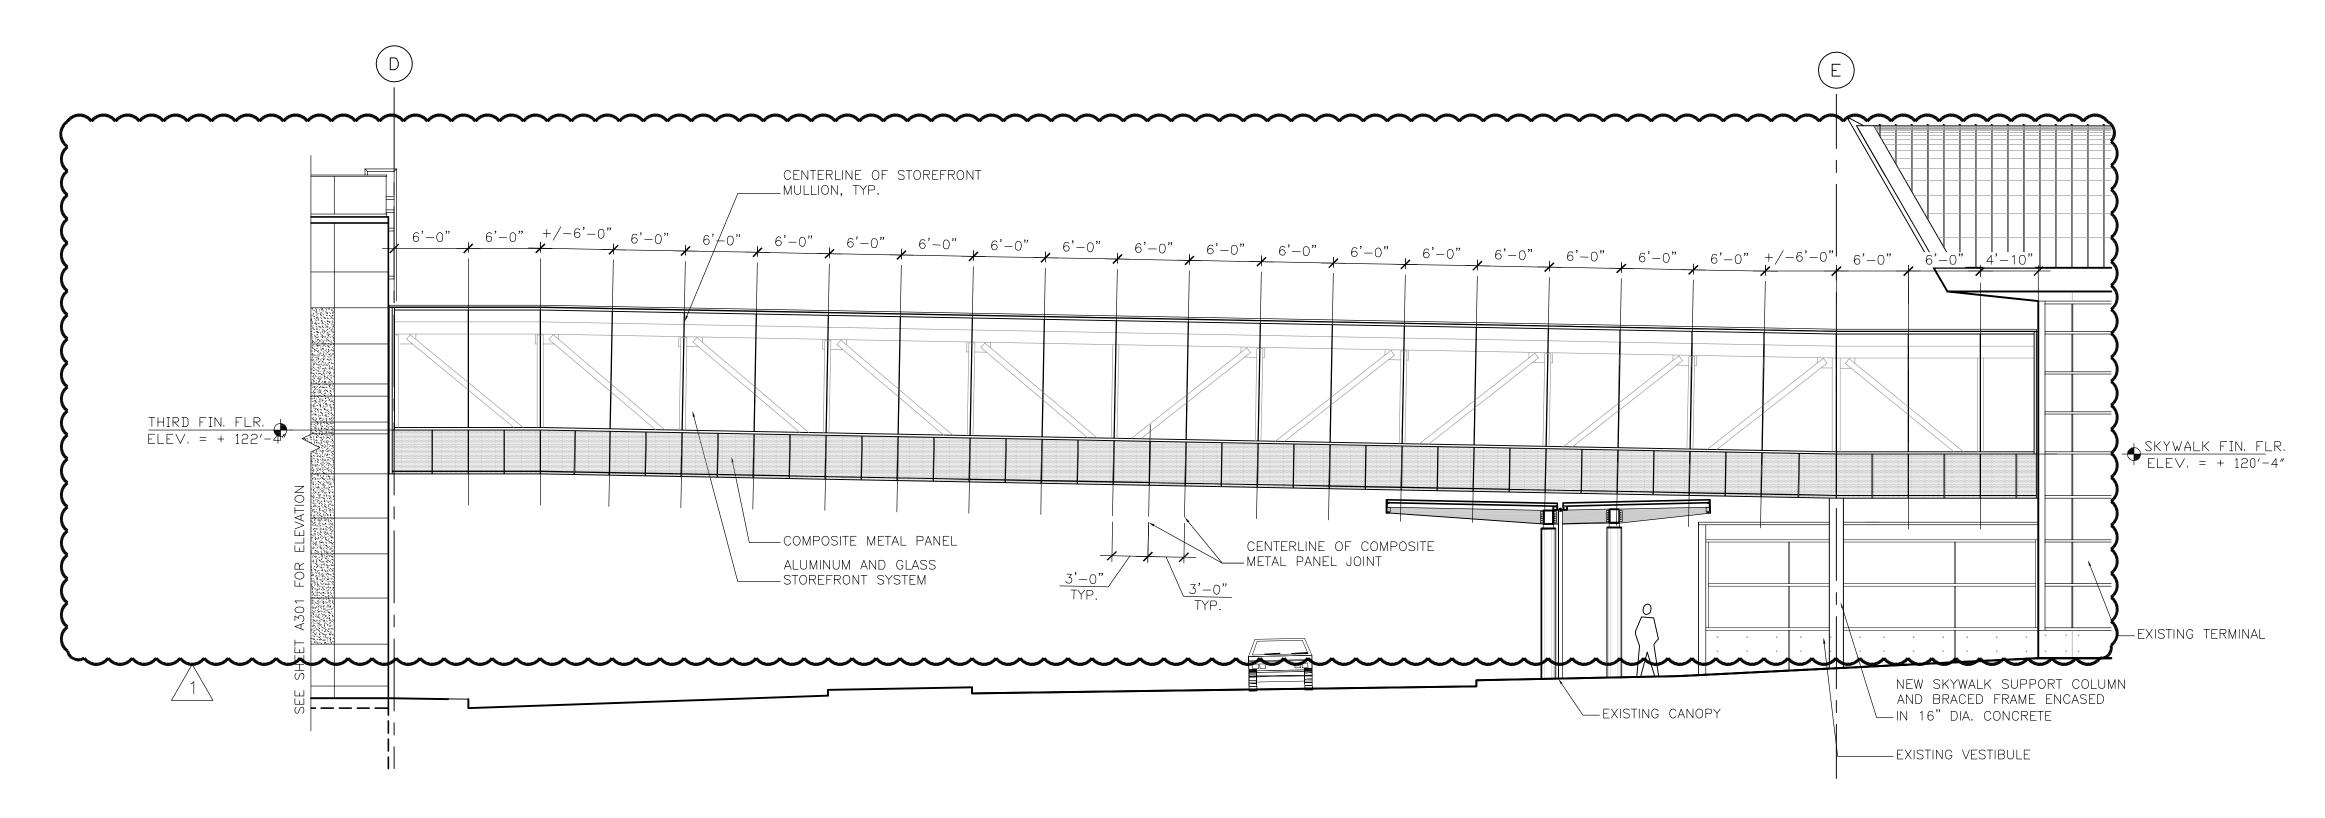

EAST SKYWALK ELEVATION

1/8" = 1'-0" WEST ELEVATION SIMILAR

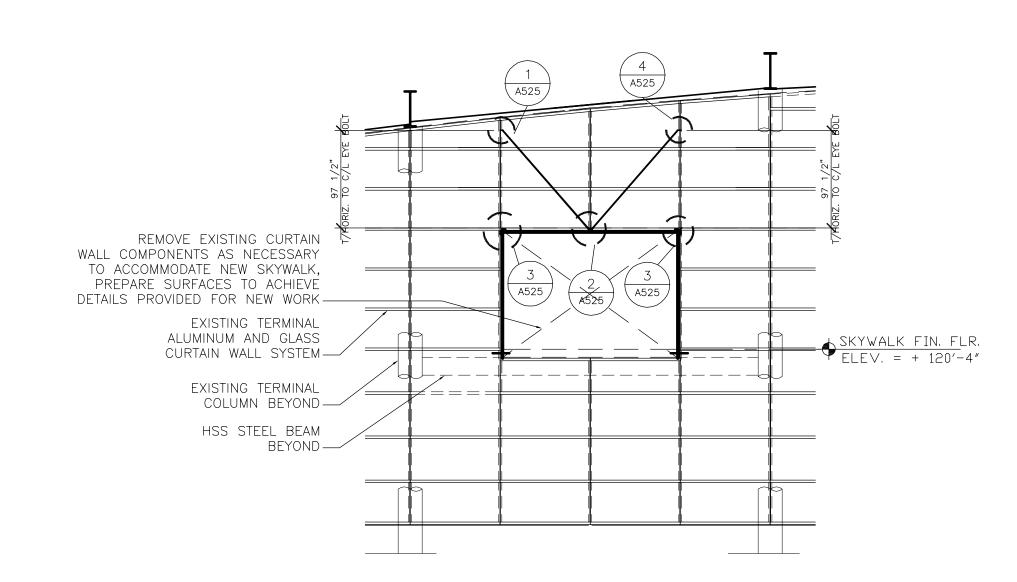

2 CURTAIN WALL ELEVATION
@ EXISTING TERMINAL

1/8" = 1'-0"



Reynolds, Smith and Hills, Inc.

4525 Airport Approach Rd, Ste A
Duluth, Minnesota 55811

218-722-1227 Fax: 218-722-1052

www.rsandh.com



DULUTH INTERNATIONAL AIRPORT DULUTH, MN

NEW PARKING STRUCTURE AND EXTERIOR WAYFINDING SIGNAGE

CONSULTANTS

Interior Architects: **TKDA ARCHITECTS**11 E Superior Street Suite 340, Duluth MN 55802

TEL: (218) 724-8578 / FAX: (218) 724-8717

Structural Engineers:

MEYER BORGMAN JOHNSON

501 Lake Avenue South, Suite 300, Duluth MN 55802

TEL: (218) 722-1056 / FAX: (218) 722-9306

Landscape Architects:

ARCHITECTURAL RESOURCES

126 East Superior Street, Duluth MN 55802
TEL: (218) 727-8481 / FAX: (218) 727-8483

ARCHITECTURAL CERTIFICATION
I hereby certify that the architectural plans, specifications or report was prepared by me or under my direct supervision and that I am a duly licensed Professional Architect under the laws of the State of Minnesota.

Signature:

Date: 05-15-13 Reg. No.: 46001

REVISIONS

Print Name: Mark Ip

NO.	DESCRIPTION	DATE
1	ADDENDUM 2	5-31-13
DAT	E ISSUED: 05/15/2013	

DATE ISSUED: 05/15/2013 REVIEWED BY:

DRAWN BY: MKG

AEP PROJECT NUMBER

213-1882-114

© 2013 REYNOLDS, SMITH AND HILLS INC.

ENLARGED SKYWALK ELEVATIONS

SHEET NUMBER

A302

LUMINAIRE SCHEDULE SEE NOTES THIS SHEET SEE DESCRIPTION MOUNTING LAMPS APPROVED MARK MODEL/SERIES NUMBER QTY **TYPE** LAMP WATTS **VOLTS** MANUFACTURER NOTE ES548MS-228RSI-DV2H-PP-EL-TR KENALL 4' FLUORESCENT LIGHT FIXTURE W/ WHITE TGIC POLYESTER POWDER COAT 5 STAGE PRE TREATMENT, AND UV STABILIZED PEARLESCENT LINEAR PRISMATIC INTERIOR LENS. UL LISTED FOR WALL F28T5 277 **VSLC SERIES** LITHONIA WET LOCATION WITH BATTERY BACKUP AND MOTION SENSOR. DAYBRITE OR APPROVED EQUAL OPEN REFLECTOR CYLINDER. COLUMBIA LITHONIA 42W CFL 277 OR PENDANT OMEGA/PHILIPS OM6/42PLT-PC-BB-CSSFF-U-(EM) OR APPROVED EQUAL SMALL APERTURE LED PENDANT CYLINDER. PLR4-9016-C2-10-35KS-30-C-277-(AMB) USAI OR APPROVED EQUAL 12. COLUMBIA C1 277 PENDANT OMEGA/PHILIPS FLUORESCENT, FIBERGLASS ENCLOSED AND GASKETED, WET LOCATION, RAPID START HOUSING: COLUMBIA LUN4-228-EP-U-LUNHK/PEBA

ONE-PIECE, HIGH-IMPACT, MOLDED POLYESTER FIBERGLASS WITH CAST WATERPROOF HUB. SURFACE F28T5/835 277 LITHONIA DMW-2-28T5-MVOLT-GEB10RS-BCD-H36-WLF DIFFUSER: ONE-PIECE, IMPACT-RESISTANT MOLDED ACRYLIC WITH ABS THERMOPLASTIC LATCHES; OR PENDANT HEAVY GAUGE DIE-FORMED STEEL LINER; HIGH GLOSS BAKED WHITE ENAMEL FINISH WITH DAYBRITE DWAE228-UNV-1/2-EB-UNV/TBK KNOCKOUTS FOR CHAIN HANGARS. PROVIDE CHAINS AS REQUIRED FOR HANGING FIXTURE. PROVIDE BATTERY BACK UP IN ELECTRICAL AND COMMUNICATIONS ROOMS. OR APPROVED EQUAL HID OUTDOOR AREA LIGHTING; WITH EASY HINGED ACCESS. LENS FRAME, DIE-CAST ALUMINUM 14. HOUSING WITH SILICONE GASKETS. -20° F HPF BALLAST; UL LISTED FOR WET LOCATION. POLE 230 277 KENALL 210W HID F OR APPROVED EQUAL 15. BEACON LED OUTDOOR AREA LIGHTING TO LIGHT THE UPPER DECK; WITH EASY HINGED ACCESS, FIELD TRV-D/24NB90/T3/UNV/MOB/BZ REPLACEABLE OPTICAL BEZEL AND HEAT DISIPATING FINS FOR 150000 HR RATED LIFE FOR BOTH POLE 277 KENALL TPD-23-4P-DB-216-L40K LED AND THEIR DRIVERS. KIM F OR APPROVED EQUAL BEGA 2029MH HID UPLIGHT LIGHTING FIXTURE. DIE-CAST ALUMINUM HOUSING W/ WALL MOUNTED BASE PLATE FOR WALL LITHONIA OR APPROVED EQUAL 277 T6G12MH DIRECT ATTACHMENT, OPTICALY CLEAR CAST ACRYLIC CYLINDER FULLY CASKETED FOR WEATHER **(F1)** TIGHT OPERATION. WSQ LED-2-10A700/40K-SR2-ELCW LITHONIA WALLPACK FULL CUTOFF, STARVIEW COMPLIANT; DIE CAST ALUMINUM HOUSING; ACRYLIC LENS; QUARTER SPHERE SHAPE; MOUNTS DIRECT TO WALL. 4000K COLOR TEMPERATURE; BUTTON 277 HUBBELL OR APPROVED EQUAL WALL PHOTOCONTROL; BATTERY BACKUP. IP65 COMPLIANT FIXTURE. MR17RP-C-MW-150M-1-277-RAK KENALL 13. WHITE PAINTED CAST METAL HOUSING, FORMED SEMISPECULAR METAL REFLECTOR WITH FLUTED SIDES, 277 150W MH 175 CLEAR PRISMATIC PLASTIC DROP LENS WITH LINEAR PRISMATIC CENTER CROSS PATTERN IN MOLDED PENDANT WHITE PLASTIC FRAME PARKING GARAGE LIGHT FIXTURE. OR APPROVED EQUAL DSXPG-LED-20C-700-40K-T5R-MVOLT-DWHXD LITHONIA 13. LED PARKING GARAGE LIGHT FIXTURE WITH TYPE V RECTANGULAR LIGHTING DISTRIBUTION. 20 LED's 277 15. RIGID BEACON PRODUCTS PENDANT KENALL OR APPROVED EQUAL PINNACLE EX44-WA-N-1T5-XX-AC48G1-UNV-1C-W 12. NARROW APERTURE, CONTINUOUS LINEAR, STAGGERED LAMPING, PERIMETER LIGHT FIXTURE. 277 28w T5 OR APPROVED EQUAL PENDANT PINNACLE EX4-A-N-40-XX-AC48G1-UNV-1C-W NARROW APERTURE, CONTINUOUS LINEAR, STAGGERED LAMPING, PERIMETER LED LIGHT FIXTURE, 277 28w T5 OR APPROVED EQUAL PENDANT LITHONIA PINNACLE EX44-WA-N-1T5-XX-AC48G1-UNV-1B-W NARROW APERTURE, CONTINUOUS LINEAR, STAGGERED LAMPING, AMBIENT LIGHT FIXTURE. 277 28w T5 OR APPROVED EQUAL PENDANT LITHONIA PINNACLE EX4-A-N-40-XX-AC48G1-UNV-1B-W 12. NARROW APERTURE, CONTINUOUS LINEAR, STAGGERED LAMPING, AMBIENT LED LIGHT FIXTURE. 28w T5 277 15. OR APPROVED EQUAL PENDANT LITHONIA 15. 277 AREA LIGHTING GRADE BEGA 8945MH OR APPROVED EQUAL DUAL LITE 13. **EMERGENCY LIGHTING UNIT** |120/277| 72 PENDANT LITHONIA IND12150-W-H5012S-ULT (UNIT WATTS) **MCPHILBEN** VU SERIES

LIGHTING CONTROL PERFORMANCE NOTES

ALL LIGHTING CIRCUITS SHALL BE CONTROLLED AUTOMATICALLY WITH MANUAL OVERRIDE CONTROL WHERE NECESSARY. MECHANICAL, ELECTRICAL, & COMMUNICATION ROOMS SHALL BE MANUAL CONTROL ONLY.

LED, EDGE LIT EXIT SIGN FOR PUBLIC SPACES; DOUBLE OR SINGLE FACE WITH OR WITHOUT

LIGHTING CONTROL SHALL BE AS SPECIFIED IN OPERATION SEQUENCE.

DIRECTIONAL ARROWS AS SHOWN ON PLANS

STORAGE ROOMS, CORRIDORS, AND STAIRWELLS SHALL BE CONTROLLED BY OCCUPANCY SENSOR ONLY.

OUTDOOR LUMINAIRE SHALL BE CONTROLLED BY PHOTOCELL AND ASTRONOMIC CLOCK. COORDINATE SYSTEM SETUP AND OPERATING HOURS WITH OWNER PER OPERATION SEQUENCE.

SUBMIT SHOP DRAWINGS OF THE MANUFACTURER'S LIGHTING CONTROL PLAN SHOWING ALL LIGHT FIXTURES, WIRING AND CONTROL DEVICES FOR REVIEW TO THE ENGINEER. IT IS NOT THE INTENT OF THESE DOCUMENTS TO SHOW ALL LIGHTING CONTROL DEVICES (PHOTOCELLS, POWERPACKS, ETC.) BUT TO DESCRIBE THE LIGHTING CONTROL PERFORMANCE OF EACH SPACE.

CONTRACTOR SHALL INCLUDE TWO DAYS OF COMMISSIONING/SYSTEM SET UP FROM THE LIGHTING CONTROL MANUFACTURER TRAINED REPRESENTATIVE. COORDINATE FINAL SYSTEM SET UP DATE AND TIME WITH OWNER AND ENGINEER.PERFORMANCE OF EACH SPACE.

LIGHTING CONTROL OPERATION SEQUENCE

LED

METAL HALIDE

UNIVERSAL

LEVEL 0, 1P (PUBLIC), 1M (MECHANICAL) & 2:

PROGRAMMABLE TIMER ON/OFF

ALL FIXTURES NORMALLY ON

LEVEL 3:

PROGRAMMABLE TIMER ON/OFF

AMBIENT LIGHT OVERRIDE TO OFF (OUTDOOR)

ALL FIXTURES NORMALLY ON

SKYWALK:

PROGRAMMABLE TIMER ON/OFF

ACCENT/DECORATIVE FIXTURES NORMALLY ON

• AMBIENT LIGHT OVERRIDE TO OFF

PERIMETER FIXTURES NORMALLY DIM

OCCUPANCY SENSOR LIGHTS ALL FIXTURES TO 100%

VACANCY TIMEOUT ADJ. 0-30 MIN RETURN TO OFF

LIGHTING CONTROL OPERATION SEQUENCE (CONT.)

ELEVATOR LOBBY 0, 1, 2 & 3: PROGRAMMABLE TIMER ON/OFF

• OCCUPANCY SENSOR AT ANY ENTRY LIGHTS FIXTURES TO 100%

OR APPROVED EQUAL

LVS-W-#-#-ELN-CW

ER60ML SERIES

OR APPROVED EQUAL

VACANCY TIMEOUT ADJ. 0-30 MIN RETURN TO OFF

STAIRS A & B:

DUAL LITE

LITHONIA

MCPHILBEN

120/277

4.6/2.8

(UNIT WATTS)

ALL FIXTURES ON

UNDER-SKYWALK ROADWAY:

PROGRAMMABLE TIMER ON/OFF

AMBIENT LIGHT OVERRIDE TO OFF (OUTDOOR)

ACCENT LTG (ALTERNATE)

PROGRAMMABLE TIMER ON/OFF

AMBIENT LIGHT OVERRIDE TO OFF (OUTDOOR)

AMBIENT LIGHT OVERRIDE TO OFF (OUTDOOR)

AREA LTG TYPE Y (ALTERNATE)

PROGRAMMABLE TIMER ON/OFF

LUMINAIRE SCHEDULE GENERAL NOTES

- 1. THE MODEL/SERIAL NUMBER INDICATES THE TYPE OF THE FIXTURE AND DOES NOT INCLUDE ALL FEATURES REQUIRED. THE DESCRIPTION COLUMN INDICATES THE REQUIRED FEATURES AND FINISHES. CONTRACTOR SHALL SUBMIT SHOP DRAWINGS FOR THE LUMINAIRES INDICATING ALL REQUIRED FEATURES AS SHOWN ON THE DRAWINGS AND SPECIFICATIONS.
- 2. THE LIGHTING FIXTURE SCHEDULE AND CATALOG NUMBERS INDICATE MAJOR REQUIREMENTS FOR THE LIGHTING FIXTURES. WHETHER SPECIFIED BY THE CATALOG NUMBERS OR NOT, THE CONTRACTOR SHALL PROVIDE ALL COMPONENTS, HARDWARE AND RELATED ITEMS TO PROVIDE A COMPLETE LIGHTING FIXTURE SYSTEM TO MEET THE REQUIREMENTS AS SPECIFIED IN THE DRAWINGS AND SPECIFICATIONS.
- 3. COORDINATE LIGHTING FIXTURE MOUNTING WITH THE ARCHITECTURAL CEILING PLANS, SECTIONS AND ELEVATIONS. PROVIDE ALL MOUNTING HARDWARE INCLUDING TRIM AND FLANGES TO COMPLETE THE INSTALLATION.
- 4. APPROVED EQUAL MANUFACTURERS: A. PROVIDE A PRODUCT EQUAL IN PERFORMANCE AND QUALITY, INCLUDING PHYSICAL ATTRIBUTES, FROM APPROVED MANUFACTURER'S LISTED IN THE FIXTURE SCHEDULE. B. A PRODUCT FROM MANUFACTURERS NOT LISTED AS APPROVED EQUAL IN THE SCHEDULE MAY BE SUBMITTED FOR APPROVAL DURING THE SHOP DRAWING PHASE. PROVIDED THE MANUFACTURER CAN PROVIDE A FIXTURE WHICH MEETS THE QUALITY AND PERFORMANCE REQUIREMENTS. THE A/E'S DETERMINATION FOR THE APPROVAL SHALL GOVERN. PROVIDE COMPLETE DETAIL OF THE PROPOSED EQUAL FIXTURE WITH A COMPARISON TO THE SPECIFIED FIXTURE INCLUDING COMPUTER GENERATED POINT BY
- 5. PROVIDE PLASTER FRAMES AS REQUIRED.


APPROVAL AS EQUAL TO SPECIFIED PRODUCTS.

6. ALL FLUORESCENT FIXTURES SHALL HAVE ELECTRONIC BALLAST WITH <10% THD UNLESS OTHERWISE NOTED.

POINT FOOT CANDLE CALCULATIONS, SAMPLES AND ANY ADDITIONAL INFORMATION

REQUESTED BY THE A/E. PROTOTYPE PRODUCTS SHALL NOT BE SUBMITTED FOR

- 7. PROVIDE LENS DISTRIBUTION TYPE FOR OPTIMUM COVERAGE. PROVIDE COMPUTER GENERATED POINT BY POINT FOOT CANDLE CALCULATIONS FOR ALL FIXTURES SUBMITTED FOR SUBSTITUTION APPROVAL.
- 8. PROVIDE 10% SPARE LAMPS OF EACH TYPE TO BE TURNED OVER TO OWNER.
- 9. CONTRACTOR SHALL VERIFY VOLTAGE REQUIREMENTS FOR ALL LUMINAIRES, PRIOR TO SHOP DRAWING SUBMITTAL, BASED ON THE CIRCUITING REQUIREMENTS ON THE PLANS AND SCHEDULES. NO ADDITIONAL COMPENSATION WILL BE PROVIDED DUE TO FAILURE OF COMPLIANCE WITH REQUIREMENTS.
- 10. ALL FIXTURES REQUIRE UL, CUL, ETL OR CSA LISTING.
- 11. PROVIDE SOLITE AMBER FILTER LENS FOR FOUR LIGHT FIXTURES ON EACH END OF THE SKYWALK. 12. MOUNTING HEIGHT FOR THIS LIGHT FIXTURES SHALL BE 16" FROM THE BOTTOM OF THE ROOF DECK.
- 13. THIS LIGHT FIXTURES SHALL BE CLG MOUNTED IN BETWEEN THE STRUCTURAL TEES AND THE BOTTOM OF THIS LIGHT FIXTURE SHALL NOT BE LOWER THAN THE TEES.
- 14. THIS LIGHT FIXTURES SHALL MATCH EXISTING PARKING LOT FIXTURES. PROVIDE LIGHT FIXTURE WITH PHILIPS 210W CERAMIC METAL HALIDE MASTER COLOR ELITE SYSTEM.
- 15. THIS LIGHT FIXTURES ARE ALTERNATES SEE FLOOR PLANS FOR DETAILS.
- 16. LIGHT FIXTURES SHALL BE CONNECTED IN EACH WALL OPENING AT 18" BELOW OPENING BOTTOM AND MONITORED AS ACCENT UPLIGHT.

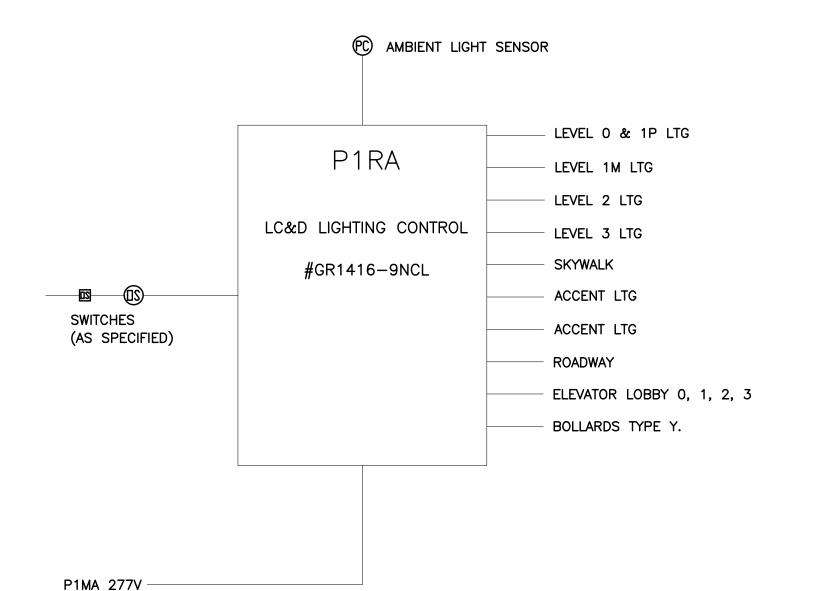

TYP. LIGHTING CONTROL

LIGHTING CONTROL OPERATION SEQUENCE (CONT.)

LED (ALTERNATE)

LEVEL 0, 1P (PUBLIC), 1M (MECHANICAL) & 2: PROGRAMMABLE TIMER ON/OFF

- ALL FIXTURES NORMALLY DIMMED
- OCCUPANCY SENSOR LIGHT ALL FIXTURES TO 100%
- VACANCY TIMEOUT ADJUSTABLE 0 TO 30 MIN RETURN TO DIM
- LEVEL 3:
- PROGRAMMABLE TIMER ON/OFF AMBIENT LIGHT OVERRIDE TO OFF (OUTDOOR)
- ALL FIXTURES NORMALLY DIM
- OCCUPANCY SENSOR LIGHTS ALL FIXTURES TO 100%

SKYWALK, ELEVATOR LOBBIES 0, 1, 2, 3, STAIRS A&B UNDER-SKYWALK ROADWAY:

SAME AS ABOVE

IMPROVING YOUR WORLD

Reynolds, Smith and Hills, Inc. 4525 Airport Approach Rd, Ste A Duluth, Minnesota 55811 218-722-1227 Fax: 218-722-1052 www.rsandh.com



AUTHORITY

DULUTH INTERNATIONAL **AIRPORT** DULUTH, MN

NEW PARKING STRUCTURE AND EXTERIOR **WAYFINDING SIGNAGE**

CONSULTANTS

Interior Architects: TKDA ARCHITECTS

11 E Superior Street Suite 340, Duluth MN 55802 TEL: (218) 724-8578 / FAX: (218) 724-8717

Structural Engineers: MEYER BORGMAN JOHNSON 501 Lake Avenue South, Suite 300, Duluth MN 55802 TEL: (218) 722-1056 / FAX: (218) 722-9306

Landscape Architects: ARCHITECTURAL RESOURCES 126 East Superior Street, Duluth MN 55802

TEL: (218) 727-8481 / FAX: (218) 727-8483

REVISIONS NO. DESCRIPTION DATE DDENDUM 2

DATE ISSUED: 05/15/2013

DRAWN BY: RJL DESIGNED BY: RJL

REVIEWED BY: BA


AEP PROJECT NUMBER

213-1882-114 (C) 2013 REYNOLDS, SMITH AND HILLS INC.


SHEET TITLE

LUMINAIRE **SCHEDULE AND NOTES**

SHEET NUMBER

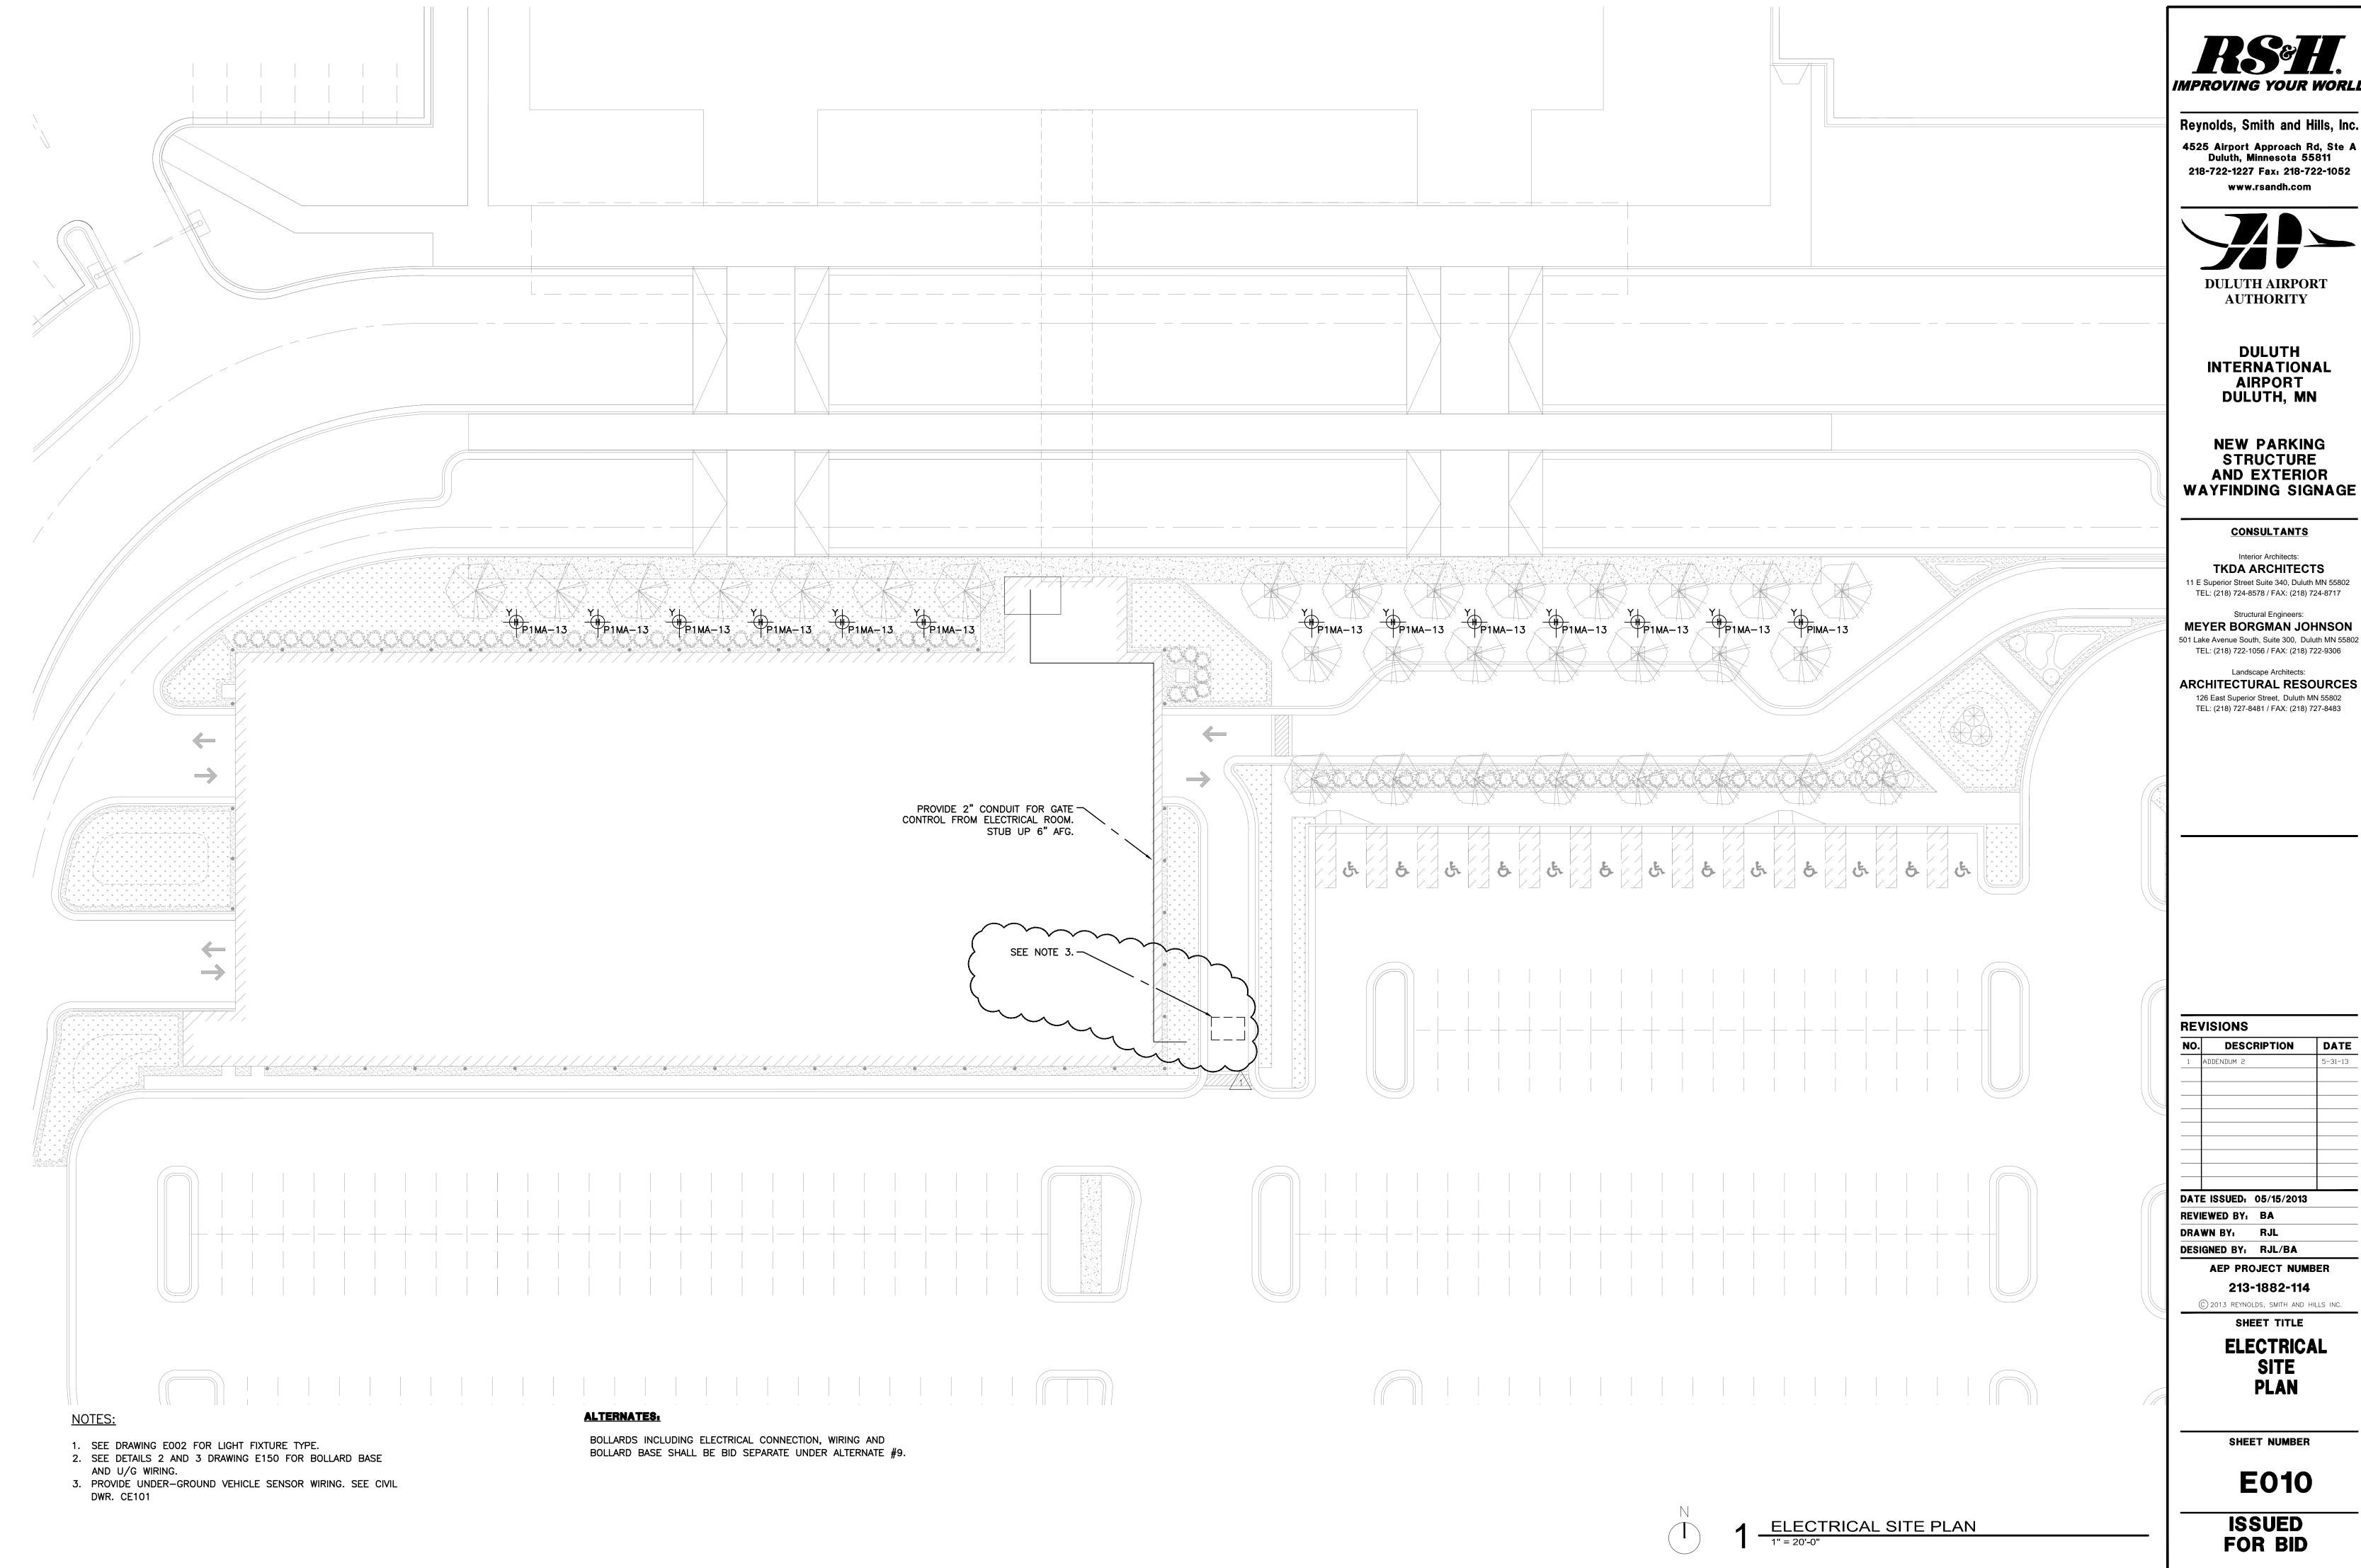

Drawing: T:\P\2131882.114 Duluth Parking Structure\CAD\E\E010 Electrical SitePlan.dwg Plotted on: 5/31/2013 9:32 AM Plotted by: Llazari, Rional

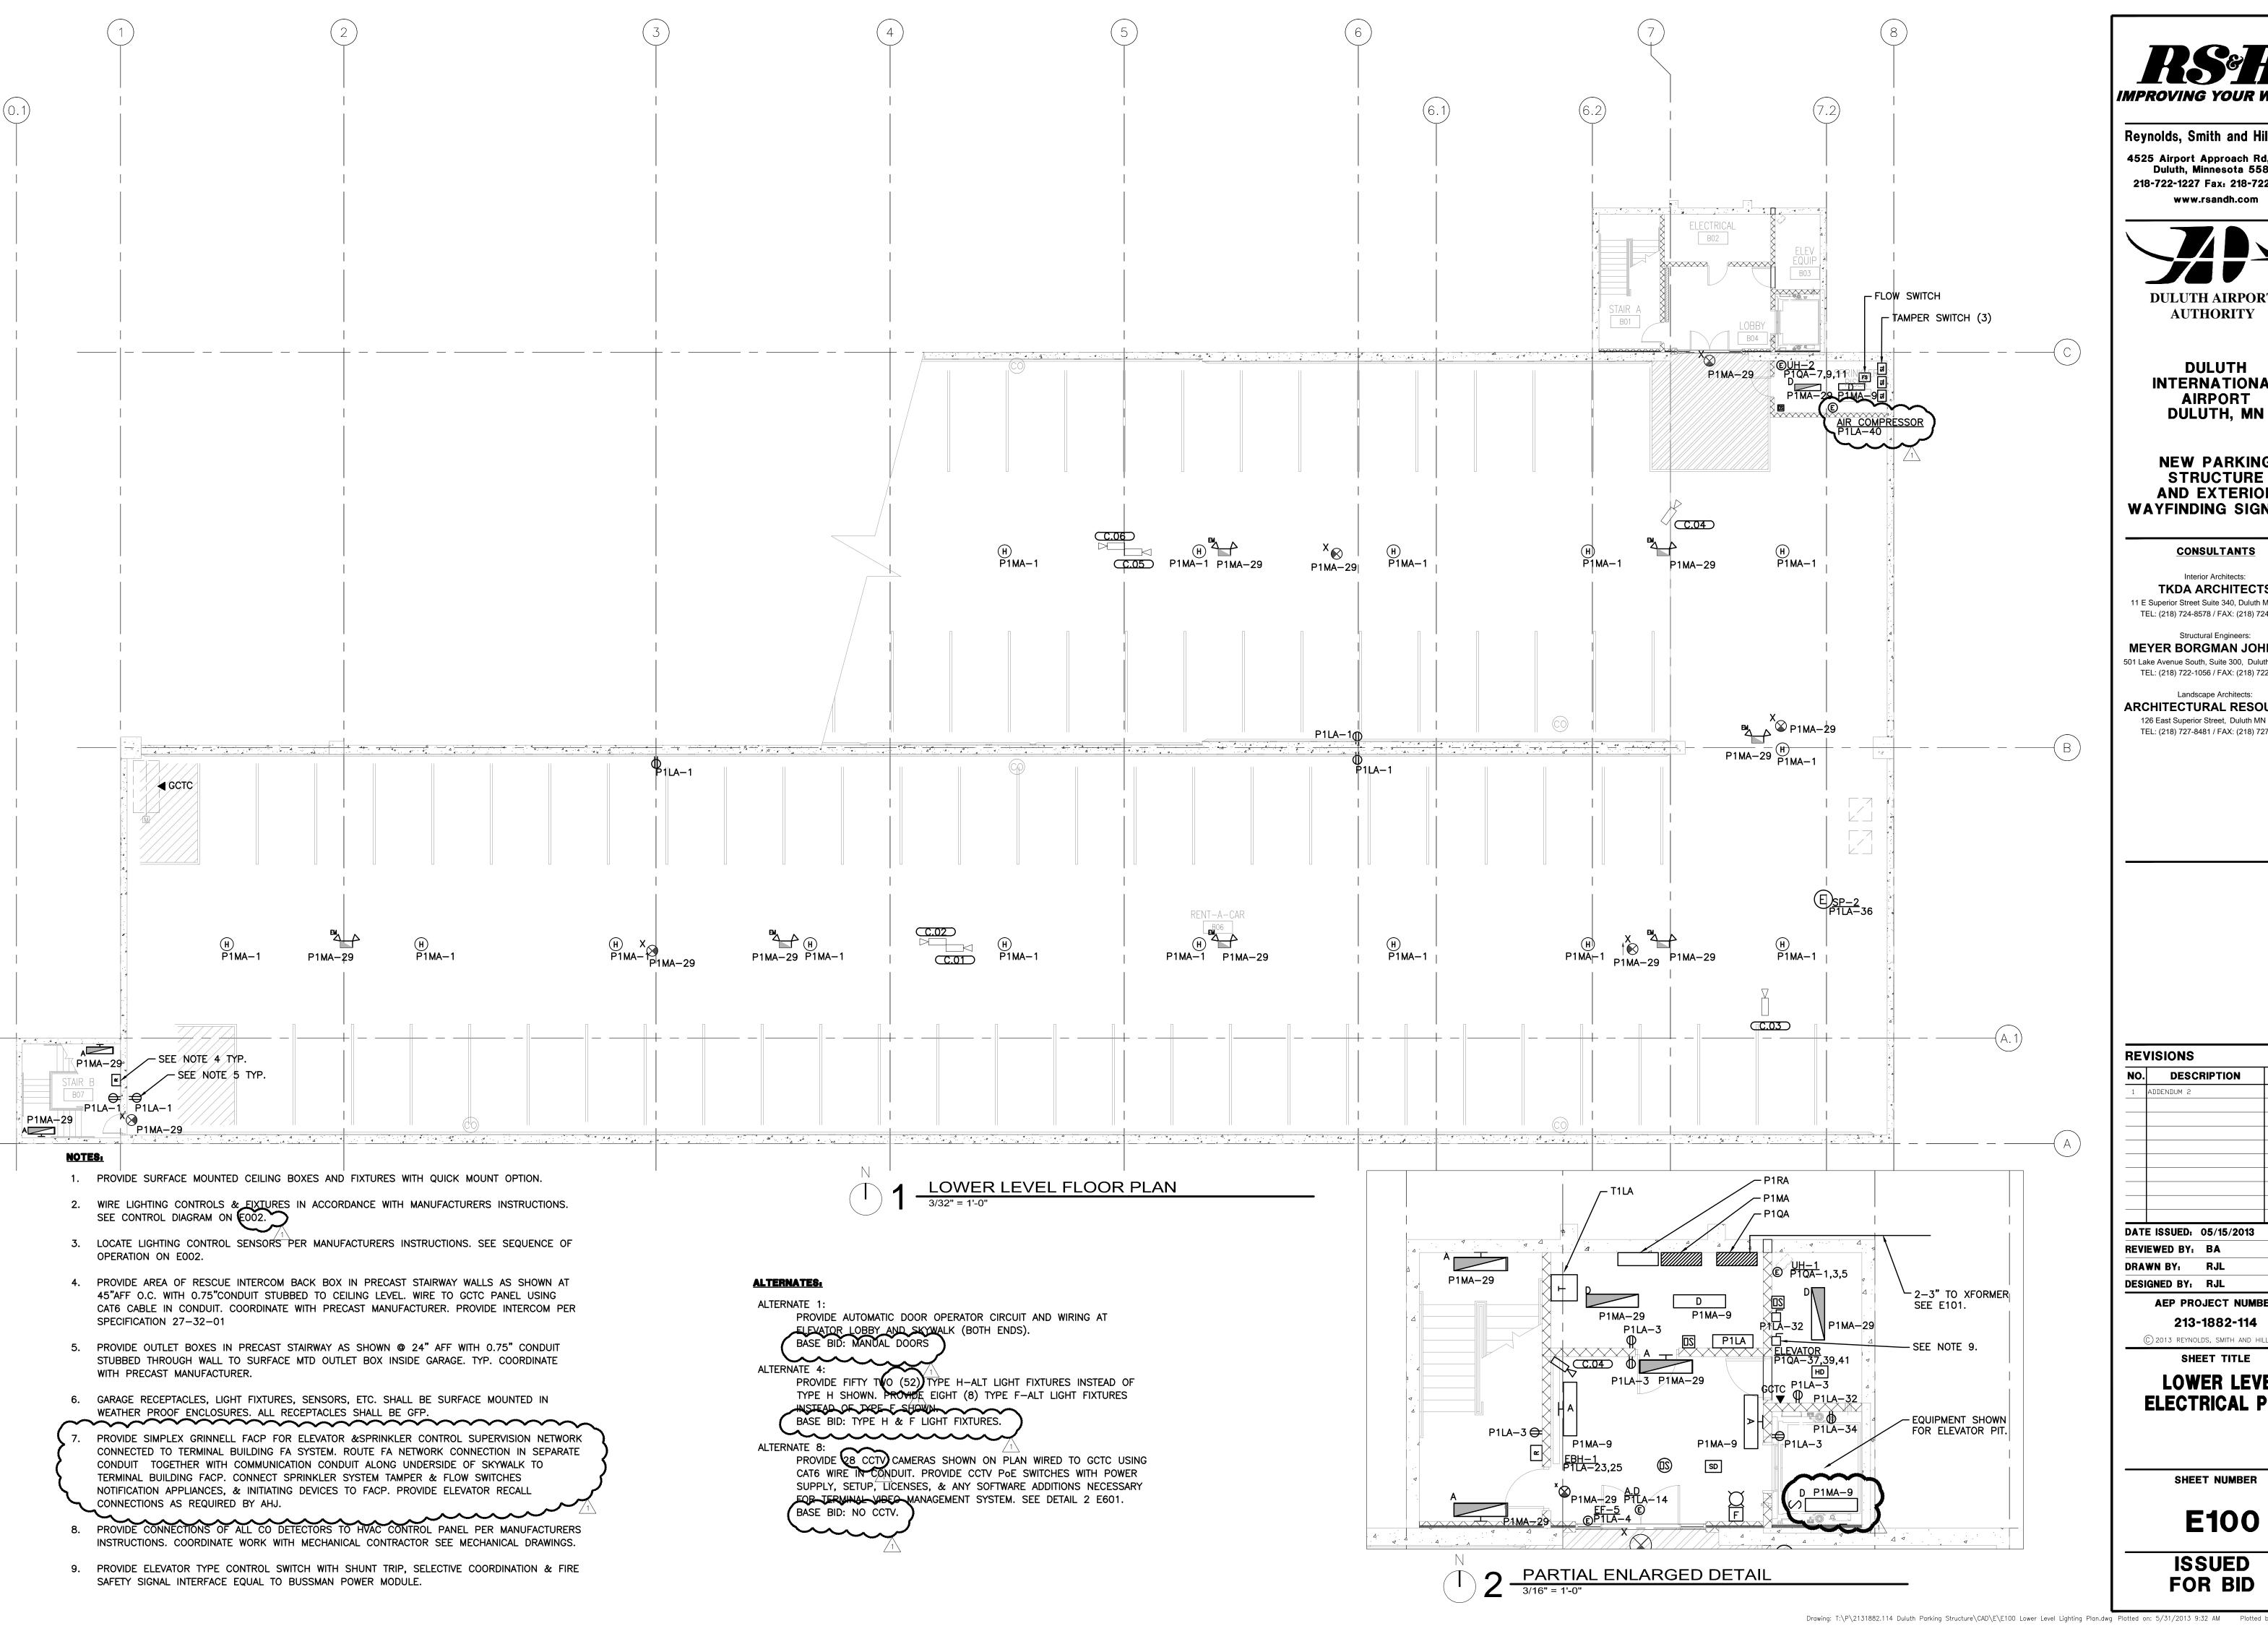

Reynolds, Smith and Hills, Inc. 4525 Airport Approach Rd, Ste A Duluth, Minnesota 55811 218-722-1227 Fax: 218-722-1052

DULUTH AIRPORT

DULUTH INTERNATIONAL

NEW PARKING STRUCTURE **AND EXTERIOR WAYFINDING SIGNAGE**

Interior Architects: TKDA ARCHITECTS 11 E Superior Street Suite 340, Duluth MN 55802

TEL: (218) 724-8578 / FAX: (218) 724-8717

MEYER BORGMAN JOHNSON 501 Lake Avenue South, Suite 300, Duluth MN 55802 TEL: (218) 722-1056 / FAX: (218) 722-9306

Landscape Architects: ARCHITECTURAL RESOURCES 126 East Superior Street, Duluth MN 55802 TEL: (218) 727-8481 / FAX: (218) 727-8483

DATE DESCRIPTION

DATE ISSUED: 05/15/2013

AEP PROJECT NUMBER 213-1882-114


(C) 2013 REYNOLDS, SMITH AND HILLS INC.

SHEET TITLE **LOWER LEVEL**

ELECTRICAL PLAN

SHEET NUMBER

E100

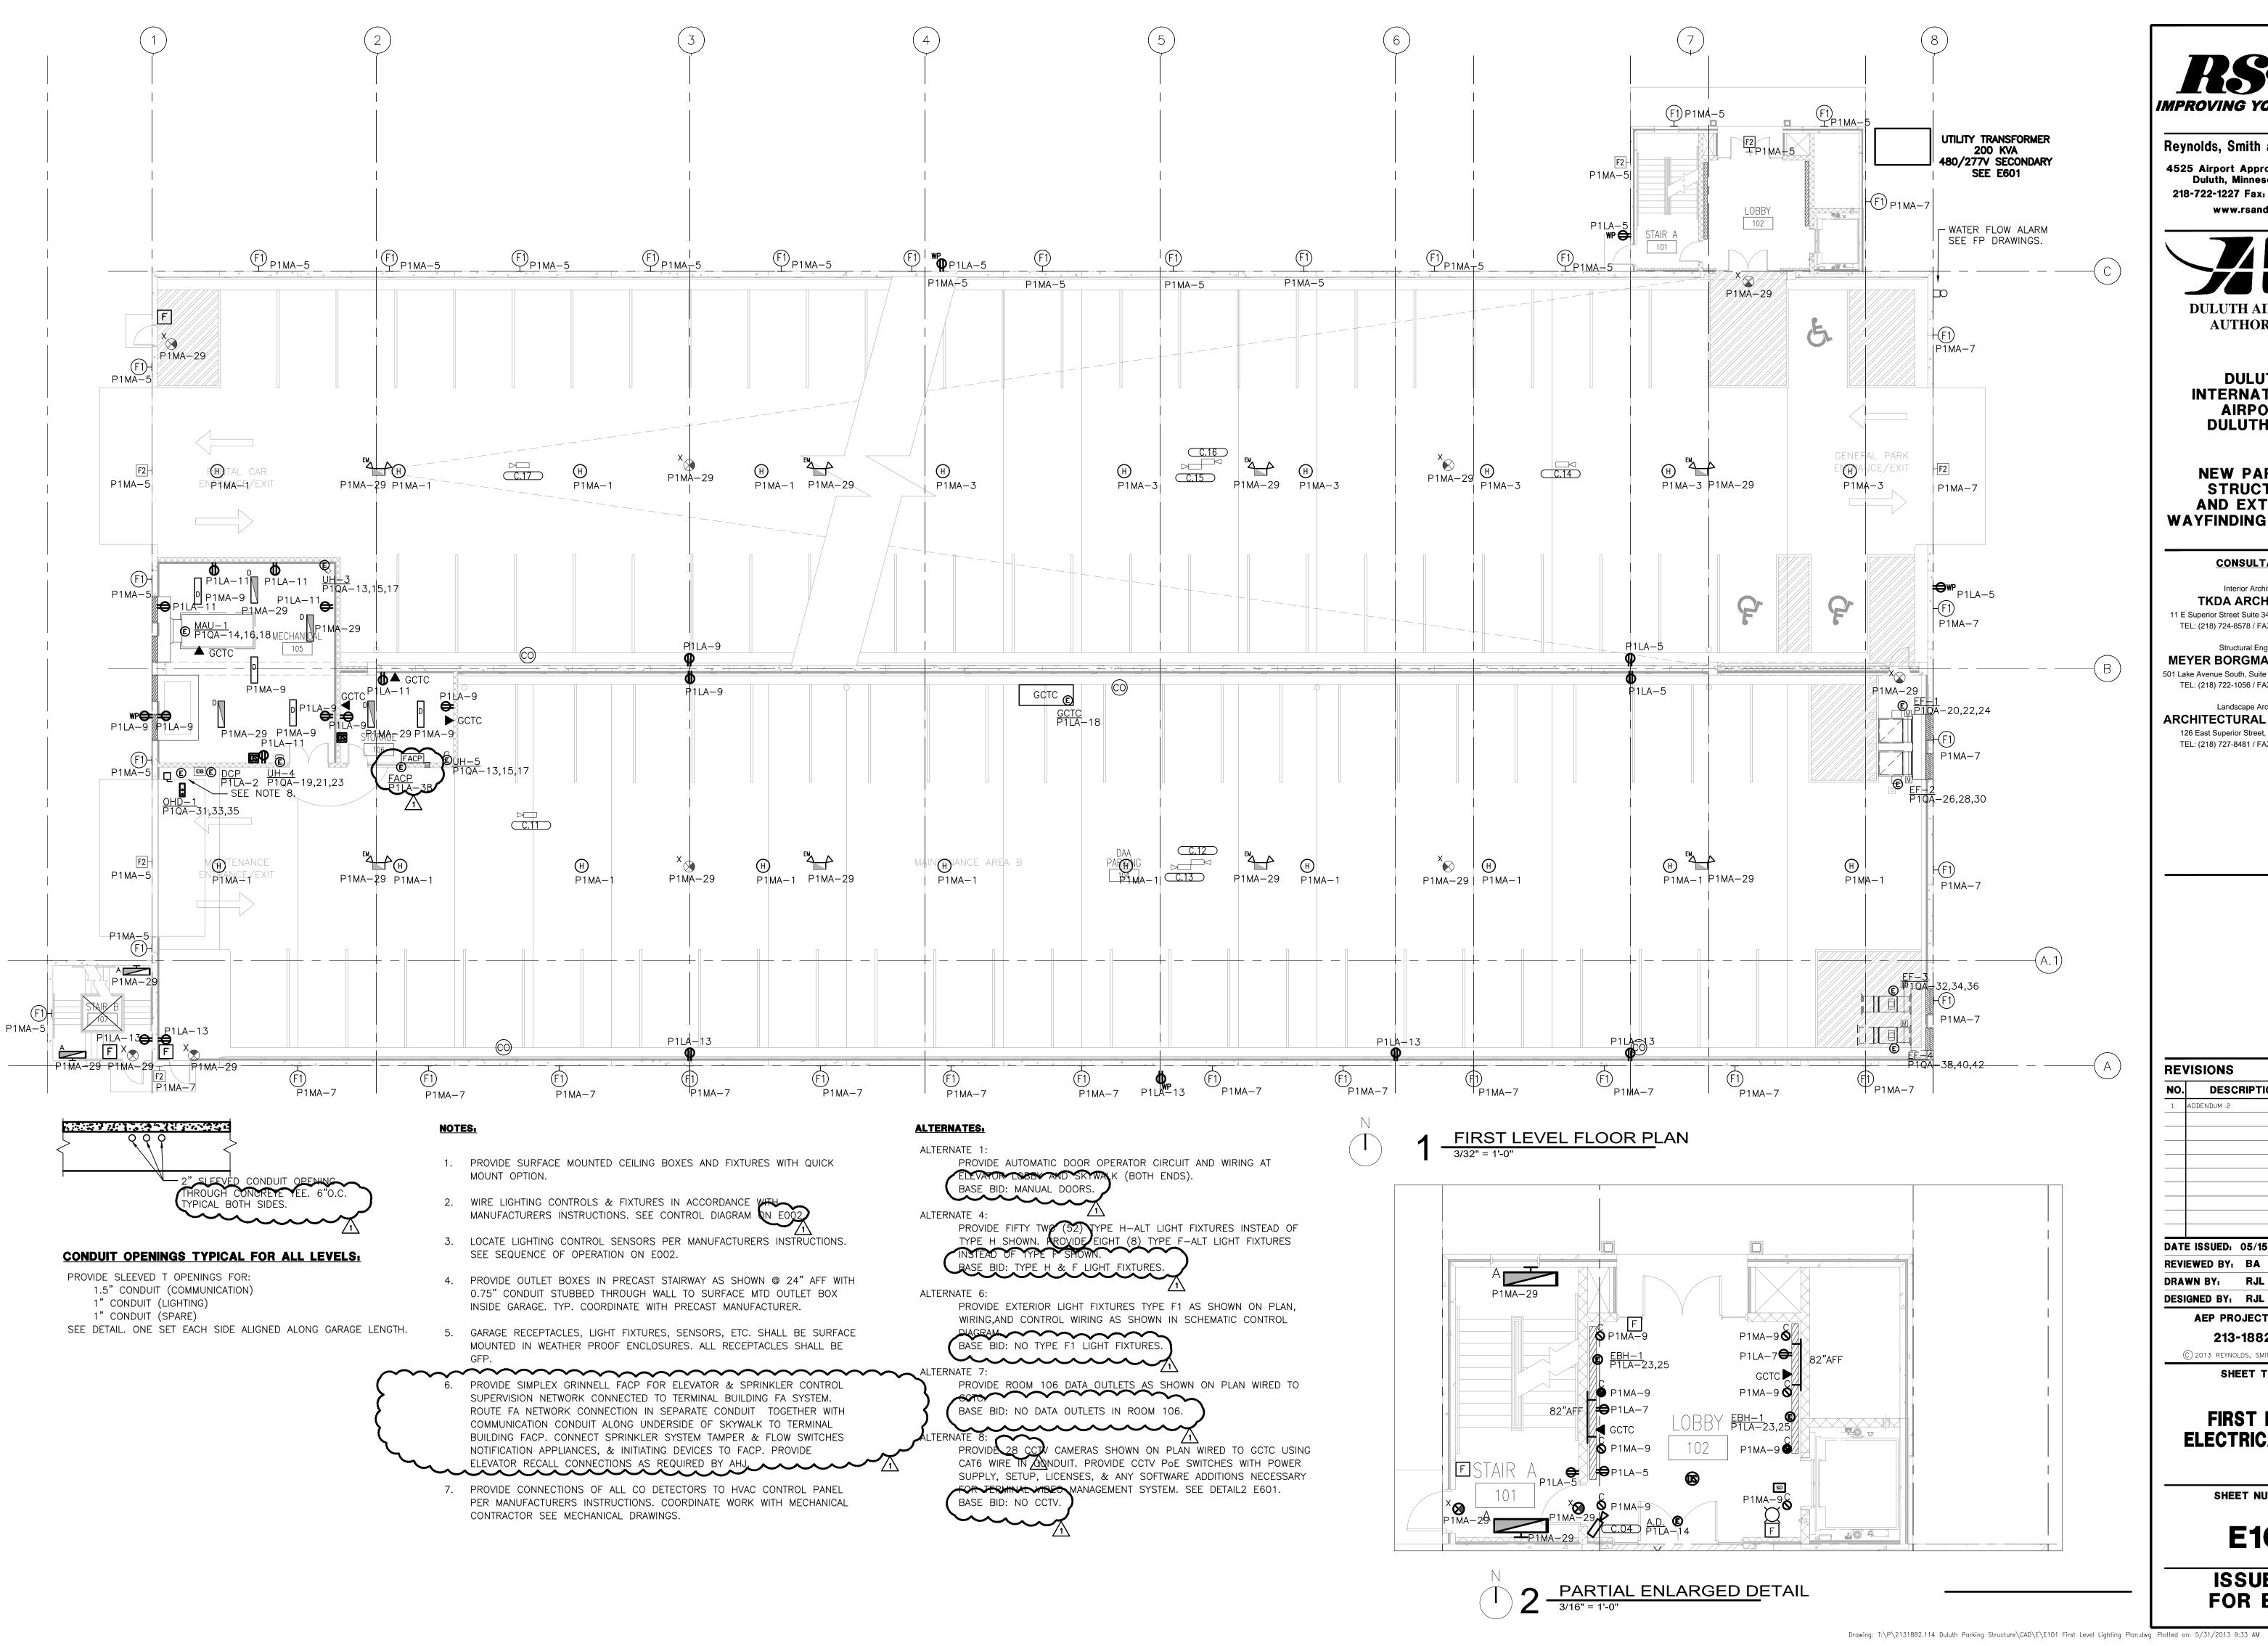

Reynolds, Smith and Hills, Inc. 4525 Airport Approach Rd, Ste A Duluth, Minnesota 55811 218-722-1227 Fax: 218-722-1052 www.rsandh.com

DULUTH AIRPORT AUTHORITY

> **DULUTH** INTERNATIONAL **AIRPORT** DULUTH, MN

NEW PARKING STRUCTURE **AND EXTERIOR WAYFINDING SIGNAGE**

CONSULTANTS

Interior Architects: TKDA ARCHITECTS

11 E Superior Street Suite 340, Duluth MN 55802 TEL: (218) 724-8578 / FAX: (218) 724-8717

Structural Engineers: **MEYER BORGMAN JOHNSON** 501 Lake Avenue South, Suite 300, Duluth MN 55802 TEL: (218) 722-1056 / FAX: (218) 722-9306

Landscape Architects: **ARCHITECTURAL RESOURCES** 126 East Superior Street, Duluth MN 55802 TEL: (218) 727-8481 / FAX: (218) 727-8483

REVISIONS

NO. DATE DESCRIPTION DDENDUM 2

DATE ISSUED: 05/15/2013 REVIEWED BY: BA

DRAWN BY: RJL

AEP PROJECT NUMBER


213-1882-114

(C) 2013 REYNOLDS, SMITH AND HILLS INC. SHEET TITLE

FIRST LEVEL **ELECTRICAL PLAN**

SHEET NUMBER

E101

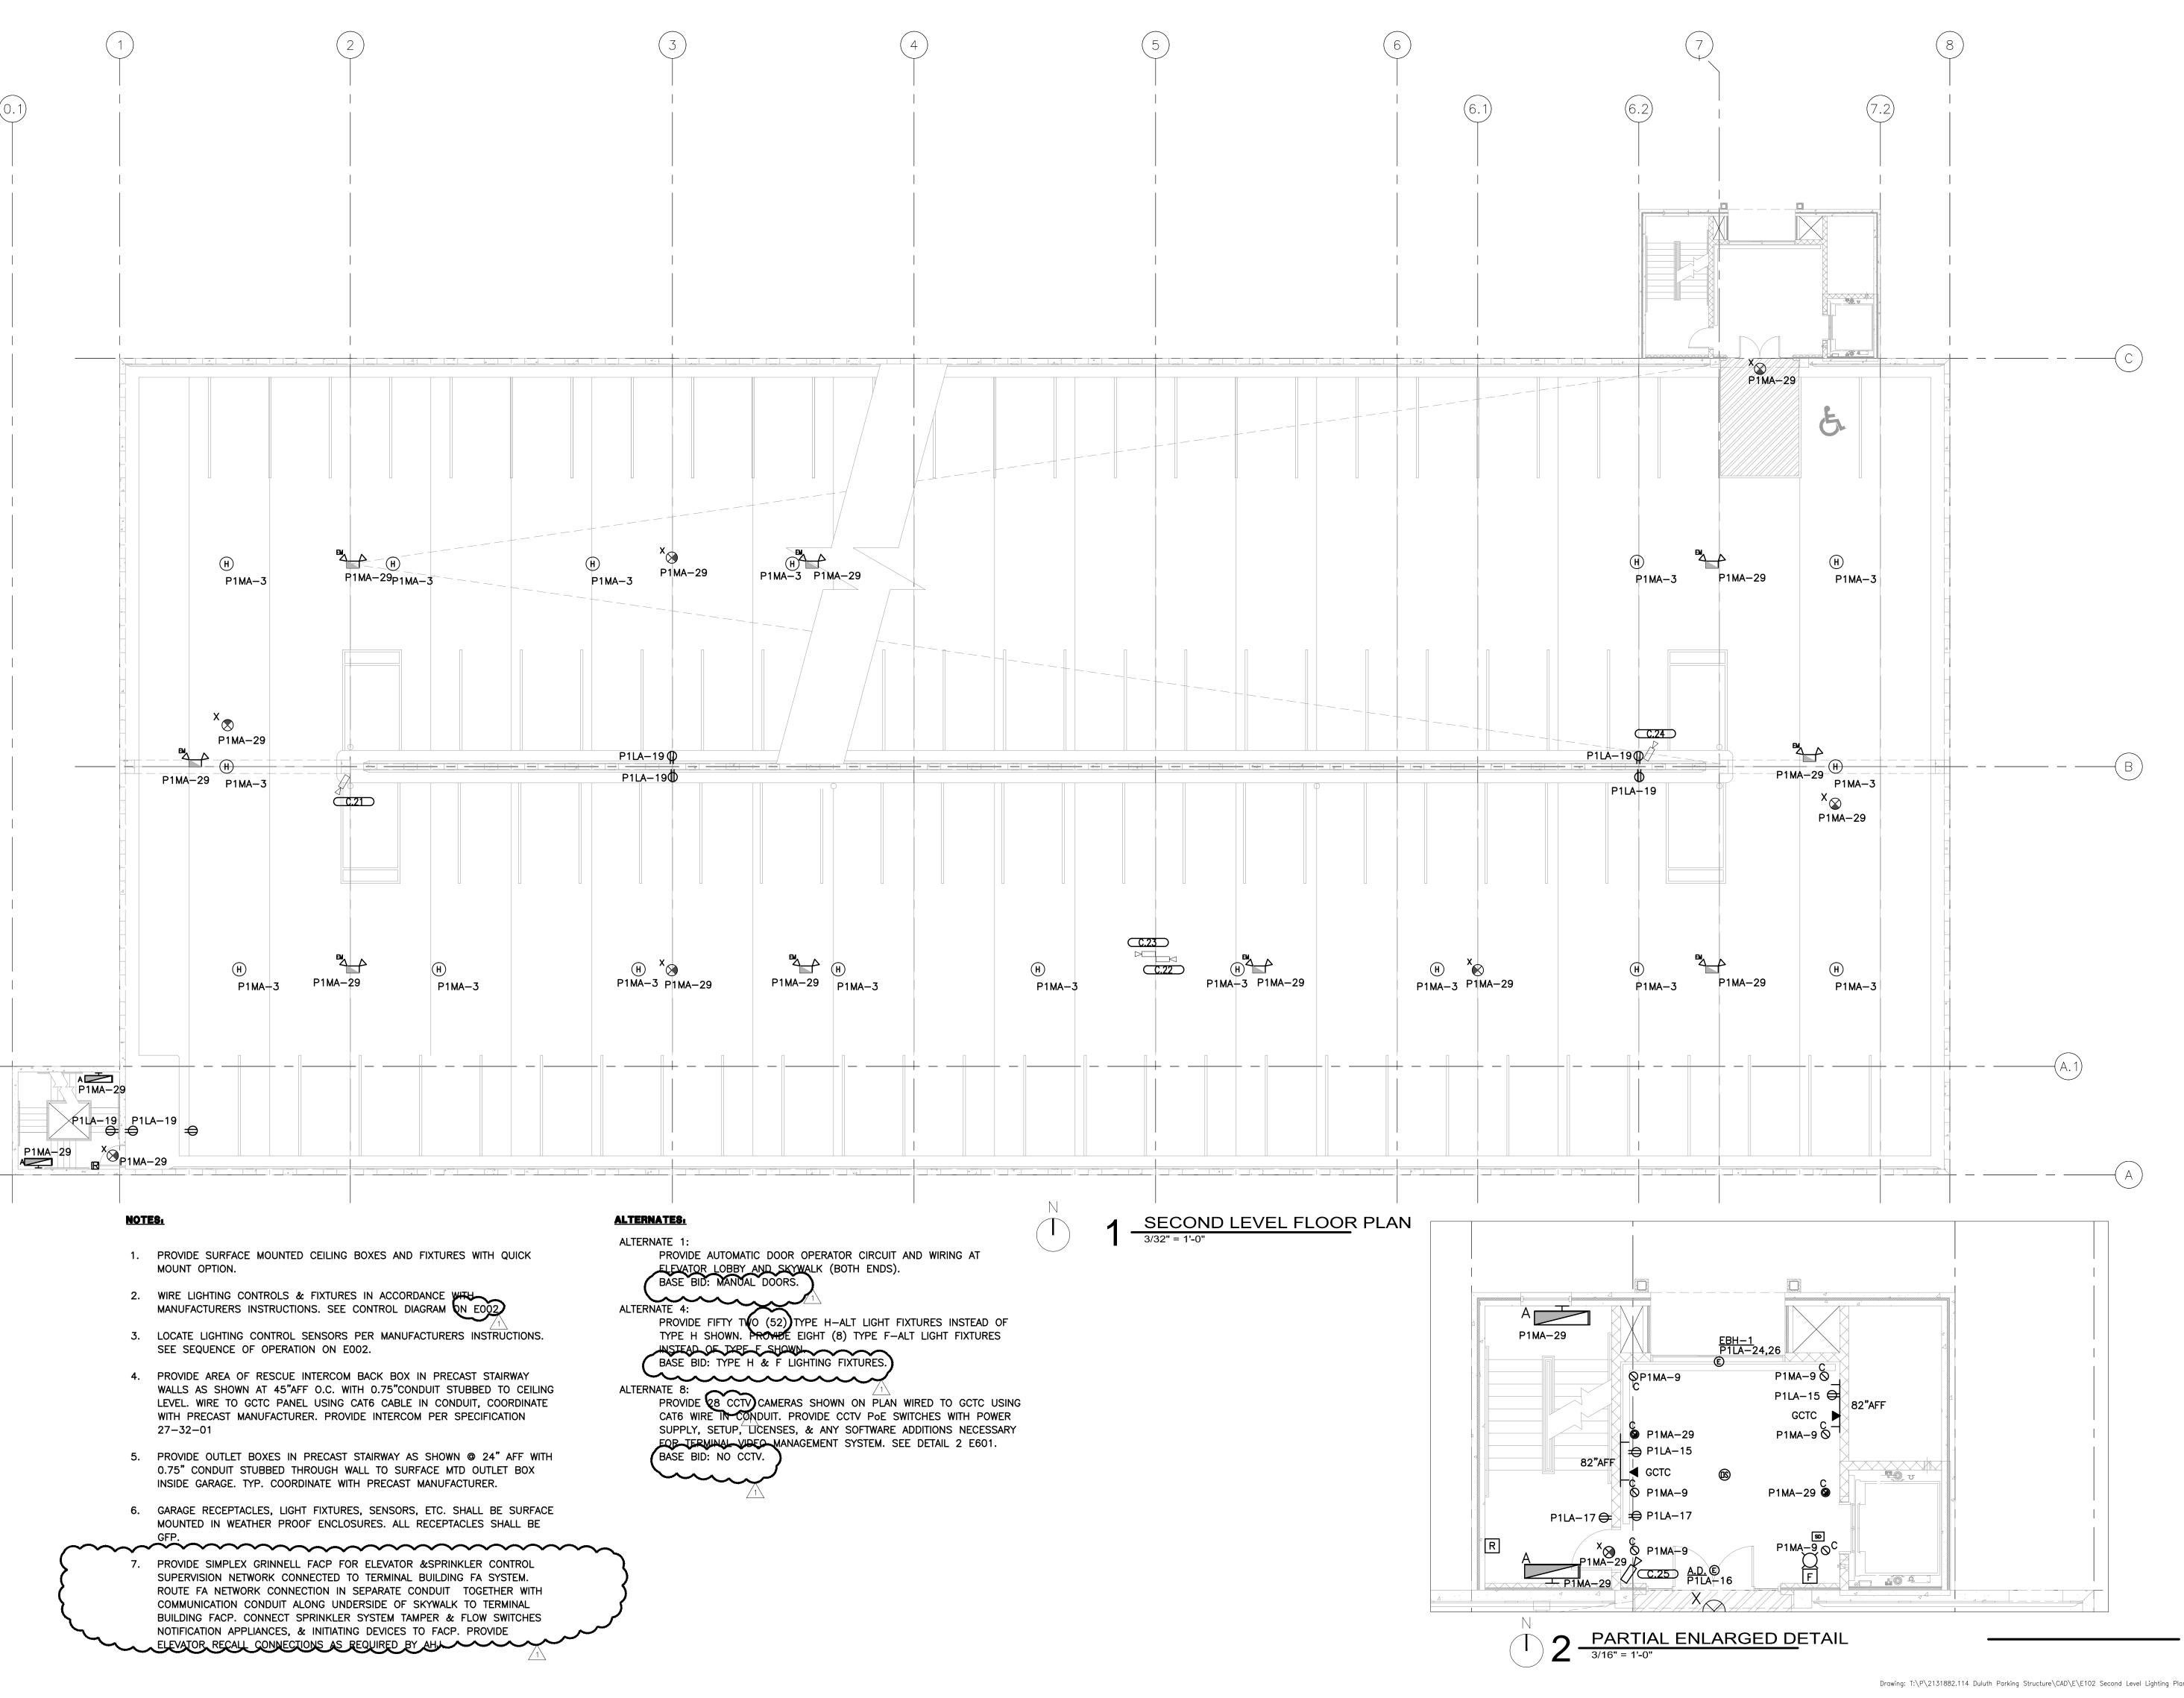

Reynolds, Smith and Hills, Inc. 4525 Airport Approach Rd, Ste A Duluth, Minnesota 55811 218-722-1227 Fax: 218-722-1052 www.rsandh.com



AUTHORITY

DULUTH INTERNATIONAL **AIRPORT** DULUTH, MN

NEW PARKING STRUCTURE **AND EXTERIOR** WAYFINDING SIGNAGE

CONSULTANTS

Interior Architects: TKDA ARCHITECTS

11 E Superior Street Suite 340, Duluth MN 55802 TEL: (218) 724-8578 / FAX: (218) 724-8717

Structural Engineers: **MEYER BORGMAN JOHNSON** 501 Lake Avenue South, Suite 300, Duluth MN 55802 TEL: (218) 722-1056 / FAX: (218) 722-9306

Landscape Architects: ARCHITECTURAL RESOURCES 126 East Superior Street, Duluth MN 55802

TEL: (218) 727-8481 / FAX: (218) 727-8483

REVISIONS

NO. DESCRIPTION DATE

DATE ISSUED: 05/15/2013 REVIEWED BY: BA

DRAWN BY: RJL DESIGNED BY: RJL

AEP PROJECT NUMBER

213-1882-114 © 2013 REYNOLDS, SMITH AND HILLS INC.

SHEET TITLE

SECOND LEVEL


ELECTRICAL PLAN

SHEET NUMBER

E102

ISSUED FOR BID

Drawing: T:\P\2131882.114 Duluth Parking Structure\CAD\E\E102 Second Level Lighting Plan.dwg Plotted on: 5/31/2013 9:33 AM Plotted by: Llazari, Rional

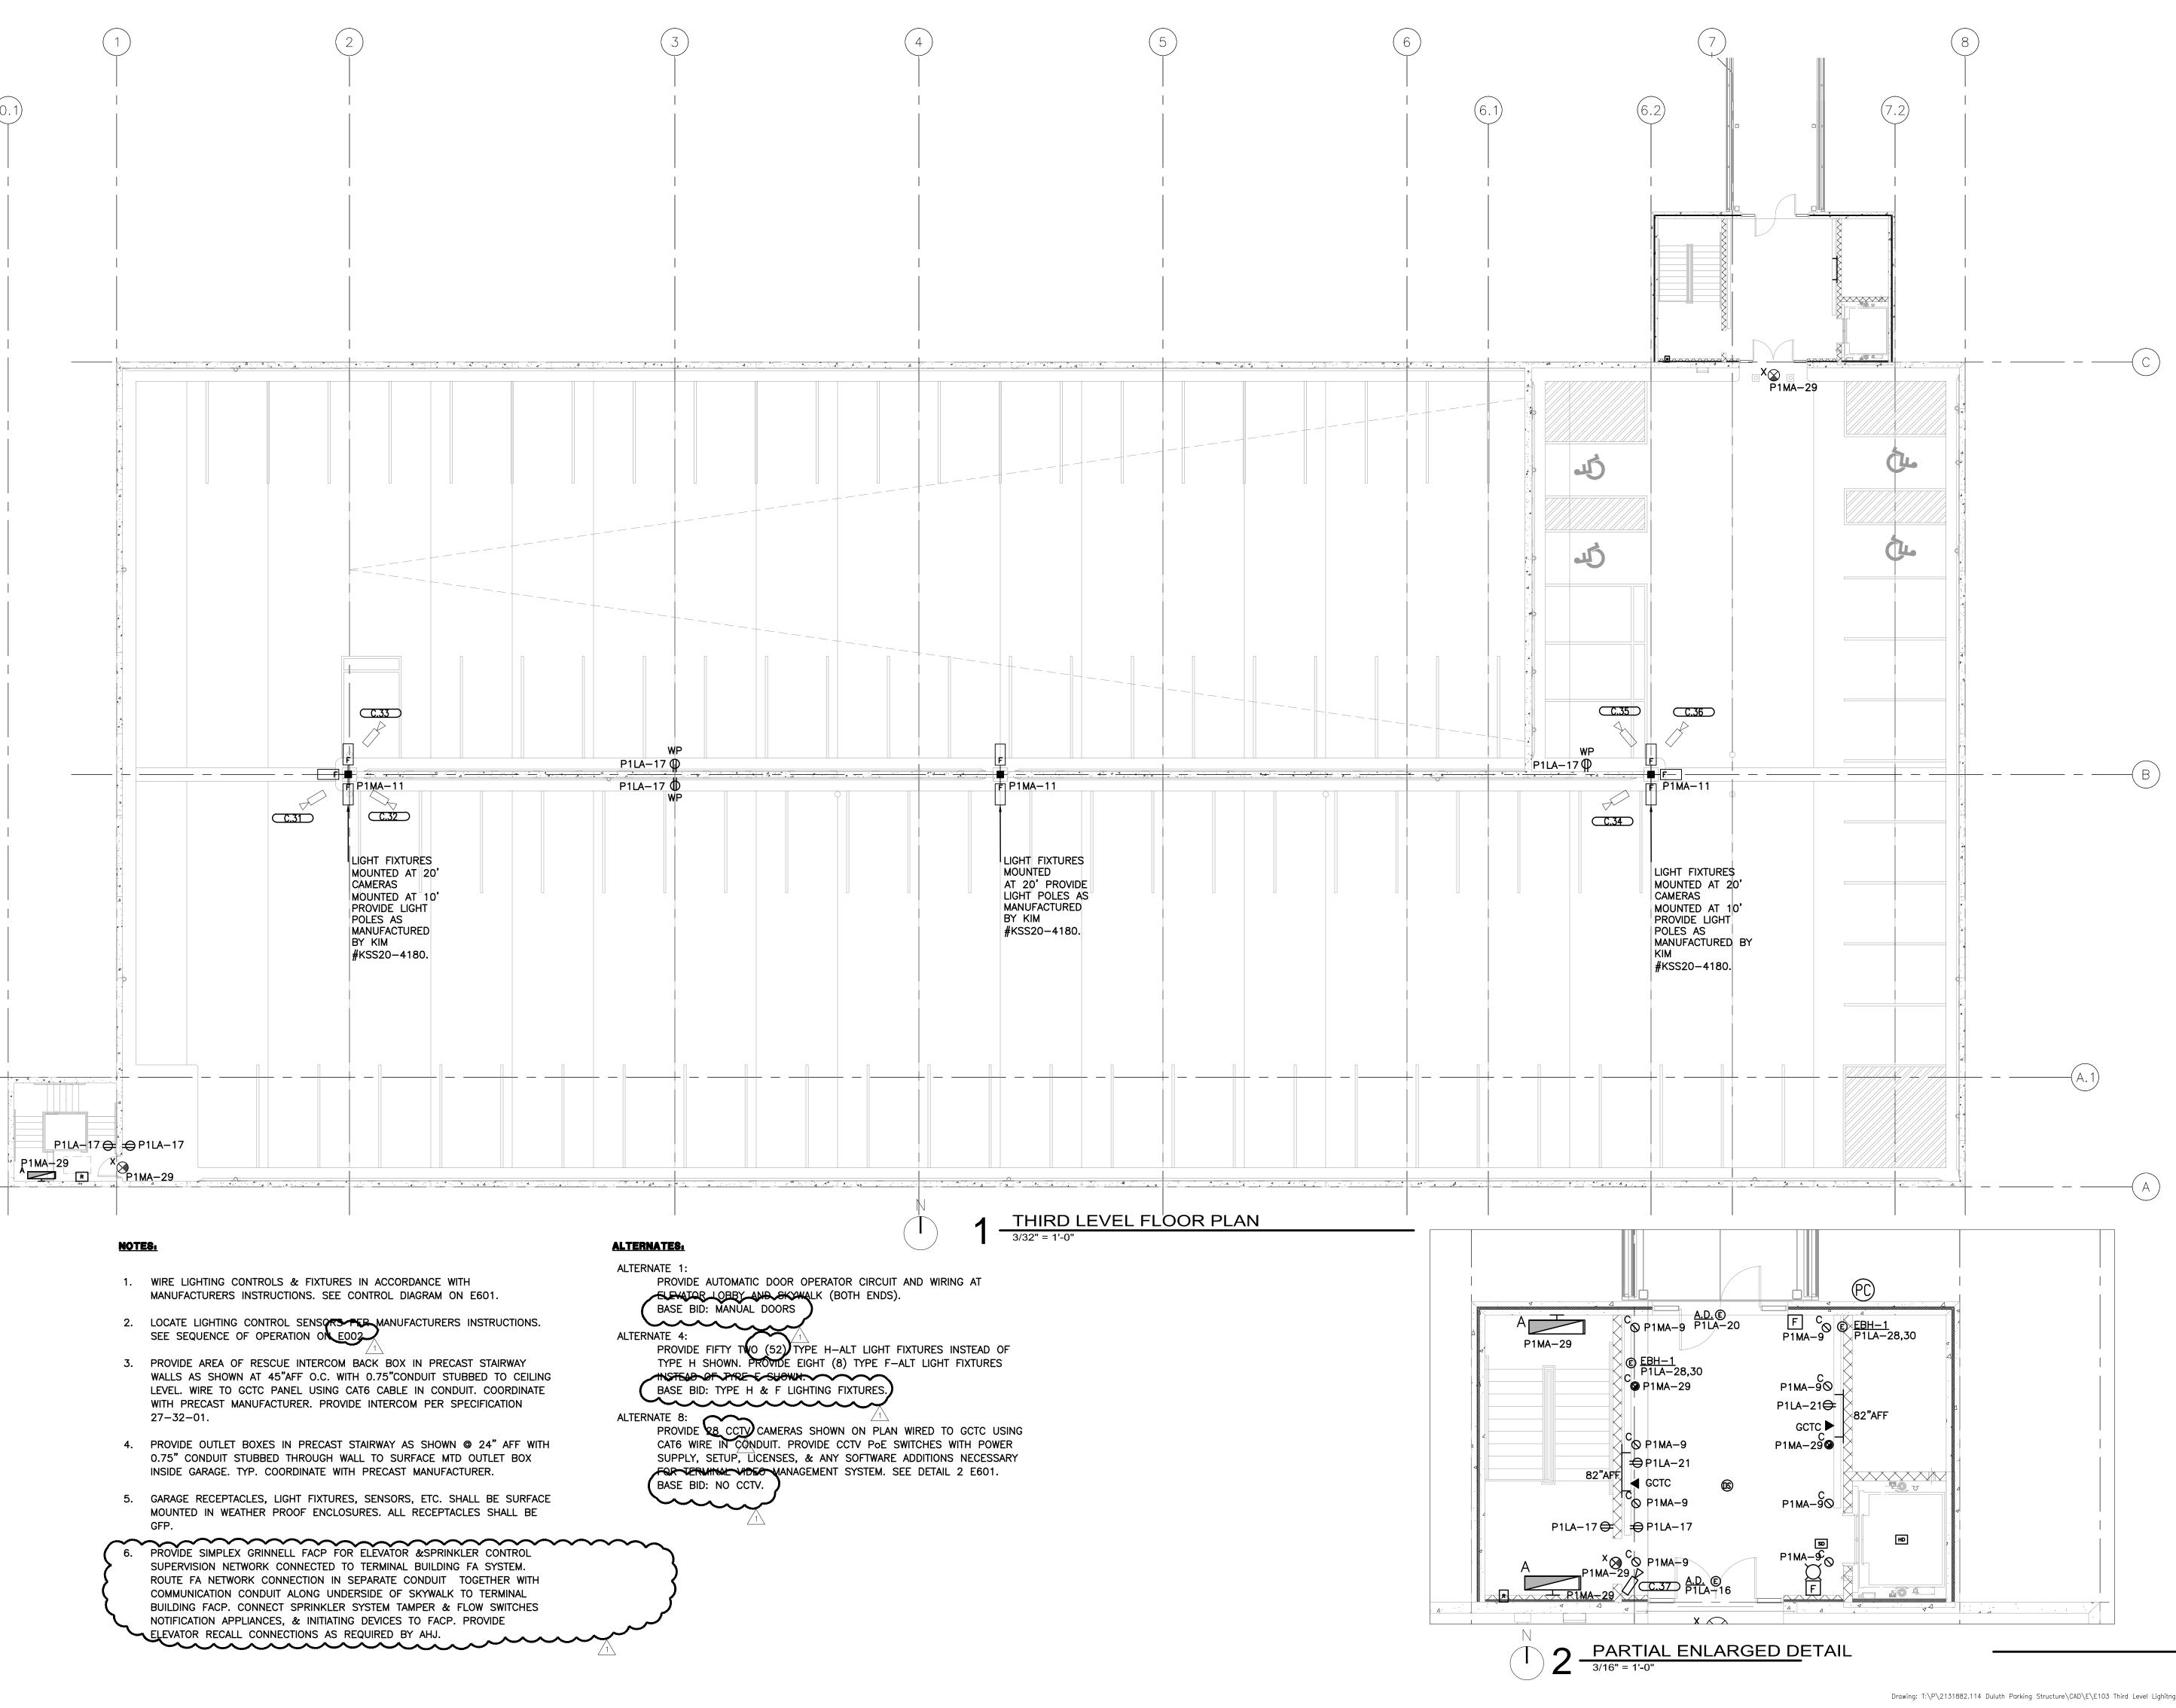

Reynolds, Smith and Hills, Inc. 4525 Airport Approach Rd, Ste A Duluth, Minnesota 55811 218-722-1227 Fax: 218-722-1052 www.rsandh.com



AUTHORITY

DULUTH INTERNATIONAL **AIRPORT**

DULUTH, MN

NEW PARKING STRUCTURE **AND EXTERIOR WAYFINDING SIGNAGE**

CONSULTANTS

Interior Architects: TKDA ARCHITECTS

11 E Superior Street Suite 340, Duluth MN 55802 TEL: (218) 724-8578 / FAX: (218) 724-8717

Structural Engineers: **MEYER BORGMAN JOHNSON** 501 Lake Avenue South, Suite 300, Duluth MN 55802 TEL: (218) 722-1056 / FAX: (218) 722-9306

Landscape Architects: ARCHITECTURAL RESOURCES 126 East Superior Street, Duluth MN 55802 TEL: (218) 727-8481 / FAX: (218) 727-8483

REVISIONS

NO.	DESCRIPTION	DATE
1	ADDENDUM 2	5-31-13

DATE ISSUED: 05/15/2013 REVIEWED BY: BA

DRAWN BY: RJL DESIGNED BY: RJL

AEP PROJECT NUMBER


213-1882-114 © 2013 REYNOLDS, SMITH AND HILLS INC.

SHEET TITLE

THIRD LEVEL **ELECTRICAL PLAN**

SHEET NUMBER

E103

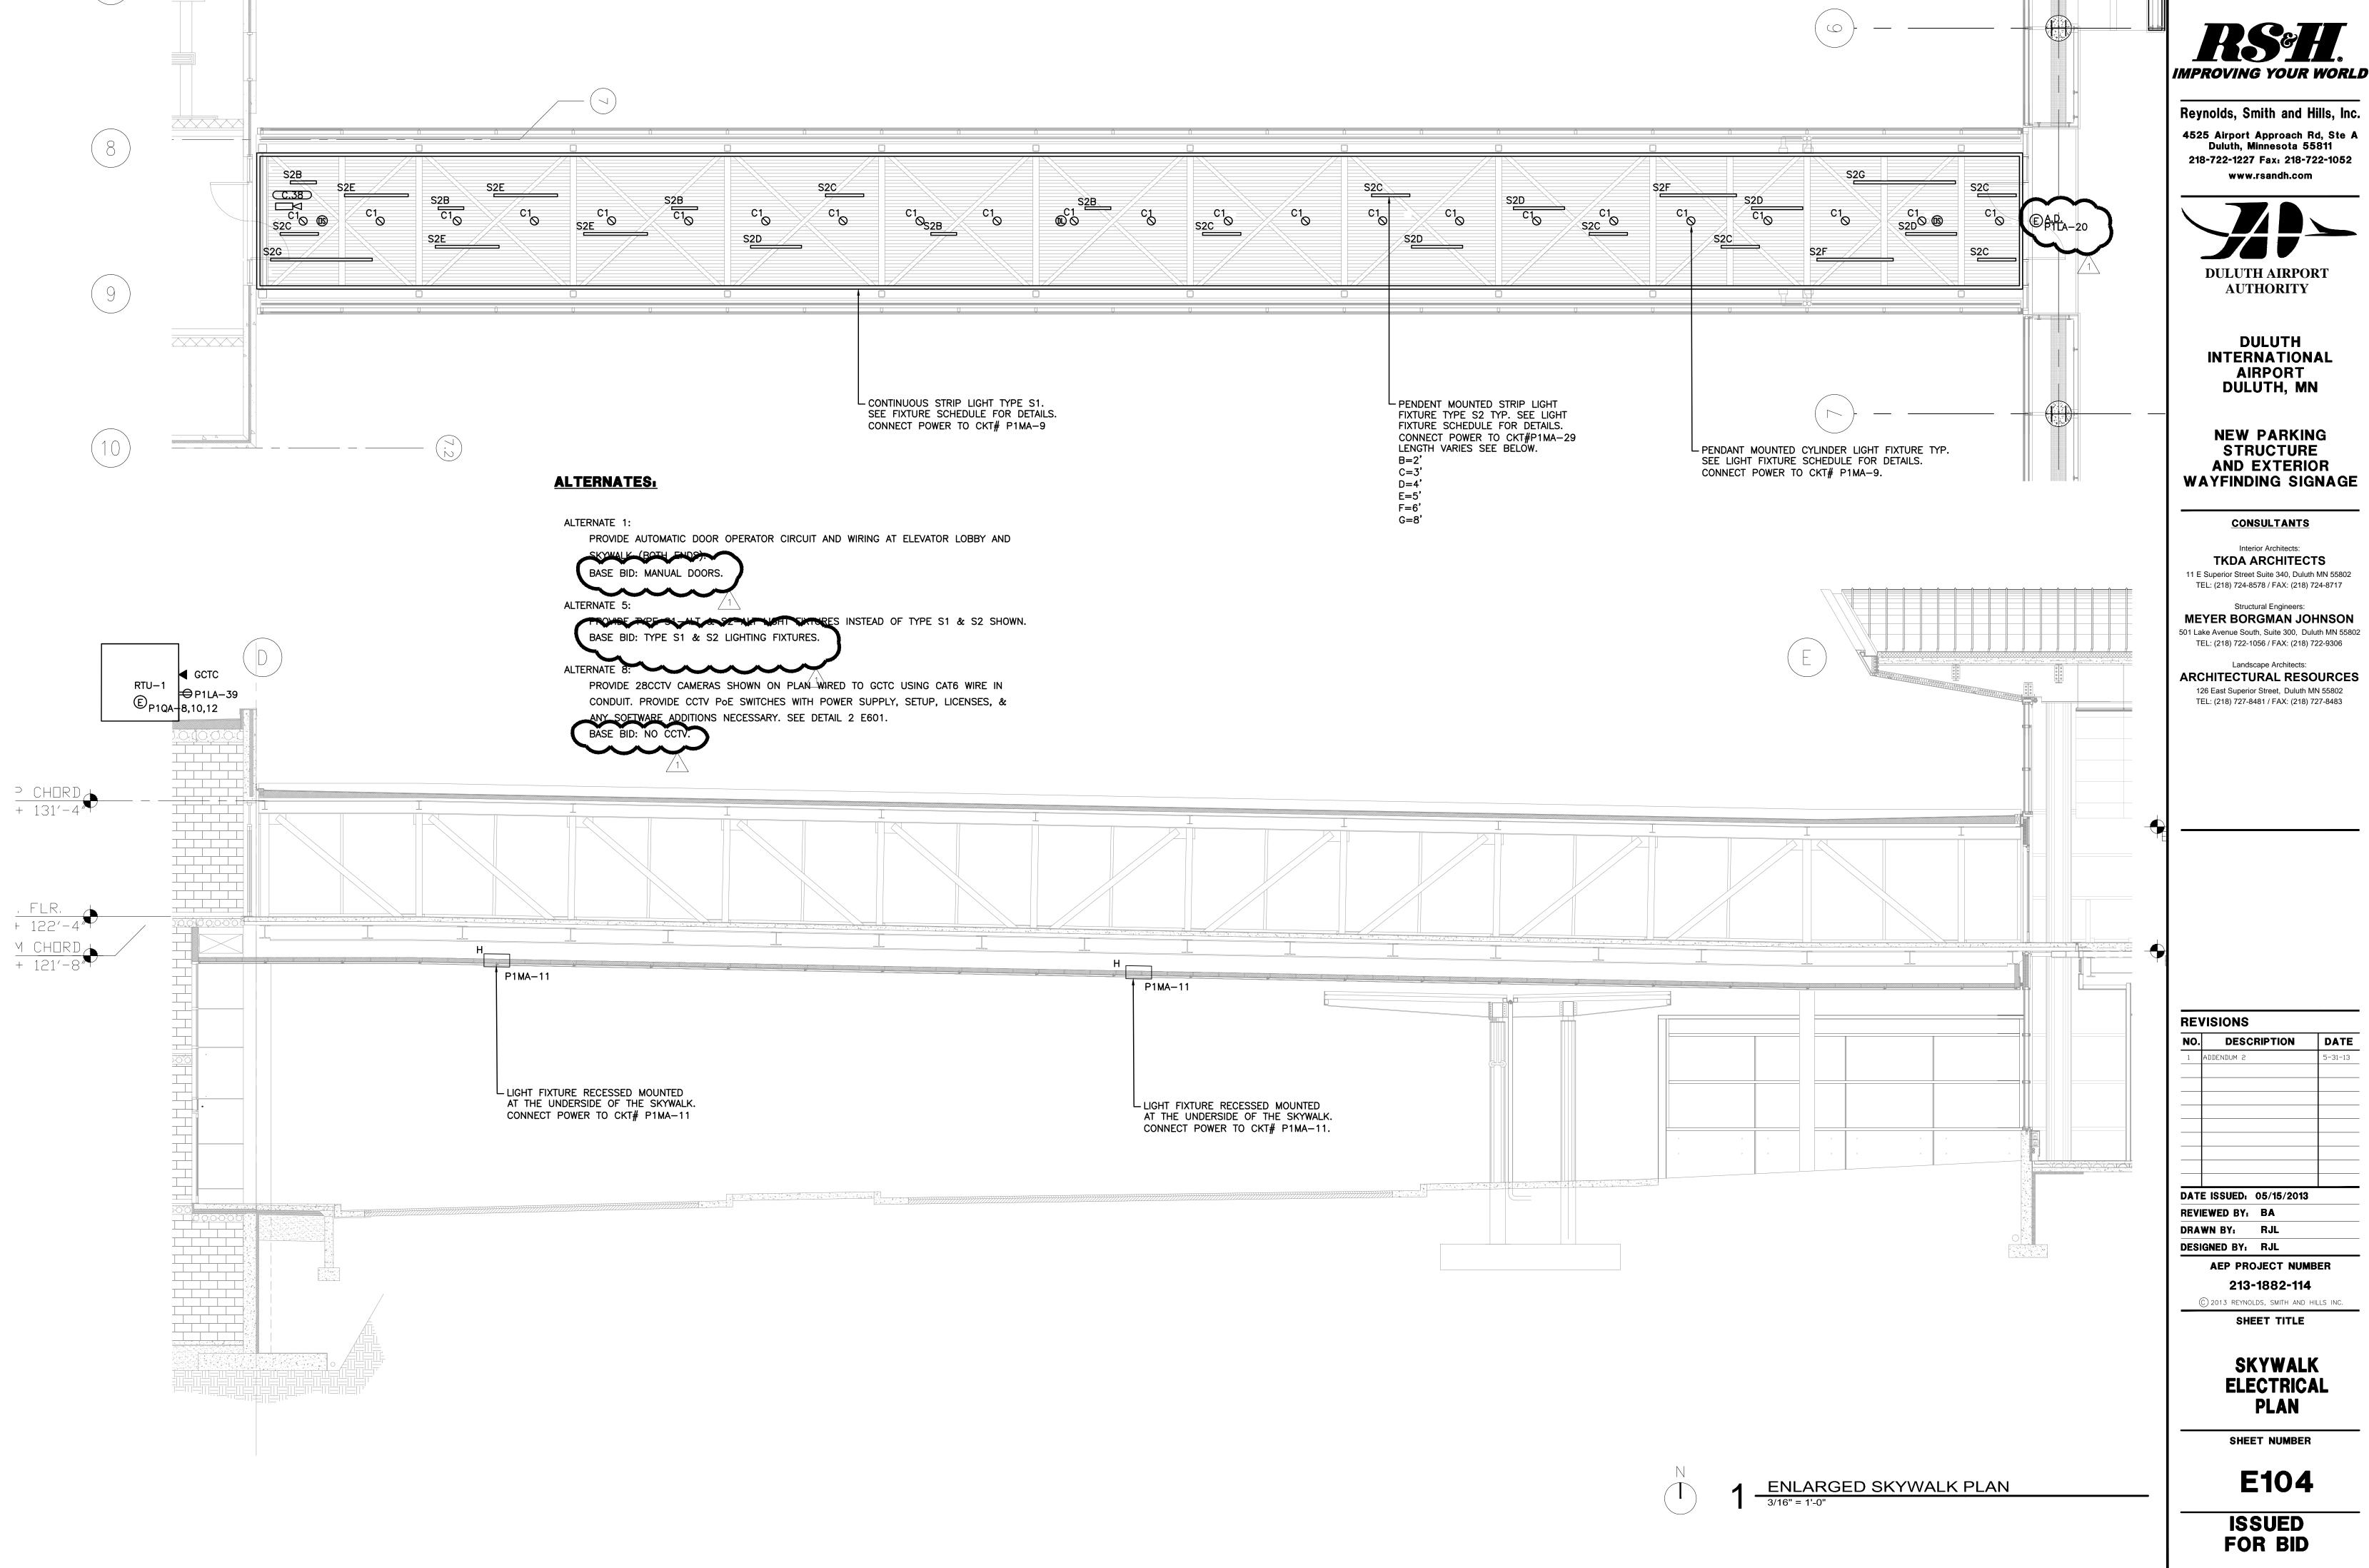

Reynolds, Smith and Hills, Inc. 4525 Airport Approach Rd, Ste A Duluth, Minnesota 55811 218-722-1227 Fax: 218-722-1052




11 E Superior Street Suite 340, Duluth MN 55802 TEL: (218) 724-8578 / FAX: (218) 724-8717

MEYER BORGMAN JOHNSON

126 East Superior Street, Duluth MN 55802 TEL: (218) 727-8481 / FAX: (218) 727-8483

NO.	DESCRIPTION	DATE
1	ADDENDUM 2	5-31-13
DAT	E ISSUED: 05/15/2013	

Drawing: T:\P\2131882.114 Duluth Parking Structure\CAD\E\E104 Enlarged Skywalk Plan.dwg Plotted on: 5/31/2013 9:35 AM Plotted by: Llazari, Rional

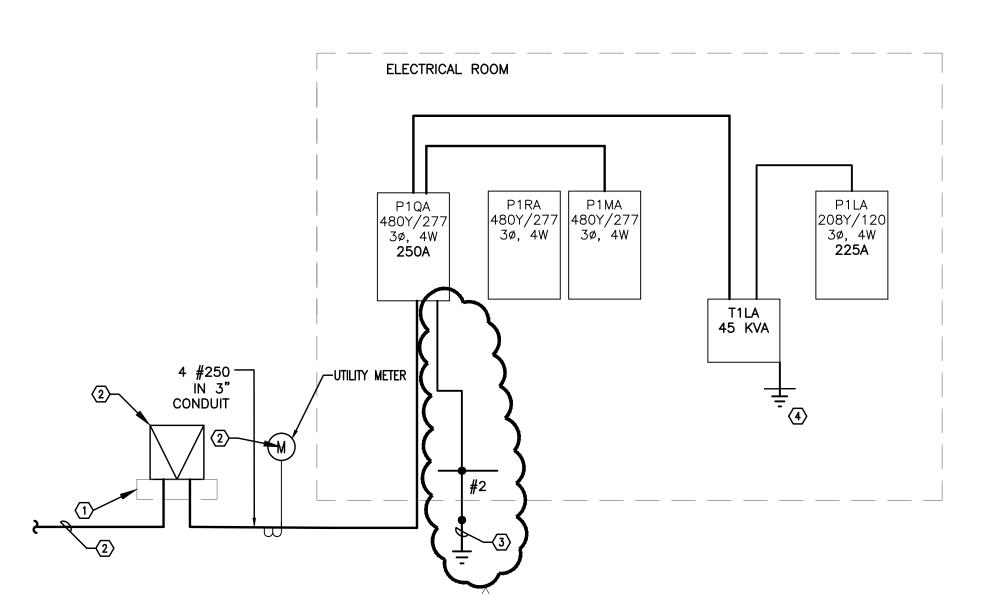

NORMAL POWER DLH PARKING GARAGE					
LOAD CALCULATIONS					
DESC .	NOTE	FACTOR	CON'D	<u>DEM</u>	
LIGHTING		125%	27.2	34	
RECEPTACLE		50%	9.2	9.2	
MECH. EQUIP.		70%	70.7	49.5	
LARGEST MOTOR		70%	22.4	15.7	
HEATING LOAD		100%	33	33	
EQUIP. CONN.		50%	16.2	8.1	
TOTAL BLDG KVA			178.7	149.5	
SPARE CAPACITY		10%	17.9	15	
NEC RCPT 1ST 10 KVA			N/A	N/A	
LARGEST MTR		25%	5.6	3.9	
TOTAL UTILITY KVA			202.2	168.4	
TOTAL AMP	DIVERSITY	0.831	168	140	


NOTES:

- (1) CONCRETE PAD PER UTILITY STANDARDS. PROVIDE SECONDARY CONDUIT DUCTBANK, CONCRETE ENCASED, AND CABLE. TRANSFORMER CONNECTIONS BY UTILITY CO.
- (2) CONTRACTOR SHALL COORDINATE INSTALLATION WITH UTILITY PROVIDER PER UTILITY REQUIREMENTS. SEE DWG. E101 FOR LOCATION.
- 3 PROVIDE SERVICE ENTRANCE GROUND PER NEC. CONNECT GROUND BUS TO 5/8" X 10' COPPERCLAD STEEL GROUND ROD DRIVEN INTO COMPACTED/UNDISTURBED EARTH TO 30" BFG. CONNECT #2 COPPER GROUNDING ELECTRODE CONDUCTOR TO GROUND ROD USING EXOTHERMIC WELD. BOND SERVICE ENTRANCE PANEL BOARD GROUND WITH #4 THWN COPPER (GREEN) TO TWO GROUNDS PER NEC.
- 4 BOND THE SECONDARY OF ALL TRANSFORMERS AND BUILDING STEEL.

POWER RISER DIAGRAM NO SCALE

GENERAL NOTES

- 1. CONTRACTOR SHALL PERFORM OTDR TESTING ON FIBER OPTIC CABLES PRIOR TO MODIFICATION AND AFTER FINAL COMPLETION.
- 2. REFER TO SPECIFICATIONS SECTION 16714, 16716 & 16717.
- 3. THESE DRAWINGS INDICATE TYPICAL CONNECTIONS ONLY. CONTRACTOR SHALL PROVIDE DETAILED SHOP DRAWINGS FOR ALL FIBER AND COPPER CABLES AND PATCH PANEL CONNECTIONS. THE SHOP DRAWINGS SHALL CLEARLY SHOW LOCATION OF ALL PATCH PANELS, SIZE, QUANTITY, AND PORT USAGE. PROVIDE ADDITIONAL RACKS AND OTHER ACCESSORIES REQUIRED TO PROVIDE A COMPLETE AND OPERATIONAL SYSTEM.
- 4. CONTRACTOR SHALL LABEL ALL PATCH PANELS, CABLES AND TERMINATION LOCATIONS. LABELS SHALL BE TYPEWRITTEN. REFER TO SPECIFICATIONS FOR LABELING REQUIREMENTS.
- 5. REFER TO SPECIFICATIONS SECTION 16715 FOR COMMUNICATIONS NETWORK
- 6. MANUFACTURER AND MODEL NUMBERS ARE USED TO ESTABLISH QUALITY AND PERFORMANCE OF THE SYSTEM. ANY EQUIPMENT THAT MEETS OR EXCEEDS THE PERFORMANCE SHALL BE CONSIDERED AND APPROVED AT THE DISCRETION OF THE ENGINEER AND/OR OWNER.
- 7. THE SCOPE SHALL INCLUDE DESIGN, IMPLEMENTATION, SETUP AND TRAINING TO THE OWNERS STAFF AND CONNECTION TO ALL THE EQUIPMENT SHOWN ON THE DRAWINGS. CONTRACTOR SHALL PROVIDE ALL COMPONENTS REQUIRED TO CONNECT THE ETHERNET BASED SYSTEMS TO THE NETWORK. THE CONTRACTOR SHALL COORDINATE WITH AIRPORT "IT" SUPPORT PERSONNEL AND CONSULTANTS.
- 8. SUBMIT SHOP DRAWINGS AND DATA SHEETS FOR ALL COMPONENTS. SHOP DRAWINGS SHALL INCLUDE CABLE IDENTIFICATION ASSIGNMENTS AND PORT USAGE. DRAWINGS SHALL CLEARLY IDENTIFY POINT TO POINT INFORMATION FOR A COMPLETE SYSTEM.
- 9. PROVIDE WIRE MANAGEMENT SYSTEMS ABOVE AND BELOW EACH PATCH PANEL.
- 10. PROVIDE BONDING AND GROUNDING PER 16716—2.13 GROUND & 2.14 TELECOMMUNICATIONS BONDING BACKBONE.

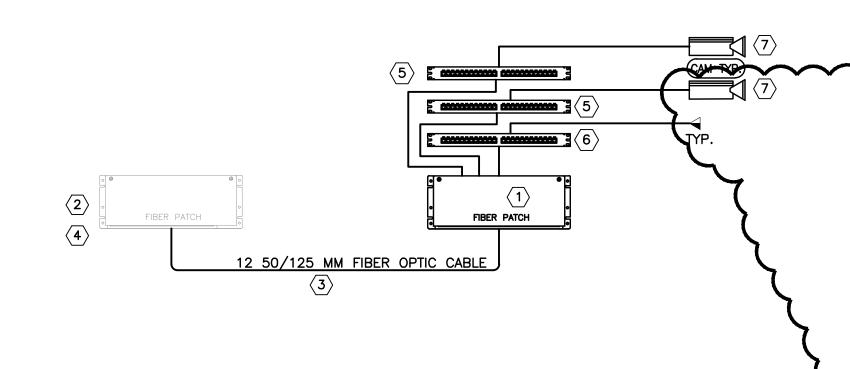




- PROVIDE 24 STRAND FIBER OPTIC PATCH PANEL WITH SPLICE TRAYS & TYPE 'SC'
 CONNECTORS, PROVIDE 24 TWO FILLONG FIBER CROSS PATCH_CORDS.
- CONNECTORS. PROVIDE 24 TWO FT LONG FIBER CROSS PATCH CORDS.

 (2) EXISTING F.O. PATCH PANEL IN TERMINAL BUILDING MDF. PROVIDE DUAL PATCH CONNECTIONS TO NETWORK CORE SWITCH.
- PROVIDE 24 STRAND 50 MICRON OM3 MM FIBER OPTIC CABLE FROM MDF F.O. PATCH PANEL TO GCTC. INSTALL IN CONDUIT ROUTE IN CEILING UNDER TERMINAL MEZZANINE, TO UNDERSIDE OF SKYWALK, TO PARKING STRUCTURE GCTC. PROVIDE 3M MAXCELL INNER DUCT IN CONDUIT.
- EXISTING FIBER OPTIC PATCH PANEL W/ SPLICE TRAYS & TYPE 'SC' CONNECTION IN
- 24 PORT NETWORK SWITCH W/ POE AND 1 GIG UPLINK. SWITCH SHALL BE COMNET CNGE2FE24MSPoE OR APPROVED EQUAL. SWITCH IS DEDICATED FOR CCTV USE ONLY. PROVIDE F.O. PATCH CONNECTION TO MDF CCTV SERVER. THIS PART OF WORK SHALL BE BID SEPARATELY UNDER ALTERNATE #8
- 6 24 PORT NETWORK SWITCH W/ 1 GIG UPLINK. SWITCH SHALL BE COMNET CNGE2FE24MS OR APPROVED EQUAL. SWITCH IS DEDICATED FOR COMMUNICATION USE ONLY.
- PROVIDE CCTV CAMERA. CAMERA SHALL BE ARECONT MV1355DN, IQINVISION ALLIANCE 1QA21, AXIS P3344-V OR APPROVED EQUAL WITH DAY/NIGHT (0.5 LUX OR LESS MIN), FIXED DOME 1.3 MEGAPIXEL (MIN), PROGRESIVE SCAN, 2.8-12MM OR EQUIVALENT, H264/MJPEG ENCODING MULTI-STREAM CAMERA. PROVIDE WEATHER/VANDAL PROOF ENCLOSURE WITH HEATER AND FAN. ALL THE WORK INCLUDING CCTV INSTALLATION, CONNECTION ETC. SHALL BE BID SEPARATELY UNDER ALTERNATE #8.



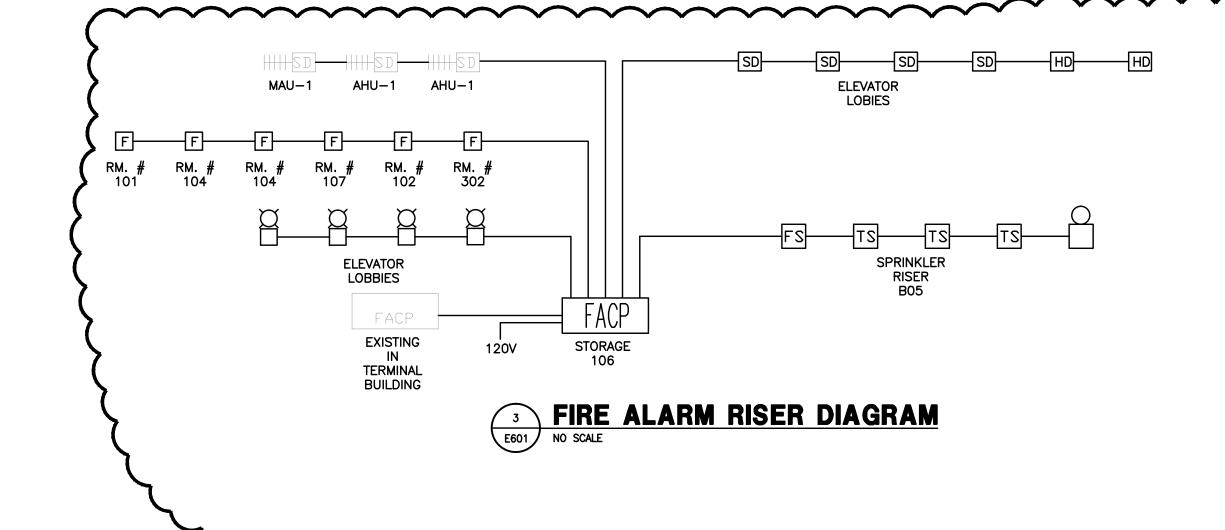

FIRE ALARM NOTES:

- 1. ALL DEVICES AND EQUIPMENT SHOWN SHALL BE NEW AND UL LISTED. SYSTEM AND WIRING SHALL COMPLY WITH NFPA 72. WIRING AND NUMBER OF DEVICES ON A CIRCUIT SHALL COMPLY WITH MANUFACTURER'S RECOMMENDATIONS.
- 2. PROVIDE WATER FLOW SWITCH, ALARM BELL, AND VALVE TAMPER SWITCHES WIRING TO NEW FACP FROM EACH
- 3. SMOKE DETECTORS SHALL BE LOCATED NO LESS THAN 5 FEET FROM ANY DIFFUSER.
- 4. MANUAL PULL STATIONS SHALL BE MOUNTED AT 46" AFF TO CENTERLINE.
- 5. AUDIBLE NOTIFICATION SPEAKERS SHALL COMPLY WITH UL 1480 AND BE MOUNTED 96" AFF TO BOTTOM OF DEVICE, BUT NOT CLOSER THAN 6" BETWEEN TOP OF DEVICE AND CEILING.
- 6. VISUAL NOTIFICATION DEVICES—COMPLY WITH UL1971. LIGHT SOURCE TO BE MOUNTED 80" AFF OR 6" BELOW THE CEILING, WHICHEVER IS LOWER. STROBES TO BE SYNCHRONIZED BY CIRCUIT AND AREA.
- 7. COMBINATION NOTIFICATION DEVICES SHALL BE MOUNTED WITH BOTTOM OF UNIT AT 80" AFF
- 8. ALL CONTROL PANELS SHALL BE 36" AFF TO BOTTOM OF PANEL AND SHALL BE NO HIGHER THAN 78" AFF TO TOP OF PANEL.
- 9. ALL DEVICE BOXES SHALL BE RECESSED IN WALL OR CEILING WHEN POSSIBLE. AVOID CONFLICTS WITH LIGHT FIXTURES, DIFFUSERS, GRILLS, DUCTS, PIPING, STRUCTURAL MEMBERS, AND OTHER OBSTRUCTIONS.
- 10. ALL FIRE ALARM WIRING SHALL BE IN SEPARATE CONDUIT. CONDUIT SHALL BE MARKED WITH RED BAND EVERY 20'. PULL BOXES SHALL HAVE RED COVERS.



Reynolds, Smith and Hills, Inc.

4525 Airport Approach Rd, Ste A
Duluth, Minnesota 55811

218-722-1227 Fax: 218-722-1052
www.rsandh.com



DULUTH
INTERNATIONAL
AIRPORT
DULUTH, MN

AUTHORITY

NEW PARKING
STRUCTURE
AND EXTERIOR
WAYFINDING SIGNAGE

CONSULTANTS

Interior Architects:
TKDA ARCHITECTS

11 E Superior Street Suite 340, Duluth MN 55802 TEL: (218) 724-8578 / FAX: (218) 724-8717

Structural Engineers:

MEYER BORGMAN JOHNSON

501 Lake Avenue South, Suite 300, Duluth MN 55802

Landscape Architects:
ARCHITECTURAL RESOURCES

126 East Superior Street, Duluth MN 55802 TEL: (218) 727-8481 / FAX: (218) 727-8483

TEL: (218) 722-1056 / FAX: (218) 722-9306

REVISIONS			
NO.	DESCRIPTION	DATE	
1	ADDENDUM 2	5-31-13	

DATE ISSUED: 05/15/2013
REVIEWED BY: BA
DRAWN BY: RJL

DESIGNED BY: RJL

AEP PROJECT NUMBER

213-1882-114© 2013 REYNOLDS, SMITH AND HILLS INC.

SHEET TITLE
ELECTRICAL
AND
COMMUNICATION
RISER
DIAGRAMS

SHEET NUMBER

E601

				MAIN SIZE & TYPE CABINET SOA MCB SURFACE		MIN FED FF 65 KAIC UTLITY		OM NC 10)		
RCUIT			AREA SERVED	PHA	PHASE LOAD VA A B C		AREA SE	RVED	NO.	TRIP	CIRCUIT NO
NO				Α					POLES	AMPS	
1	20			3340							
				9060						100	2
3	20 3		UH-1 & UH-2		334	0					
	5 20				906	0	P1MA	,	3	100	4
5						3340					
						9060				100	6
7	25			5000							
				8857						40	8
9	25	3	UH-3, UH-4, UH-	-5	500	0	RTU-1			40	
					885	7			3		10
11	25					5000					
						8857				40	12
13	60			7480							
				3880						25	14
15	60	3	ELEVATOR		748	0					
					388	0	MAU-1		3	25	16
17	60					7480					
						3880				25	18
19	20			0							
				8730						25	20
21	20	3	SPARE		0						
					873	0	EF-1, EF-2		3	25	22
23	20					0					
						8730				25	24
25	60			11160							
				2100						20	26
27	60	3	P1LA (VIA TIL		111	60					
					210	0	EF-3, E	F-4	3	20	28
29	60					11160					
						2100				20	30
31	20			0							
				0						20	32
33	20	1	SPARE		0						
					0		SPARI	Ξ	3	20	34
35 20						0					
						0				20	36
37	20	1		0							
				0			_			20	38
39	20	1			0						
					0		SPACI	Ξ	3	20	40
41	20	1				0					
						0				20	42

VOLTS /	PHASE/W	IRE PA	Electr NEL SIZE & TYPE MAIN SI			BINET	MIN	FED FROM		NOTES	
208/3/	4	22	5 A 125A M				22 KAIC	A	100% GND	00% GND	
NO NO	TRIP AMPS	NO. POLES	AREA SERVED	A PHAS	SE LOAD	C	AREA SE	NO. POLE	TRIP S AMPS	CIRCUIT NO	
1	20	1	RCPT'S LOWER LEVEL	780							
•	1 20 1		NOTE OF LOWER LEVEL	1200			MAINT. DOOR CNTRL PW		1	20	2
3	3 20 1		RCPT'S LOWER LEVEL		900			<u> </u>		_	
			ELEV. AREA		1200				1	20	4
5	20	1	RCP'T 1ST FLOOR			1080	PUBLIC GATE				
						1200			1	20	6
7	20	1	1ST FLOOR FUTURE FIDS	320 1200						20	8
9	20	1	RCPT'S 1ST FLOOR	1200	900		-		_		
4.4		4	DODT'O 40T 5100D		1200		OHD POWER		3	20	10
11	20	1	RCPT'S 1ST FLOOR			900	_				
4 -	00	4	DODT'S 4ST 51SS	000		1200				20	12
13	20	1	RCPT'S 1ST FLOOR	900					•		
4.5	00	4	OND FLOOD FUTURE FIRE	1800			ELEV LOBBY AUTO DOOR ELEV LBY DOOR 2ND,3RD		1	20	14
15	20	1	2ND FLOOR FUTURE FIDS		900						4.0
47	00	4	DODT'S OND LODGY A		1200	4000			1	20	16
17	20 1		RCPT'S 2ND LOBBY & 3RD FLOOR			1080	GCTC POWER				4.0
10	20	1	RCPT'S 2ND FLOOR	1080		1800	GCIC PO	WLK	1	20	18
19	20	I	NOFI 3 ZND FLOUR	1200			SKYWALK AUT	DUUBS	1	20	20
21	1 20 1		3RD FLOOR FUTURE FIDS	1200	360		SKIWALK AUT	CAUUU	'	20	20
- '	_0	•			180		RTU RCPT.		1	20	22
23	20				, 55	1081	KIU KU	Г1.		20	
	_0					1081	2ND FL	EBH		20	24
25	20	2	1ST FL EBH	1081		1001			2		_ '
				1081						20	26
27	20				610						
					1237		3RD FL	EBH		20	28
29	20	2	LOWER FL. EBH		1207	610			2		
						1237	-			20	30
31	20			0		,					
				960			ELEVATOR DS		1	20	32
33	20	3	SPARE		0		SP-1				
					960				1	20	34
35	20					0					
						960	SP-2		1	20	36
37	20	1	SPARE	0							*
				180			FACP		1	20	38
39	20	1	SPARE		0						*
			_		1650		FP COMPR	ESSOR	1	20	40
41	20	1	SPARE			0	_				
	~~	~~	~~~~				SPARI	~~	~}	~20	48
43	20	1	SPACE	0				_			
4.5			CDAOE	0			SPACI	=	1	20	44
45	20	1	SPACE		0		02:07	_			
47		4	CDACE		0		SPACE	_	1	20	46
47	20	1	SPACE			0	00.00	_	4		40
40	00	4	SPACE			0	SPACI	<u>-</u>	1	20	48
49	20	1	STAUL	0			CDAC	_	4	00	E0
E 1	20	4	SPACE	0			SPACI	_	1	20	50
51	20	1	SPAUL		0		0040	_	4	00	50
53	20	1	SPACE		0		SPACI	_	1	20	52
၁၁	20	I	SFACE			0	CDAO	<u>-</u>	4	20	E 4
			CONNECTED LOAD	11600	9650	0 12230	SPACI = 33480 VA	_	1	20	54
			CUNNECTED LUAD	LIDUU	400U	1775()	3.346U VA				

VOLTS/F 480/3/	PHASE/WIRE PANEL SIZE & TYPE MAIN S 125 A 100A M		AIN SIZE & OOA MCB				MIN 35 KAIC	FED FROM P1QA				
CIRCUIT	TRIP	NO. POLES	AREA SERVED	Р	HASE	LOAD	VA	AREA SE	RVED	NO. POLES	TRIP	CIRC
NO	AMPS	PULES	,	Α		В	С			PULES	AMPS	NC
1	20	1	LTG GARAGE MAINT. RENTAL CAR AREA)			SPARI	E	1	20	2
3	20	1	LTG GARAGE PUBL PARKING 1ST & 21		4(025		SPARI	E	1	20	4
5	20	1	LTG ACCENT NE				3960	_			20	
7	20	1	LTG ACCENT SW	3960)			SPARI	_	1	20	6
								SPARI	E	1	20	8
9	20	1	LTG ELEVATOR STAI LOBBY & SKYWAL		35	540		SPARI	E	1	20	10
11	20	1	3RD LEVEL GARAG & UNDER SKYWAL				2200	SPARI	F	1	20	1:
13	20	1	LTG BOLLARDS	2210)			-				
15	20	1	SPARE					SPARI		1	20	1.
		·						SPARI	E	1	20	1
17	20	1	SPARE					SPARI	E	1	20	1
19	20	1	SPARE					SPARI	E	1	20	2
21	20	1	SPARE							1	20	2
23	20	1	SPARE					SPARI				
25	20	1	SPARE					SPARI	_	1	20	2
				0							20	2
27	20	1	SPARE		0			SPARI	F	3	20	2
29	20	1	EMERGENCY LTG & E	EXIT.			3950		-			
							0	07170			20	3
			CONNECTED LOA	AD 9495	∍ 7 <u>5</u>	565	10110	= 27170				

* CLEARLY MARK CB "EMERGENCY-DO NOT TURN OFF"



Reynolds, Smith and Hills, Inc.

4525 Airport Approach Rd, Ste A
Duluth, Minnesota 55811

218-722-1227 Fax: 218-722-1052
www.rsandh.com



DULUTH
INTERNATIONAL
AIRPORT
DULUTH, MN

NEW PARKING STRUCTURE AND EXTERIOR WAYFINDING SIGNAGE

CONSULTANTS

Interior Architects: **TKDA ARCHITECTS**11 E Superior Street Suite 340, Duluth MN 55802

TEL: (218) 724-8578 / FAX: (218) 724-8717

Structural Engineers:

MEYER BORGMAN JOHNSON

501 Lake Avenue South, Suite 300, Duluth MN 55802

TEL: (218) 722-1056 / FAX: (218) 722-9306

Landscape Architects:

ARCHITECTURAL RESOURCES

126 East Superior Street, Duluth MN 55802
TEL: (218) 727-8481 / FAX: (218) 727-8483

REVISIONS

NO. DESCRIPTION DATE

DAT	E ISSUED: 05/15/2013	
1	ADDENDUM 2	5-31-13

REVIEWED BY: BA

DRAWN BY: RJL

DESIGNED BY: RJL

AEP PROJECT NUMBER

213-1882-114

© 2013 REYNOLDS, SMITH AND HILLS INC.

SHEET TITLE

ELECTRICAL PANEL SCHEDULES

SHEET NUMBER

E701

ISSUED FOR BID

Drawing: T:\P\2131882.114 Duluth Parking Structure\CAD\E\E600 Riseres .dwg Plotted on: 5/31/2013 9:35 AM Plotted by: Llazari, Rional