



CITY OF DULUTH
PURCHASING DIVISION
Room 120 City Hall
411 West First Street
Duluth, Minnesota 55802-1199
218/730-5340
purchasing@duluthmn.gov

Addendum 1
File # 19-16AA
RFP Eng Svcs L8514 Bridge Replacement, Project 1861

This addendum serves to notify all bidders of the following changes to the solicitation documents:

1. See attached Plan Sheet for St. Andrews Street from 2001. No work was done on Bridge L8514 with this project. Plans for the bridge are not available.
2. See attached GIS utilities map.

Please acknowledge receipt of this Addendum by returning it with your proposal. This page will not be included in the proposal page limitation.


Posted: **9/18/19**



ONLY TREES AND PLANTS NECESSARY FOR PROPOSED CONSTRUCTION SHALL BE REMOVED. THE ENGINEER WILL IDENTIFY SIGNIFICANT VEGETATION TO BE PROTECTED AND PRESERVED. ANY QUESTION REGARDING WHETHER TREES AND PLANTS SHOULD REMAIN, SHALL BE BROUGHT TO THE ATTENTION OF THE ENGINEER BEFORE REMOVAL. ANY DAMAGE TO TREES OR PLANTS THAT NECESSITATES THEIR REMOVAL WILL BE REMOVED AND REPLACED AT 2:1 AT THE CONTRACTOR'S EXPENSE.

PATRICIA A SCHULER TAYLOR
3122 WEST GATE DR
FARGO, ND 58103
1850-00270


NE 22
BULKHEAD EXISTING
SANITARY
STA 5+45.1
RELOCATE POWER POLE
(BY OTHERS)

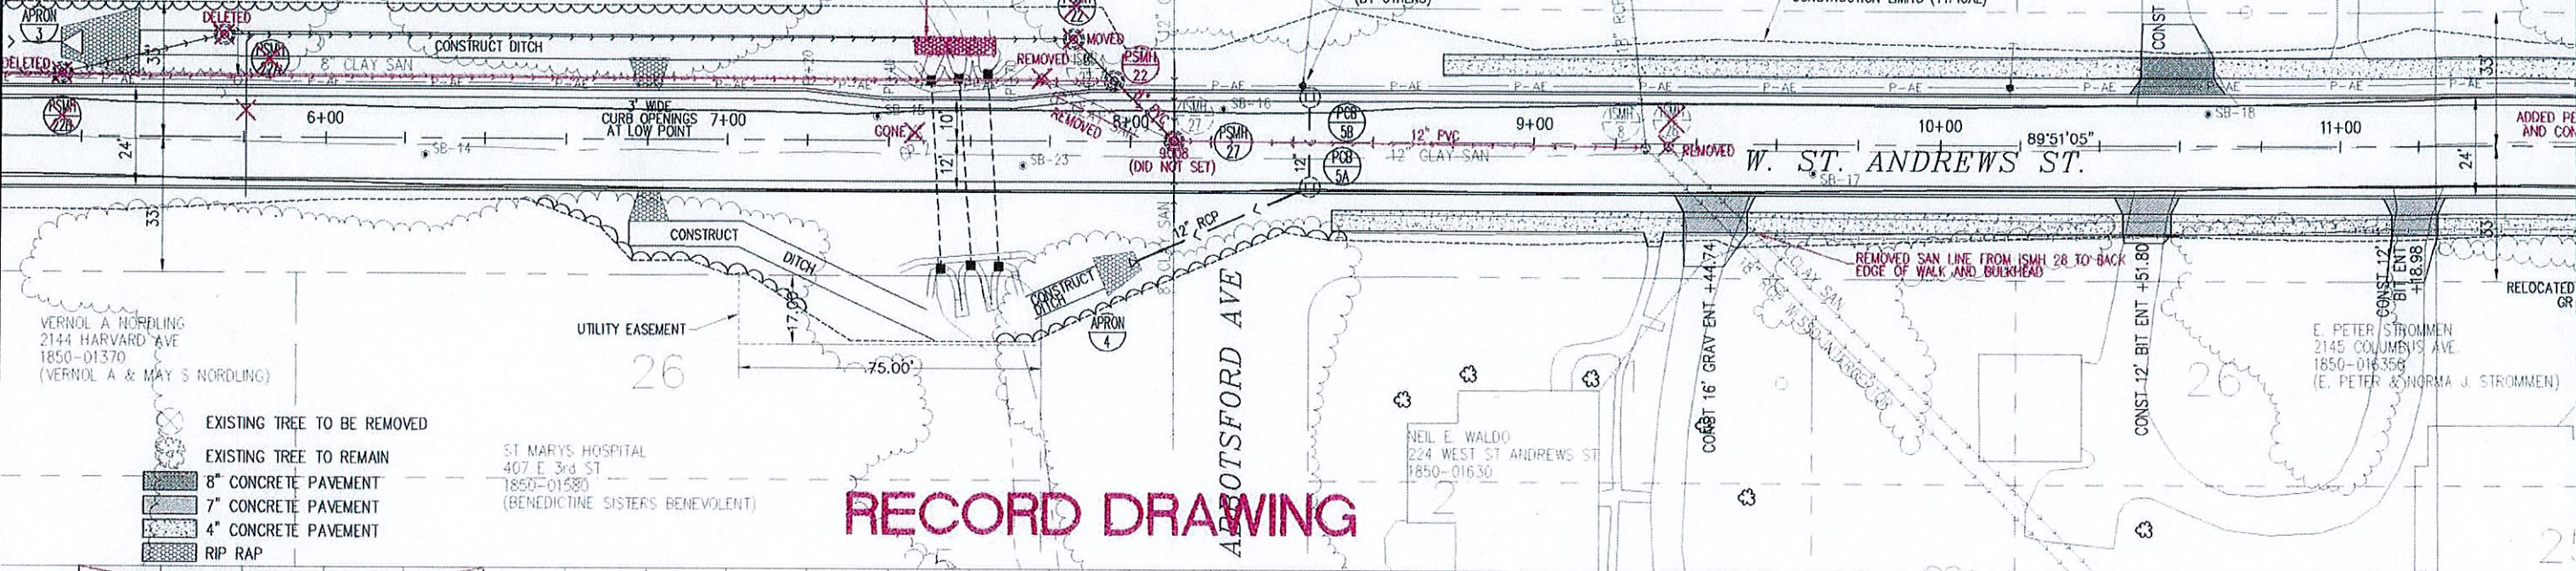

- EXISTING TREE TO BE REMOVED
- EXISTING TREE TO REMAIN
- 8" CONCRETE PAVEMENT
- 7" CONCRETE PAVEMENT
- 4" CONCRETE PAVEMENT
- RIP RAP

ST MARY'S HOSPITAL
407 E 3rd ST
1850-01580
(BENEDICTINE SISTERS BENEVOLENT)

RECORD DRAWING

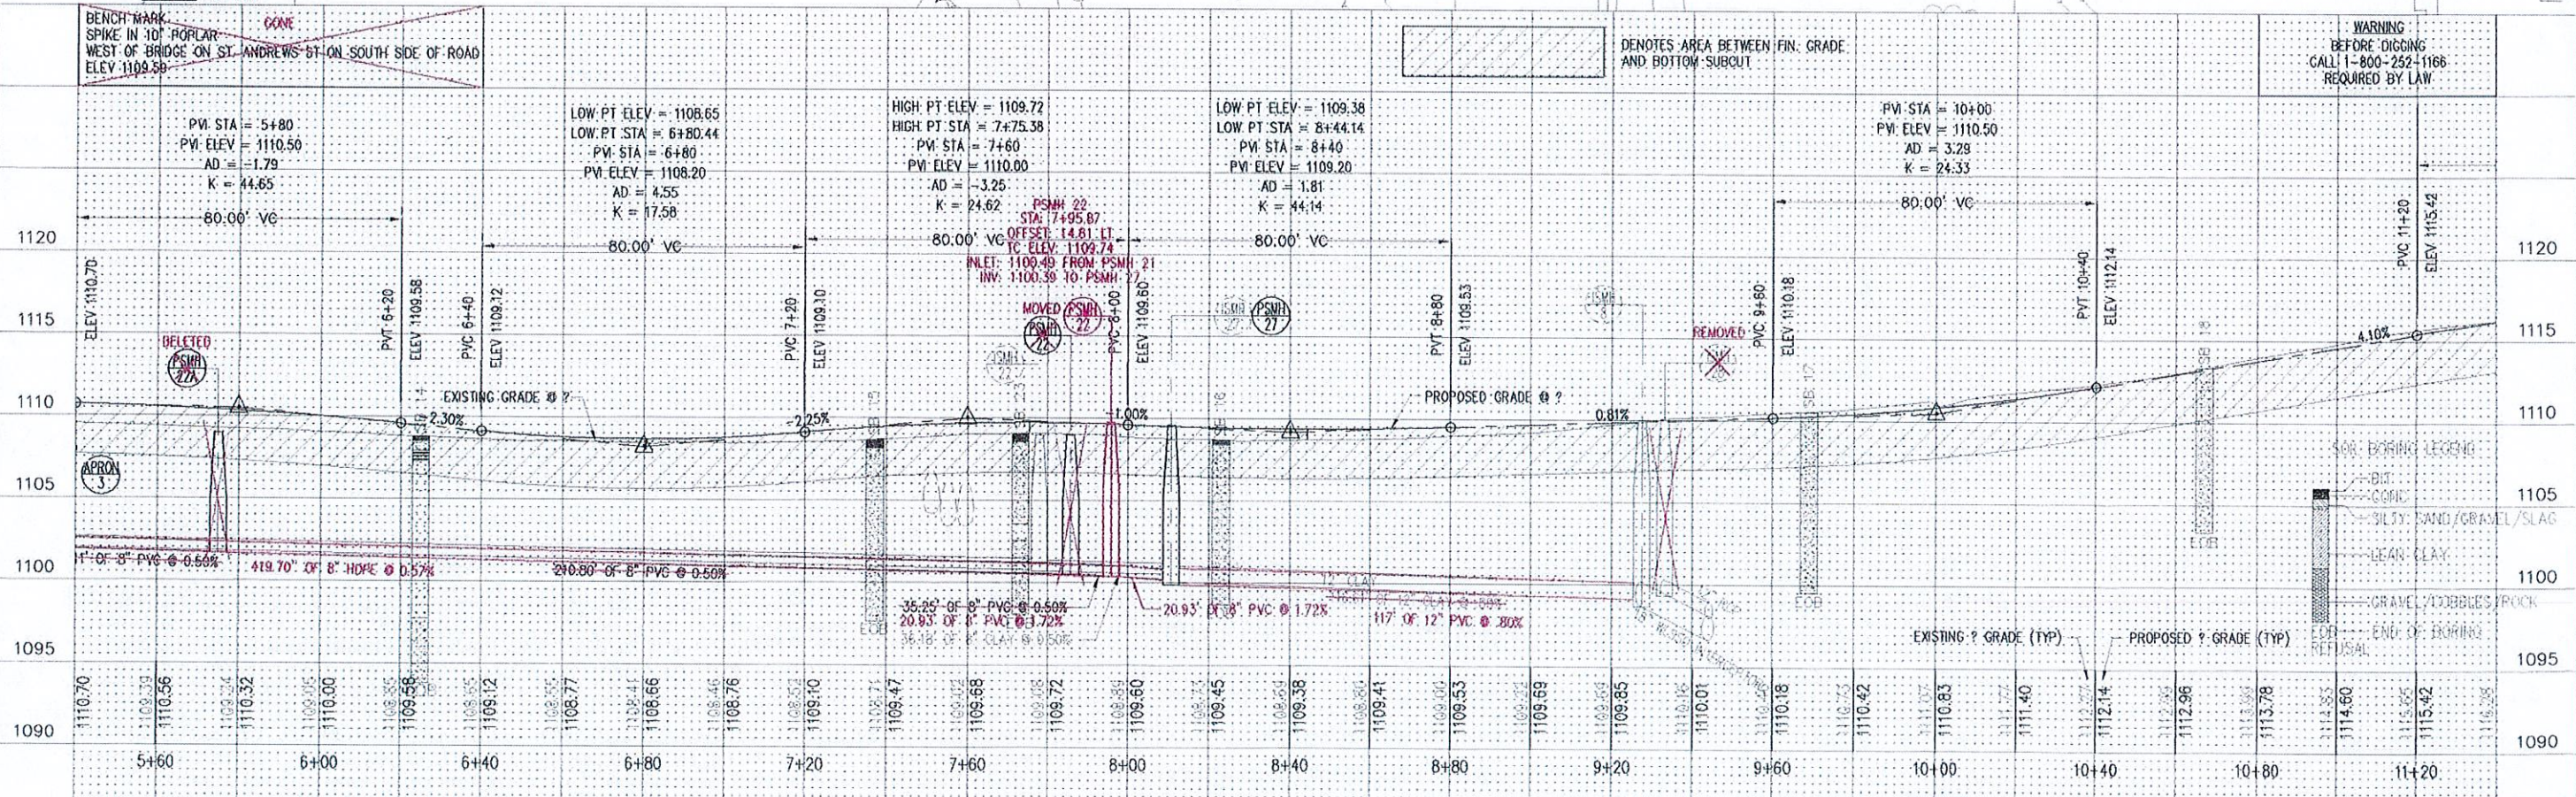

ST ANDREWS ST (2 OF 4)

PLAN AND PROFILE

CERTIFIED BY _____ LIC. No. _____ DATE _____ 2001

DULUTH PROJ No. 9062RS01/9062XB01

SHEET No. 18 OF 61 SHEETS