


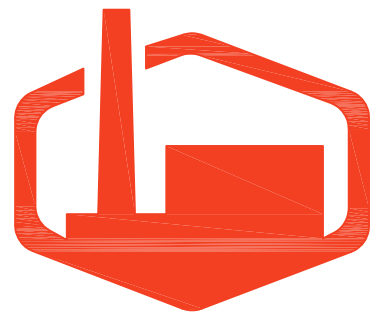

**DULUTH ENERGY
SYSTEMS**

ONE LAKE PLACE DRIVE
DULUTH, MN 55802-1189

BURNER MANAGEMENT SYSTEM DULUTH STEAM BOILER #3

REV A

JOB# 424997

CONTROL SYSTEM DESIGNED AND BUILT BY



Building on Promises Kept
mechanical • electrical • systems

7625 Boone Avenue North | Brooklyn Park, MN 55428 | p: 763.544.4131 | f: 763.595.4380 | www.eganco.com

D:\District Energy\Duluth Fireye Panels\Boiler 3\Drawings\424997-3_100IDX.dwg 11/14/2016 2:09:58 PM

LIST OF DRAWINGS		
SHT	REVISION	DRAWING DESCRIPTIONS
01	A	ELECTRICAL SCHEMATIC
02	A	ELECTRICAL SCHEMATIC
03	A	ELECTRICAL SCHEMATIC
04	A	ELECTRICAL SCHEMATIC
05	A	SAFETY CIRCUIT SCHEMATIC
06	A	SAFETY CIRCUIT SCHEMATIC & PLC IO MODULE
07	A	PLC IO MODULES
08	A	ELECTRICAL SCHEMATIC
09	A	CONTROL PANEL LAYOUT
10	A	BACKPANEL LAYOUT
11	A	PANELVIEW ENCLOSURE

SYMBOL LEGEND	
■	FIELD
▲	FUEL TRAIN
M	MOTOR CONTROL
B	BMS PANEL
R	REMOTE PANEL
⊙	TERMINAL
◇	REFERENCE TO EXPANSION MODULE
----	FIELD WIRING
*	WIRING BY FIELD ELECTRICAL CONTRACTOR

THIS DRAWING HAS BEEN UPDATED FOR DULUTH ENERGY FROM VENDOR PRINTS & DOES NOT NECESSARILY CONFORM TO EGAN CO. DRAFTING CODES & STANDARDS.

LEGEND	
—————	PANEL WIRING
-----	FIELD WIRING
⊗	PANEL TERMINAL
⊠	FIELD DEVICE TERMINAL



Dwg#: 424997 Egan #: 424997
Voltage 120V Ph: 1 Hz: 60
Total FLA: 8.8
Largest Motor FLA: N/A
SCCR: 5 KA
Enclosure type: 12

Enclosure openings must be filled by equipment marked with the same Type rating as enclosure. Use 75° deg. C copper wire minimum.

Fuse Chart:	
DESCRIPTION	AMPERAGE (A.)
105F	2A
106F	6A
702F	3A
803F	2A
806F	6A



© EGAN COMPANY 2016
THIS DRAWING AND ITS CONTENTS ARE THE CONFIDENTIAL PROPERTY OF EGAN COMPANY. NEITHER THIS DRAWING, ITS CONTENTS NOR ITS DESIGN CONCEPTS MAY BE USED WITHOUT THE WRITTEN CONSENT OF EGAN COMPANY.




DULUTH ENERGY
SYSTEMS


ONE LAKE PLACE DRIVE
DULUTH, MN 55802-1189



INDEX SHEET		MAIN PANEL	JOB NO. : 424997	
			DRAWN BY : MDT	
BURNER MANAGEMENT SYSTEM			APPROVED : M. THOMAS	
DULUTH STEAM BOILER #3				
REV				
A				

DWG. NO.
424997-3_100IDX
SHEET NO.
00

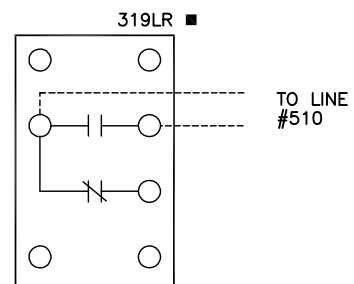



ALWC-301.5
AUX LOW WATER CUTOUT RELAY
509

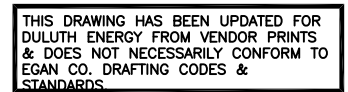

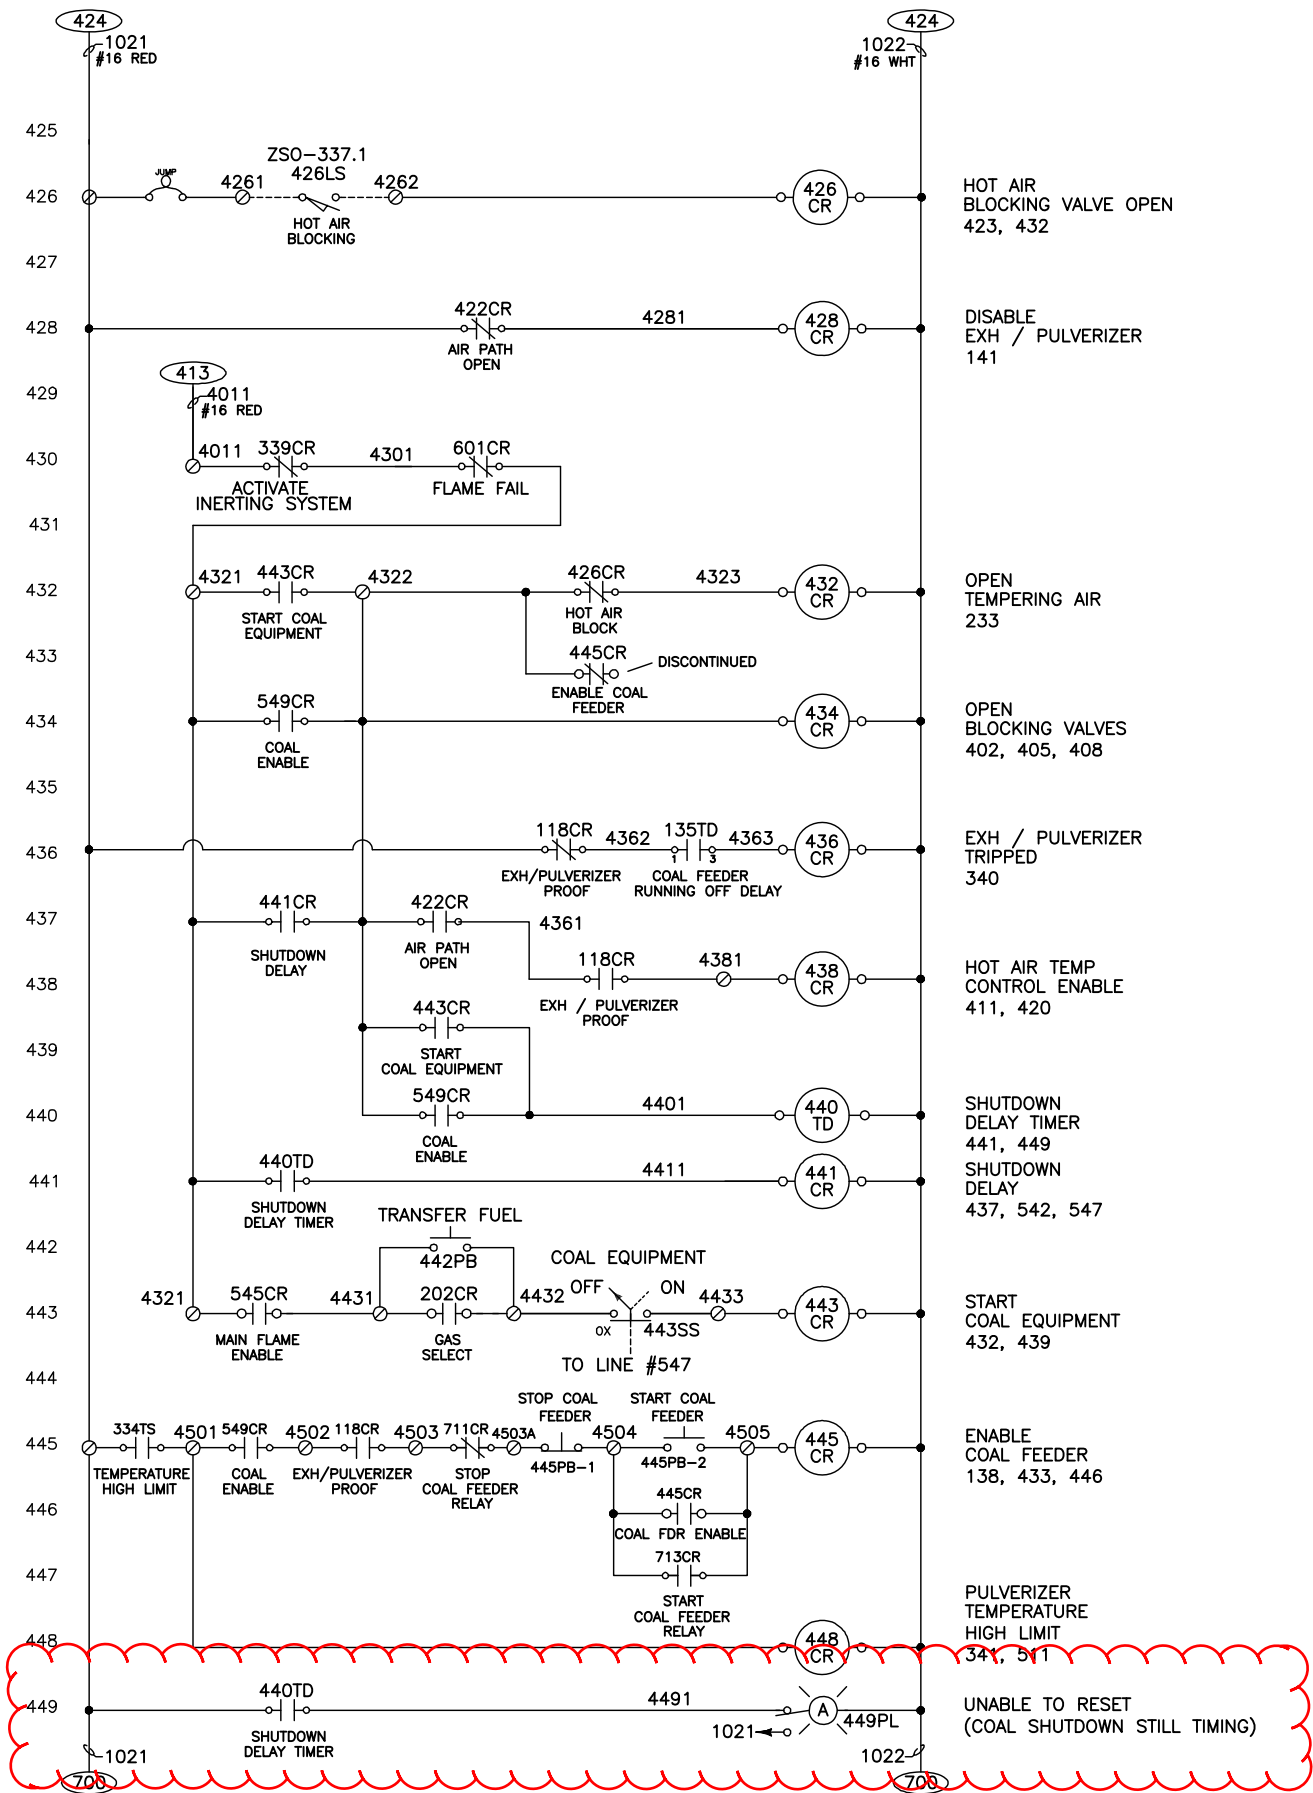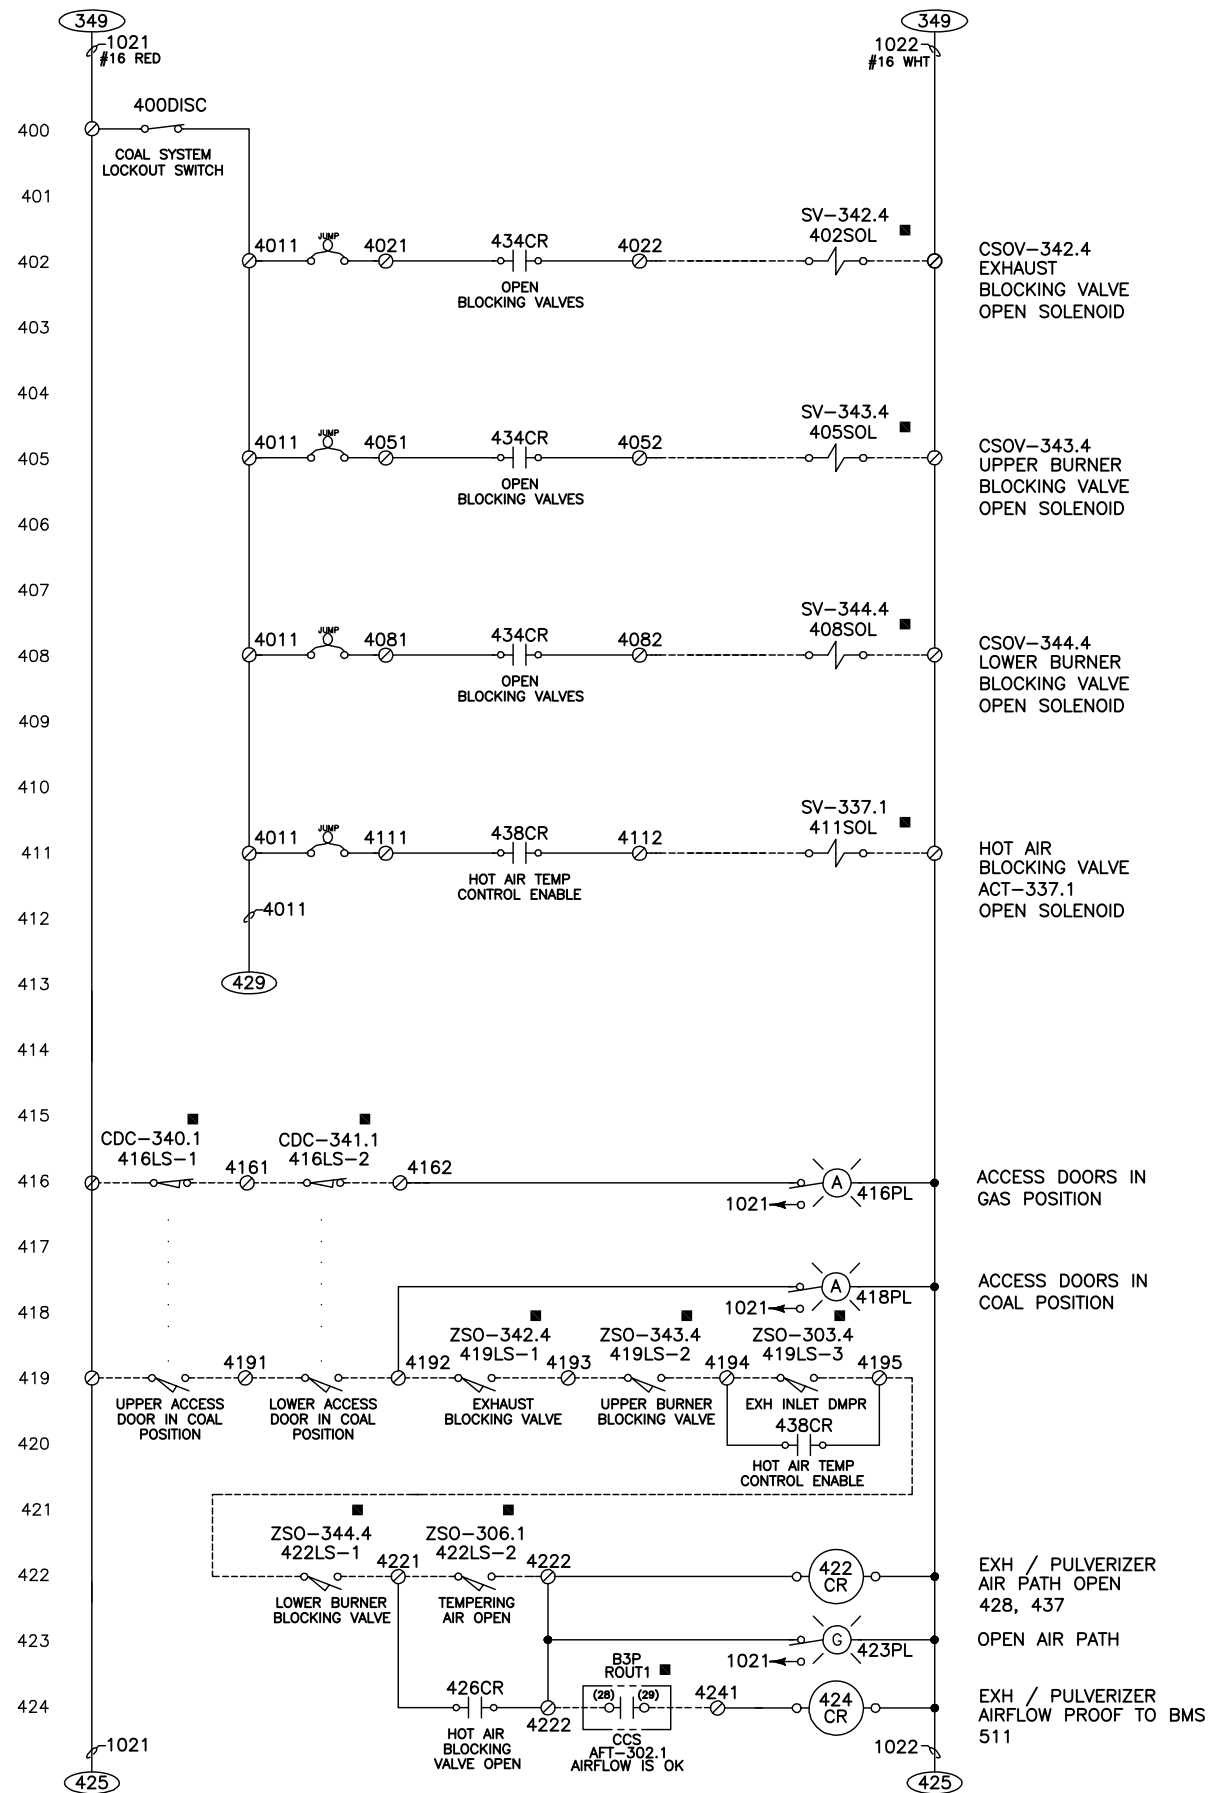

THIS DRAWING HAS BEEN UPDATED FOR
DULUTH ENERGY FROM VENDOR PRINTS
& DOES NOT NECESSARILY CONFORM TO
EGAN CO. DRAFTING CODES &
STANDARDS.

D:\District Energy\Duluth Fireye Panels\424997-3_05.dwg 1/19/2017 8:00:51 PM

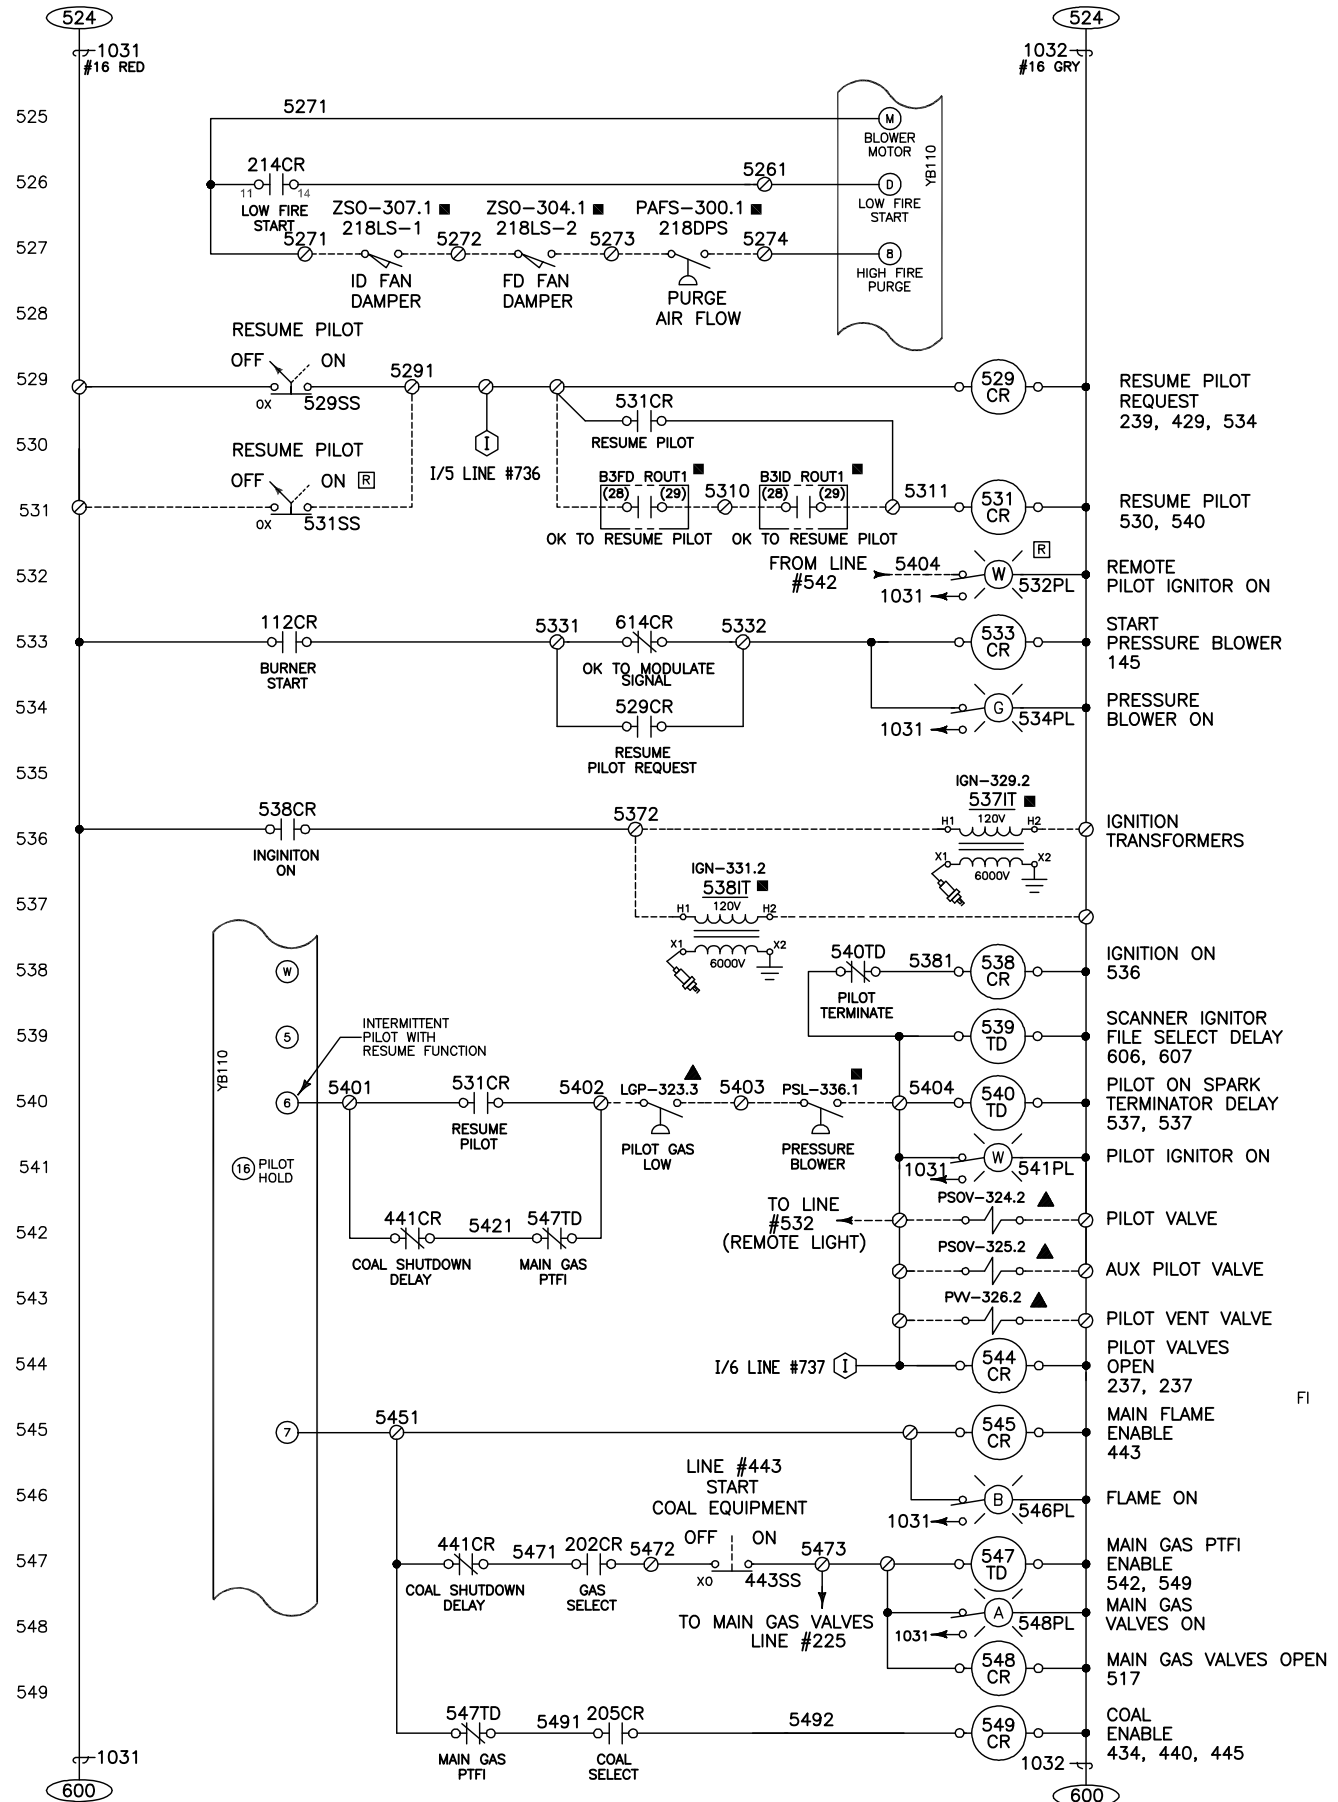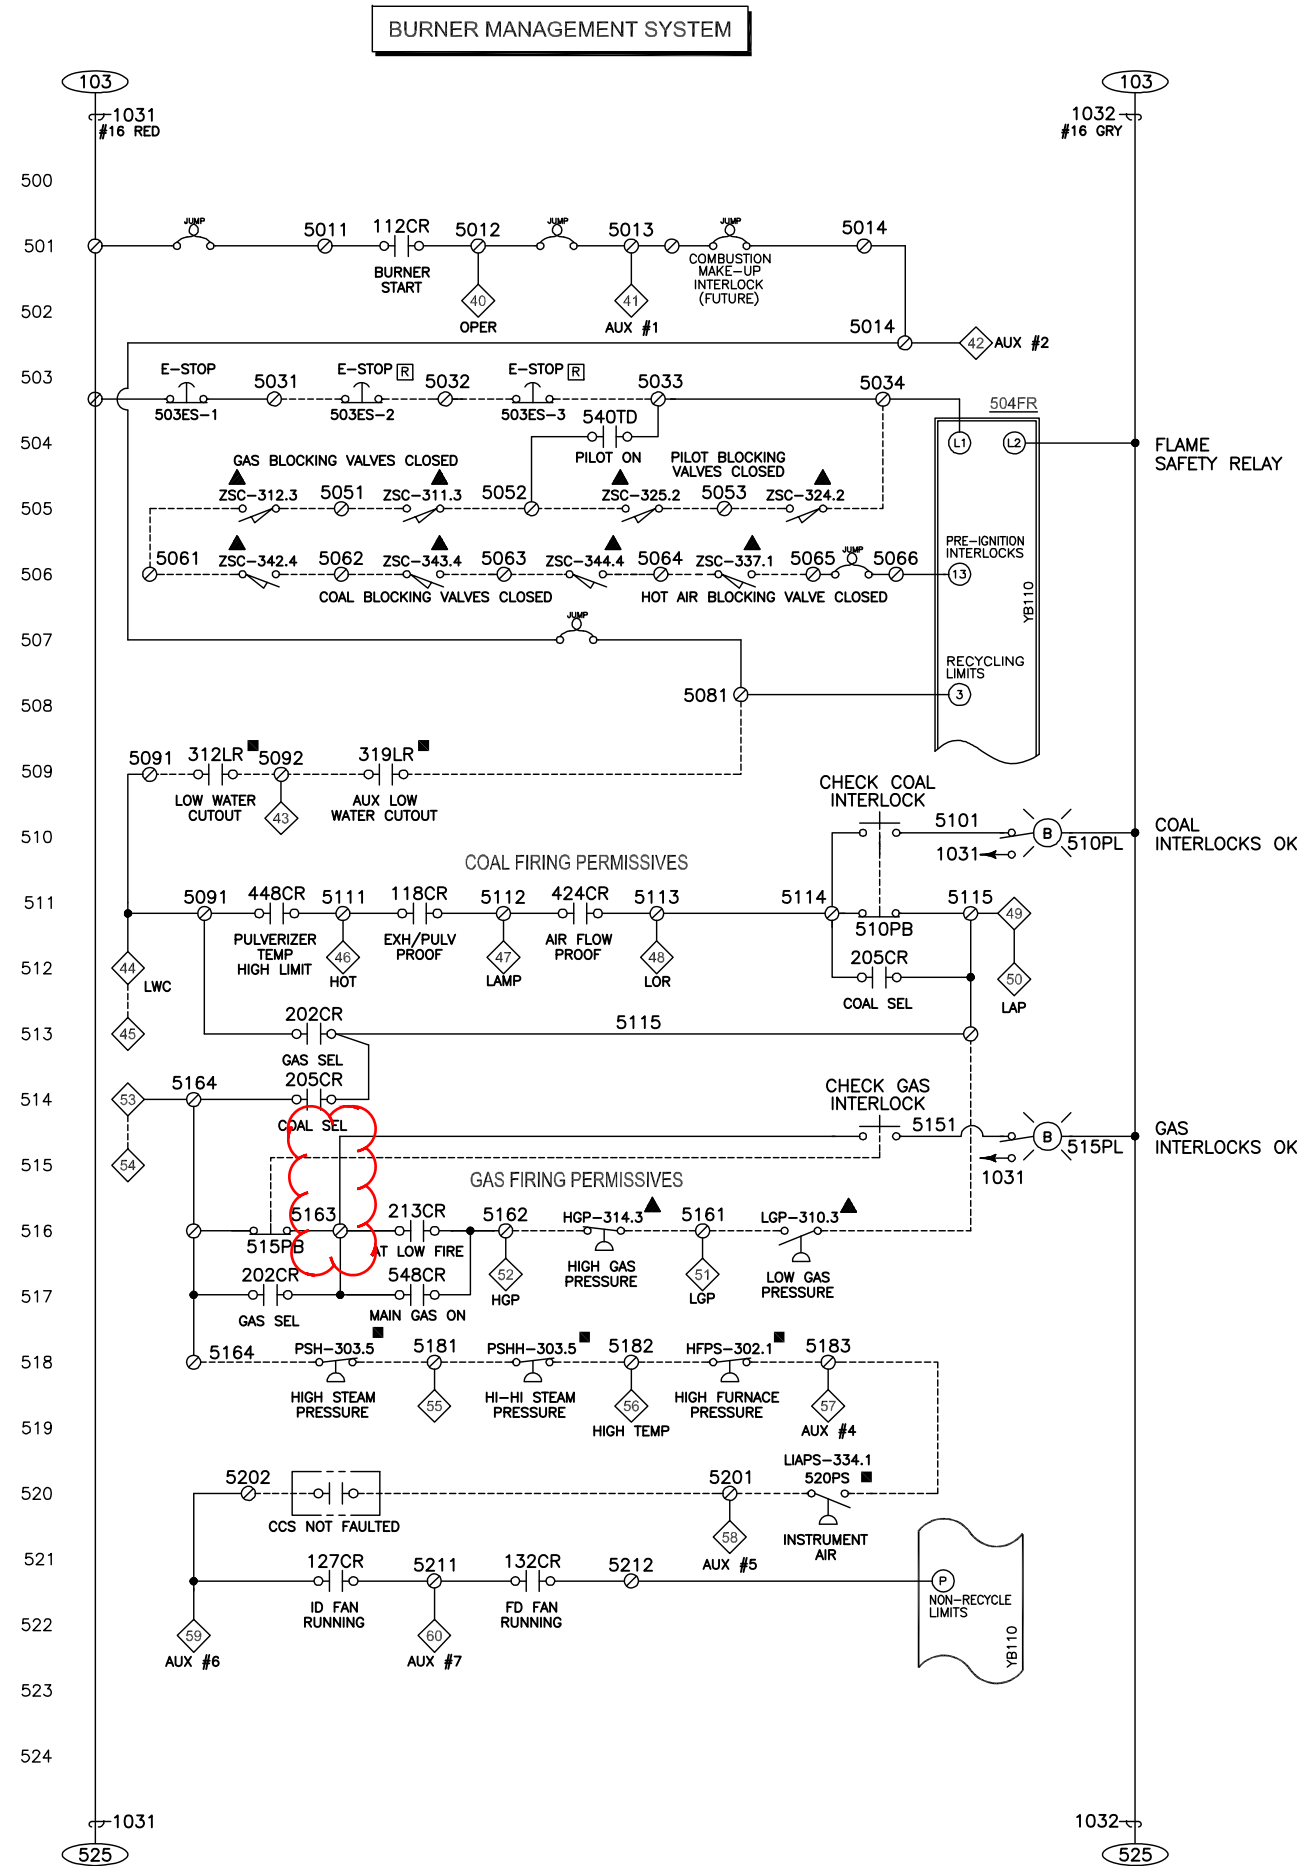

THIS DRAWING HAS BEEN UPDATED FOR
DULUTH ENERGY FROM VENDOR PRINTS
& DOES NOT NECESSARILY CONFORM TO
EGAN CO. DRAFTING CODES &
STANDARDS



Building on Promises Kept
mechanical • electrical • systems

EGAN COMPANY 2016
THIS DRAWING AND ITS
CONTENTS ARE THE
CONFIDENTIAL PROPERTY
OF EGAN COMPANY.
NEITHER THIS DRAWING,
ITS CONTENTS NOR ITS
DESIGN CONCEPTS MAY
BE USED WITHOUT THE
WRITTEN CONSENT OF
EGAN COMPANY.

**DULUTH ENERGY
SYSTEMS**




ONE LAKE PLACE DRIVE
DULUTH, MN 55802-1189
p: 763.544.4131 | f: 763.595.4380 | www.eganco.com

JOB NO.: 424997
DRAWN BY: MDT
APPROVED: M. THOMAS

REV	DESCRIPTION	DATE	APPROVED
C	PUSHBUTTON WIRE MOVED TO 5163	01/19/17	MDT
B	ASBUILT	01/04/17	MDT
A	BURNER PANEL UPGRADE	11/14/16	MDT
REV	DESCRIPTION	DATE	APPROVED

DWG. NO.
424997-3_05
SHEET NO.
05

D:\District Energy\Duluth Fireye Panels\Boiler 3\Drawings\424997-3_06.dwg 1/4/2017 10:34:38 AM

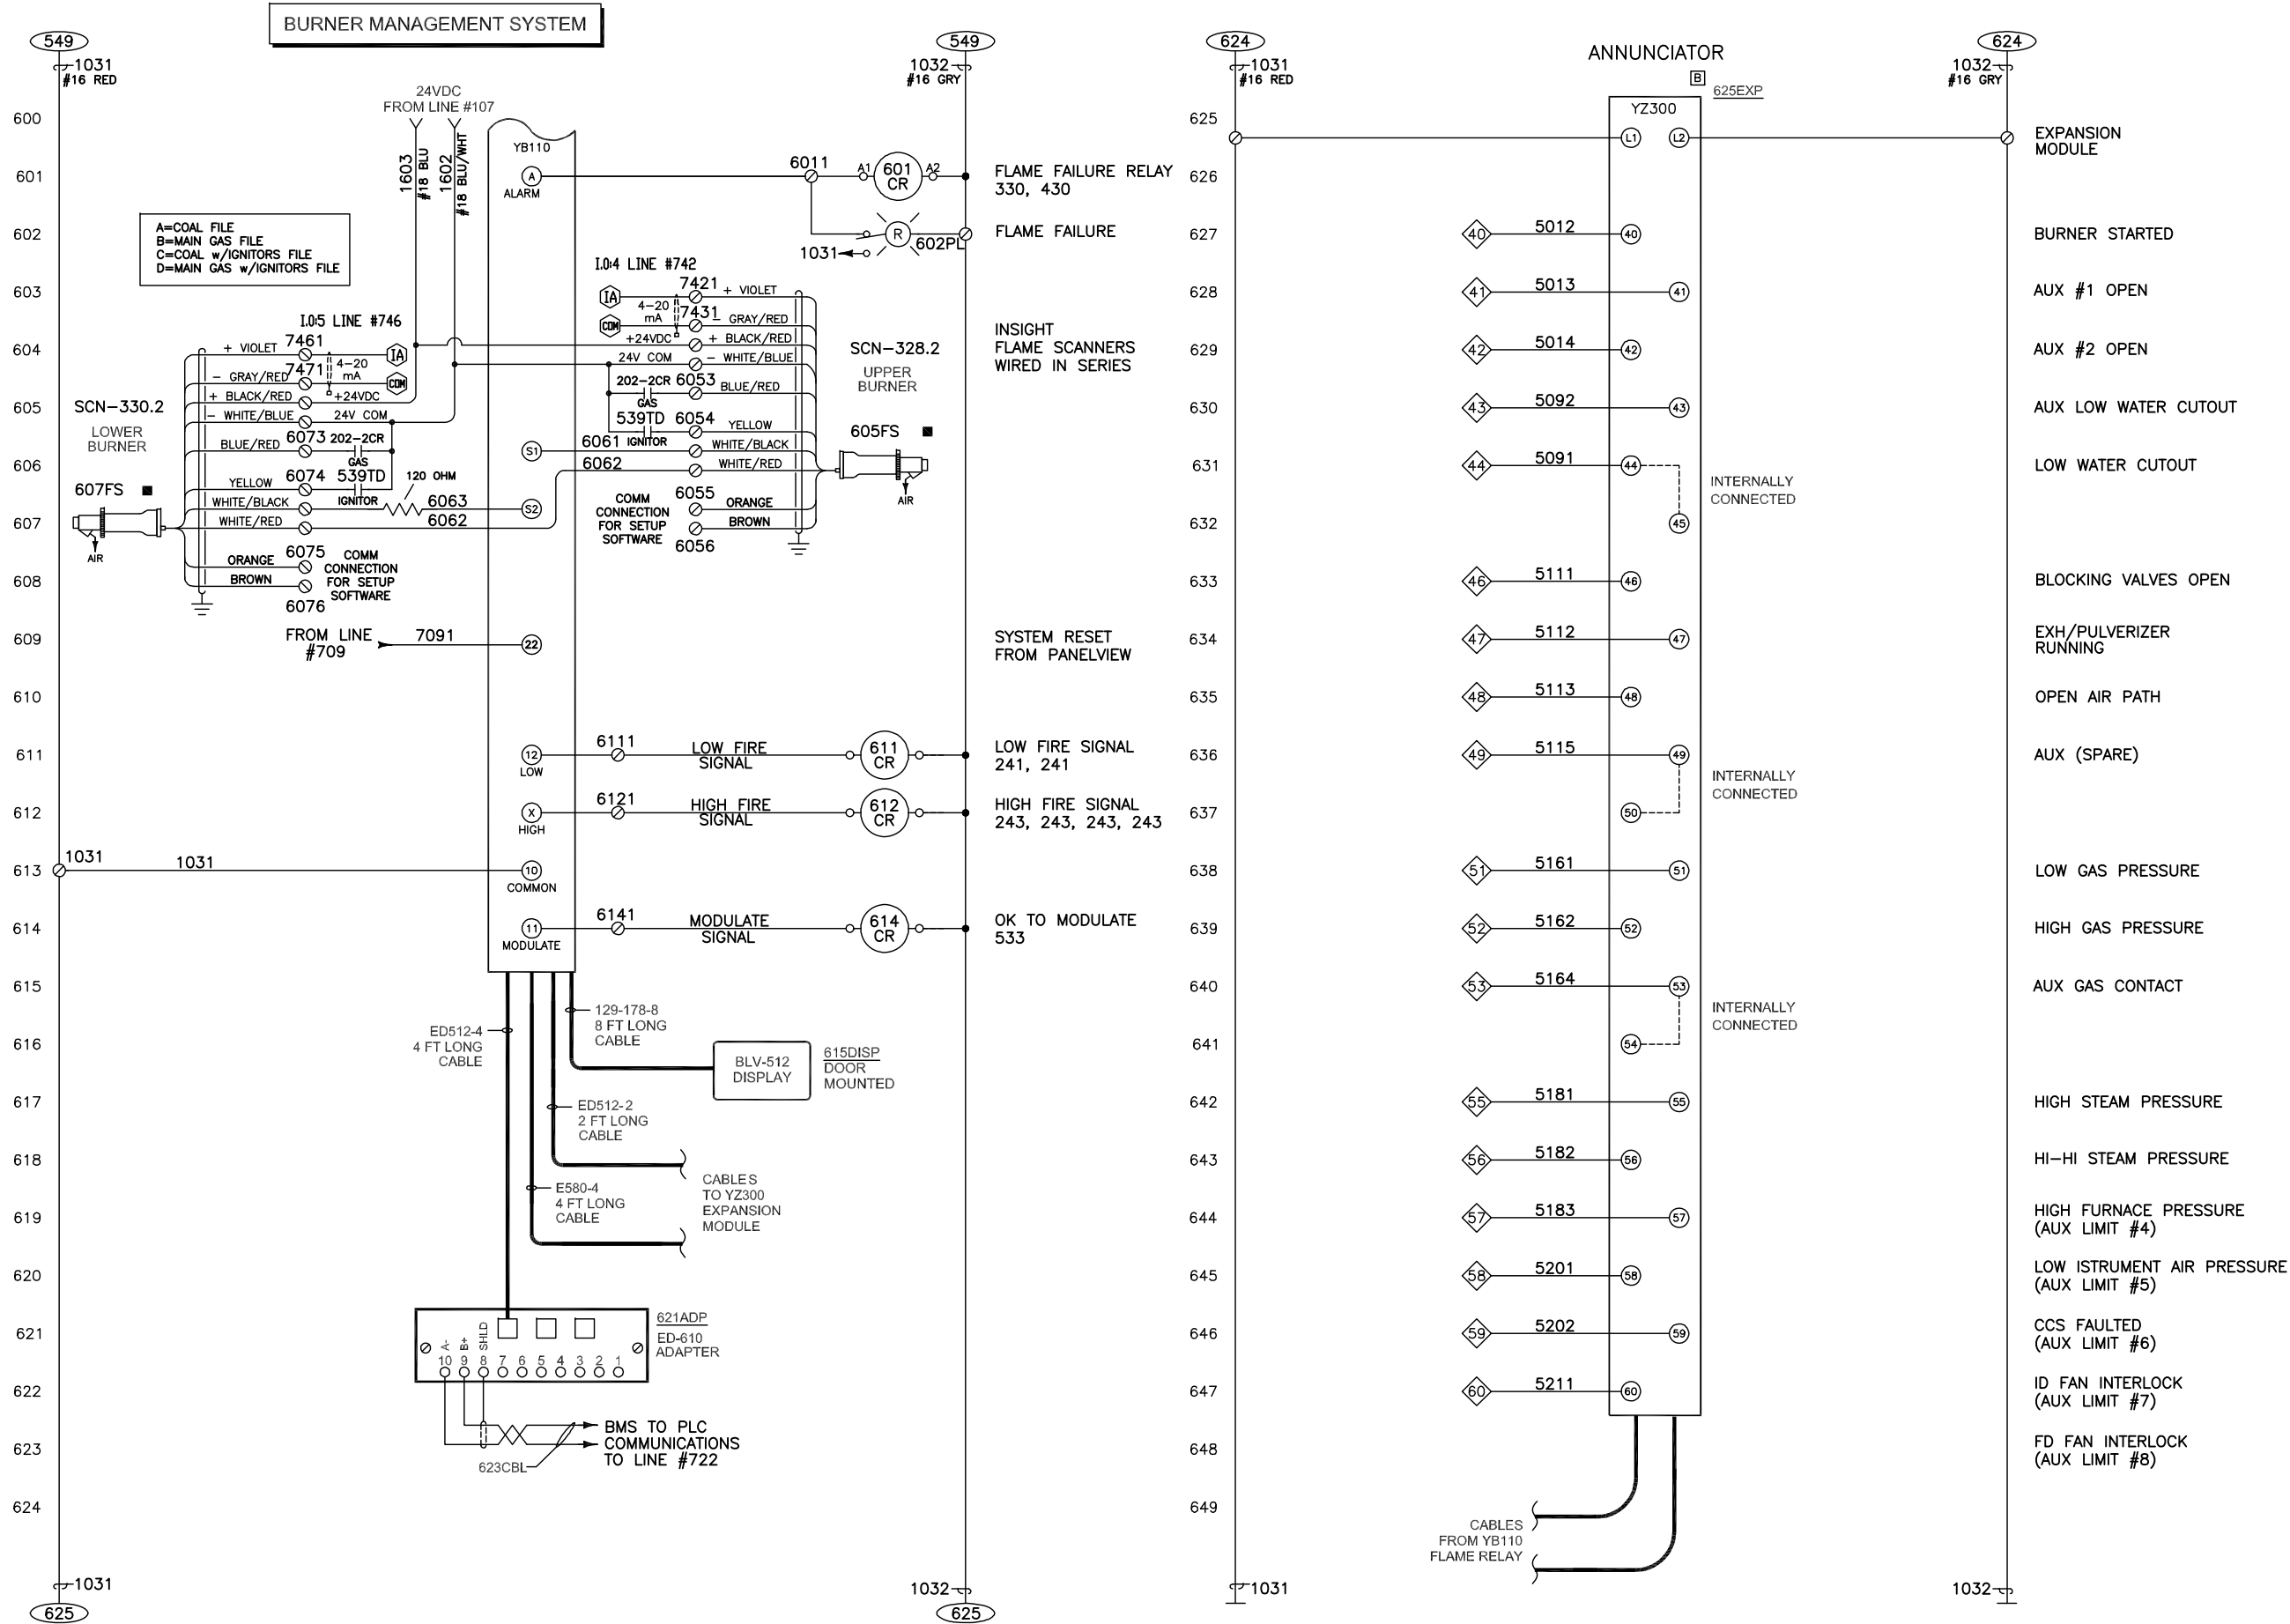

THIS DRAWING HAS BEEN UPDATED FOR
DULUTH ENERGY FROM VENDOR PRINTS
& DOES NOT NECESSARILY CONFORM TO
EGAN CO. DRAFTING CODES &
STANDARDS



Building on Promises Kept
mechanical • electrical • systems

EGAN COMPANY 2016
THIS DRAWING AND ITS
CONTENTS ARE THE
CONFIDENTIAL PROPERTY
OF EGAN COMPANY.
NEITHER THIS DRAWING,
ITS CONTENTS NOR ITS
DESIGN CONCEPTS MAY
BE USED WITHOUT THE
WRITTEN CONSENT OF
EGAN COMPANY.

**DULUTH ENERGY
SYSTEMS**





ONE LAKE PLACE DRIVE
DULUTH, MN 55802-1189

7625 Boone Avenue North | Brooklyn Park, MN 55428 | p: 763.544.4131 | f: 763.595.4380 | www.eganco.com


SAFETY CIRCUIT SCHEMATIC & PLC IO MODULE PANEL BURNER MANAGEMENT SYSTEM DULUTH STEAM BOILER #3	JOB NO. : 424997		DRAWN BY : MDT		APPROVED : M. THOMAS	
REV						
B		ASBUILT		MDT		01/04/17
A		BURNER PANEL UPGRADE		MDT		11/14/16
				DRWN		DATE
						APPROVED

DWG. NO.	424997-3_06
SHEET NO.	06

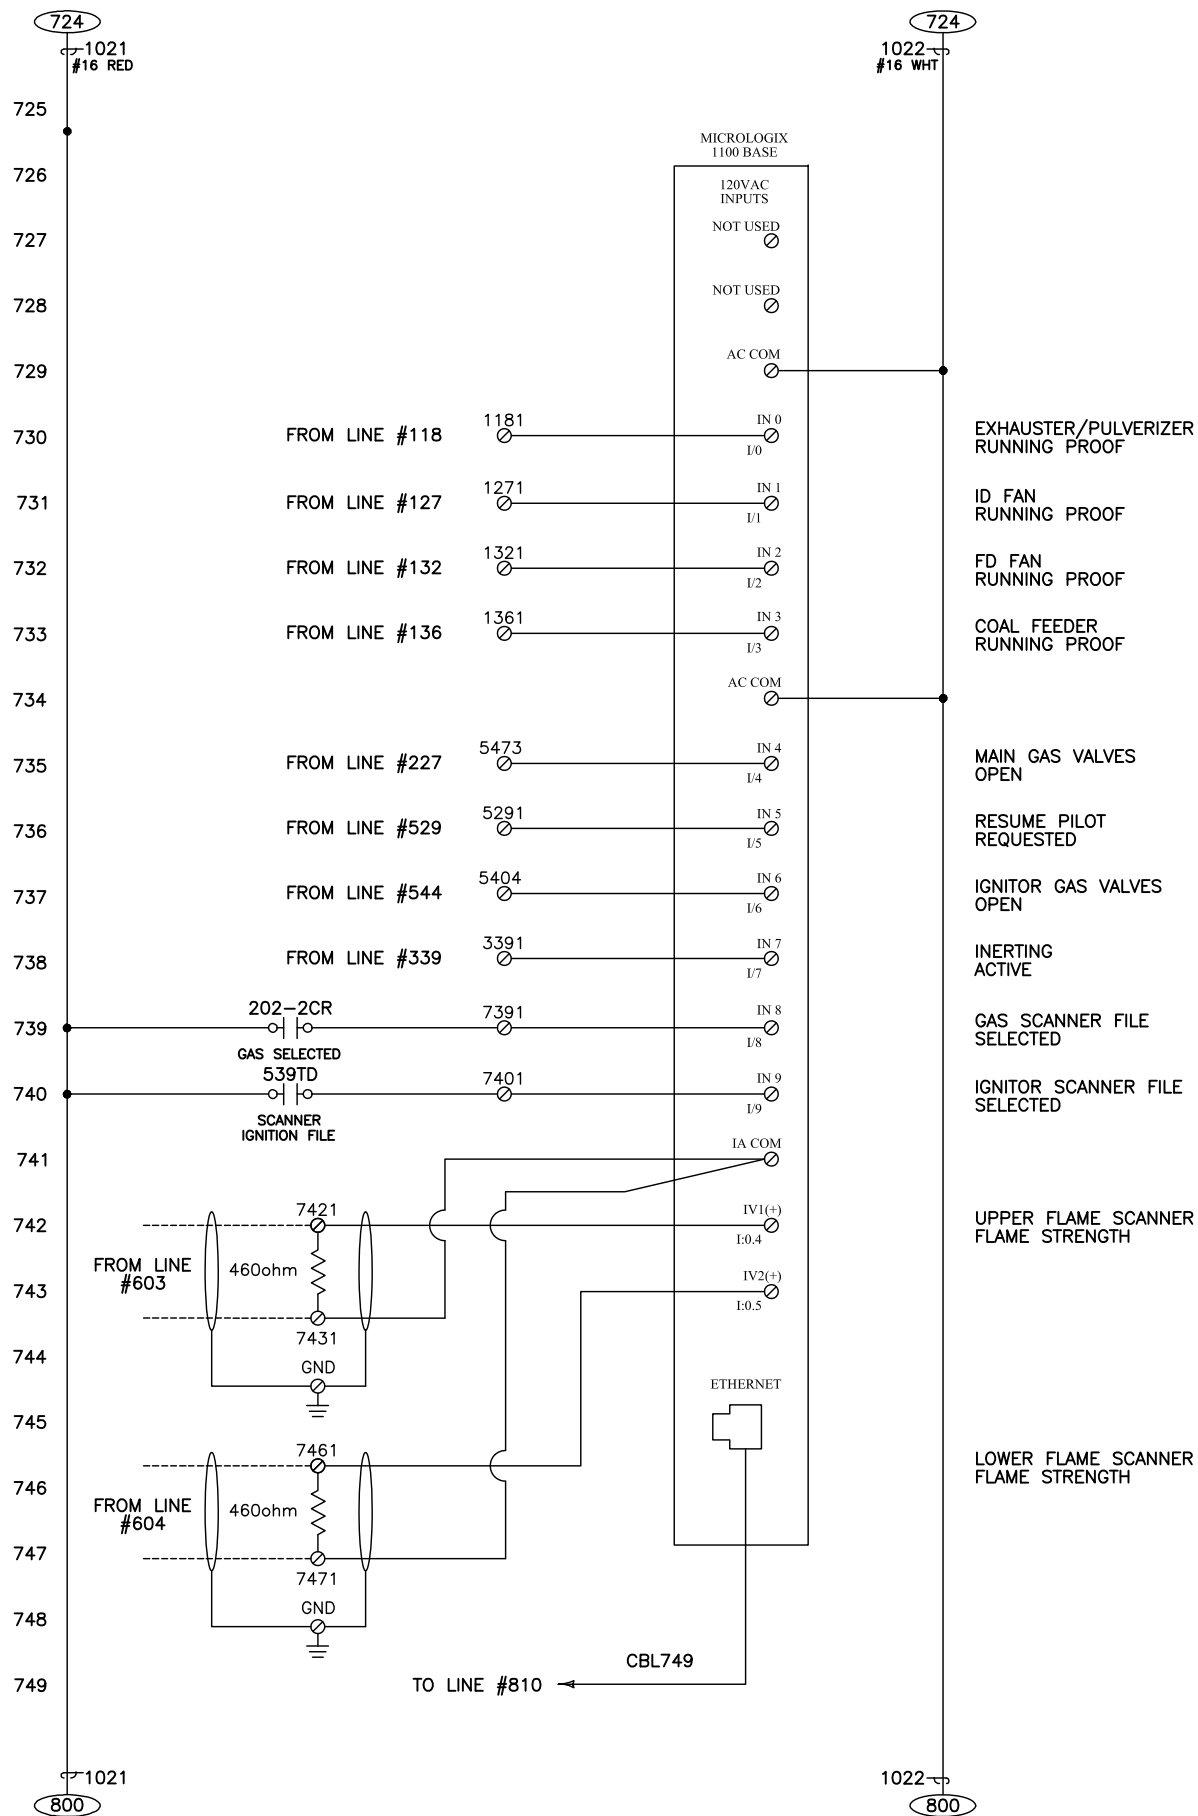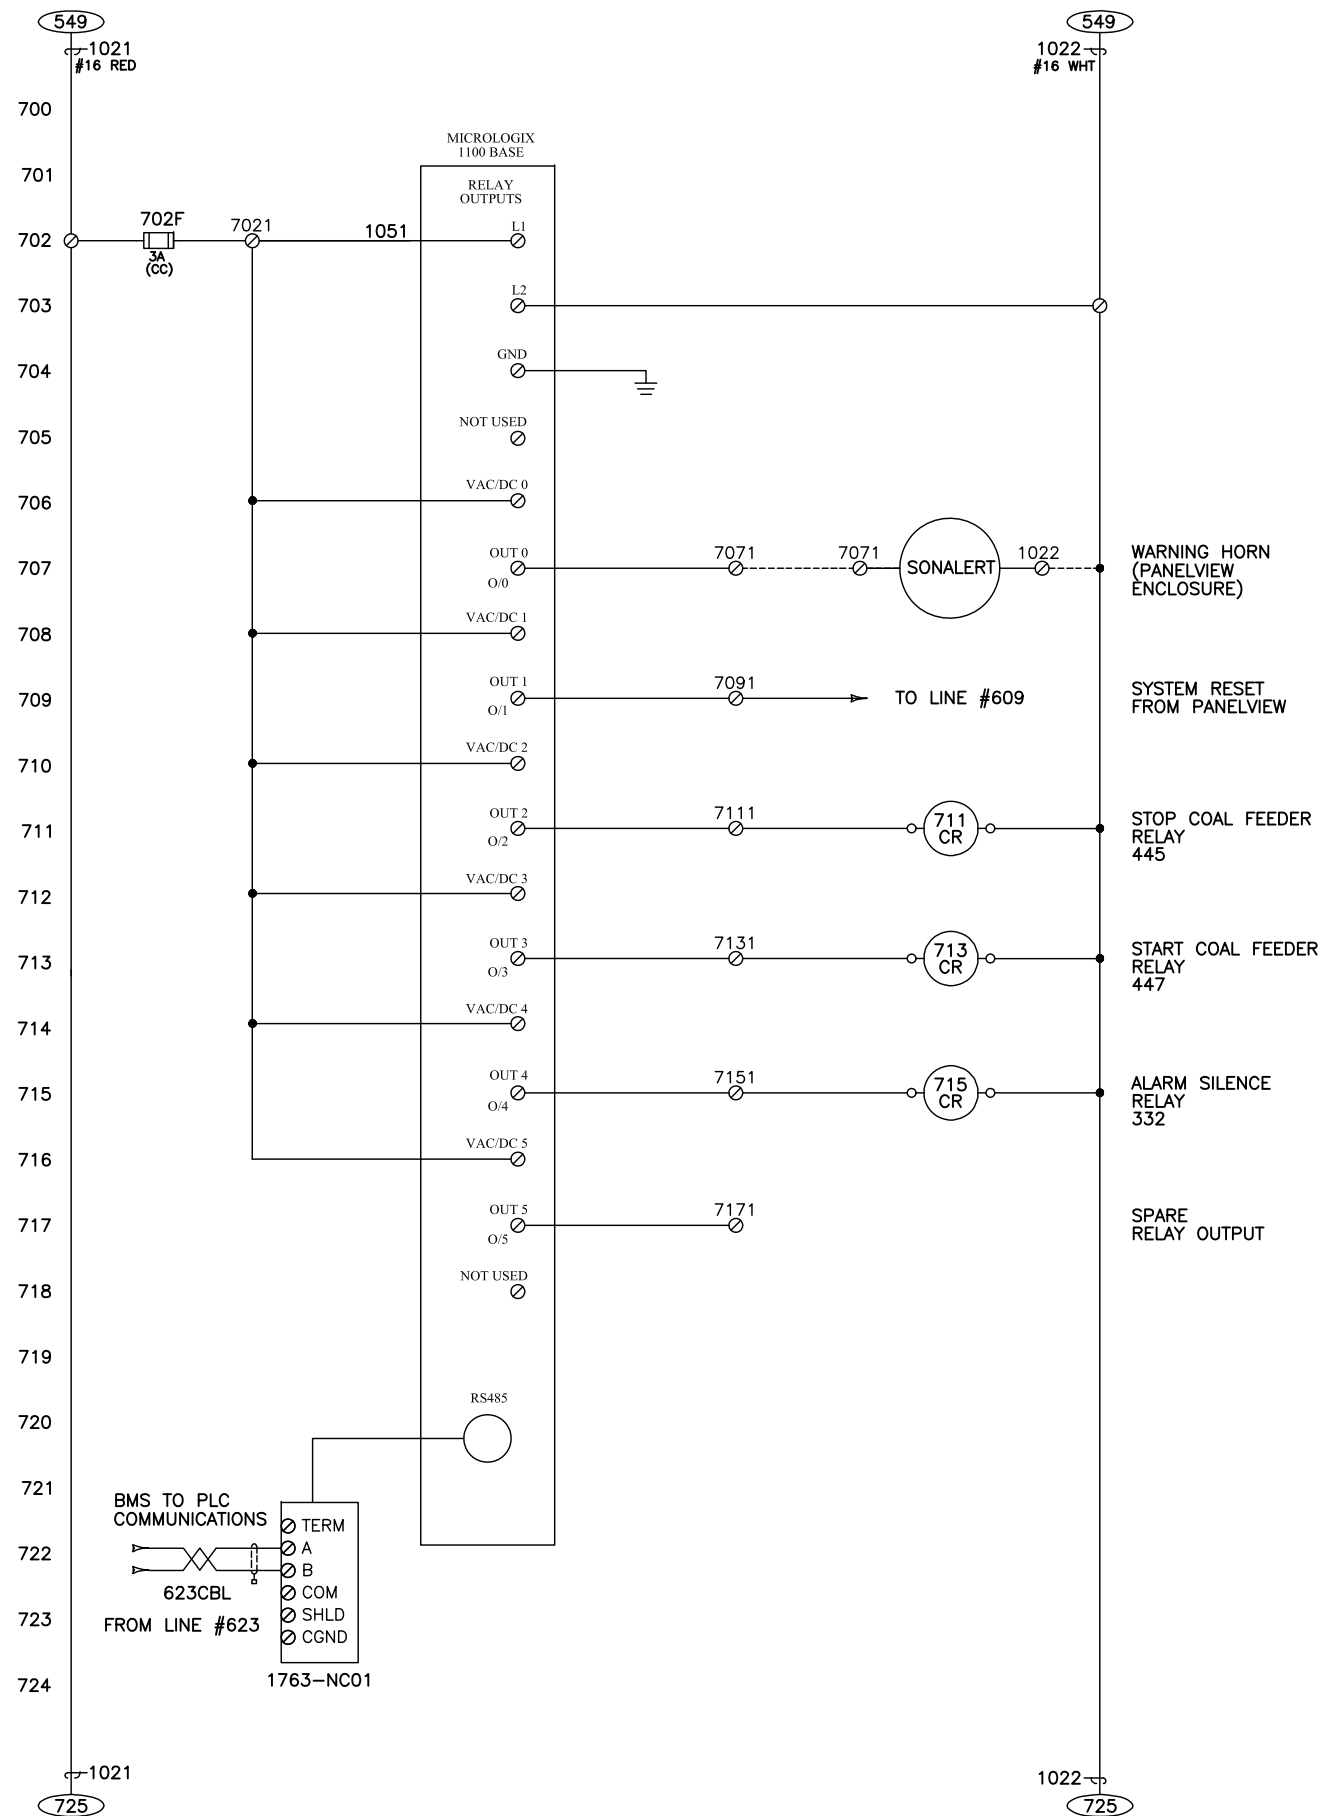

THIS DRAWING HAS BEEN UPDATED FOR
DULUTH ENERGY FROM VENDOR PRINTS
& DOES NOT NECESSARILY CONFORM TO
EGAN CO. DRAFTING CODES &
STANDARDS

D:\District Energy\Duluth Fireye Panels\Boiler 3\Drawings\424997-3_08.dwg 1/4/2017 10:38:06 AM

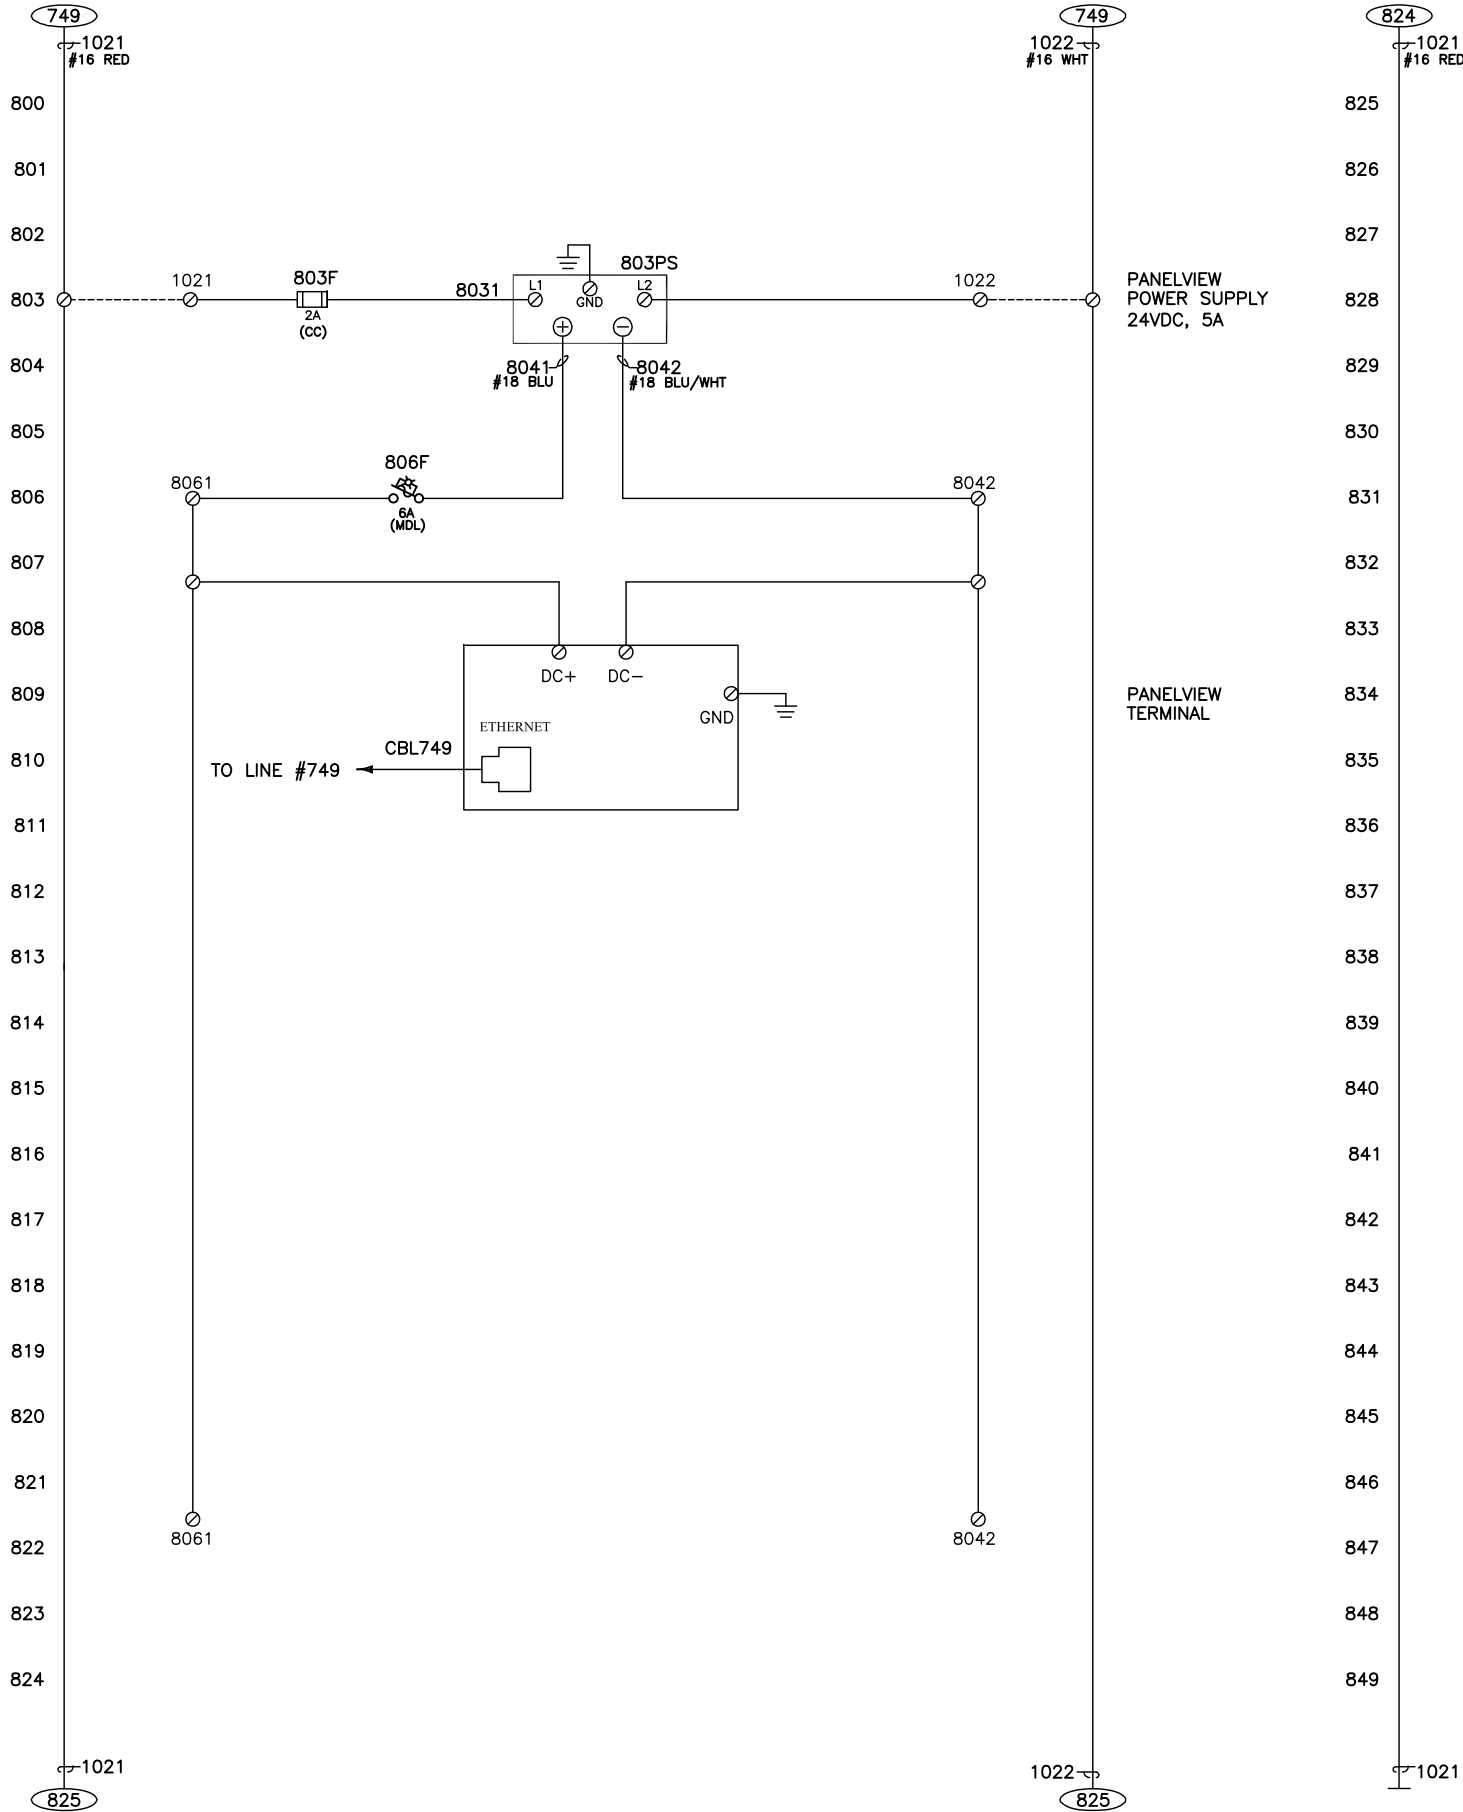

THIS DRAWING HAS BEEN UPDATED FOR
DULUTH ENERGY FROM VENDOR PRINTS
& DOES NOT NECESSARILY CONFORM TO
EGAN CO. DRAFTING CODES &
STANDARDS



EGAN COMPANY 2016
THIS DRAWING AND ITS
CONTENTS ARE THE
CONFIDENTIAL PROPERTY
OF EGAN COMPANY.
NEITHER THIS DRAWING,
ITS CONTENTS NOR ITS
DESIGN CONCEPTS MAY
BE USED WITHOUT THE
WRITTEN CONSENT OF
EGAN COMPANY.


**DULUTH ENERGY
SYSTEMS**

ONE LAKE PLACE DRIVE
DULUTH, MN 55802-1189
p: 763.544.4131 | f: 763.595.4380 | www.eganco.com


JOB NO. : 424997		DRAWN BY : MDT		APPROVED : M. THOMAS	
REV	B	ASBUILT	MDT	01/04/17	DATE
	A	BURNER PANEL UPGRADE	MDT	11/14/16	DATE
DESCRIPTION		APPROVED			

DWG. NO. 424997-3_08
SHEET NO. 08


D:\District Energy\Duluth Fireye Panels\Boiler 3\Drawings\424997-3_09.dwg 11/14/2016 3:22:02 PM

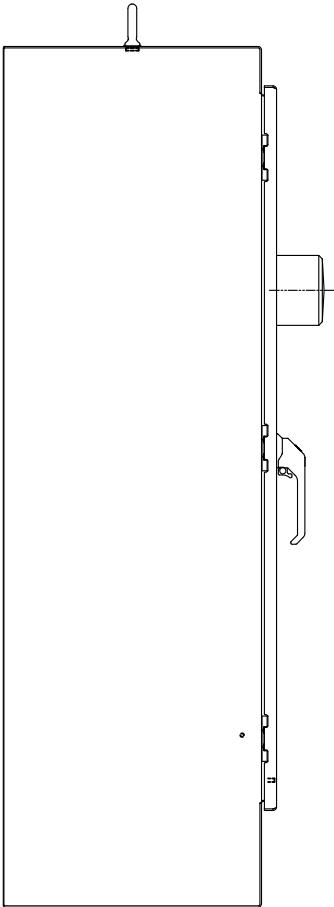


LEFT SIDE VIEW

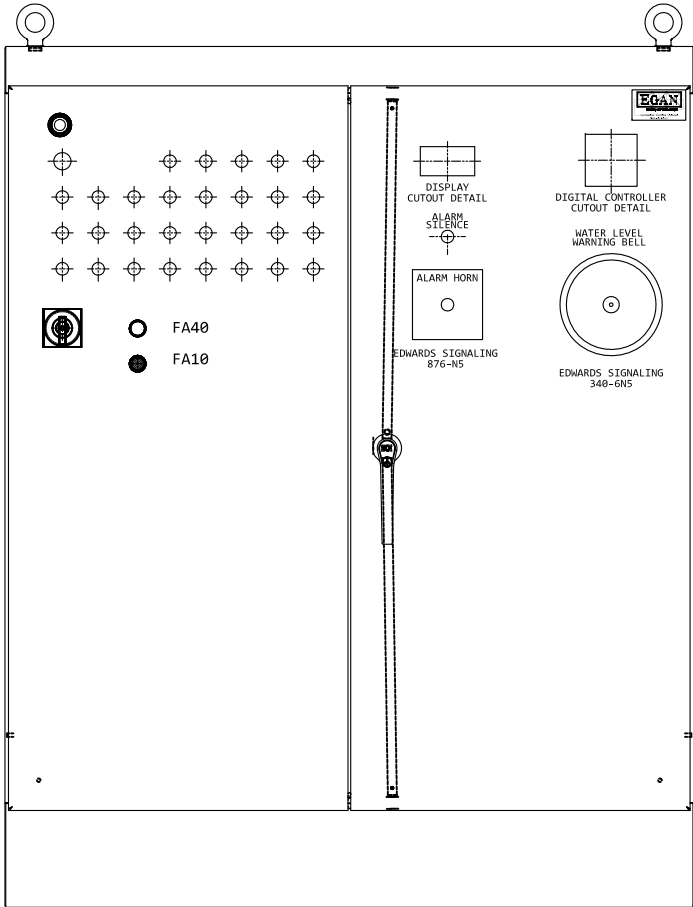


FRONT VIEW

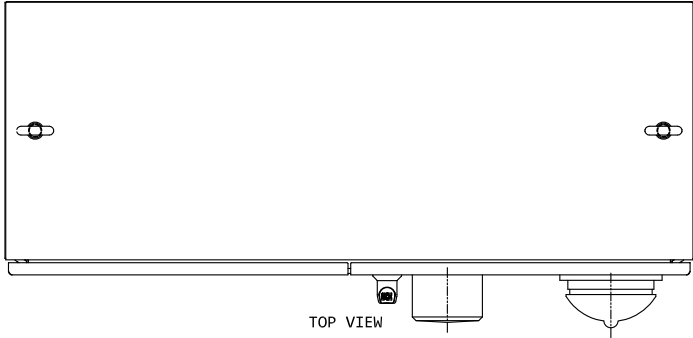

TOP VIEW

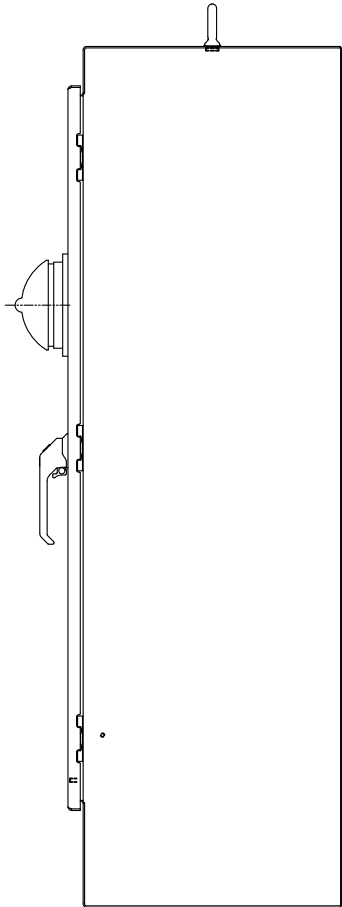

RIGHT SIDE VIEW

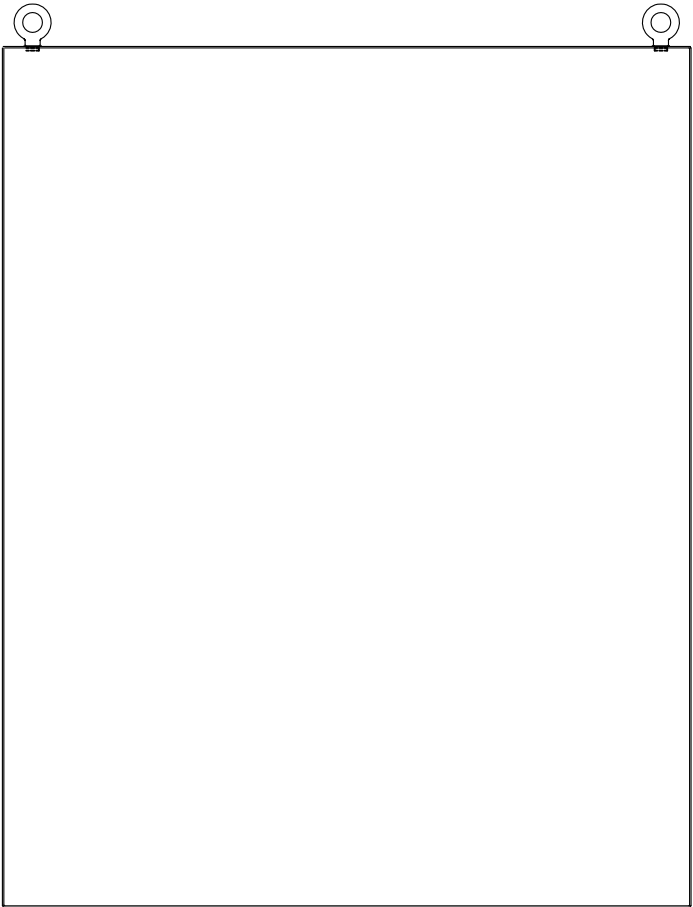

BACK VIEW



**DULUTH ENERGY
SYSTEMS**

ONE LAKE PLACE DRIVE
DULUTH, MN 55802-1189

7625 Boone Avenue North | Brooklyn Park, MN 55428 | p: 763.544.4131 | f: 763.595.4380 | www.eganco.com

CONTROL PANEL LAYOUT		MAIN PANEL		JOB NO. : 424997	
BURNER MANAGEMENT SYSTEM				DRAWN BY : DJN	
DULUTH STEAM BOILER #3				APPROVED : M. THOMAS	
REV	A				
					</


DWG. NO.	424997-3_09
SHEET NO.	09

© EGAN COMPANY 2016
THIS DRAWING AND ITS
CONTENTS ARE THE
CONFIDENTIAL PROPERTY
OF EGAN COMPANY.
NEITHER THIS DRAWING,
ITS CONTENTS NOR ITS
DESIGN CONCEPTS MAY
BE USED WITHOUT THE
WRITTEN CONSENT OF
EGAN COMPANY.



mechanical • electrical • systems

SAGINAW CONTROL & ENGINEERING
SCE-60P48F1

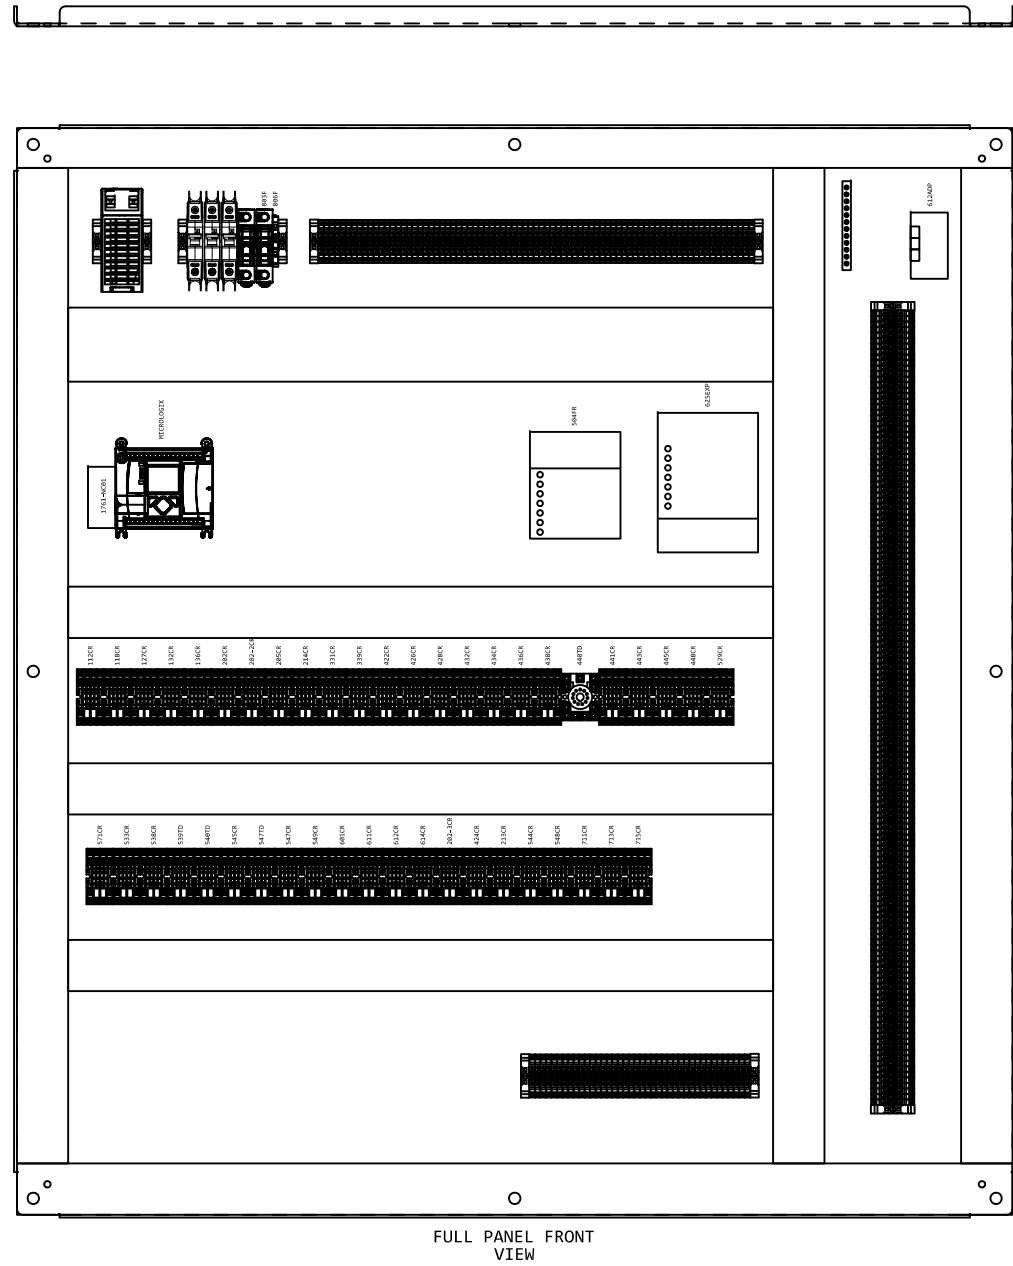

BACKPANEL LAYOUT		MAIN PANEL		JOB NO. : 424997	
BURNER MANAGEMENT SYSTEM				DRAWN BY : DJN	
DULUTH STEAM BOILER #3				APPROVED : M. THOMAS	
REV					
A	BURNER PANEL UPGRADE		DJN	MDT	11/14/16
REV	DESCRIPTION		DJN	APPROVED	DATE

DWG. NO.	424997-3_10
SHEET NO.	10




**DULUTH ENERGY
SYSTEMS**

ONE LAKE PLACE DRIVE
DULUTH, MN 55802-1189


© EGAN COMPANY 2016
THIS DRAWING AND ITS
CONTENTS ARE THE
CONFIDENTIAL PROPERTY
OF EGAN COMPANY.
NEITHER THIS DRAWING,
ITS CONTENTS NOR ITS
DESIGN CONCEPTS MAY
BE USED WITHOUT THE
WRITTEN CONSENT OF
EGAN COMPANY.




D:\District Energy\Duluth Fireye Panels\Boiler 3\Drawings\424997-3_11.dwg 11/14/2016 3:37:06 PM

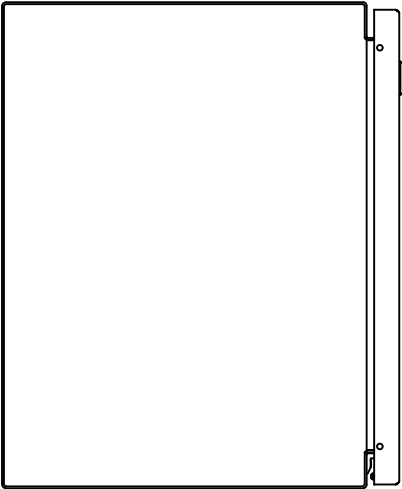


LEFT SIDE VIEW

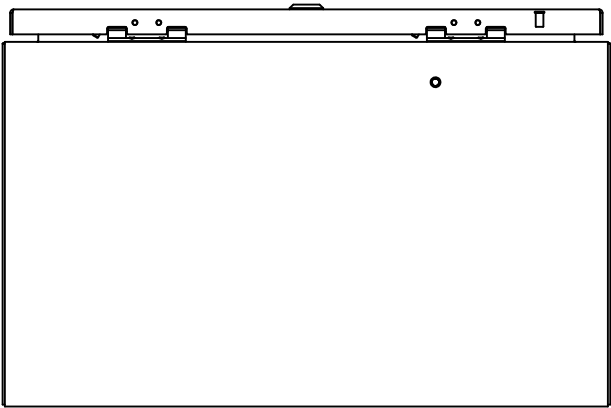


BOTTOM VIEW

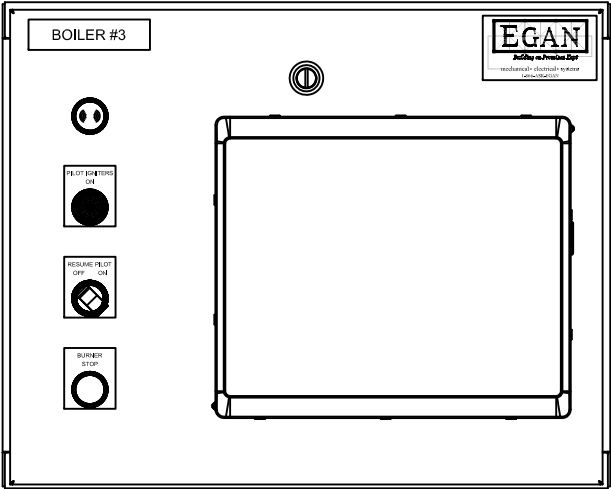


FRONT VIEW

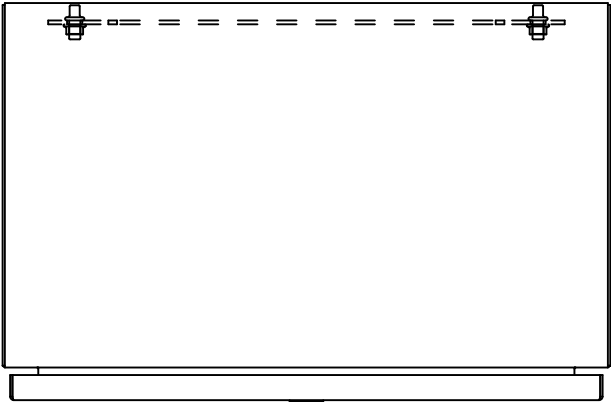


TOP VIEW

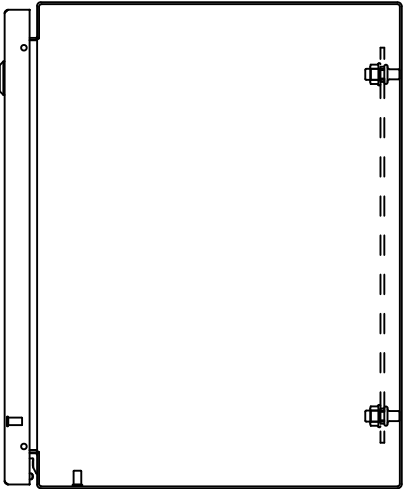

RIGHT SIDE VIEW

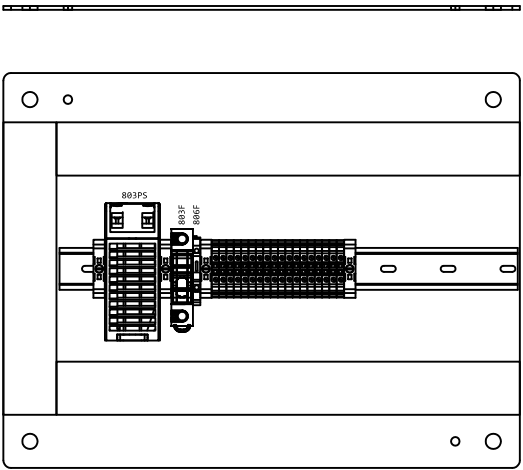

SUBPANEL FRONT VIEW

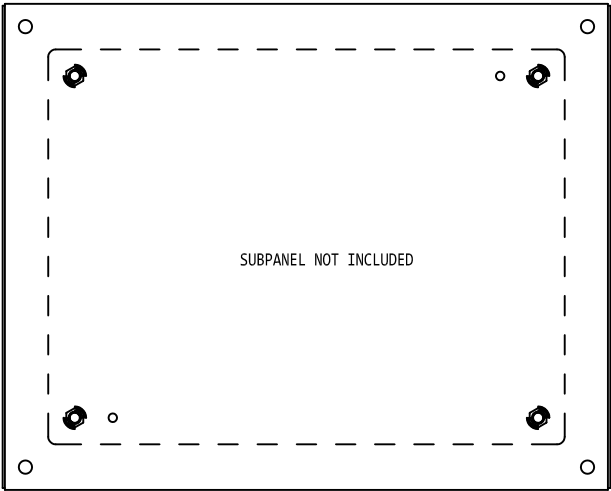

EXTERNAL REAR VIEW

SAGINAW CONTROL & ENGINEERING
SCE-20EL1612LP

HMI PANEL LAYOUT		HMI PANEL		JOB NO. : 424997	
BURNER MANAGEMENT SYSTEM				DRAWN BY : DJN	
DULUTH STEAM BOILER #3				APPROVED : M. THOMAS	
REV	DESCRIPTION	DATE	DATE	DATE	DATE
A	BURNER PANEL UPGRADE	11/14/16	MDT	11/14/16	MDT

**DULUTH ENERGY
SYSTEMS**


ONE LAKE PLACE DRIVE
DULUTH, MN 55802-1189
p: 763.544.4131 | f: 763.595.4380

EGAN COMPANY 2016
THIS DRAWING AND ITS
CONTENTS ARE THE
CONFIDENTIAL PROPERTY
OF EGAN COMPANY.
NEITHER THIS DRAWING,
ITS CONTENTS NOR ITS
DESIGN CONCEPTS MAY
BE USED WITHOUT THE
WRITTEN CONSENT OF
EGAN COMPANY.


EGAN

Building on Promises Kept
mechanical • electrical • systems


Main Panel Button Layout

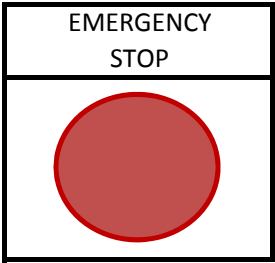


503ES-1

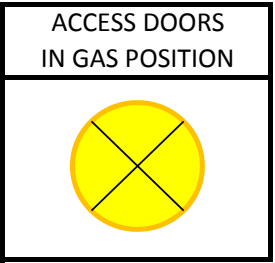


416PL

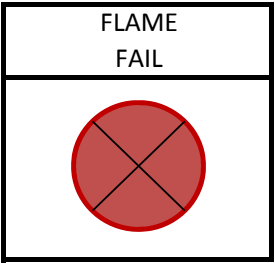


602PL

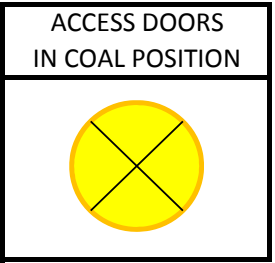


418PL

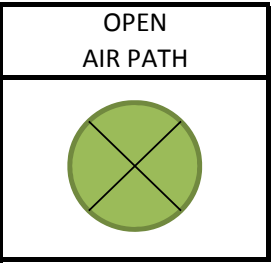


423PL

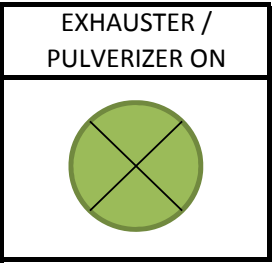


119PL

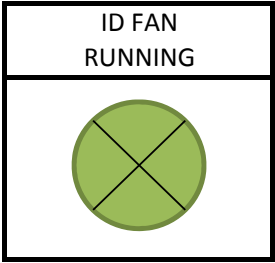


128PL

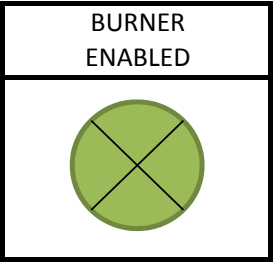


113PL

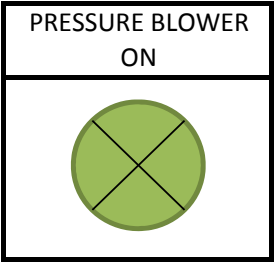


534PL

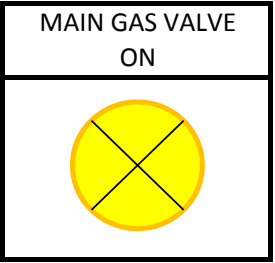


548PL

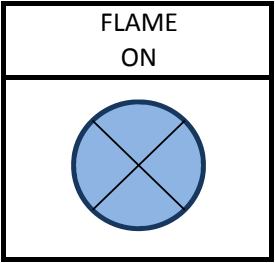


546PL

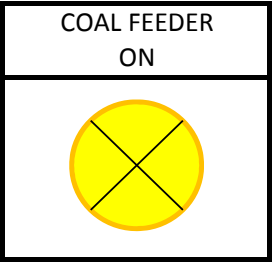


137PL

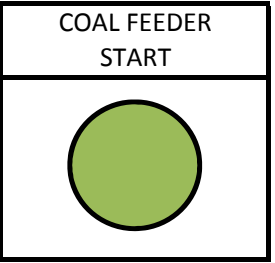


445PB-2

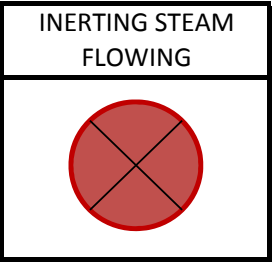


347PL

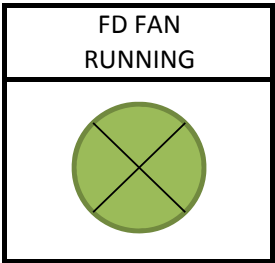


133PL

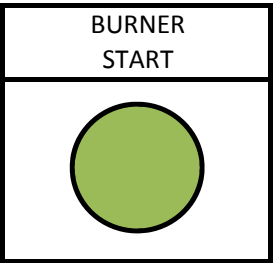


112PB-3

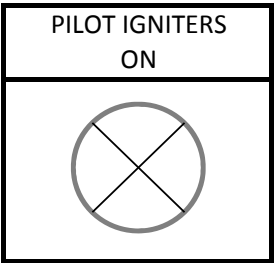


541PL

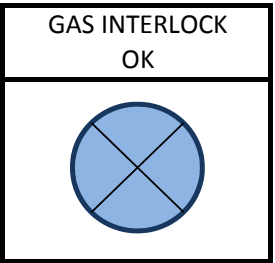


515PL

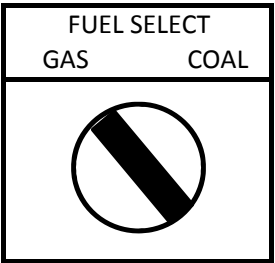


202SS

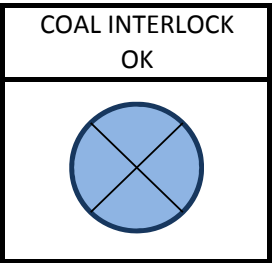


510PL

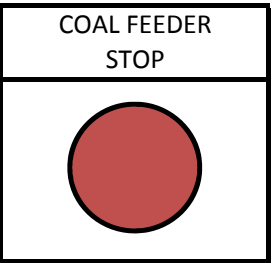


445PB-1

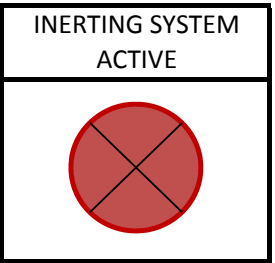


340PL

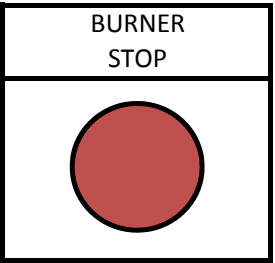


112PB-1

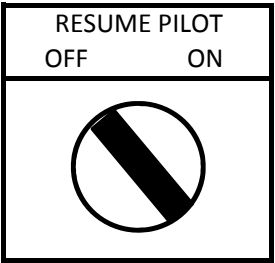


529SS

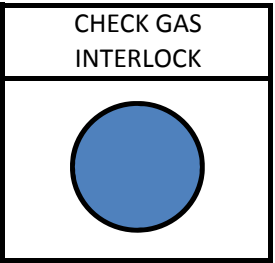


515PB

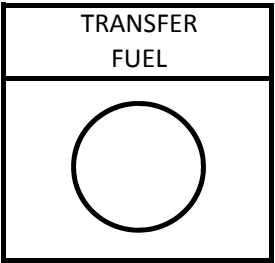


442PB

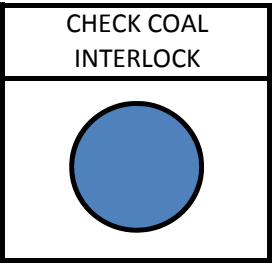

510PB

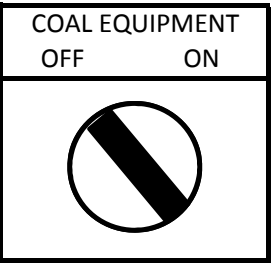


443SS

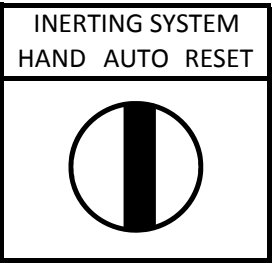


339SS

Sonalert

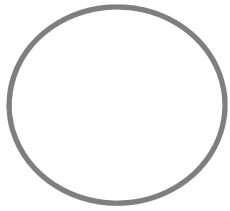

PILOT IGNITERS
ON

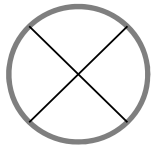


532PL

RESUME PILOT
OFF ON




531SS

BURNER
STOP

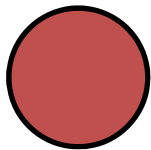


112PB-2

 Panelview



Exit Door 1

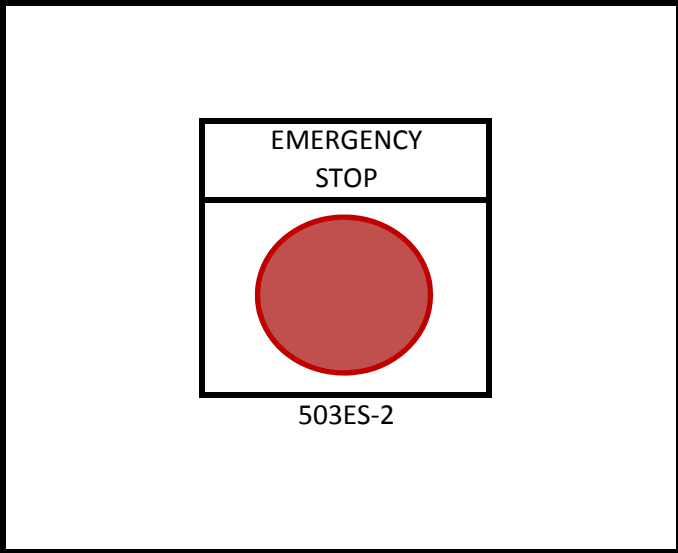

Exit Door 2

