


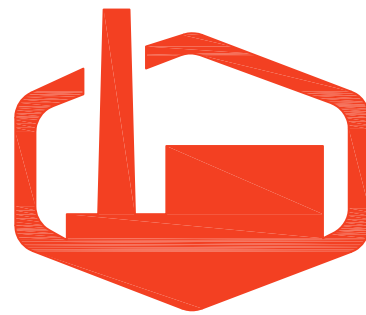

**DULUTH ENERGY
SYSTEMS**


ONE LAKE PLACE DRIVE
DULUTH, MN 55802-1189

BURNER MANAGEMENT SYSTEM DULUTH STEAM BOILER #2

REV C

JOB# 424997

CONTROL SYSTEM DESIGNED AND BUILT BY

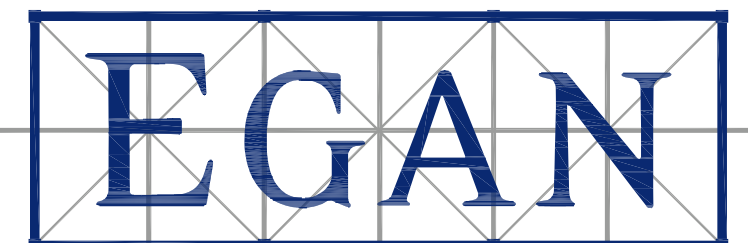

Building on Promises Kept
mechanical • electrical • systems

7625 Boone Avenue North | Brooklyn Park, MN 55428 | p: 763.544.4131 | f: 763.595.4380 | www.eganco.com

D:\District Energy\Duluth Fireye Panels\Drawings\424997-1_100IDX.dwg 11/14/2016 11:57:35 AM

LIST OF DRAWINGS		
SHT	REVISION	DRAWING DESCRIPTIONS
01	C	ELECTRICAL SCHEMATIC
02	C	ELECTRICAL SCHEMATIC
03	C	ELECTRICAL SCHEMATIC
04	C	ELECTRICAL SCHEMATIC
05	C	SAFETY CIRCUIT SCHEMATIC
06	C	SAFETY CIRCUIT SCHEMATIC & PLC IO MODULE
07	C	PLC IO MODULES
08	A	ELECTRICAL SCHEMATIC
09	A	CONTROL PANEL LAYOUT
10	C	BACKPANEL LAYOUT
11	A	PANELVIEW ENCLOSURE

SYMBOL LEGEND	
■	FIELD
▲	FUEL TRAIN
M	MOTOR CONTROL
B	BMS PANEL
R	REMOTE PANEL
⊙	TERMINAL
◇	REFERENCE TO EXPANSION MODULE
----	FIELD WIRING
*	WIRING BY FIELD ELECTRICAL CONTRACTOR

THIS DRAWING HAS BEEN UPDATED FOR DULUTH ENERGY FROM VENDOR PRINTS & DOES NOT NECESSARILY CONFORM TO EGAN CO. DRAFTING CODES & STANDARDS.

LEGEND	
—————	PANEL WIRING
-----	FIELD WIRING
⊗	PANEL TERMINAL
⊠	FIELD DEVICE TERMINAL



Dwg#: 424997 Egan #: 424997
Voltage 120V Ph: 1 Hz: 60
Total FLA: 8.8
Largest Motor FLA: N/A
SCCR: 5 KA
Enclosure type: 12

Enclosure openings must be filled by equipment marked with the same Type rating as enclosure. Use 75° deg. C copper wire minimum.

Fuse Chart:	
DESCRIPTION	AMPERAGE (A.)
105F	2A
106F	6A
702F	3A
803F	2A
806F	6A



EGAN COMPANY 2016
THIS DRAWING AND ITS
CONTENTS ARE THE
CONFIDENTIAL PROPERTY
OF EGAN COMPANY.
NEITHER THIS DRAWING,
ITS CONTENTS NOR ITS
DESIGN CONCEPTS MAY
BE USED WITHOUT THE
WRITTEN CONSENT OF
EGAN COMPANY.

**DULUTH ENERGY
SYSTEMS**

ONE LAKE PLACE DRIVE
DULUTH, MN 55802-1189



7625 Boone Avenue North | Brooklyn Park, MN 55428 | p: 763.544.4131 | f: 763.595.4380 | www.eganco.com

INDEX SHEET	BURNER MANAGEMENT SYSTEM DULUTH STEAM BOILER #2	MAIN PANEL	JOB NO. : 424997	
			DRAWN BY : MDT	
			APPROVED : M. THOMAS	
			MDT	11/14/16
REV	DESCRIPTION	MDT	MDT	DATE
A	ASBUILT BURNER PANEL UPGRADE	MDT	MDT	08/16/16


DWG. NO.
424997-1_100IDX
SHEET NO.
00

DWG. NO.	424997-1_01
SHEET NO.	01

D:\District Energy\Duluth Fireye Panels\Boiler 2\Drawings\424997-1_02.dwg 11/22/2016 8:33:21 AM

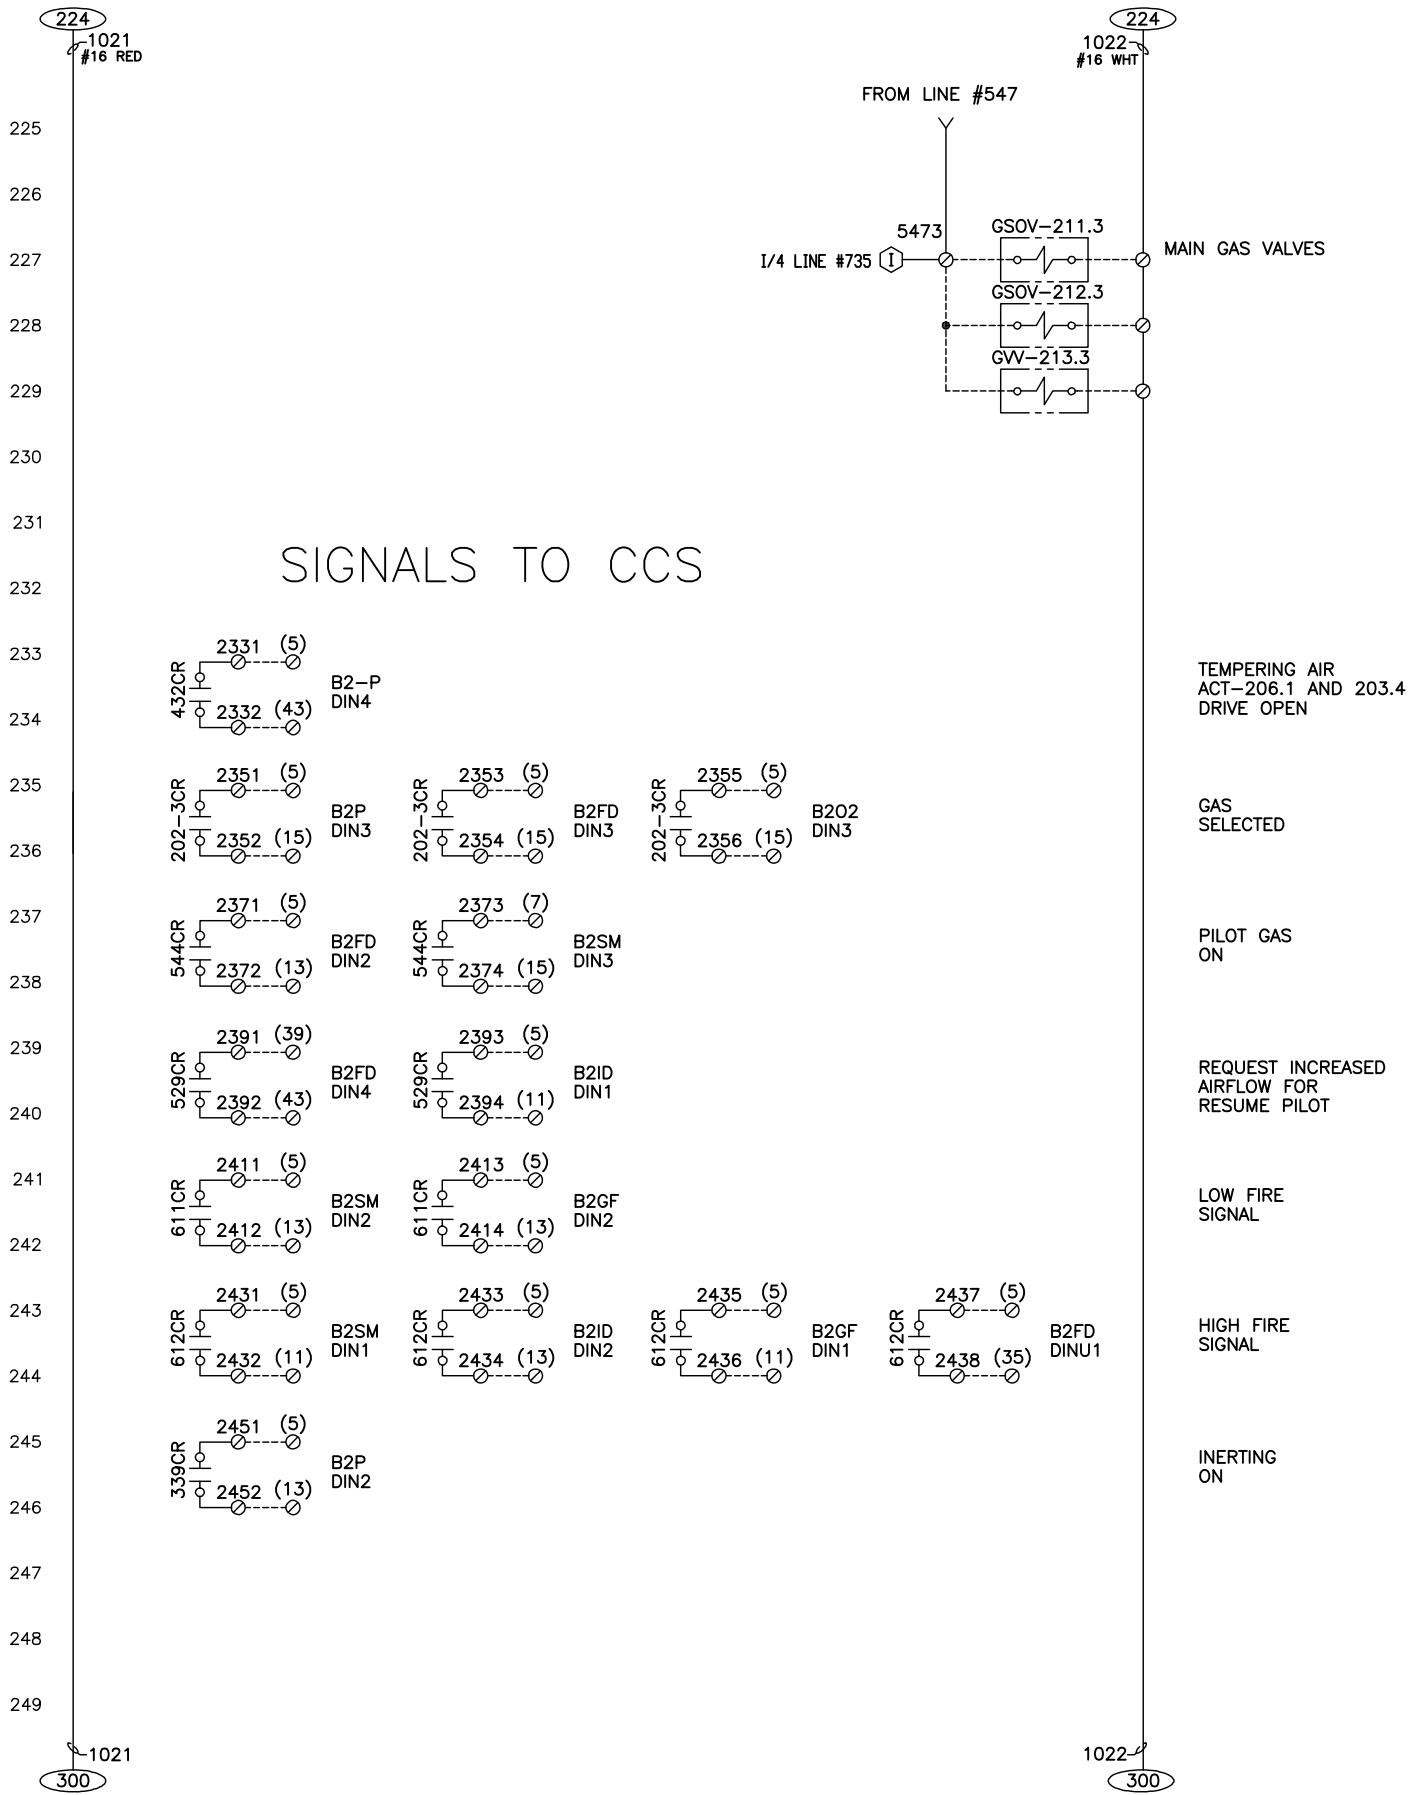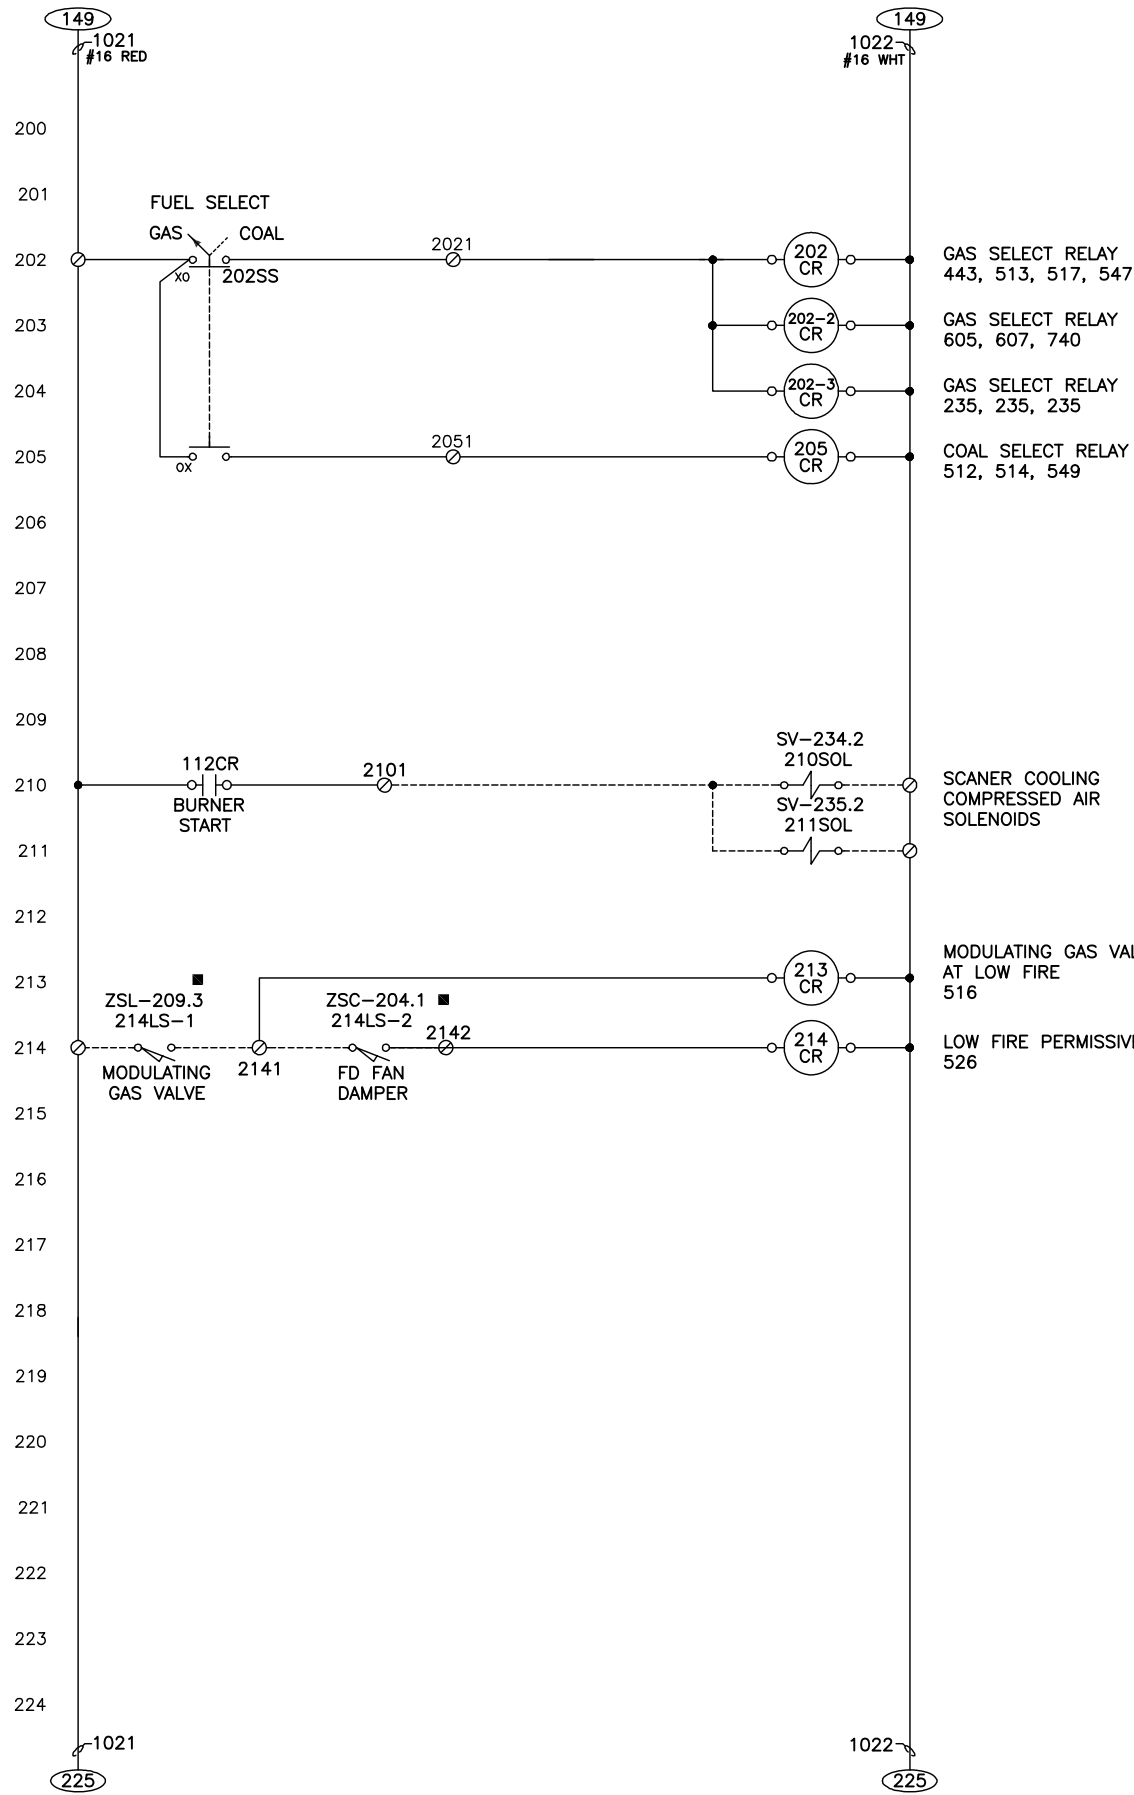

SIGNALS TO CCS

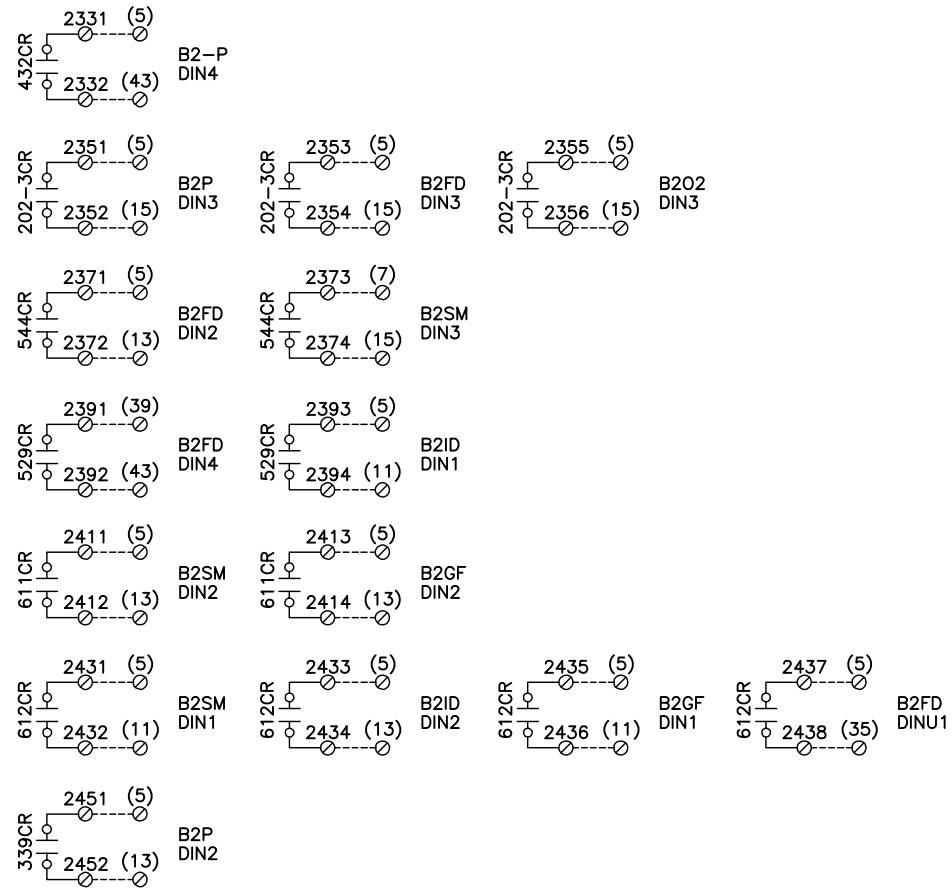

THIS DRAWING HAS BEEN UPDATED FOR
DULUTH ENERGY FROM VENDOR PRINTS
& DOES NOT NECESSARILY CONFORM TO
EGAN CO. DRAFTING CODES &
STANDARDS

DULUTH ENERGY
SYSTEMS



JOB NO. : 424997		DRAWN BY : MDT		APPROVED : M. THOMAS	
REV	C	ASBUILT	MDT	11/14/16	DATE
	B	202-3CR ADDED	MDT	08/31/16	DATE
	D	B2SM DIN3 SIGNAL ADDED	MDT	11/22/16	DATE
	REV	DESCRIPTION	DRWN	APPROVED	DATE
A					

ELECTRICAL SCHEMATIC
BURNER MANAGEMENT SYSTEM
DULUTH STEAM BOILER #2

DWG. NO.
424997-1_02

SHEET NO.
02

DULUTH ENERGY
SYSTEMS




JOB NO. : 424997		DRAWN BY : MDT		APPROVED : M. THOMAS	
REV	C	ASBUILT	MDT	11/14/16	DATE
	B	202-3CR ADDED	MDT	08/31/16	DATE
	D	B2SM DIN3 SIGNAL ADDED	MDT	11/22/16	DATE
	REV	DESCRIPTION	DRWN	APPROVED	DATE
A					



ELECTRICAL SCHEMATIC
BURNER MANAGEMENT SYSTEM
DULUTH STEAM BOILER #2

DWG. NO.
424997-1_02

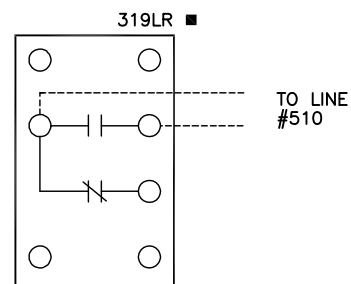



ALWC-201.5
AUX LOW WATER CUTOUT RELAY
509

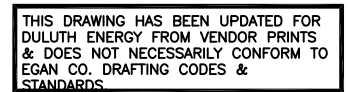

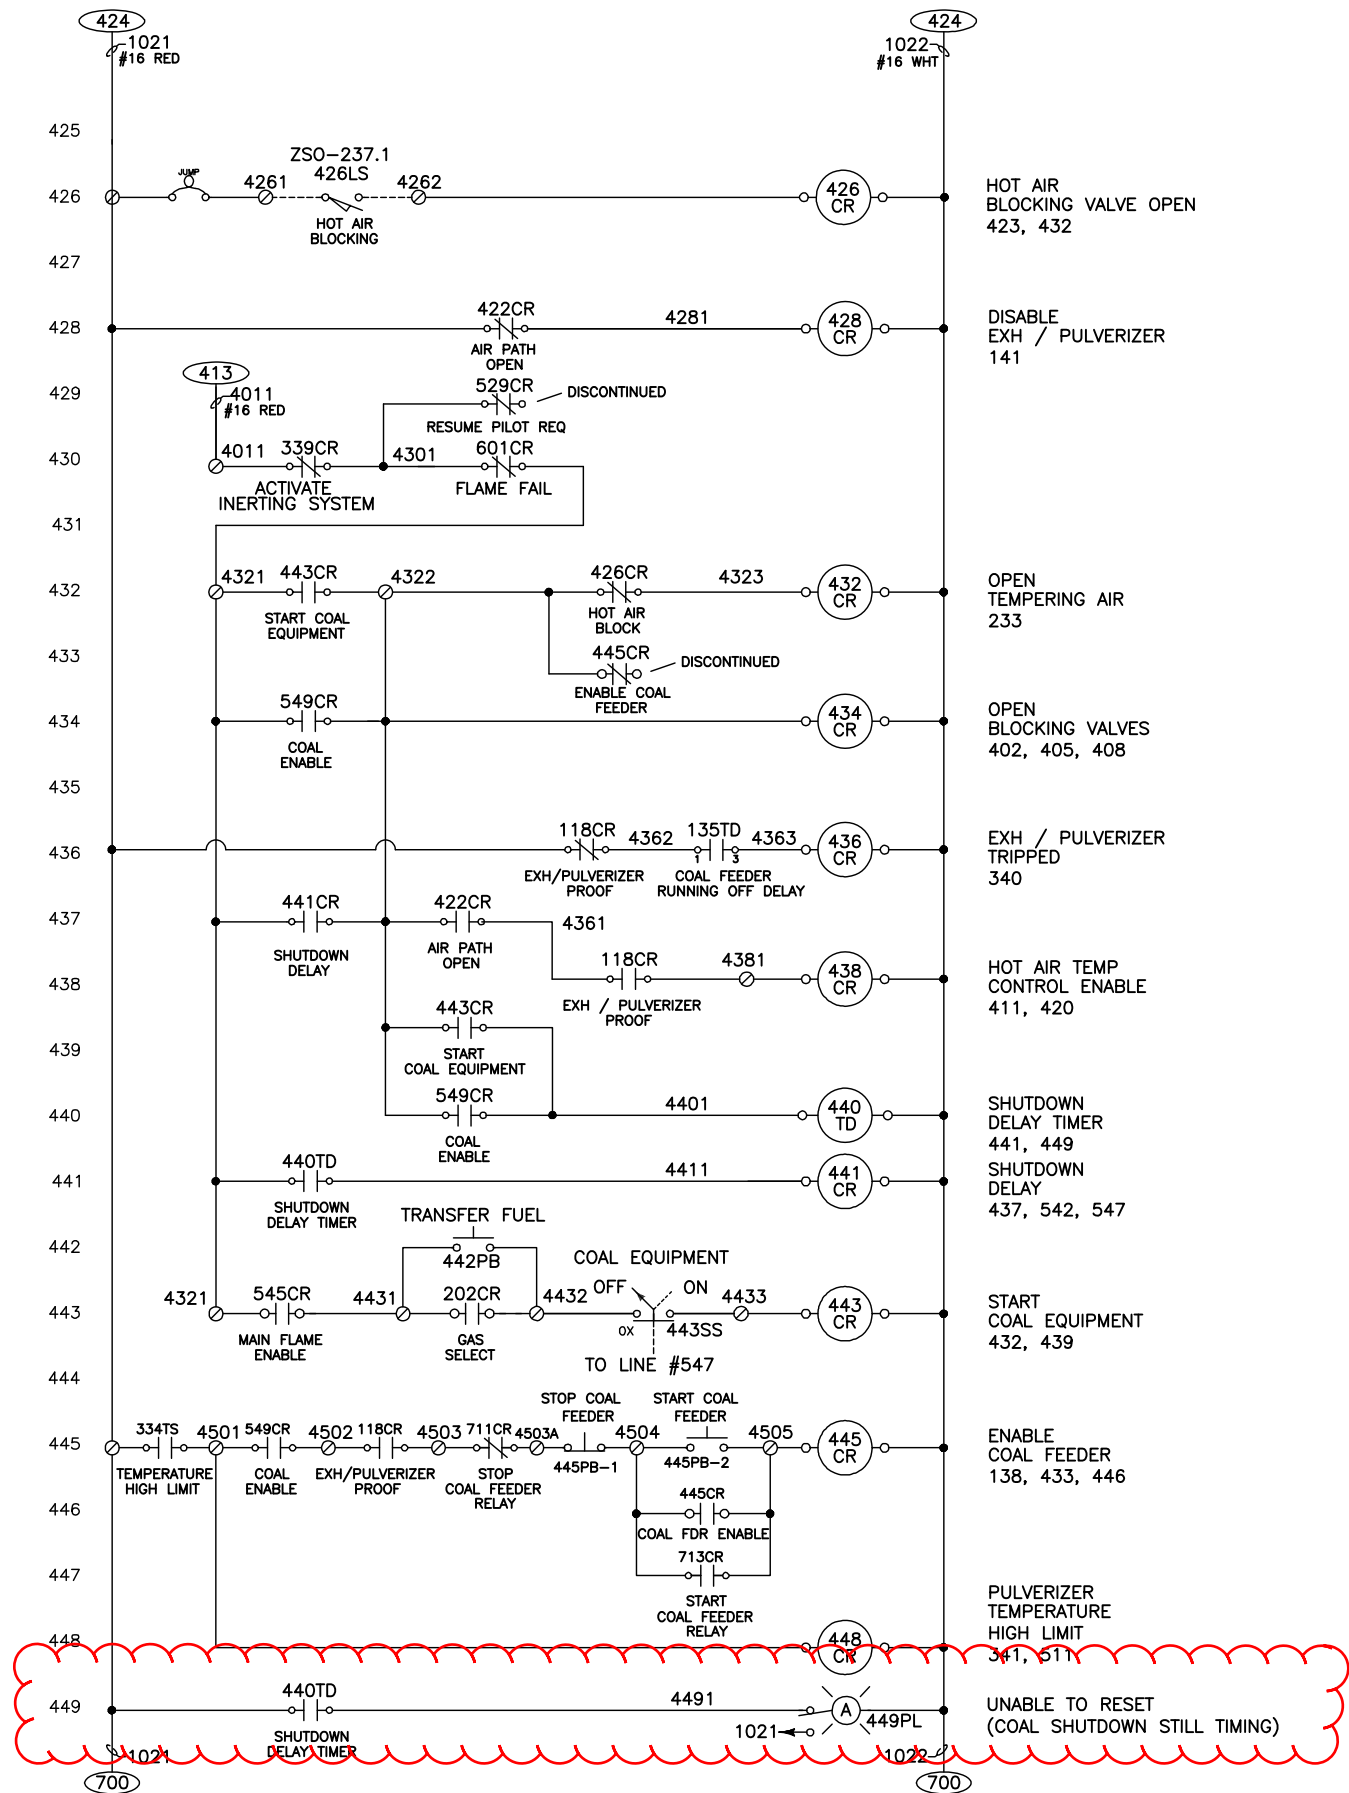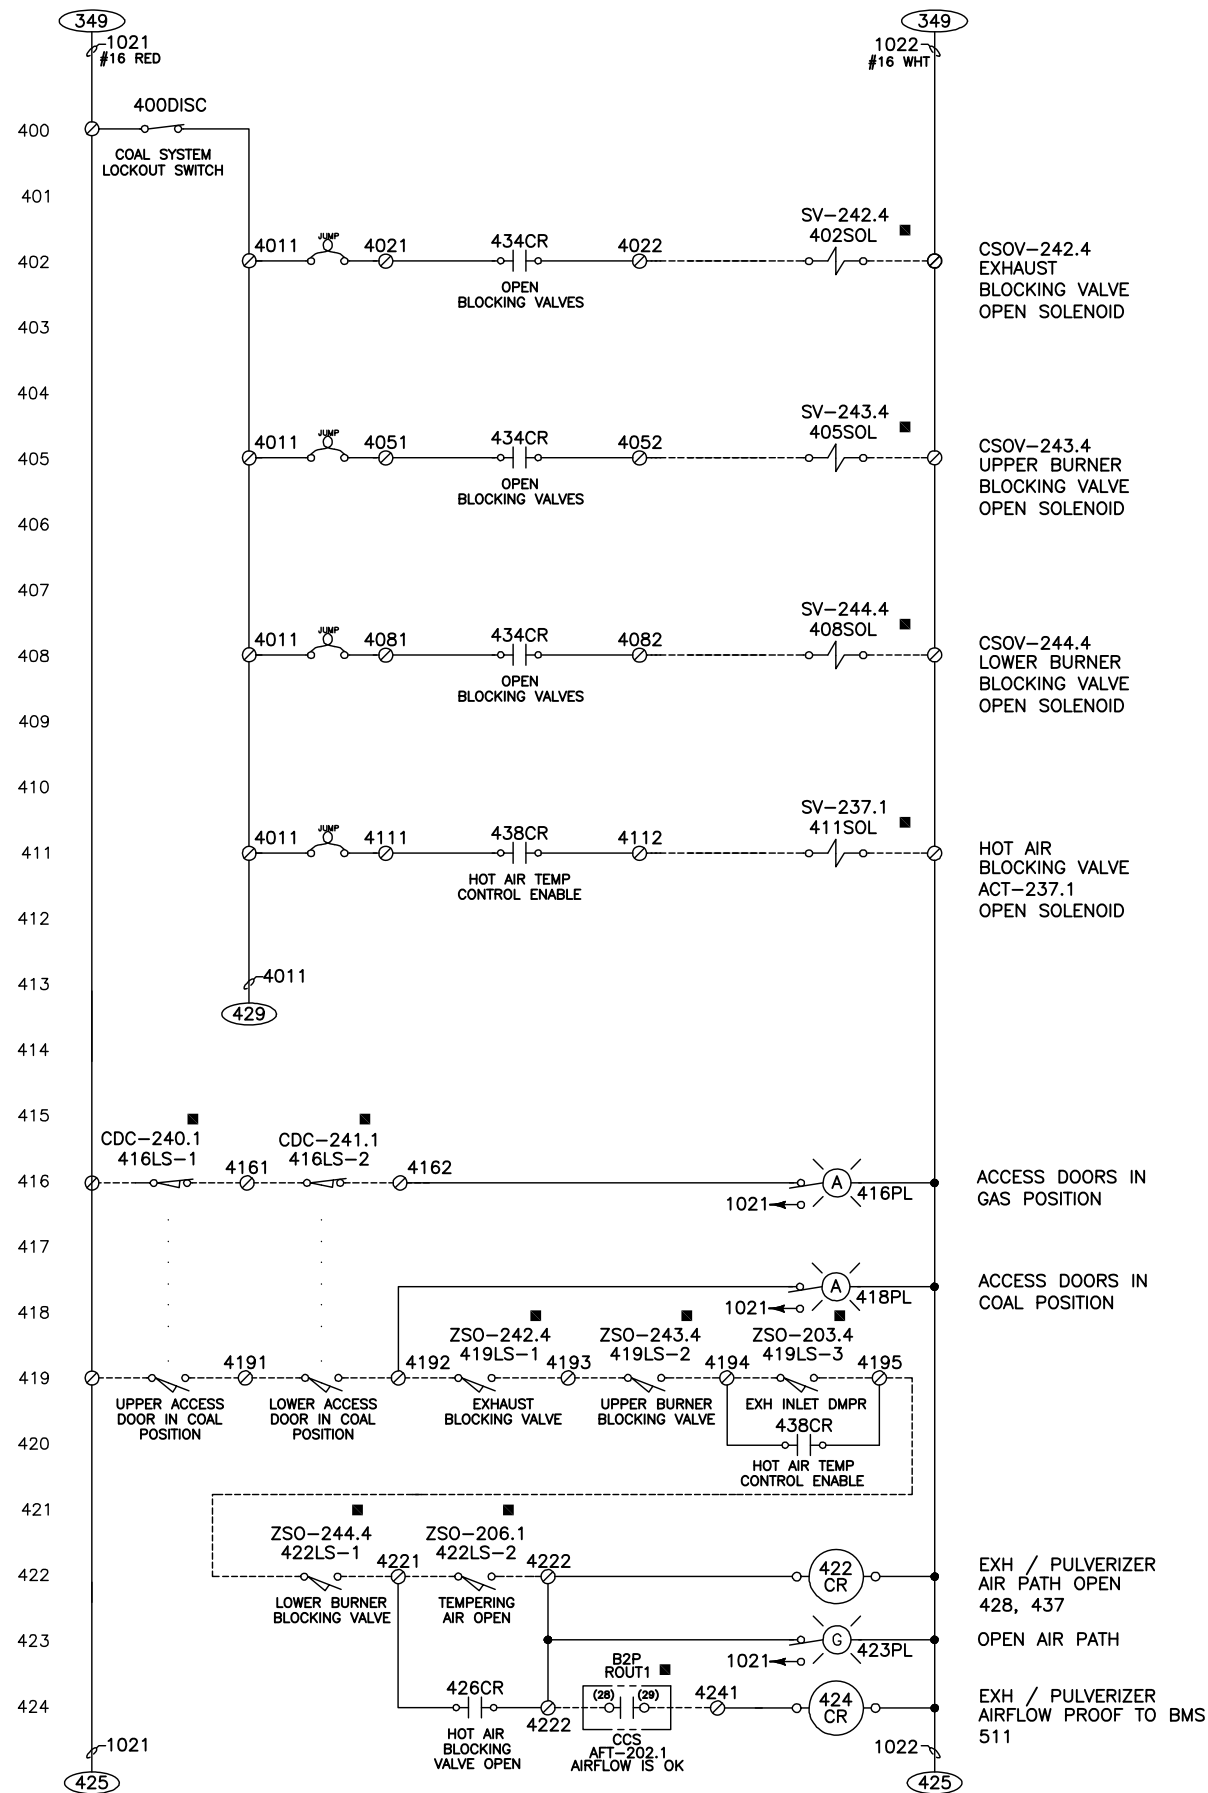

THIS DRAWING HAS BEEN UPDATED FOR
DULUTH ENERGY FROM VENDOR PRINTS
& DOES NOT NECESSARILY CONFORM TO
EGAN CO. DRAFTING CODES &
STANDARDS

D:\District Energy\Duluth Fireye Panels\424997-1_05.dwg 1/19/2017 7:47:43 PM

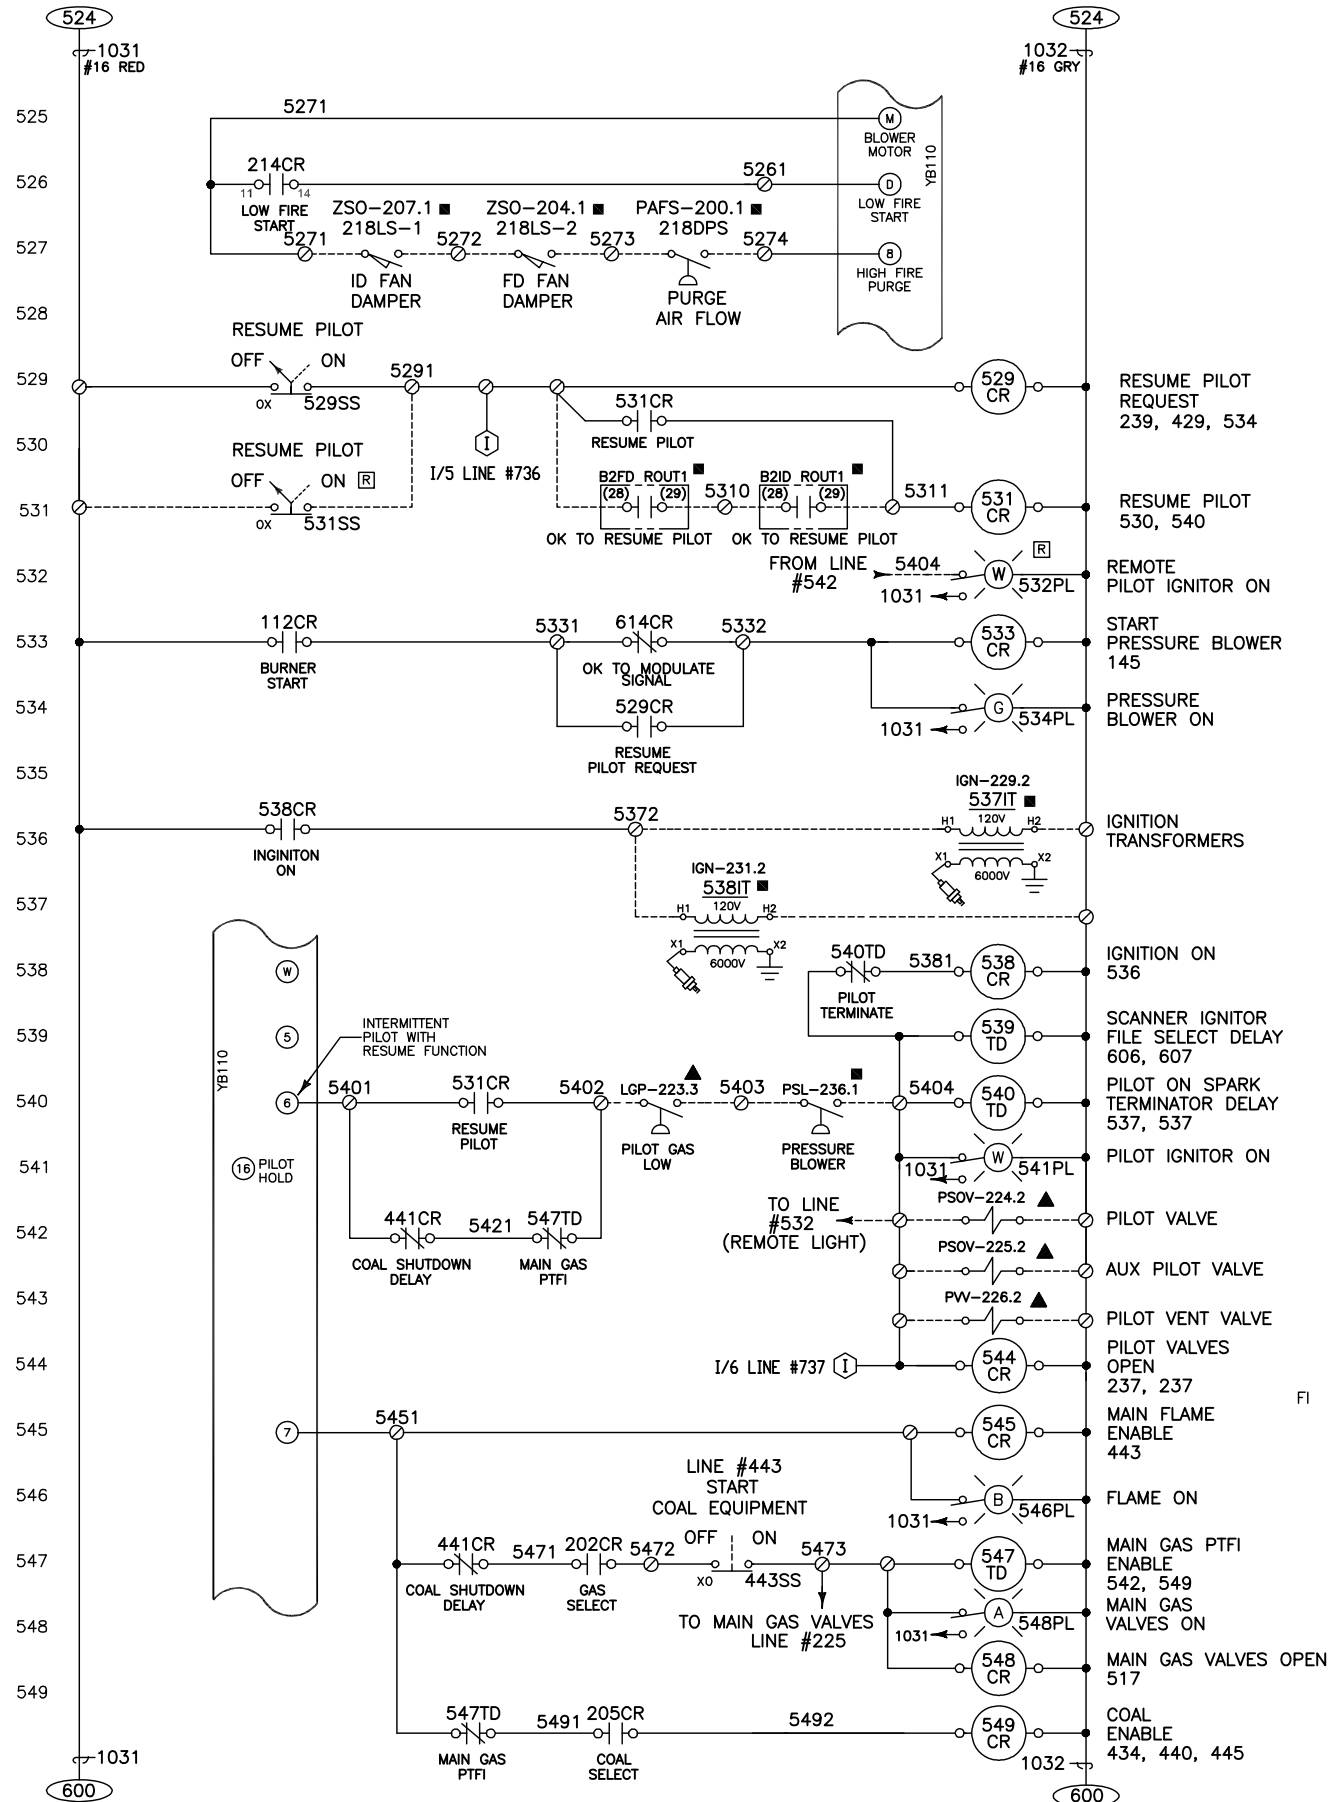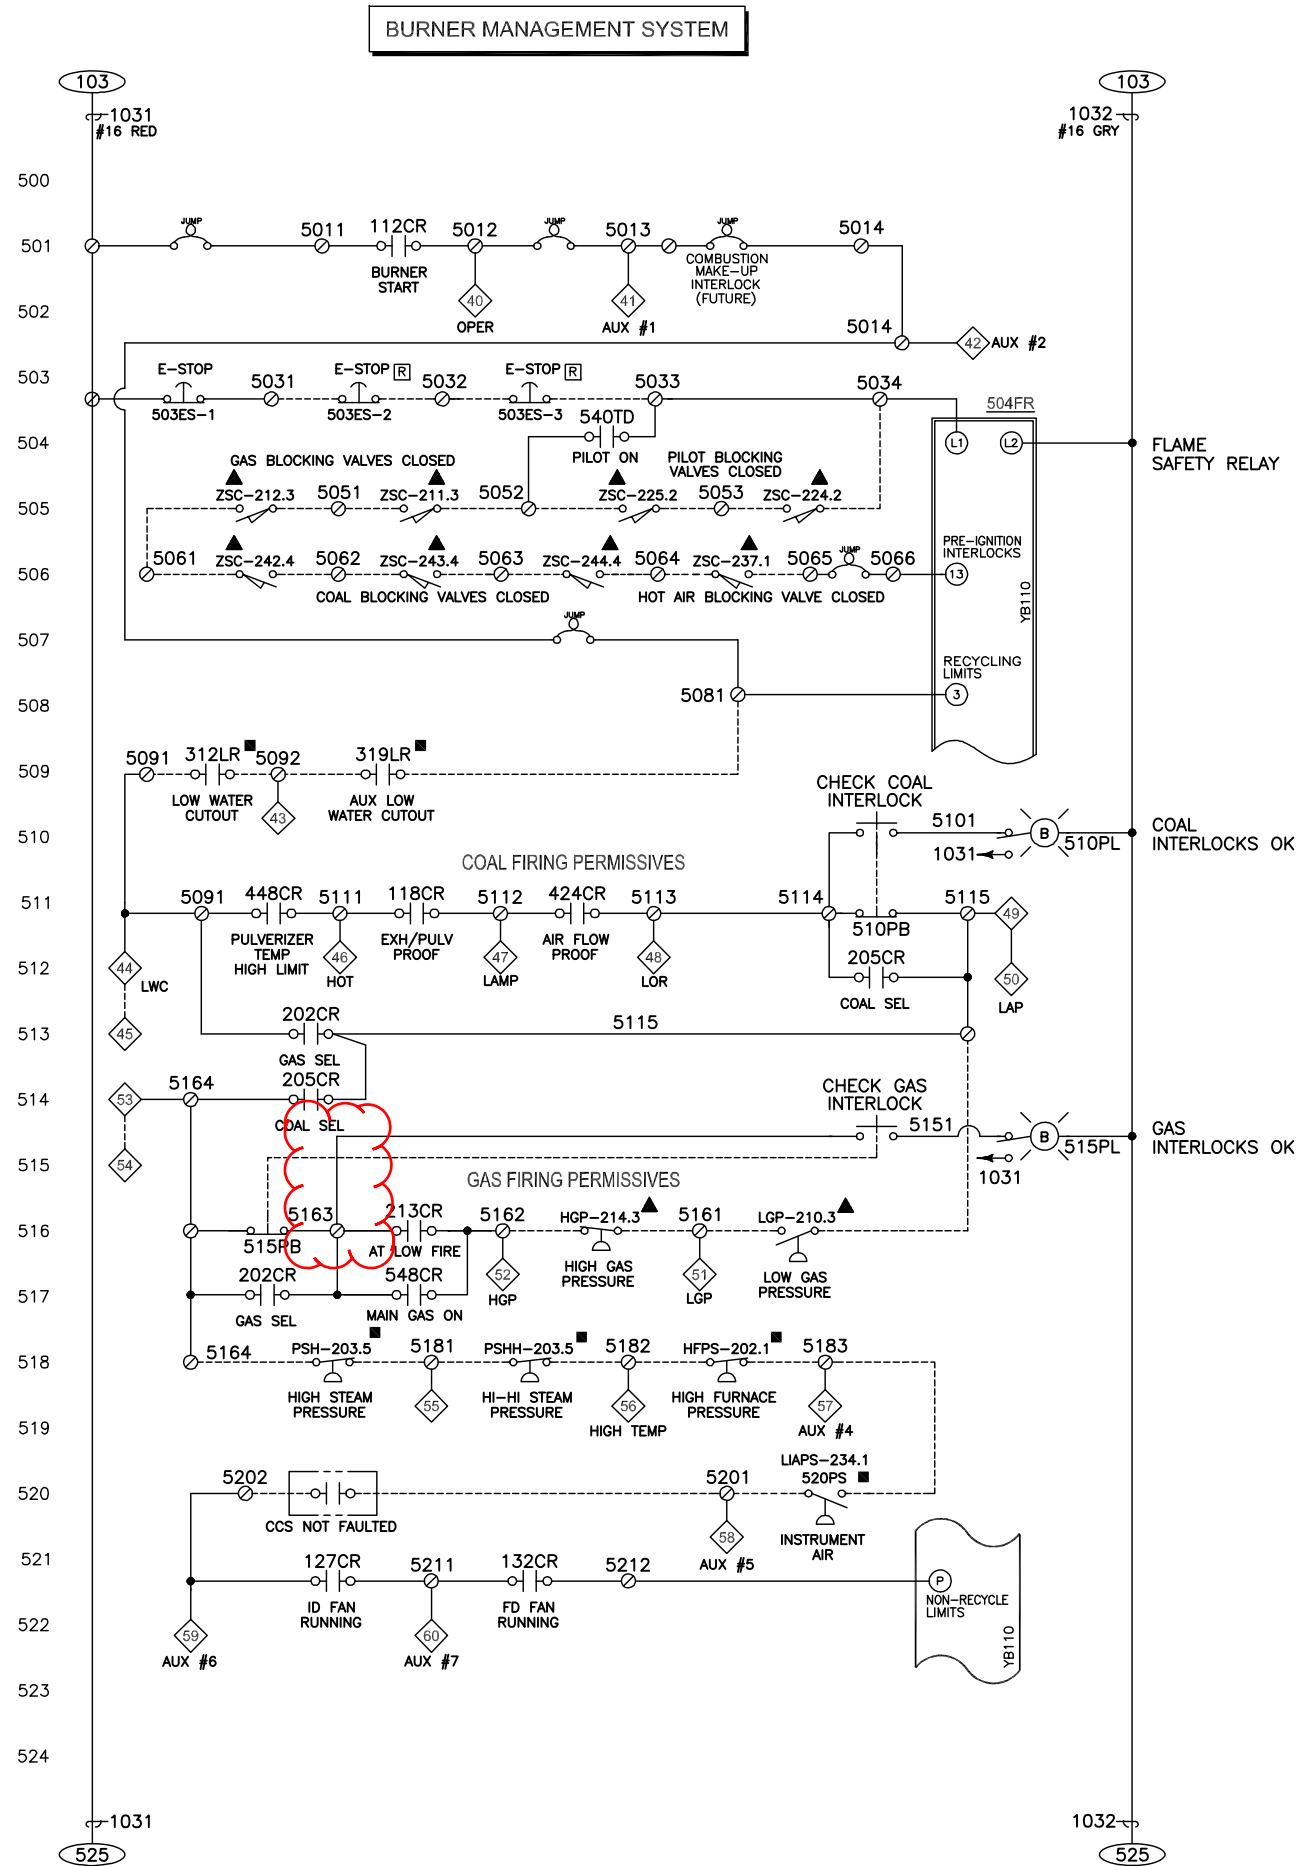

THIS DRAWING HAS BEEN UPDATED FOR
DULUTH ENERGY FROM VENDOR PRINTS
& DOES NOT NECESSARILY CONFORM TO
EGAN CO. DRAFTING CODES &
STANDARDS



Building on Promises Kept
mechanical • electrical • systems

EGAN COMPANY 2016
THIS DRAWING AND ITS
CONTENTS ARE THE
CONFIDENTIAL PROPERTY
OF EGAN COMPANY.
NEITHER THIS DRAWING,
ITS CONTENTS NOR ITS
DESIGN CONCEPTS MAY
BE USED WITHOUT THE
WRITTEN CONSENT OF
EGAN COMPANY.

**DULUTH ENERGY
SYSTEMS**



ONE LAKE PLACE DRIVE
DULUTH, MN 55802-1189
p: 763.544.4131 f: 763.595.4380
www.eganco.com

JOB NO.: 424997
DRAWN BY: MDT
APPROVED: M. THOMAS

DATE
11/14/16
08/31/16
01/19/17


DESCRIPTION
MOVED TO 5163
PUSHBUTTON WIRE

REV
C ASBUILT
B 424CR CONTACT ADDED
D 424CR CONTACT ADDED

REV
D



DWG. NO.
424997-1_05

SHEET NO.
05

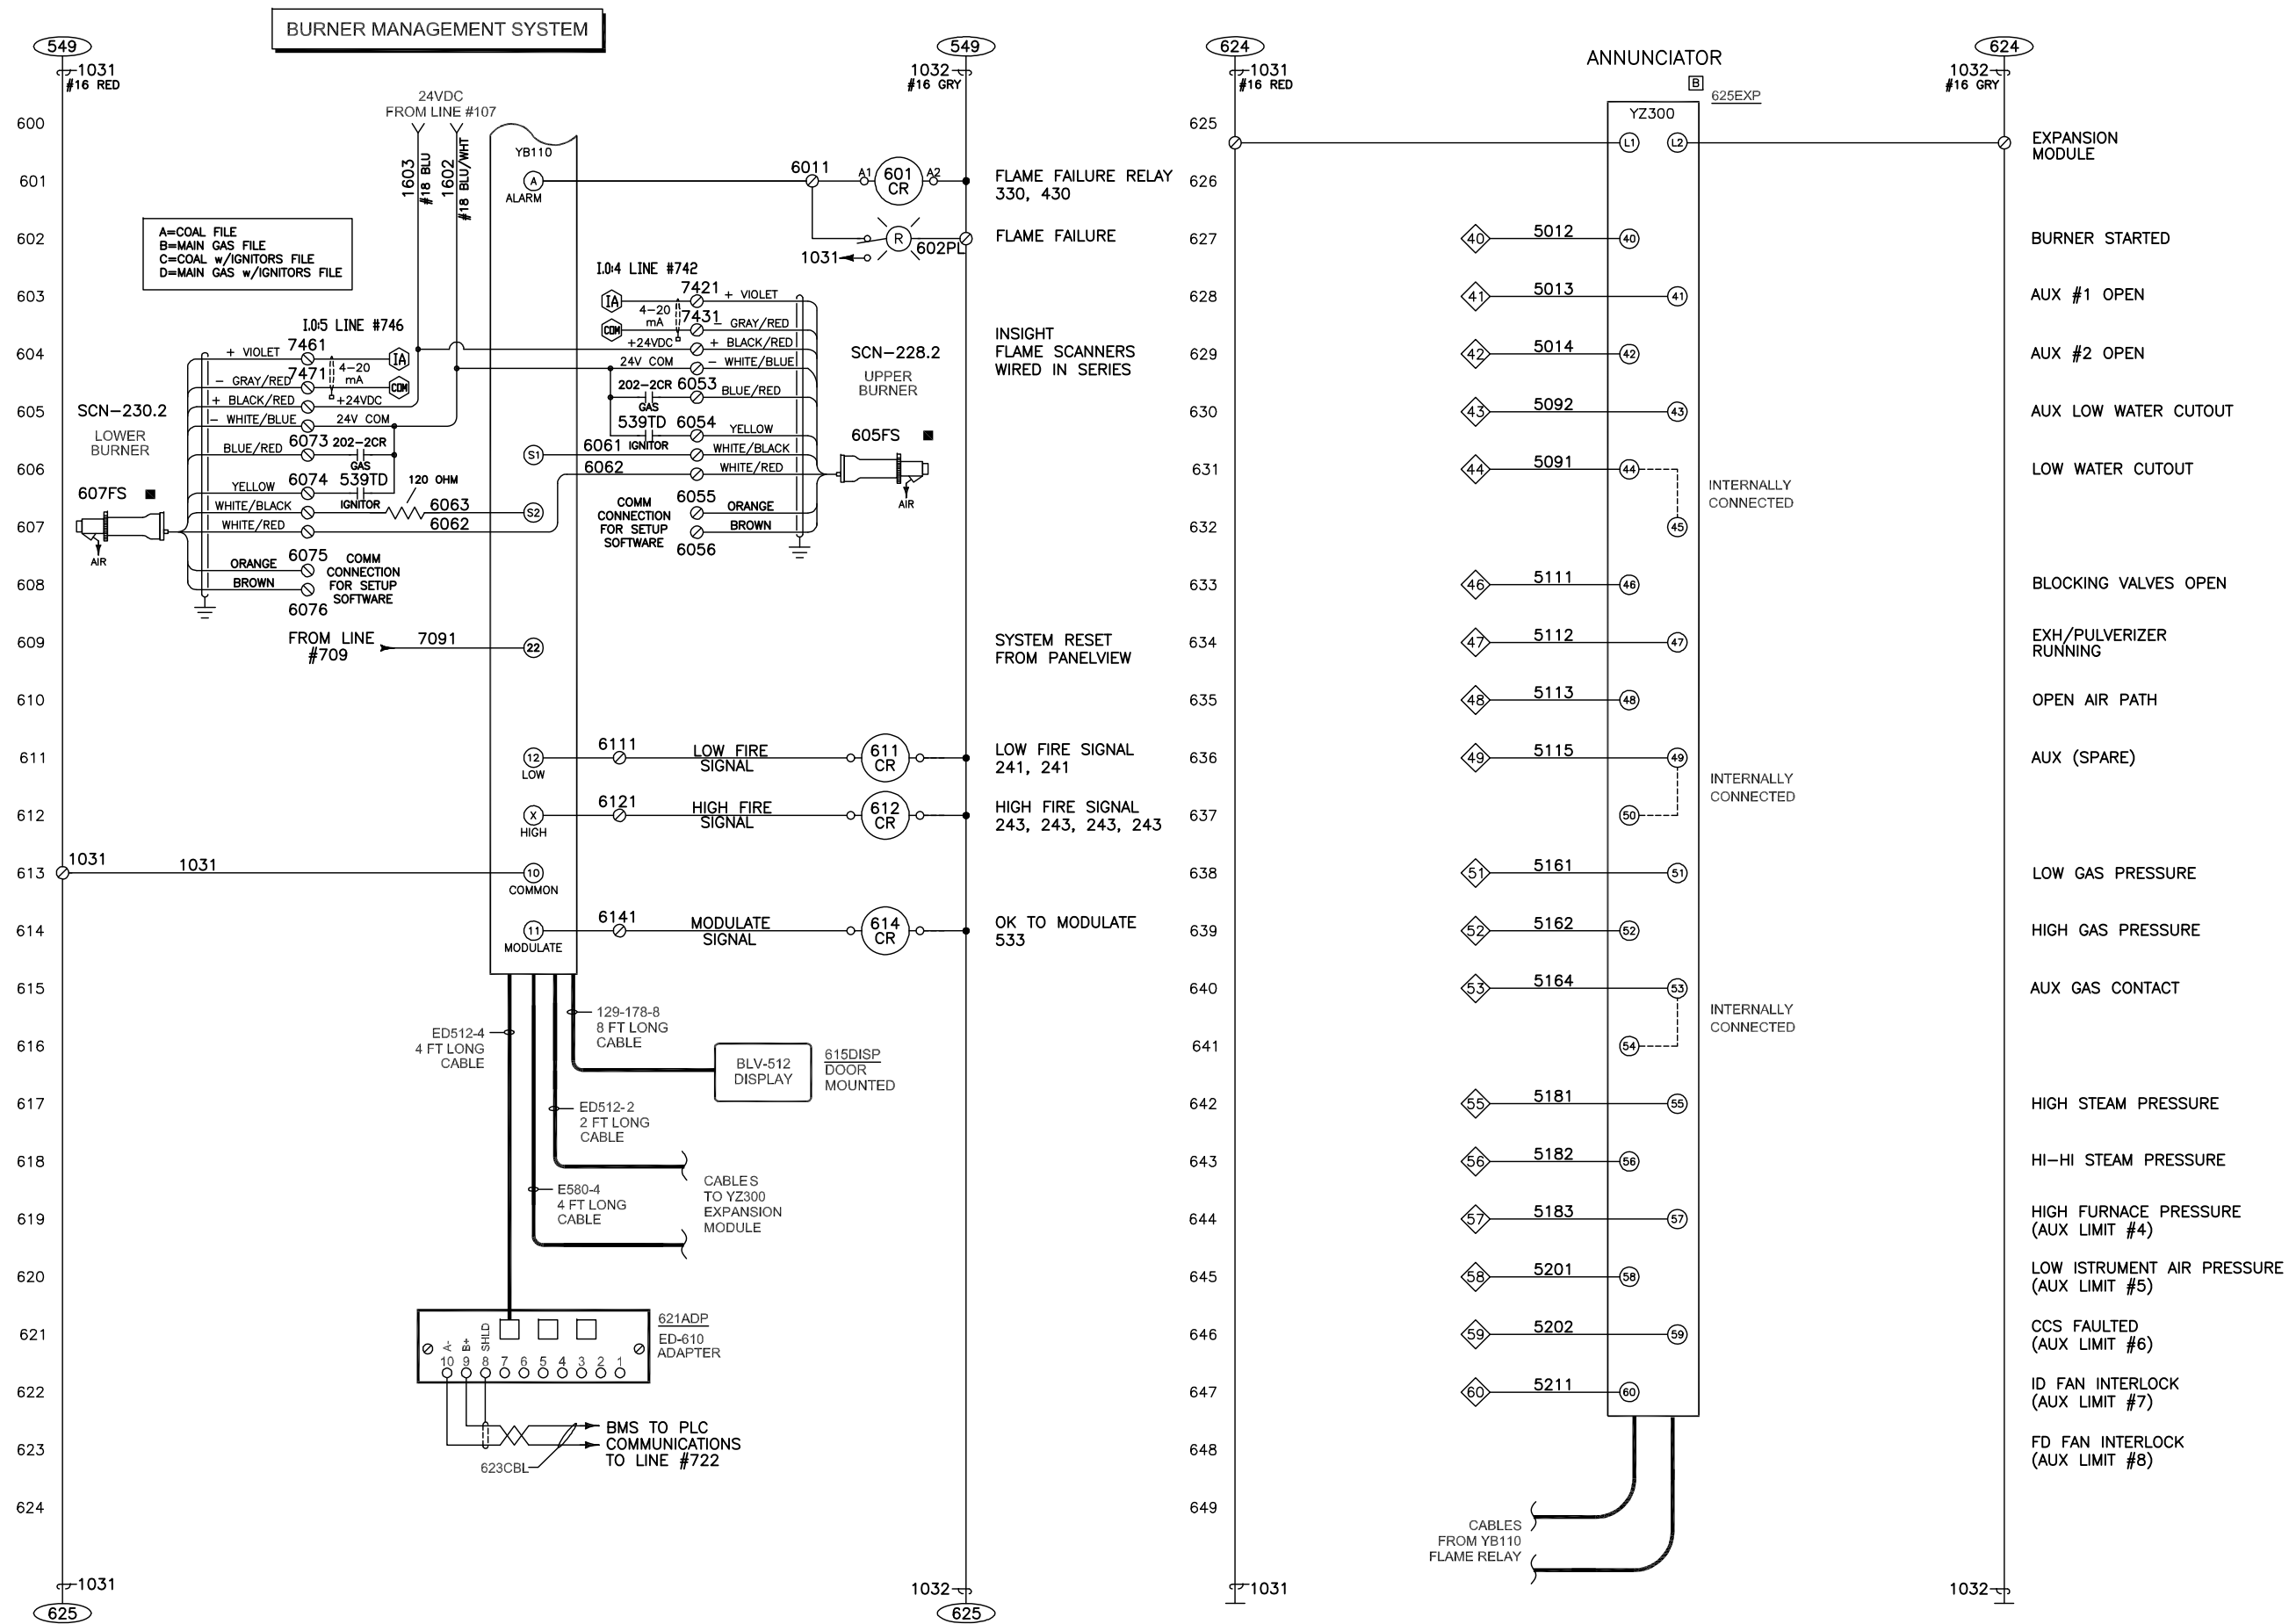

THIS DRAWING HAS BEEN UPDATED FOR
DULUTH ENERGY FROM VENDOR PRINTS
& DOES NOT NECESSARILY CONFORM TO
EGAN CO. DRAFTING CODES &
STANDARDS.

D:\District Energy\Duluth Fireye Panels\Drawings\424997-1_07.dwg 11/14/2016 11:01:31 AM

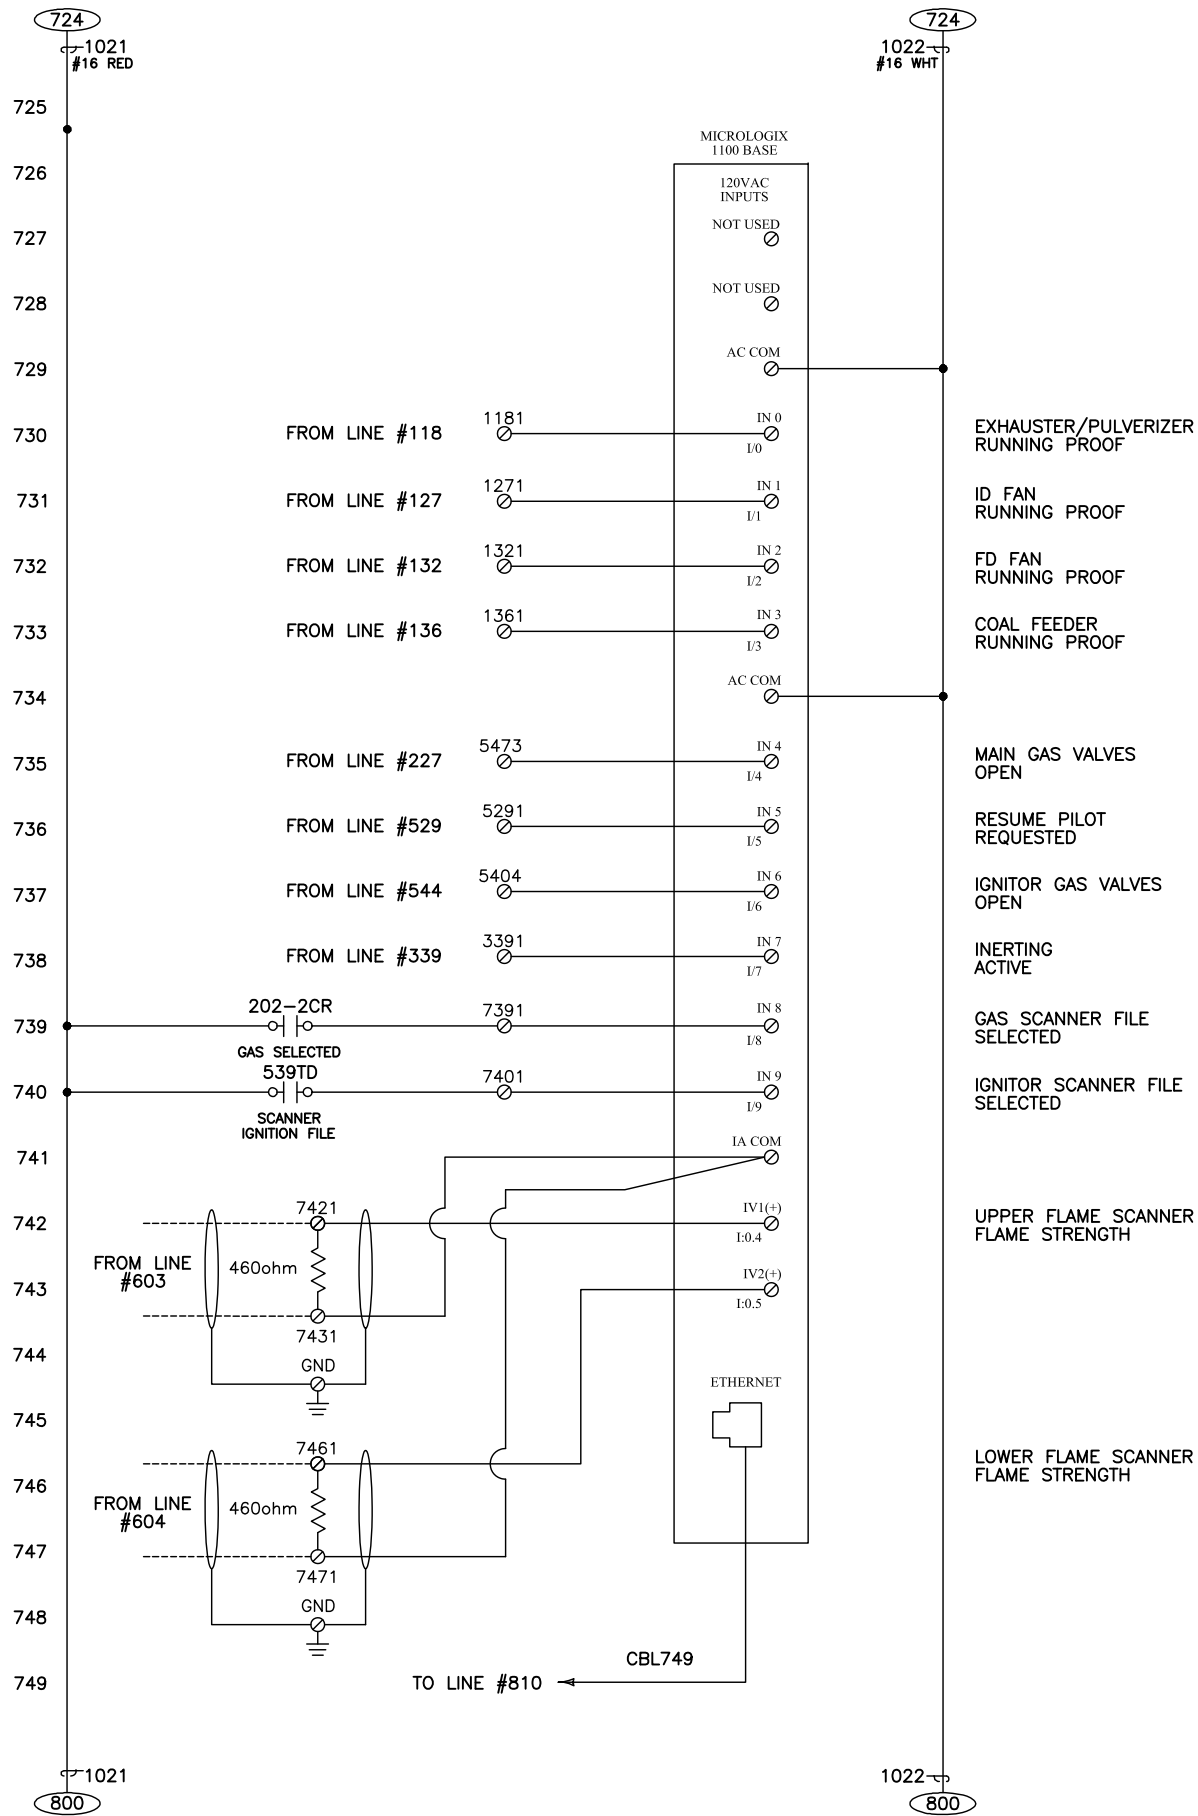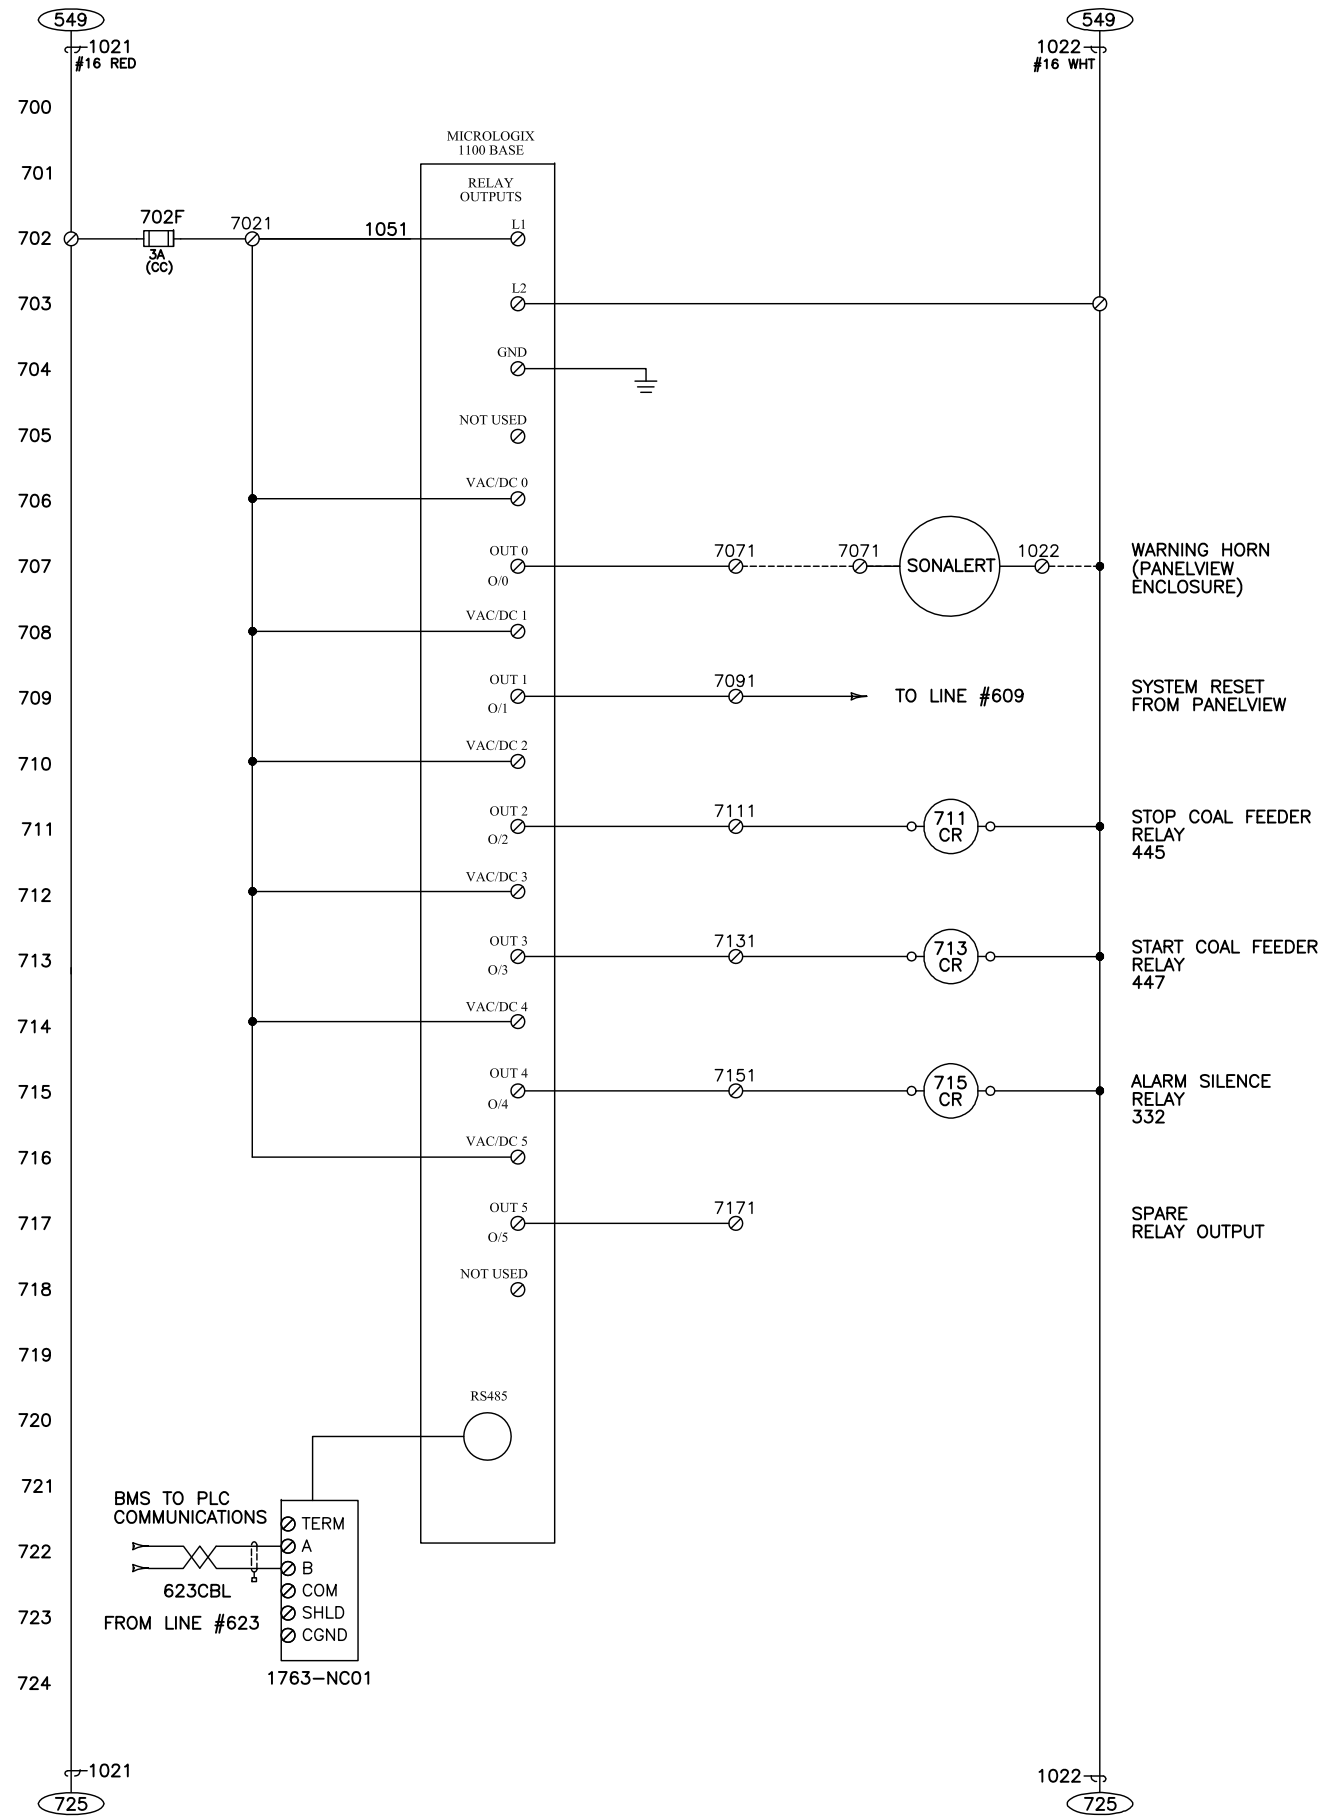

THIS DRAWING HAS BEEN UPDATED FOR
DULUTH ENERGY FROM VENDOR PRINTS
& DOES NOT NECESSARILY CONFORM TO
EGAN CO. DRAFTING CODES &
STANDARDS



Building on Promises Kept
mechanical • electrical • systems

EGAN COMPANY 2016
THIS DRAWING AND ITS
CONTENTS ARE THE
CONFIDENTIAL PROPERTY
OF EGAN COMPANY.
NEITHER THIS DRAWING,
ITS CONTENTS NOR ITS
DESIGN CONCEPTS MAY
BE USED WITHOUT THE
WRITTEN CONSENT OF
EGAN COMPANY.

DULUTH ENERGY
SYSTEMS



ONE LAKE PLACE DRIVE
DULUTH, MN 55802-1189
p: 763.544.4131 | f: 763.595.4380 | www.eganco.com


JOB NO.: 424997
DRAWN BY: MDT
APPROVED: M. THOMAS

REV	C	A	B	DESCRIPTION	DATE	APPROVED
A				ASBUILT BURNER PANEL UPGRADE	11/14/16 08/16/16	MDT MDT MDT

PLC IO MODULES
BURNER MANAGEMENT SYSTEM
DULUTH STEAM BOILER #2

DWG. NO.
424997-1_07

SHEET NO.
07

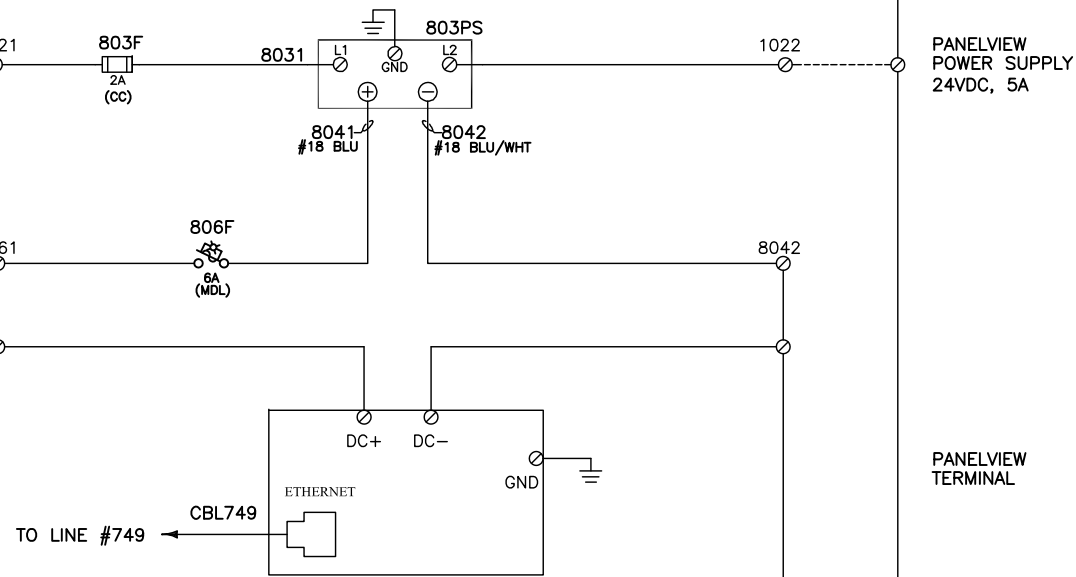

E·G·A·N
Building on Promises Kept
mechanical • electrical • systems

© EGAN COMPANY 2016
THIS DRAWING AND ITS
CONTENTS ARE THE
CONFIDENTIAL PROPERTY
OF EGAN COMPANY.
NEITHER THIS DRAWING,
ITS CONTENTS NOR ITS
DESIGN CONCEPTS MAY
BE USED WITHOUT THE
WRITTEN CONSENT OF
EGAN COMPANY.

**DULUTH ENERGY
SYSTEMS**

LAKE PLACE DRIVE
1, MN 55802-1189

44 4131 F: 763 595 4380



JOB NO.:	424997
DRAWN BY:	MDT
APPROVED:	M. THOMAS
MDT	08/16/16
APPROVED	DATE


ELECTRICAL SCHEMATIC BURNER MANAGEMENT SYSTEM DULUTH STEAM BOILER #2		MAIN PANEL	
REV			
A	BURNER PANEL UPGRADE		MDT
REV	DESCRIPTION		DRAWN

DWG. NO.
424997-1_08


SHEET NO.

08


D:\District Energy\Duluth Fireye Panels\Drawings\424997-1_09.dwg 11/4/2016 7:10:25 AM

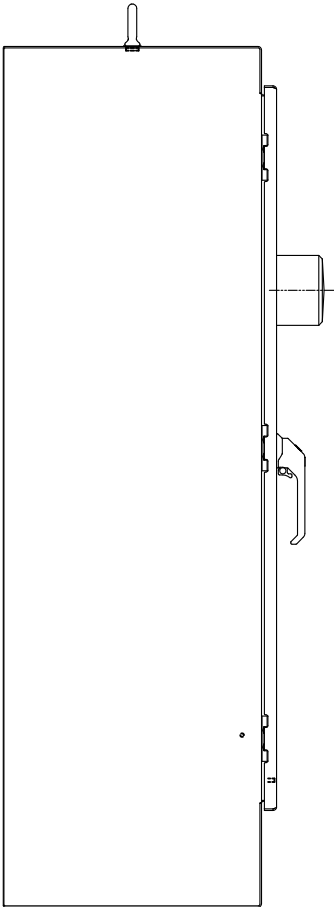


LEFT SIDE VIEW

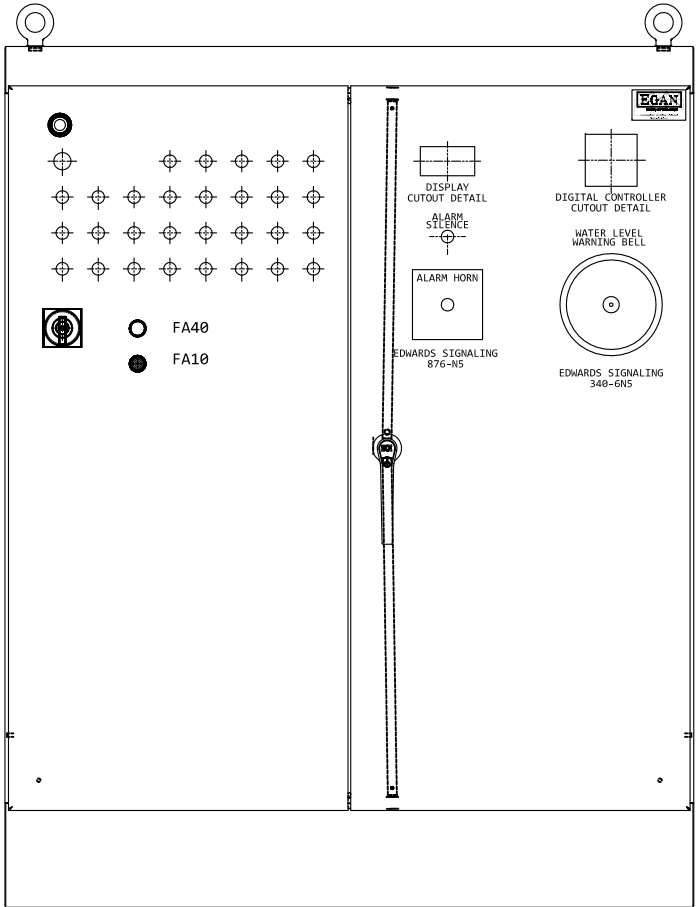


FRONT VIEW

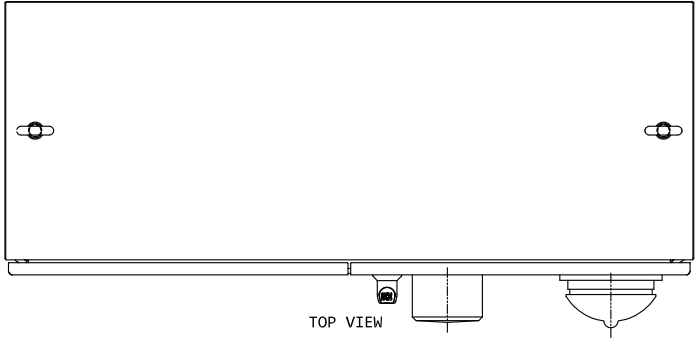

TOP VIEW

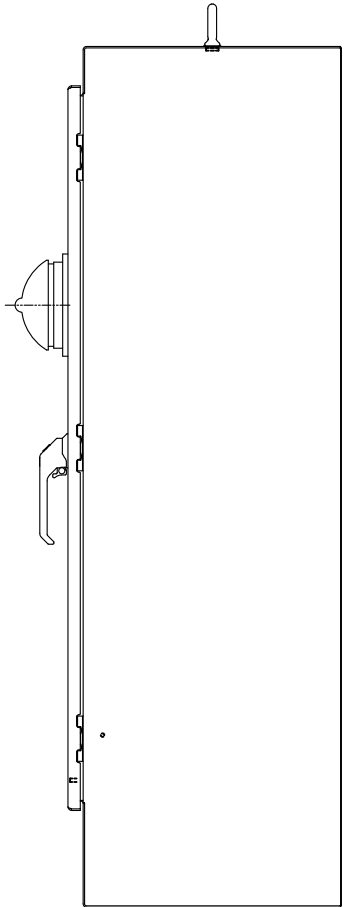

RIGHT SIDE VIEW

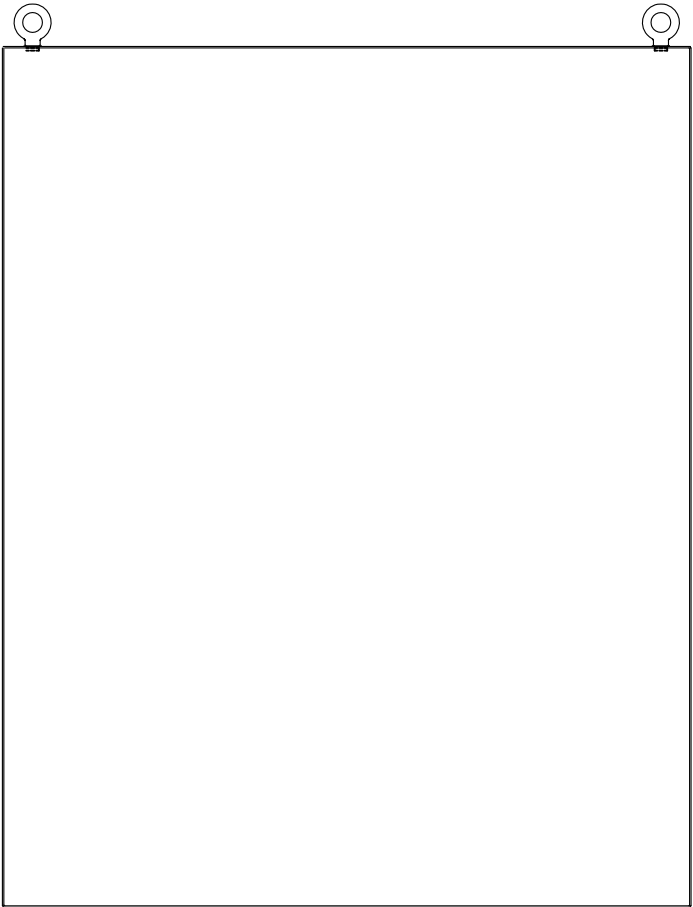

BACK VIEW



**DULUTH ENERGY
SYSTEMS**

ONE LAKE PLACE DRIVE
DULUTH, MN 55802-1189

7625 Boone Avenue North | Brooklyn Park, MN 55428 | p: 763.544.4131 | f: 763.595.4380 | www.eganco.com

JOB NO. : 424997		MAIN PANEL	
DRAWN BY : DJN			
APPROVED : M. THOMAS			
REV	A	BURNER PANEL UPGRADE	DESCRIPTION
		DJN	MDT
		DRVN	APPROVED
			DATE
			08/16/16


DWG. NO.	424997-1_09
SHEET NO.	09

© EGAN COMPANY 2016
THIS DRAWING AND ITS
CONTENTS ARE THE
CONFIDENTIAL PROPERTY
OF EGAN COMPANY.
NEITHER THIS DRAWING,
ITS CONTENTS NOR ITS
DESIGN CONCEPTS MAY
BE USED WITHOUT THE
WRITTEN CONSENT OF
EGAN COMPANY.



Building on Promises Kept
mechanical • electrical • systems

D:_District Energy\Duluth Fireye Panels\Drawings\424997-1_10.dwg 11/14/2016 11:47:36 AM

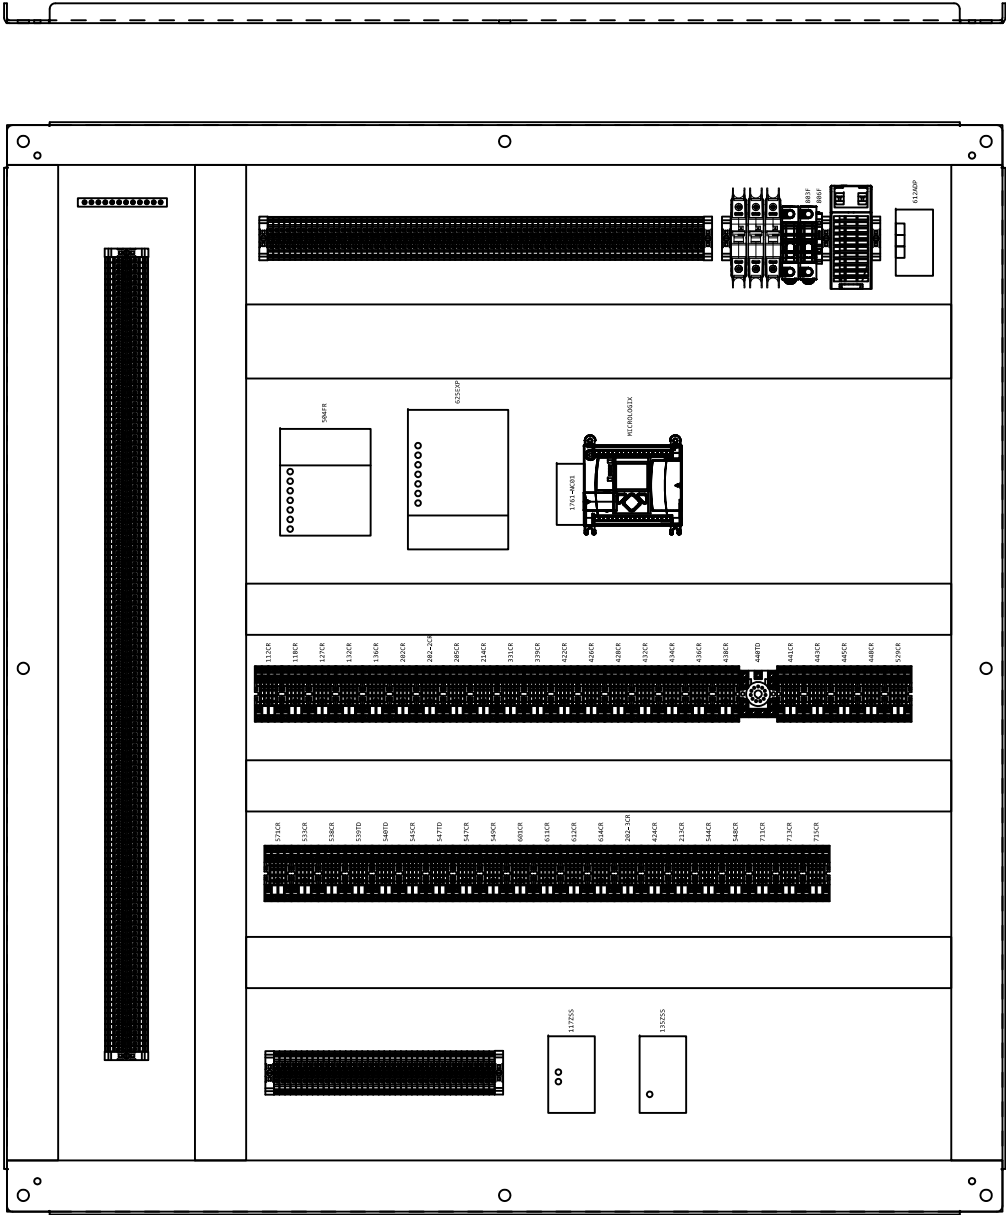

FULL PANEL FRONT VIEW

SAGINAW CONTROL & ENGINEERING
SCE-60P48F1



ONE LAKE PLACE DRIVE
DULUTH, MN 55802-1189

DULUTH ENERGY
SYSTEMS

JOB NO. : 424997
DRAWN BY : DJN
APPROVED : M. THOMAS

MAIN PANEL		DATE	
MDT	MDT	11/14/16	DATE
DJN	MDT	08/16/16	DATE
DRVN	APPROVED		

REV	DESCRIPTION
C	ASBUILT
A	BURNER PANEL UPGRADE
REV	

DWG. NO.
424997-1_10

SHEET NO.
10


© EGAN COMPANY 2016
THIS DRAWING AND ITS
CONTENTS ARE THE
CONFIDENTIAL PROPERTY
OF EGAN COMPANY.
NEITHER THIS DRAWING,
ITS CONTENTS NOR ITS
DESIGN CONCEPTS MAY
BE USED WITHOUT THE
WRITTEN CONSENT OF
EGAN COMPANY.




Building on Promises Kept
mechanical • electrical • systems

7625 Boone Avenue North | Brooklyn Park, MN 55428 | p: 763.544.4131 | f: 763.593.4380 | www.eganco.com


D:_District Energy\Duluth Fireye Panels\Drawings\424997-1_11.dwg 11/4/2016 7:12:23 AM

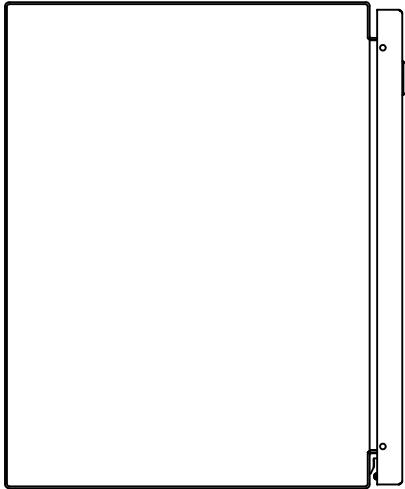


LEFT SIDE VIEW

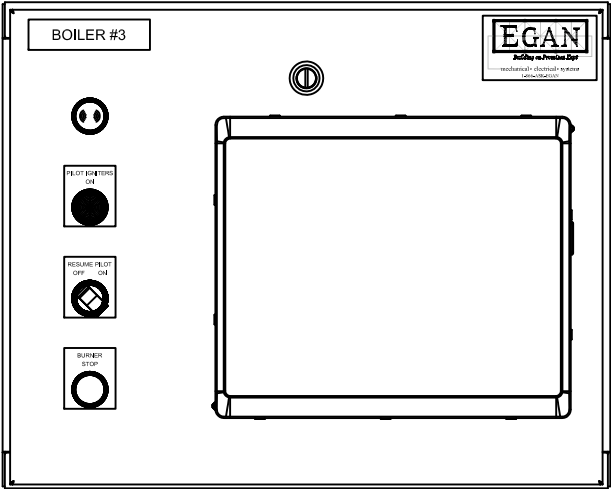


FRONT VIEW

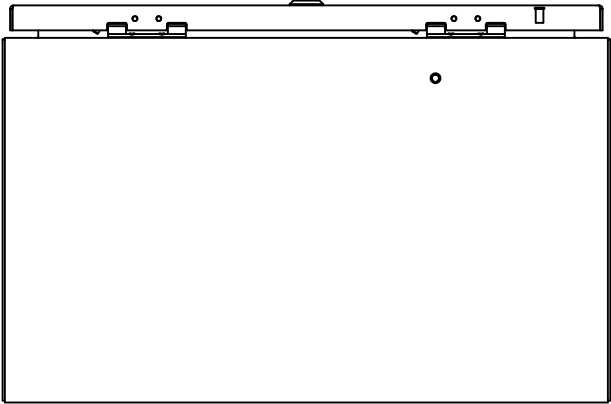


BOTTOM VIEW

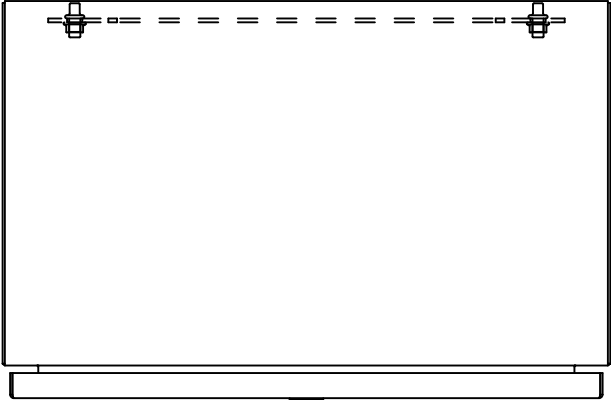

TOP VIEW

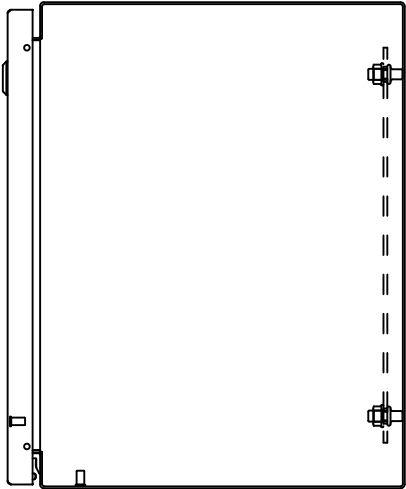


RIGHT SIDE VIEW

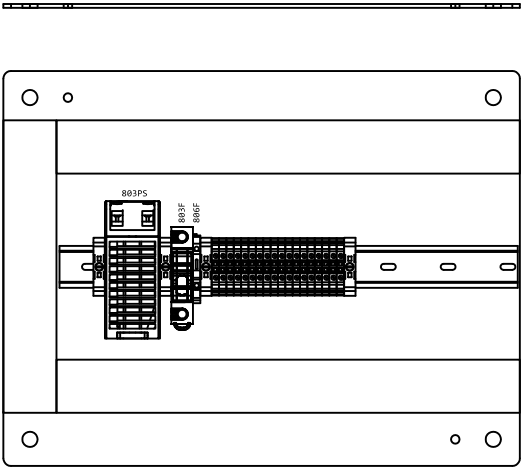

SUBPANEL FRONT VIEW

SAGINAW CONTROL & ENGINEERING
SCE-20EL1612LP

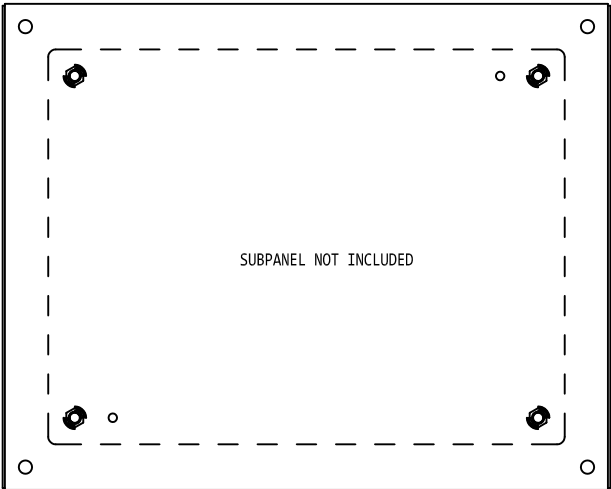

EXTERNAL REAR VIEW



DULUTH ENERGY
SYSTEMS

ONE LAKE PLACE DRIVE
DULUTH, MN 55802-1189

7625 Boone Avenue North | Brooklyn Park, MN 55428 | p: 763.544.4131 | f: 763.595.4380 | www.eganco.com

HMI PANEL LAYOUT BURNER MANAGEMENT SYSTEM DULUTH STEAM BOILER #2	JOB NO. : 424997		DRAWN BY : DJN		APPROVED : M. THOMAS	
	HMI PANEL		DATE		DATE	
	REV		DESCRIPTION		DESCRIPTION	
	A		BURNER PANEL UPGRADE		BURNER PANEL UPGRADE	


DWG. NO.	424997-1_11
SHEET NO.	11

EGAN COMPANY 2016
THIS DRAWING AND ITS
CONTENTS ARE THE
CONFIDENTIAL PROPERTY
OF EGAN COMPANY.
NEITHER THIS DRAWING,
ITS CONTENTS NOR ITS
DESIGN CONCEPTS MAY
BE USED WITHOUT THE
WRITTEN CONSENT OF
EGAN COMPANY.




Building on Promises Kept
mechanical • electrical • systems


Main Panel Button Layout

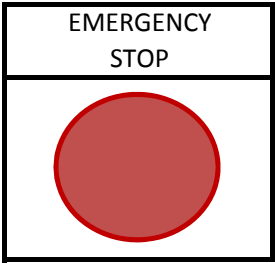


503ES-1

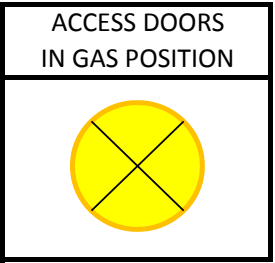


416PL

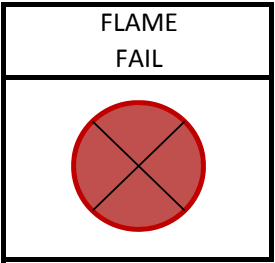


602PL

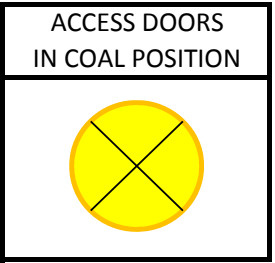


418PL

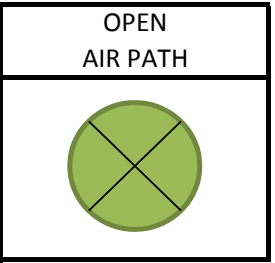


423PL

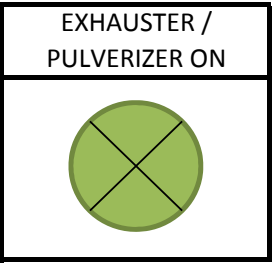


119PL

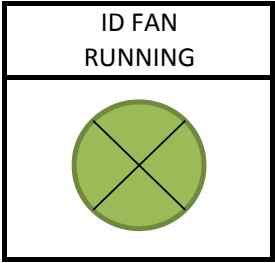


128PL

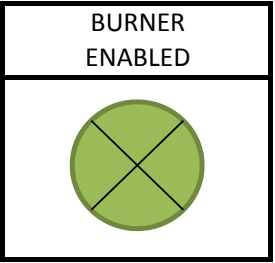


113PL

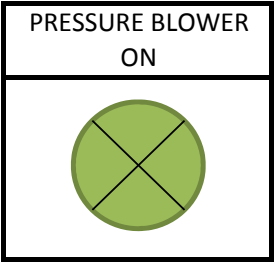


534PL

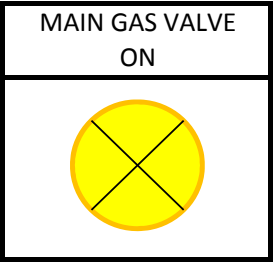


548PL

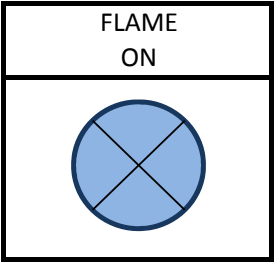


546PL

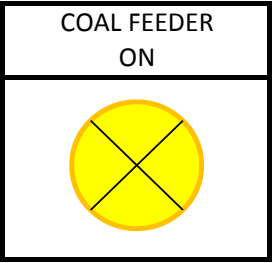


137PL

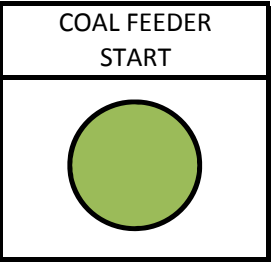


445PB-2

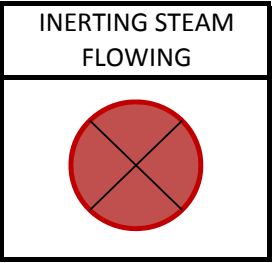


347PL

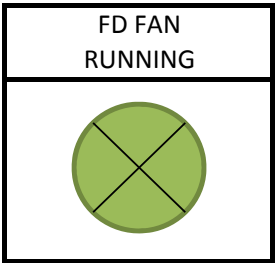


133PL

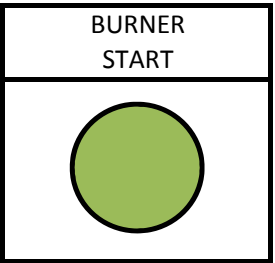


112PB-3

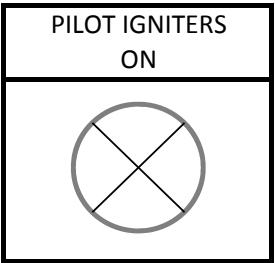


541PL

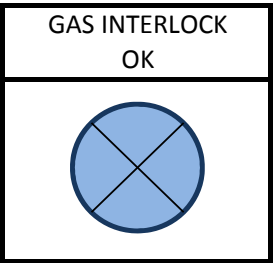


515PL

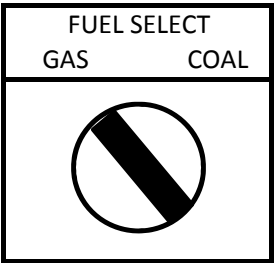


202SS

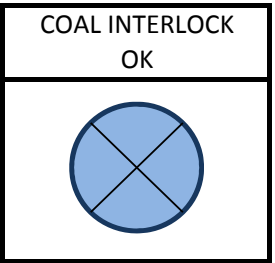


510PL

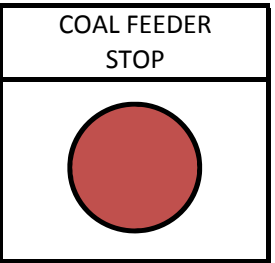


445PB-1

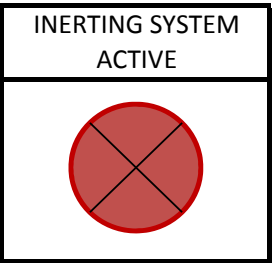


340PL

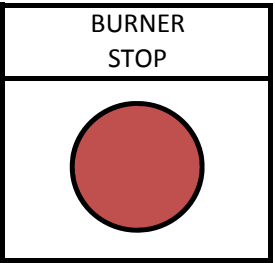


112PB-1

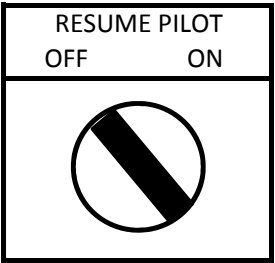


529SS

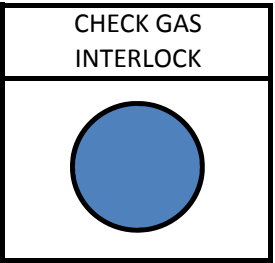


515PB

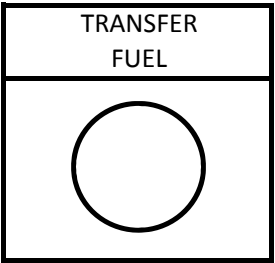


442PB

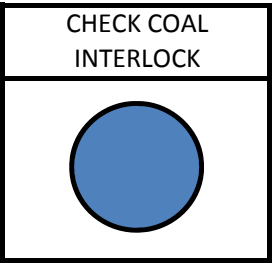

510PB

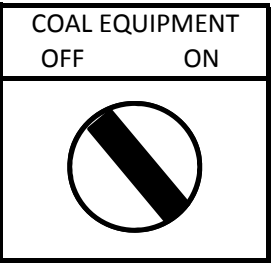


443SS

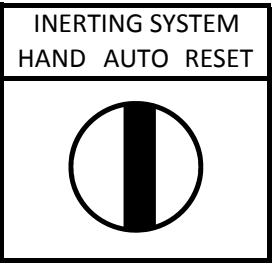


339SS

Sonalert

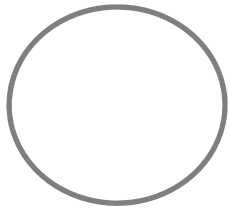

PILOT IGNITERS
ON

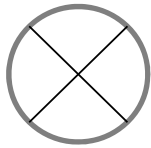


532PL

RESUME PILOT
OFF ON



531SS

BURNER
STOP

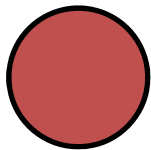


112PB-2

Panelview



Exit Door 1

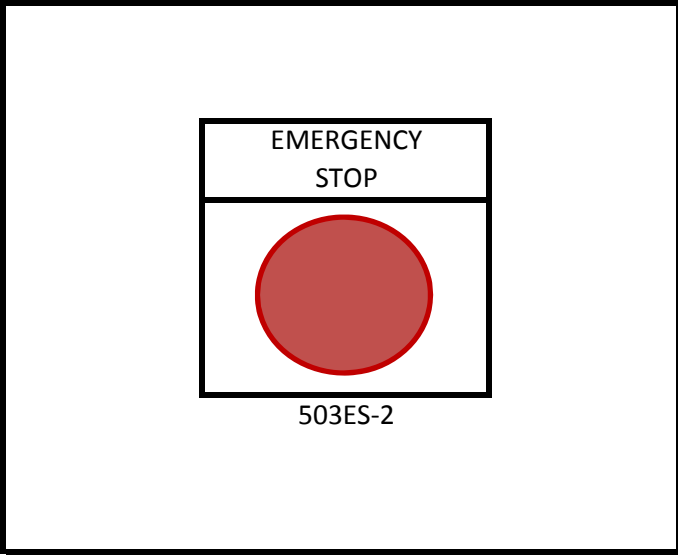

Exit Door 2

