

DOCUMENT 00 00 12

ADDENDUM NO. 2
June 2, 2023

2023 RECONSTRUCT TERMINAL BUILDING
AIP No. 3-27-0025-20-2023
SKY HARBOR AIRPORT
DULUTH, MN

SEH No. DULAI 172133

From: Short Elliott Hendrickson Inc.
3535 Vadnais Center Drive
St. Paul, MN 55110-3507
651.490.2000

To: Document Holders

DOCUMENT HOLDERS on the above-named project are hereby notified that this document shall be appended to, take precedence over and become part of the original bidding documents dated May 17, 2023 and Addenda dated May 31, 2023 for this work. Bids submitted for the construction of this work shall conform to this document.

This addendum consists of 3 pages and 00 01 00 Table of Contents (6 pages), 00 52 00 Standard Form of Agreement (8 pages), 01 45 10 Quality Control for Building Construction (8 pages), 32 13 10 Concrete Pavement (6 pages), 32 92 00 Landscaping (2 pages), 32 93 12 Plant Installation and Establishment (3 pages), T-905 Topsoil (4 pages), Appendix H – Asbestos Inspection and Regulated Waste Assessment Report (28 pages), and Drawing Nos. G0.01, G1.10, G2.00, G2.10, C2.00, C2.10, C2.20, C3.00, C4.00, C5.00, C5.01, C5.02, C5.03, A003, A004, A100, A101, A102, A200, A201, A300, A500, S001, S101, S201, S501, S502, and S504.

Contractors shall be aware of upcoming Addendum No.3, that will be posted on Monday, June 5th addressing minor revisions to the structural & architectural plan sheets.

Pre-Bid Meeting Recording:

1. ☐ [DYT Terminal Building - PreBid Meeting](#)

- Link can be provided separately. Reach out to the Project Manager.

Changes to Bidding Requirements:

2. Document 00 01 00 – Table of Contents, DELETE in its entirety and REPLACE with attached specification.
3. Document 00 52 00 – Standard Form of Agreement, DELETE in its entirety and REPLACE with attached specification.

Changes to Specifications:

4. Section 01 45 10 – Quality Control for Building Construction, DELETE in its entirety and REPLACE with attached specification.
5. Section 32 13 10 – Concrete Pavement, ADD in its entirety.
6. Section 32 92 00 – Landscaping, DELETE in its entirety and REPLACE with attached specification.
7. Section 32 93 12 – Plant Installation and Establishment, ADD in its entirety.
8. Section T-905 – Topsoil, DELETE in its entirety and REPLACE with attached specification.

Changes to Appendix

9. Appendix H – Asbestos Inspection and Regulated Waste Assessment Report, ADD in its entirety.

Changes to Drawings:

10. Drawing G0.01 – Table of Contents, DELETE in its entirety and REPLACE with the attached revised drawing.

11. Drawing G1.10 – Construction Phasing Plan, DELETE in its entirety and REPLACE with the attached revised drawing.

- Updated general notes.

12. Drawing G2.00 – General Notes, DELETE in its entirety and REPLACE with the attached revised drawing.

- Updated general notes.

13. Drawing G2.10 – Statement of Estimated Quantities, DELETE in its entirety and REPLACE with the attached revised drawing.

- Updated Statement of Quantities Table.
- Updated SEQ notes.

14. Drawing C2.00 – Demolition Plan (Building), DELETE in its entirety and REPLACE with the attached revised drawing.

- Clarified plan notes.

15. Drawing C2.10 – Demolition Plan (Site), DELETE in its entirety and REPLACE with the attached revised drawing.

- Clarified plan notes.
- Added concrete pavement removal on existing hangar approach.

16. Drawing C2.20 – Interim Terminal Facility & Temporary Setup, DELETE in its entirety and REPLACE with the attached revised drawing.

- Clarified plan notes.
- Corrected hatch pattern in legend
- Jobsite camera notes
- Fueling monitor equipment notes

17. Drawing C3.00 – Typical Sections, DELETE in its entirety and REPLACE with the attached revised drawing.

- Clarified plan notes.
- Add concrete pavement typical section.

18. Drawing C4.00 – Pavement Plan, DELETE in its entirety and REPLACE with the attached revised drawing.

- Added additional concrete pavement area.

19. Drawing C5.00 – Grading Plan, DELETE in its entirety and REPLACE with the attached revised drawing.

- Added plan elevations.

20. Drawing C5.01 – Grading Plan, DELETE in its entirety and REPLACE with the attached revised drawing.

- Added plan elevations.

21. Drawing C5.02 – Grading Plan, DELETE in its entirety and REPLACE with the attached revised drawing.

- Added plan elevations.

22. Drawing C5.03 – Landscaping Plan, ADD in its entirety.

23. DELETE the following drawings and REPLACE in their entirety with the attached revised drawings:

- A003, A004, A100, A101, A102, A300, A500, S001, S101, S201, S501, S502, and S504.

24. ADD drawings A200 and A201 in their entirety.

Product Substitution Request Log: N/A

Note: Receipt of this Addendum No. 2, dated June 2, 2023, shall be acknowledged on Bid Express. Failure to do so will not allow Bidder to submit Bid.

END OF ADDENDUM

TABLE OF CONTENTS

Number	Document
	Introductory Information
00 01 01	Title Page
00 01 05	Certification
00 01 08	Project Directory
00 01 10	Table of Contents
	Bidding Requirements
00 11 13	Advertisement for Bids
00 21 13	Instructions to Bidders
00 31 32	Geotechnical Data
00 41 00	Bid Form
00 43 00	Bid Bond
00 43 37	List of Proposed Suppliers
00 45 19	Affidavit of Non-Collusion
00 45 45	Verification of Compliance with Minnesota Statutes 16C.285
00 45 47	Certification of Compliance with Minnesota Statutes 363A.36
00 45 49	Certification of Compliance with FAA Buy American Preference - Equipment/Building Projects (A4.3.3)
00 46 00	Demonstration of Good Faith DBE Efforts
	Contract Forms
00 51 00	Notice of Award
00 52 00	Standard Form of Agreement
00 55 00	Notice to Proceed
00 61 13	Performance Bond
00 61 14	Payment Bond
	FAA General Provisions
Section 10	Definitions and Terms
Section 20	Proposal Requirements and Conditions
Section 30	Award and Execution of Contract
Section 40	Scope of Work
Section 50	Control of Work
Section 60	Control of Materials
Section 70	Legal Regulations and Responsibility to Public
Section 80	Execution and Progress
Section 90	Measurement and Payment
	Conditions of the Contract
00 72 00	Standard General Conditions
00 73 00	Supplementary Conditions
00 73 30	Additional Special Provisions for Federally-Funded Contracts
DIVISION 1 - GENERAL REQUIREMENTS	
	Summary
01 11 00	Summary of Work
01 23 00	Alternates

	Price and Payment Procedures
01 25 13	Product Substitution Procedures
01 26 00	Contract Modification Procedures
	Administrative Requirements
01 31 19	Project Meetings
01 33 00	Submittal Procedures
	Quality Requirements
01 42 15	Specification Format, Definitions and Abbreviations
01 42 18	Reference Standards for Infrastructure Improvements
01 42 19	Reference Standards for Building Construction
01 45 10	Quality Control for Building Construction
	Temporary Facilities and Controls
01 51 00	Temporary Utilities
01 51 36	Temporary Water
01 52 13	Interim Terminal Facility
01 52 19	Temporary Sanitary Facilities
01 55 15	Maintenance and Restoration of Haul Roads
01 57 33	Application of Water for Dust Control
01 58 13	Project Signs
	Product Requirements
01 60 00	Product Requirements
	Execution and Closeout Requirements
01 71 23	Field Engineering
01 78 23	Operation and Maintenance Data
01 78 37	Product Warranties

DIVISION 2 - EXISTING CONDITIONS

	Demolition and Structure Moving
02 41 13	Building Removal
02 41 33	Removing Pavement and Miscellaneous Structures
	Facility Remediation
02 82 20	Regulated Asbestos Removal

DIVISION 3 - CONCRETE

	Maintenance of Concrete
03 11 00	Concrete Forming
03 20 00	Concrete Reinforcing
	Cast-in-Place Concrete
03 30 00	Cast-in-Place Concrete
03 35 22	Mechanical Polished Concrete

DIVISION 4 - MASONRY

04 70 00	Simulated Masonry
----------	-------------------

DIVISION 5 - METALS

05 12 00	Structural Steel Framing
05 50 00	Metal Fabrications

DIVISION 6 - WOOD, PLASTICS, AND COMPOSITES

06 10 00	Rough Carpentry
06 17 33	Wood I-Joists
06 40 23	Interior Architectural Woodwork
06 82 00	Glass-Fiber-Reinforced Plastic Panels

DIVISION 7 - THERMAL AND MOISTURE PROTECTION

	Thermal Protection
07 21 00	Thermal Insulation
07 21 29	Sprayed Insulation
07 22 16	Roof Board Insulation
	Roofing and Siding Panels
07 41 13	Metal Roofing and Wall Panels
07 46 43	Composition Siding
	Roof and Wall Specialties and Accessories
07 71 23	Gutters and Downspouts
	Joint Protection
07 92 00	Joint Sealants

DIVISION 8 - OPENINGS

	Doors and Frames
08 11 13	Hollow Metal Doors and Frames (Commercial)
08 14 00	Wood Doors
	Entrances, Storefronts, and Curtain Walls
08 43 13	Aluminum-Framed Storefront
	Windows
08 54 13	Fiberglass Frame Windows
	Glazing
08 80 00	Glazing

DIVISION 9 - FINISHES

	Plaster and Gypsum Board
09 29 00	Gypsum Board
	Tiling
09 30 00	Tiling
	Ceilings
09 51 13	Acoustical Panel Ceilings
	Flooring
09 65 13	Resilient Wall Base and Accessories
	Painting and Coating
09 91 00	Painting

DIVISION 10 - SPECIALTIES

	Information Specialties
10 14 19	Dimensional Letter Signage
10 14 23	Panel Signage

10 14 33 Internally Illuminated Signage

Interior Specialties

10 28 13 Toilet Accessories

10 44 00 Safety Specialties

DIVISION 22 – MECHANICAL

22 05 00 Basic Mechanical Requirements for Plumbing
22 05 10 Mechanical Related Work for Plumbing
22 05 12 Plumbing Pipes and Pipe Fittings
22 05 13 Electrical Provisions of Mechanical Work for Plumbing
22 05 19 Meters and Gages for Plumbing
22 05 23 Plumbing Valves
22 05 29 Hangers and Supports for Plumbing
22 07 00 Mechanical Insulation for Plumbing
22 11 16 Domestic Water Piping
22 11 19 Piping Specialties for Plumbing
22 13 16 Sanitary Waste and Vent Piping
22 33 00 Water Heaters
22 40 00 Plumbing Fixtures
23 05 00 Basic Mechanical Requirements for HVAC
23 05 10 Mechanical Related Work for HVAC
23 05 12 HVAC Pipes and Pipe Fittings
23 05 13 Electrical Provisions of Mechanical Work for HVAC
23 05 19 Meters and Gages for HVAC
23 05 23 HVAC Valves
23 05 29 Hangers and Supports for HVAC
23 05 93 Testing, Adjusting and Balancing for HVAC
23 07 00 Mechanical Insulation for HVAC
23 09 93 Sequence of Operation for HVAC Controls
23 11 19 Piping Specialties for HVAC
23 11 26 Gas System
23 23 00 Refrigerant Piping
23 31 13 Metals Ducts
23 33 00 Air Ductwork Accessories
23 37 13 Diffusers, Registers and Grillers
23 54 00 Furnaces
23 63 13 Air Source Heat Pumps
23 72 00 Air-to-Air Energy Recovery Units

DIVISION 26 – ELECTRICAL

26 00 00 Electrical General
26 00 10 Electrical Provisions for Mechanical Work
26 05 00 Common Work Results for Electrical
26 05 19 Medium Voltage Cables
26 05 26 Grounding and Bonding for Electrical Systems
26 05 29 Hangers and Supports for Electrical Systems
26 05 33 Conduits and Raceways
26 05 34 Raceways and Boxes for Electrical Systems
26 05 53 Identification for Electrical Systems
26 24 16 Panelboards
26 27 26 Wirings Devices
26 28 16 Enclosed Switches and Circuit Breakers
26 29 13 Enclosed Controllers
26 51 00 Interior Lighting
27 15 00 Telephone/Data/Security Systems

DIVISION 31 - EARTHWORK

Earth Moving

31 22 10	Subbase Granular Material
31 22 20	Earthwork for Building Sites
31 23 33	Trench Excavation and Backfill
31 25 10	Stormwater Management

Earthwork Methods

31 34 10	Geosynthetic Installation
----------	---------------------------

DIVISION 32 - EXTERIOR IMPROVEMENTS

Bases, Ballasts, and Paving

Base Courses

32 11 22	Aggregate Base
----------	----------------

Flexible Paving

32 12 13	Bituminous Tack Coat
32 12 16	Plant-Mixed Asphalt Pavement

Concrete Pavement

32 13 10	Concrete Pavement
----------	-------------------

Curb and Gutters

32 16 20	Concrete Curbing
----------	------------------

Paving Specialties

32 17 23	Pavement Marking
32 18 20	Walks

Site Accessories

32 40 00	Site Accessories
----------	------------------

Planting

32 92 00	Landscaping
32 93 12	Plant Installation and Establishment

DIVISION 33 - UTILITIES

Sanitary Sewage Utilities

33 36 10	Septic Systems
----------	----------------

FAA TECHNICAL SPECIFICATIONS

PART 2 - GENERAL CONSTRUCTION ITEMS

Item C-105	Mobilization
------------	--------------

PART 3 - SITEWORK

Item P-152	Excavation, Subgrade, and Embankment
------------	--------------------------------------

PART 10 - FENCING

Item F-162	Chain-Link Fence
------------	------------------

	PART 12 - TURFING
Item T-901	Seeding
Item T-905	Topsoiling
	PART – 14 ELECTRICAL
Item L-115	Electrical Manholes and Junction Structures

APPENDIX A

Geotechnical Exploration Report

APPENDIX B

Prevailing Wage Rates

APPENDIX C

Equal Employment Opportunity Special Provisions (EEO)

APPENDIX D

Certification of Exemption, Form ST3

APPENDIX E

Direct Deposit

APPENDIX F

Subsurface Septic Treatment System Forms – St. Louis County, MN

APPENDIX G

City of Duluth Construction Standard Specifications

APPENDIX H

Safety Plan and Compliance Narrative (SPCN)

APPENDIX I

MnDOT DBE Special Provisions

APPENDIX H

Asbestos Inspection and Regulated Waste Assessment Report

**STANDARD FORM OF AGREEMENT
BETWEEN OWNER AND CONTRACTOR
ON THE BASIS OF A STIPULATED PRICE**

THIS AGREEMENT is by and between the Sky Harbor Airport on behalf of the Duluth Airport Authority
(Owner) and _____ (Contractor).

Owner and Contractor hereby agree as follows:

ARTICLE 1 – WORK

- 1.01 Contractor shall complete all Work as specified or indicated in the Contract Documents. The Work is generally described as follows: 2023 Reconstruct Terminal Building, Sky Harbor Airport.

ARTICLE 2 – THE PROJECT

- 2.01 The Project, of which the Work under the Contract Documents is a part, is generally described as follows: Construction of a terminal building at Sky Harbor Airport.

ARTICLE 3 – ENGINEER

- 3.01 The Project has been designed by Short Elliott Hendrickson Inc. (SEH®).
- 3.02 The Owner has retained SEH (Engineer) to act as Owner's representative, assume all duties and responsibilities, and have the rights and authority assigned to Engineer in the Contract Documents in connection with the completion of the Work in accordance with the Contract Documents.

ARTICLE 4 – CONTRACT TIMES

4.01 *Time of the Essence*

- A. All time limits for Milestones, if any, Substantial Completion, and completion and readiness for final payment as stated in the Contract Documents are of the essence of the Contract.

4.02 *Contract Times: Days*

- A. The Work will be substantially completed within **270 calendar days** after the date when the Contract Times commence to run as provided in Paragraph 4.01 of the General Conditions and completed and ready for final payment in accordance with Paragraph 15.06 of the General Conditions within **300 calendar days** after the date when the Contract Times commence to run.
1. The Contractor shall notify the Owner of long lead-time for procurement of materials. The Owner will determine on a case-by-case basis if liquidated damages may be waived for these occurrences.
- B. Sitework Milestone. All earthwork (excavation, foundation, footings, etc.), sitework (utilities, paving, concrete, concrete patio, sloped walks, etc.) and all related construction elements at or below finished grade must be completed by **October 31, 2023**.
- C. Excavation and Restoration Requirement. The contractor must complete all excavation (below existing grade including but not limited to excavation for new structure foundation, footings and utilities) **within 21 calendar days**. This requirement is for the airport to coordinate with tribal monitoring, which is subject to contracting outside of the scope of the project. The restoration work must be completed **within 3 calendar days**. Notification prior to commencing is required.

4.03 *Liquidated Damages*

- A. Contractor and Owner recognize that time is of the essence as stated in Paragraph 4.01 above and that Owner will suffer financial loss if the Work is not completed within the times specified in Paragraph 4.02 above, plus any extensions thereof allowed in accordance with the Contract. The parties also recognize the delays, expense, and difficulties involved in proving in a legal or arbitration proceeding the actual loss suffered by Owner if the Work is not completed on time. Accordingly, instead of requiring any such proof, Owner and Contractor agree that as liquidated damages for delay (but not as a penalty):
1. Sitework Milestone Completion: Contractor shall pay Owner **\$1,000.00 for each day** that expires after the time (as duly adjusted pursuant to the Contract) specified in Paragraph 4.02.A above for Substantial Completion until the Work is substantially complete.
 2. Substantial Completion: Contractor shall pay Owner **\$500.00 for each day** that expires after the time (as duly adjusted pursuant to the Contract) specified in Paragraph 4.02.A above for Substantial Completion until the Work is substantially complete.
 3. Completion of Remaining Work: After Substantial Completion, if Contractor shall neglect, refuse, or fail to complete the remaining Work within the Contract Time (as duly adjusted pursuant to the Contract) for completion and readiness for final payment, Contractor shall pay Owner **\$200.00 for each day** that expires after such time until the Work is completed and ready for final payment.
 4. Liquidated damages for failing to timely attain Substantial Completion and final completion are not additive and will not be imposed concurrently.

4.04 *Special Damages*

- A. Should taxiway lights be damaged or knocked down, the Contractor shall be assessed **\$1,000 per light occurrence**.
- B. In addition to the amount provided for liquidated damages, Contractor shall reimburse Owner (1) for any fines or penalties imposed on Owner as a direct result of the Contractor's failure to attain Substantial Completion according to the Contract Times, and (2) for the actual costs reasonably incurred by Owner for engineering, construction observation, inspection, and administrative services needed after the time specified in Paragraph 4.02 for Substantial Completion (as duly adjusted pursuant to the Contract), until the Work is substantially complete.
- C. After Contractor achieves Substantial Completion, if Contractor shall neglect, refuse, or fail to complete the remaining Work within the Contract Times, Contractor shall reimburse Owner for the actual costs reasonably incurred by Owner for engineering, construction observation, inspection, and administrative services needed after the time specified in Paragraph 4.02 for Work to be completed and ready for final payment (as duly adjusted pursuant to the Contract), until the Work is completed and ready for final payment.
- D. The special damages imposed in this paragraph are supplemental to any liquidated damages for delayed completion established in this Agreement.

ARTICLE 5 – CONTRACT PRICE

- 5.01 Owner shall pay Contractor for completion of the Work in accordance with the Contract Documents the amounts that follow, subject to adjustment under the Contract:

- A. For all Unit Price Work, an amount equal to the sum of the established unit price for each separately identified item of Unit Price Work times the actual quantity of that item as indicated in Contractor's Bid.

The Bid Prices for Unit Price Work set forth as of the Effective Date of the Agreement are based on estimated quantities. As provided in Paragraph 13.03 of the General Conditions, estimated quantities

are not guaranteed, and determinations of actual quantities and classifications are to be made by Engineer as provided in Paragraph 10.06 of the General Conditions.

The Estimated Total of All Unit Price Work is:

\$ _____

ARTICLE 6 – PAYMENT PROCEDURES

6.01 Submittal and Processing of Payments

- A. Contractor shall submit Applications for Payment in accordance with Article 15 of the General Conditions. Applications for Payment will be processed by Engineer as provided in the General Conditions. Payments will be due 30 days after approval.

6.02 Progress Payments; Retainage

- A. Subject to the provisions of SC-15.01.C, Owner shall make monthly progress payments on account of the Contract Price on the basis of Contractor's Applications for Payment during performance of the Work as provided in Paragraph 6.02.A.1 below, provided that such Applications of Payment have been submitted in a timely manner and otherwise meet the requirements of the Contract. All such payments will be measured by the Schedule of Values established as provided in the General Conditions (and in the case of Unit Price Work based on the number of units completed) or, in the event there is no Schedule of Values, as provided elsewhere in the Contract:
 - 1. Prior to Substantial Completion, progress payments will be made in an amount equal to the percentage indicated below but, in each case, less the aggregate of payments previously made and less such amounts as Owner may withhold, including but not limited to liquidated damages, in accordance with the Contract:
 - a. 95 percent of Work completed (with the balance being retainage).
 - b. 95 percent of cost of materials and equipment not incorporated in the Work (with the balance being retainage).
- B. Within 60 days of Substantial Completion, Owner shall pay an amount sufficient to increase total payments to Contractor to 100 percent of the Work completed; less such amounts set off by Owner pursuant to Paragraph 15.01.E of the General Conditions; and less 250 percent of Engineer's estimate of the value of Work to be completed or corrected as shown on the punch list of items to be completed or corrected prior to final payment. Upon completion or correction and acceptance of said Work, Owner shall pay the amounts withheld within 60 days as recommended by Engineer.
 - 1. After Substantial Completion Owner shall also withhold one percent of the value of the Contract or \$500, whichever is greater, pending completion and submission of all "final paperwork" by the Contractor as defined by Minnesota Statutes, section 15.72, subdivision 2.(e)(2). Owner shall pay said amount withheld after Substantial Completion within 60 days of submission of all final paperwork as recommended by Engineer.

6.03 Final Payment

- A. Upon final completion and acceptance of the Work in accordance with Paragraph 15.06 of the General Conditions, Owner shall pay the remainder of the Contract Price as recommended by Engineer as provided in said Paragraph 15.06.

6.04 Interest

All amounts not paid when due shall bear interest at the rate of four percent (4%) per annum.

6.05 Electronic Payment Requirements

- A. All payments to the successful Contractor are required to be via Automated Clearing House (ACH). Reference Article 24 of Document 00 21 13 Instructions to Bidders Online Bidding.
- B. Contractor delay in submitting forms in **Appendix E** to the Sponsor shall negate the Contractor's right to collect interest as referenced in Section 6.04 until the issue is resolved.

ARTICLE 7 – CONTRACT DOCUMENTS

7.01 *Contents*

- A. The Contract Documents consist of the following:
1. Addenda (numbers 00 00 1__ to 00 00 1__, inclusive).
 2. This Agreement (pages 00 52 00-1 to 00 52 00-7, inclusive).
 3. Performance Bond (Document 00 61 13).
 4. Payment Bond (Document 00 61 14).
 5. General Conditions (pages 00 72 00-1 to 00 72 00-66, inclusive).
 6. Supplementary Conditions (pages 00 73 00-1 to 00 73 00-8, inclusive).
 7. Specifications as listed in the table of contents of the Project Manual.
 8. The Drawings listed in the index located on Drawing Sheet G000 (Title Sheet).
 9. Exhibits to this Agreement (enumerated as follows).
 - a. Contractor's Bid (Document 00 41 00).
 - b. Documentation submitted by Contractor prior to Notice of Award (pages ____ to ____, inclusive).
 - c. Certificate of Insurance.
 10. The following which may be delivered or issued on or after the Effective Date of the Contract and are not attached hereto:
 - a. Notice to Proceed.
 - b. Field Order(s).
 - c. Work Change Directive(s).
 - d. Change Order(s).
- B. The documents listed in Paragraph 7.01.A are attached to this Agreement (except as expressly noted otherwise above).
- C. There are no Contract Documents other than those listed above in this Article 7.
- D. The Contract Documents may only be amended, modified, or supplemented as provided in the General Conditions.

ARTICLE 8 – REPRESENTATIONS, CERTIFICATIONS, AND STIPULATIONS

8.01 *Contractor's Representations*

- A. In order to induce Owner to enter into this Contract, Contractor makes the following representations:
1. Contractor has examined and carefully studied the Contract Documents, and any data and reference items identified in the Contract Documents.
 2. Contractor has visited the Site, conducted a thorough, alert visual examination of the Site and adjacent areas, and become familiar with and is satisfied as to the general, local, and Site conditions that may affect cost, progress, and performance of the Work.
 3. Contractor is familiar with and is satisfied as to all Laws and Regulations that may affect cost, progress, and performance of the Work.
 4. Contractor has carefully studied all: (1) reports of explorations and tests of subsurface conditions at or adjacent to the Site and all drawings of physical conditions relating to existing

surface or subsurface structures at the Site that have been identified in the Supplementary Conditions, especially with respect to Technical Data in such reports and drawings, and (2) reports and drawings relating to Hazardous Environmental Conditions, if any, at or adjacent to the Site that have been identified in the Supplementary Conditions, especially with respect to Technical Data in such reports and drawings.

5. Contractor has considered the information known to Contractor itself; information commonly known to contractors doing business in the locality of the Site; information and observations obtained from visits to the Site; the Contract Documents; and the Site-related reports and drawings identified in the Contract Documents, with respect to the effect of such information, observations, and documents on (1) the cost, progress, and performance of the Work; (2) the means, methods, techniques, sequences, and procedures of construction to be employed by Contractor; and (3) Contractor's safety precautions and programs.
6. Based on the information and observations referred to in the preceding paragraph, Contractor agrees that no further examinations, investigations, explorations, tests, studies, or data are necessary for the performance of the Work at the Contract Price, within the Contract Times, and in accordance with the other terms and conditions of the Contract.
7. Contractor is aware of the general nature of work to be performed by Owner and others at the Site that relates to the Work as indicated in the Contract Documents.
8. Contractor has given Engineer written notice of all conflicts, errors, ambiguities, or discrepancies that Contractor has discovered in the Contract Documents, and the written resolution thereof by Engineer is acceptable to Contractor.
9. The Contract Documents are generally sufficient to indicate and convey understanding of all terms and conditions for performance and furnishing of the Work.
10. Contractor's entry into this Contract constitutes an incontrovertible representation by Contractor that without exception all prices in the Agreement are premised upon performing and furnishing the Work required by the Contract Documents.

8.02 Contractor's Certifications

- A. Contractor certifies that it has not engaged in corrupt, fraudulent, collusive, or coercive practices in competing for or in executing the Contract. For the purposes of this Paragraph 8.02:
 1. "corrupt practice" means the offering, giving, receiving, or soliciting of anything of value likely to influence the action of a public official in the bidding process or in the Contract execution;
 2. "fraudulent practice" means an intentional misrepresentation of facts made (a) to influence the bidding process or the execution of the Contract to the detriment of Owner, (b) to establish Bid or Contract prices at artificial non-competitive levels, or (c) to deprive Owner of the benefits of free and open competition;
 3. "collusive practice" means a scheme or arrangement between two or more Bidders, with or without the knowledge of Owner, a purpose of which is to establish Bid prices at artificial, non-competitive levels; and
 4. "coercive practice" means harming or threatening to harm, directly or indirectly, persons or their property to influence their participation in the bidding process or affect the execution of the Contract.

ARTICLE 9 – MISCELLANEOUS

9.01 Terms

- A. Terms used in this Agreement will have the meanings stated in the General Conditions and the Supplementary Conditions.

9.02 *Assignment of Contract*

- A. Unless expressly agreed to elsewhere in the Contract, no assignment by a party hereto of any rights under or interests in the Contract will be binding on another party hereto without the written consent of the party sought to be bound; and, specifically but without limitation, money that may become due and money that is due may not be assigned without such consent (except to the extent that the effect of this restriction may be limited by law), and unless specifically stated to the contrary in any written consent to an assignment, no assignment will release or discharge the assignor from any duty or responsibility under the Contract Documents.

9.03 *Successors and Assigns*

- A. Owner and Contractor each binds itself, its successors, assigns, and legal representatives to the other party hereto, its successors, assigns, and legal representatives in respect to all covenants, agreements, and obligations contained in the Contract Documents.

9.04 *Severability*

- A. Any provision or part of the Contract Documents held to be void or unenforceable under any Law or Regulation shall be deemed stricken, and all remaining provisions shall continue to be valid and binding upon Owner and Contractor, who agree that the Contract Documents shall be reformed to replace such stricken provision or part thereof with a valid and enforceable provision that comes as close as possible to expressing the intention of the stricken provision.

IN WITNESS WHEREOF, Owner and Contractor have signed this Agreement.

This Agreement will be effective on _____, _____ (which is the Effective Date of the Contract).

OWNER:

Sky Harbor Airport on behalf of the Duluth Airport Authority

By: _____

Title: _____

[CORPORATE SEAL]

Attest: _____

Title: _____

Address for Giving Notices:

(If Owner is a corporation, attach evidence of authority to sign. If Owner is a public body, attach evidence of authority to sign and resolution or other documents authorizing execution of Owner-Contractor Agreement).

Designated Representative:

Name: _____

Title: _____

Address: 4701 Grinden Drive

Duluth, Minnesota 55881

Phone: _____

Facsimile: _____

CONTRACTOR:

By: _____

Title: _____

[CORPORATE SEAL]

Attest: _____

Title: _____

Address for Giving Notices:

License No. _____
(Where Applicable)

Agent for service of process: _____

(If Contractor is a corporation or a partnership, attach evidence of authority to sign.)

Designated Representative:

Name: _____

Title: _____

Address _____

Phone: _____

Facsimile: _____

END OF DOCUMENT

This Page Left Blank Intentionally

QUALITY CONTROL FOR BUILDING CONSTRUCTION

PART 1 GENERAL

1.01 SUMMARY

- A. Section includes:
 - 1. Administrative and procedural requirements for quality control.
 - 2. Inspection and testing services to assist in determination of work with specifications and regulations.
 - 3. Requirements for Contractor cooperation.
 - 4. Responsibility for payment.
 - 5. Schedule of required tests.
- B. Contractor Responsibility: These required services do not relieve Contractor of responsibility for compliance with any requirements.
- C. Quality Control section shall be completed and submitted with the building permit.

1.02 REFERENCES

- A. IBC Code: Currently in effect and adopted by state in which Project is located.
- B. ASTM:
 - 1. D3740 - Minimum Requirements for Agencies Engaged in Testing or Inspection of Soil and Rock
 - 2. E329 - Requirements for Agencies Engaged in Testing or Inspection of Materials Used in Construction

1.03 DEFINITIONS

- A. Quality Control: Inspections, tests, related actions including reports, performed by independent agencies and governing authorities, as well as directed by Contractor.

1.04 SUBMITTALS

- A. Submit copy of report of laboratory facilities inspection made by Materials Reference Laboratory of National Bureau of Standards (NBS) during most recent tour of inspection, with memorandum of remedies of any deficiencies reported by the inspection.
- B. Prior to start of Work, submit testing laboratory name, address, and telephone number, and names of full-time registered Specialist and responsible officer.
- C. After each inspection and test, submit two written copies of report to Engineer and to Contractor no later than 3 working days after completion of inspection or test. Include:
 - 1. Date issued
 - 2. Project title and number
 - 3. Name of inspector
 - 4. Date and time of sampling or inspection
 - 5. Identification of product and Specifications Section
 - 6. Location in the Project
 - 7. Type of inspection or test
 - 8. Date of test
 - 9. Results of tests
 - 10. Conformance with Contract Documents

- D. When requested by Engineer, provide interpretation of test results.

1.05 QUALITY ASSURANCE

- A. Codes and Standards: Comply with requirements of ASTM D3740 and E329.
- B. Testing:
1. Owner shall employ and pay for services of an independent testing laboratory to perform specified inspection and testing.
 2. Employment of testing laboratory shall in no way relieve Contractor of obligation to perform work in accordance with requirements of Contract Documents.
- C. Laboratory Qualifications:
1. Qualified in accordance with referenced ASTM standard to acceptance of Engineer.
 2. Authorized to operate in state in which Project is located.
 3. Staff: Maintain a full-time registered Engineer Specialist on staff to review services.
 4. Testing Equipment: Calibrated at reasonable intervals with devices of an accuracy traceable to either National Bureau of Standards (NBS) Standards or accepted values of natural physical constants.

1.06 RESPONSIBILITIES

- A. Contractor Responsibility:
1. Quality control testing or inspections scheduled to be Contractor's responsibility.
 2. Code Compliance Testing: Quality control required by codes or ordinances, or by plan approval authority, made by legally constituted authority unless otherwise provided in Contract Documents. Verification of conformance of the Work within specified construction tolerances.
 3. Contractor's Convenience Testing.
 4. Notify Engineer and laboratory 48 hours prior to expected time for operations requiring inspections and testing services.
 5. Provide incidental labor and facilities to:
 - a. Provide access to Work to be tested.
 - b. Obtain and handle samples at the Site or at source of products to be tested.
 - c. Facilitate tests and inspections, and storage and curing of test samples.
 6. Coordinate with each independent agency the sequence of activities to accommodate required services with minimum delay in progress of Work and to avoid removing and replacing Work. Schedule times for quality control.
- B. Owner Responsibility: Quality control not specifically indicated as Contractor's responsibility, or to be provided by another identified entity.
- C. Laboratory Responsibility:
1. Ascertain compliance of materials and mixes with requirements of Contract Documents.
 2. Promptly notify Engineer and Contractor of observed irregularities or non-conformance of Work or Products.
 3. Perform additional inspections and tests required by Engineer.
 4. Limits on Laboratory Authority:
 - a. Laboratory may not release, revoke, alter, or enlarge on requirements of Contract Documents.
 - b. Laboratory may not approve or accept any portion of the Work.
 - c. Laboratory may not assume any duties of Contractor.
 - d. Laboratory has no authority to stop the Work. If a situation arises in which, in the judgment of the Laboratory, work should be stopped; Laboratory shall bring it to the attention of the Contractor's Superintendent and the Engineer.
- D. Retest Responsibility:
1. Where results of quality control prove unsatisfactory and do not indicate compliance of related Work with requirements of the Contract Documents, retests are responsibility of Contractor, regardless of whether the original test was Contractor's responsibility.

2. Retest of Work revised or replaced by Contractor is Contractor's responsibility, where required tests were performed on original Work.
3. Retesting costs will be deducted from Contract amount by Change Order.
4. Provide 2 retests for each failed test.

PART 2 PRODUCTS

Not Used

PART 3 EXECUTION

3.01 ADJUSTING

- A. Upon completion of quality control performed on Work, repair damaged Work, restore substrates and finishes to eliminate deficiencies, including deficiencies in visual qualities of exposed finishes. Comply with Contract Document requirements for "Cutting and Patching."

3.02 PROTECTION

- A. Protect Work exposed by or for quality control service activities, and protect repaired Work.

3.03 RESPONSIBILITY FOR ADJUSTING AND REPAIR

- A. Contractor's responsibility, regardless of assignment of responsibility for quality control.

3.04 FIELD QUALITY CONTROL

- A. Testing Agency responsibilities are included in the Street and Utility Quality Control Testing Schedule for general site testing and the Special Structural Testing and Inspection Program Summary Schedule for structural testing.
- B. Special Inspections:
 1. The following inspections and testing shall be conducted by an Independent Testing Agency, arranged and paid for by the Owner with the results being reported to Architect, Engineer, Building Inspector, Contractor and Structural Engineer of Record.
 - a. For the items listed in the Special Structural Testing and Inspection Program Schedule herein, see guidelines in IBC Chapter 17.
 - b. Tests and inspections will be paid for by the Owner Unless Noted Otherwise.
 2. Preconstruction Meeting:
 - a. If requested by Engineer, conduct 1 meeting at Site to review the scope of special structural testing and inspection.
 - b. Comply with requirements of Section 01 31 19.
 3. Post Special Structural Testing and Inspection Summary in field office at job Site. Retain all reports submitted by special inspectors for review of the Building Official upon request.
 4. The schedule of special structural testing and inspections is attached to this section. In addition, provide testing and inspection of the following:
 - a. Excavating, Filling, Grading:
 - 1) Periodically verify excavations are extended to proper depth and have reached proper material.
 - 2) Periodically observe subgrade and verify that site has been prepared properly prior to placement of compacted fill or rock pad.
 - 3) Continuously verify use of proper materials, densities and lift thicknesses during placement and compaction of compacted fill.
 - 4) Classification and compaction testing for building pads: 1 test per 2,500 square feet per 12-inch lift; minimum 3 tests.
 - 5) Classification and compaction testing for paved areas: Refer to P-152 specification.

- 6) Foundation wall backfill: 1 test per 100 feet or less of wall length, but no fewer than 2 tests.
- 7) Footing subgrades: At least At least 2 tests of each soil stratum to verify design bearing capacities. Refer to "Design Loads" section of General Structural Notes.
- 8) Utility trenches: 1 test for each 150 feet or less of trench length, but no fewer than 2 tests.
- 9) Roadway grading: Refer to P-152 Specification.
- b. Proof rolling of parking areas and sidewalks subject to vehicular traffic.
- c. Secure inspection and acceptance of subgrades and fill layers before subsequent construction is permitted.
- d. See "Frequency" descriptions at the end of this section for structural testing and inspection descriptions.

Street and Utility Quality Control Testing Schedule

Specification Section	Product	Type of Test	Location		Responsibility
			Source	Field	
03 30 00	Concrete Aggregate	Gradation	x		Contractor
31 22 10	Subbase Granular	Gradation	x		Contractor
31 22 10	Subbase Granular	Moisture, Density		x	Ind. Testing Agency
31 22 20	Earthwork-Building Pads	Moisture, Density		x	Ind. Testing Agency
31 22 20	Foundation Wall Backfill	Moisture, Density		x	Ind. Testing Agency
31 22 20	Earthwork – Interior of Structures	Moisture, Density		x	Ind. Testing Agency
31 22 20	Footing Subgrades	Moisture, Density		x	Ind. Testing Agency
31 23 33	Utility Trenches	Moisture, Density		x	Ind. Testing Agency
P-152	Roadway Grading and Paved Areas	Moisture, Density		x	Ind. Testing Agency
P-152	Borrow for Embankment	Moisture, Density		x	Ind. Testing Agency
32 16 20	Concrete Curb	Slump, Air, Temp, Cylinder Compression		x	Ind. Testing Agency
32 13 10	Concrete Pavement	Slump, Air, Temp, Cylinder Compression		x	Ind. Testing Agency
P-152	Subgrade	Test Rolling		x	Contractor
32 11 22	Aggregate Base	Moisture, Density		x	Ind. Testing Agency
32 11 22	Aggregate Base	Gradation	x		Contractor
32 12 16	Asphalt Pavement	Source Quality Control per MnDOT 2360.4	x		Contractor/Fabricator
32 12 16	Asphalt Pavement	Compaction Testing		x	Ind. Testing Agency
32 18 20	Walks - Concrete	Slump, Air, Temperature, Cylinder Compression		x	Ind. Testing Agency
2504	Plant Water Main	Pressure/Leakage		x	Contractor
2504	Plant Water Main	Conductivity		x	Contractor
2504	Potable Water Main	Coliform/Disinfection		x	Contractor
2503	Sanitary Sewer	Infiltration		x	Contractor
2503	Sanitary Sewer	Air/Pressure		x	Contractor

SPECIAL STRUCTURAL TESTING AND INSPECTION PROGRAM SUMMARY SCHEDULE

Project Name: 2023 Reconstruct Terminal Building Project Number: DULAI 172133

Location: Sky Harbor Airport, Duluth, Minnesota

Permit Number (1): _____

Technical (2)		Description (3)	Type of Inspector (4)	Frequency (5)	Assigned Firm (6)
Section	Article				
01 45 10	3.04	Soils	TA	See 01 45 10	
03 11 00	3.01	Concrete Formwork	SI-S	F3	
03 20 00	3.04	Concrete Reinforcement	SI-S	F3, F4	
03 30 00	3.18	Concrete Placement Techniques	SI-S	F5	
01 45 10	N/A	Concrete Testing	TA	F5	
06 10 00		Rough Carpentry	SI-S	F10, F11	
Drawings	N/A	Anchors in Concrete	TA	See structural drawing notes	

Notes: This schedule shall be filled out and included in the Special Structural Testing and Inspection Program.

- (1) Permit number to be provided by the Building Official.
- (2) Referenced to the specific technical scope section in the program (specification section).
- (3) Use descriptions per IBC Chapter 17, as adopted by the State Building Code.
- (4) Special Inspector - Technical, Special Inspector - Structural
- (5) Weekly, monthly, per test/inspection, per floor, etc. – See “Frequency” section following this schedule.
- (6) Firm contracted to perform services.

ACKNOWLEDGMENTS

Each appropriate representative shall sign below:

Owner: _____	Firm: _____	Date: _____
Contractor: _____	Firm: _____	Date: _____
Architect: _____	Firm: _____	Date: _____
SER: _____	Firm: <u>SEH</u>	Date: _____
SI-S: _____	Firm: _____	Date: _____
SI-T: _____	Firm: _____	Date: _____
TA: _____	Firm: _____	Date: _____
F: _____	Firm: _____	Date: _____

If requested by Engineer of record or Building Official, the individual names of all prospective special inspectors and the Work they intend to observe shall be identified (Use reverse side of form if necessary).

Legend: SER = Structural Engineer of Record SI-T = Special Inspector - Technical TA = Testing
 Agency SI-S = Special Inspector - Structural F = Fabricator

Accepted for the Building Department by _____ **Date** _____

1. FREQUENCY

If conflicting information is provided in technical specification sections, the more stringent requirement governs.

A. CATEGORIES

F1. Not used.

F2. Not used.

F3. The inspector shall periodically see all formwork, reinforcing steel, pre-stressing tendon, and anchor bolts prior to concrete placement to inspect for conformance with the drawings.

F4. The inspector shall see all structural steel and reinforcing steel field welds prior to application of finishes to inspect for conformance with the approved plans. If applicable, the inspector shall request the testing agency perform Ultrasonic Testing on 50% of all full penetration field welds for the project. If the failure of welding test is 25% of all tests performed, 100% of all full penetration field welds shall be tested.

F5. Concrete Placement: Continuous Inspection - Inspector to review placement of all cast-in-place concrete. Periodically verify use of required design mix. Periodically inspect for maintenance of specified curing temperature and techniques. Test shall be made by a Level 1 Technician as certified by ACI.

a. Concrete Specimens:

- 1) Compression Strength Testing: The method of making cylinders, storage and testing shall be in accordance with ASTM Specification C31, latest edition. Record any deviations from the requirements of ASTM C31 in the test report.
 - a) Cast 4 six inch cylinders per set (or an additional cylinder if four inch cylinders are used):
 - (1) One at 7 days for information
 - (2) Two at 28 days for acceptance
 - (3) One for hold (test at 56 days if desired by Engineer, or if other tests were lower than specified).
 - b) Conduct at least 1 strength test for each 75 yards or fraction thereof for each mixture design placed in any 1 day.
 - c) Furnish a copy of the test results to Engineer as soon as available.
 - d) Field cure cylinders (2 per set) to check concrete strength prior to critical shoring removal as recommended in Section 03 30 00.
 - e) Acceptance test results shall be the average strengths of the 2 specimens tested at 28 days.
 - f) Conduct load test on test cores of concrete that fail to meet the specified strength, in accordance with ASTM C42.
 - g) Failure to meet strength requirements of the cores, shall be a cause for rejection by Engineer.
 - h) The cost of remedial measures required due to test failures shall be paid for by the Contractor.

b. Standard Field Tests to be performed on fresh concrete for the first truck and every third truck thereafter (1st, 4th, 7th, etc.) or when a change in properties is noticed, at the final location (test after pump, not at truck):

- 1) Concrete Slump Tests:
 - a) Testing agency will determine slump of concrete from each truck in accordance with ASTM Specification C143, latest edition.
 - b) If slump exceeds maximum allowed, remove batch from work and dispose of off-site.
 - c) Test slump at end of conveying system.
- 2) Concrete Air Content Tests:
 - a) Testing agency will determine air content of concrete from each truck in accordance with ASTM Specification C231, latest edition.
 - b) Air content shall be tested at end of conveying system.

- 3) Concrete Temperature:
 - a) Testing agency will determine temperature of concrete from each truck in accordance with ASTM C1064.
 - b) Test temperature at end of conveying system.

F6. All bolts shall be checked for snug tight condition.

F7. Not used.

F8. Periodic inspection of steel erection for conformance with the drawings.

F9. Not used.

F10. Periodic inspection of structural wood roof deck including:

- 1. Roof deck installation in accordance with the construction documents, installation drawings, shop drawings, design documents and applicable referenced standards.

F11. Periodic inspection of bearing and shearwall construction for conformance with the drawings including installation of hold-down anchors.

END OF SECTION

SECTION 32 13 10

CONCRETE PAVEMENT (MnDOT 2301)

PART 1 GENERAL

1.01 SUMMARY

- A. Provide portland cement concrete pavement without reinforcement. Concrete pavement is for outside of the building footprint, only for the existing hangar approach replacement area.
- B. Method of Measurement:
 - 1. Measurement will be made by the square yard.
 - 2. No separate measurement will be made for tie bars.
- C. Basis of Payment:
 - 1. Payment for concrete construction shall be included in the Building Construction Item at the Contract Unit Price listed on Bid Form. All associated Work items shall be considered incidental.

1.02 REFERENCES

- A. MnDOT:
 - 1. 2301 - Concrete Pavement
 - 2. 2461 - Structural Concrete
 - 3. 3151 - Bituminous Material
 - 4. 3702 - Preformed Joint Fillers
 - 5. 3754 - Poly-Alpha Methylstyrene (AMS) Membrane Curing Compound
 - 6. 3756 - Plastic Curing Blankets

1.03 SUBMITTALS

- A. Refer to Section 01 33 00.
- B. Concrete Mix Submittals:
 - 1. Include name and address of transit-mix concrete supplier with submissions.
 - 2. Catalog information on admixtures or agents to be included in mix.
 - 3. List of concrete mix designs at least 21 days prior to start of Work. Include alternate mixture designs when characteristics of materials, Project conditions, weather, test or other circumstances warrant adjustments.
- C. Quality Assurance/Control Submittals:
 - 1. Test Reports: Report test results to Engineer.
 - 2. Material Certificates: Signed by manufacturers certifying materials comply with requirements of Construction Documents.
- D. Provide with Product Data: Buy-American Certification and/or Build America, Buy America (BABA) for manufactured goods of products supplied, steel or iron products, if applicable.

1.04 QUALITY ASSURANCE

- A. Regulatory Agencies: Comply with local governing regulations if more stringent than specified.
- B. Preinstallation Meeting: Meet with Engineer prior to the start of installation.
- C. Produce concrete from MnDOT certified plants.

1.05 PROJECT CONDITIONS

- A. Existing Conditions:
 - 1. Drawings do not purport to show actual dimensions but are intended only to establish location and scope of Work.
 - 2. Field-verify dimensions and assume full responsibility for their accuracy.
 - 3. Match existing concrete thickness of adjacent hangar approach.
- B. Maintain access for vehicular and pedestrian traffic.

PART 2 PRODUCTS

2.01 MATERIALS

- A. Materials and accessories shall comply with MnDOT specifications:
 - 1. Concrete: MnDOT 2461.
 - 2. Steel Reinforcement Tie Bars: MnDOT 2301
 - 3. Preformed Joint Filler: MnDOT 3702.
 - a. Emulsified asphalt: MnDOT 3151.
 - 4. Curing Materials:
 - a. Plastic curing blankets: MnDOT 3756.
 - b. Poly-Alpha Methyl Styrene (AMS) Membrane curing compound: MnDOT 3754.
 - 5. Forms:
 - a. Wood or metal with smooth contact face.
 - b. Minimum form height: That of proposed concrete thickness.
 - c. Use flexible or curved forms for curves with radius 100 feet or less.
 - d. Form sections shall be not less than 10 feet long, except that wood forms can be 8 feet or greater.
 - e. Top of form shall show no deviations greater than 1/8 inch from a straight edge equal to form section.
 - f. Face of straight forms shall show no deviation greater than 1/4 inch from a 10-foot straight edge.
 - 6. Form Release Agent: Commercially formulated; will not bond with, stain, or adversely affect concrete surfaces provided in the Approved/Qualified Products List.

2.02 CONCRETE MIX PROPORTIONS

- A. Slipform Placement: Mix No. 3A21.
- B. Fixed Form Placement: Mix No. 3A41.

PART 3 EXECUTION

3.01 PREPARATION

- A. Base Preparation:
 - 1. Examine exposed subgrades and base surfaces for compliance with requirements for dimensional, grading, and elevation tolerances.
 - 2. Remove loose material from compacted subgrade and base layer.
 - 3. Proof-roll base surface with heavy pneumatic-tired equipment to identify soft pockets and areas of excess yielding. Correct nonconforming conditions.
 - 4. Complete fine grading at least 3 hours in advance of concrete placement.
 - 5. Moisten subgrade in upper 3 inches to provide uniform dampened condition.
 - 6. Do not place concrete on frozen surface.
- B. Forms:

1. Set forms to required grade on alignment for a distance equal to minimum 3 hours paving time.
2. Clean after each use and coat contact face with chemical release agent.
3. Do not remove for 24 hours after concrete has been placed.

C. Steel Reinforcement Tie Bars:

1. Tie Bars: Epoxy coated.
2. Provide 12" in length for tie bars to tie new concrete to existing.
3. Drill a minimum 6" into existing concrete.
4. Space tie bars 12" on center.

3.02 INSTALLATION

A. Concrete Pavement:

1. Place in accordance with MnDOT 2461 and 2301.
2. Use either fixed form or slip form construction.
3. Prevent segregation of mix.
4. Do not add water to concrete during delivery, at Site, or to fresh concrete after testing.
5. Consolidate concrete along face of forms and adjacent to transverse joints with an internal vibrator.
6. Prevent dislocation of reinforcing, dowels, and joint devices.
7. Deposit and spread concrete in a continuous operation.
8. Do not move concrete with vibrator.

B. Joints:

1. Construct and space as shown on Drawings and perpendicular to grade.
2. Joining existing pavement: Place transverse joints to align with previously placed joints, unless otherwise indicated.
3. Construction Joints: Set at side and end terminations of pavement and at locations where pavement operations are stopped for more than 1/2 hour, unless pavement terminates at isolation joints.
4. Tie Bars: Provide at sides of pavement strips where indicated.
5. Butt Joints: Use epoxy bonding adhesive at joint locations where fresh concrete is placed against hardened or partially hardened concrete surfaces.
6. Doweled Joints: Install dowel bars and support assemblies at joints where indicated. Lubricate or asphalt-coat 1/2 of dowel length to prevent concrete bonding to 1 side of joint.
7. Isolation Joints: Preformed joint-filler strips abutting concrete curbs, catch basins, manholes, inlets, structures, walks, other fixed objects, and where indicated.
 - a. Furnish in one-piece lengths. Where more than 1 length is required, lace or clip joint-filler sections together.
 - b. Protect top edge of joint filler during concrete placement with temporary preformed cap. Remove cap after concrete placed on both sides of joint.
8. Contraction Joints: Construct to match jointing of existing adjacent concrete pavement.
9. Edging:
 - a. Tool edges of pavement after initial floating with edging tool.
 - b. Repeat after applying surface finishes.
 - c. Eliminate tool marks on concrete surfaces.
10. After removal of forms, clean ends of joints and point-up any minor honeycombed areas.
11. Remove and replace areas or sections with major defects, as directed by Engineer.

C. Surface Finish:

1. After concrete is consolidated, screeded and floated, final finish texture shall be obtained by drawing a carpet drag longitudinally. Provide a textured depth of at least 1.0 millimeters in accordance with ASTM E965-87.
2. Carpet shall be:
 - a. Artificial grass type.
 - b. Total minimum weight of 70 ounces per square yard.
 - c. Molded polyethylene pile face with blade length of 5/8 to 1 inch.

3. Transverse Metal-tine Texture: Not required on subsidiary paving areas such as cross-overs, parking lanes etc.
4. Slip-Resistive Aggregate Finish:
 - a. Spread on pavement surfaces according to manufacturer's written instructions before final floating.
 - b. Use curing compound recommended by this manufacturer; apply immediately.
 - c. After curing, lightly work surface with steel wire brush or abrasive stone and water to expose nonslip aggregate.
- D. Curing and Protection:
 1. Cure minimum 72 hours after finishing.
 2. Protect from loss of moisture, rain damage, traffic, and extreme hot or cold temperatures.
 3. Apply curing media within 30 minutes after side forms are removed.
 4. Blanket Curing Method:
 - a. Envelop concrete with waterproof paper or plastic after finishing, and seal with waterproof tape or adhesive.
 - b. Prevent water vapor loss.
 - c. After curing, treat exposed surfaces with 2 coats treating oil.
 5. Curing Compound Method:
 - a. Coat exposed surfaces with curing compound immediately after finishing.
 - b. Apply uniformly at a rate of 1 gallon per 150 square feet of surface area with approved airless sprayer.
 - c. Spray on second coat within 3 hours.
- E. Joint Sealing:
 1. Engineer to inspect and approve concrete base before sealing.
 2. Apply epoxy polyester sealer to sound, clean, oil-free, dry concrete in 2-coat application, and in accordance with manufacturer's recommendations.

3.03 TOLERANCES

- A. Surface Smoothness:
 1. Deviations greater than 0.25 inches in 10 feet measured with a straight edge in the longitudinal direction will be considered unacceptable work.
 2. Deviations greater than 0.25 inches in 10 feet measured with straight edge in transverse direction will be considered unacceptable work.
- B. Thickness: Survey data (see Section 01 71 23 Field Engineering) of aggregate prior to placement will verify thickness of concrete pavement.
- C. Unacceptable Work: Remove and replace as directed by Engineer.

3.04 FIELD TESTING

- A. Testing and Analysis of Concrete: See 01 45 10.

3.05 REPAIRS AND PROTECTION

- A. Remove and replace concrete that is broken, damaged, or defective, or does not comply with requirements.
- B. Drill test cores where directed by Engineer when necessary to determine magnitude of cracks or defective areas. Fill drilled core holes with portland cement concrete bonded to pavement with epoxy adhesive.
- C. Protect concrete from damage. Exclude traffic from pavement for minimum 14 days after placement. When construction traffic is permitted, maintain pavement as clean as possible by removing surface stains and spillage of materials as they occur.

- D. Maintain concrete pavement free of stains, discoloration, dirt, and other foreign material. Sweep not more than 2 days before date scheduled for Substantial Completion inspections.

3.06 CLEAN-UP

- A. The Contractor shall provide a contained area for concrete wash out area as part of this Item.
- B. Washing out concrete trucks other than contractor provided area will not be allowed.

END OF SECTION

This Page Left Blank Intentionally

SECTION 32 92 00

LANDSCAPING

PART 1 GENERAL

1.01 SUMMARY

- A. Provide the following:
 - 1. Accessories including, but not limited to:
 - a. Weed barrier.
 - b. Landscape rock.
- B. Method of Measurement: Landscaping: Measure by area in square feet.
- C. Basis of Payment:
 - 1. Payment for landscaping shall be at the Contract Unit Price as listed on the Bid Form. All associated Work items, shall be considered incidental.
 - 2. No separate payment will be made for supplying and placing weed barrier.
 - 3. No separate payment will be made for supplying and placing landscape rock.

1.02 SUBMITTALS

- A. Refer to Section 01 33 00.
 - 1. Product Data:
 - a. For each type of product indicated.
 - b. Verify with Owner on selection of River Rock. Provide sample of rock to Airport.
- B. Provide with Product Data: Buy-American Certification and/or Build America, Buy America (BABA) for manufactured goods of products supplied, steel or iron products, if applicable.
- C. Qualification Data: For landscape installer.

1.03 QUALITY ASSURANCE

- A. Qualifications:
 - 1. Installer: A qualified landscape installer whose work has resulted in successful installations.
- B. Substitutions: Refer to Section 01 25 13.

1.04 DELIVERY, STORAGE, AND HANDLING

- A. Landscape rock: Place in an area not to disruption construction or airfield operations.

1.05 PROJECT CONDITIONS

- A. Existing Conditions:
 - 1. Inspect the Project prior to installation.
 - 2. If conditions do not meet approval, notify Engineer.
 - 3. Proceeding without notification implies acceptance of conditions.

1.06 WARRANTY

- A. Warranty for a period of 1 year after date of substantial completion against defects, including death and unsatisfactory growth, except for defects resulting from neglect by Owner, abuse or damage by others, or unusual phenomena or incidents which are beyond landscape installer's control.

PART 2 PRODUCTS

2.01 LANDSCAPE ACCESSORIES

- A. Landscape Rock:
 - 1. Rock shall be MN River Rock, Lake Superior River Rock or WI River Rock.
- B. Weed Barrier:
 - 1. 6-mil black polyethylene film **OR** Filtration/Separation Fabric: Water permeable filtration fabric of fiberglass or polypropylene fabric.

PART 3 EXECUTION

3.01 LANDSCAPE WORK

- A. Landscape Layout:
 - 1. Install the landscaping at the location shown on the Plans. Landscaping shall size and shape shall be coordinated with the Airport prior to installation.
- B. Weed Barrier:
 - 1. Lay film continuously over compacted subgrade prior to placing landscape rock. Overlap edges 4 inches at joints between sheets. Secure to ground with nails to prevent rolling or movement when placing landscape rock.
- C. Landscape Rock:
 - 1. Weed barrier must be placed prior to placing of landscape rock.
 - 2. Install landscape rock to a depth of 4-inches.
 - 3. Place rock to meet grades, as shown on the Plans.

3.02 CLEANUP, MAINTENANCE, AND PROTECTION

- A. During landscape work, keep pavements clean and work area in an orderly condition.
- B. Promptly remove soil and debris created by lawn work from paved areas.
- C. Clean wheels of vehicles before leaving site to avoid tracking soil onto roads, walks, or other paved areas.
- D. Disposal:
 - 1. Remove waste and foreign materials, including weeds, stones, soil cores, grass, vegetation, and sod and legally dispose of them off Owner's property.
 - 2. Divert from landfill disposal whenever possible.
 - 3. Topsoil containing foreign materials resulting from Contractor's operations, including oil drippings, fuel spills, shall be disposed of legally.

3.03 INSPECTION AND ACCEPTANCE

- A. Inspection: When landscape work is completed, including maintenance, Engineer will, upon request, inspect to determine acceptability.
- B. Rejected Work: When inspected landscape work does not comply with requirements, replace rejected work and continue specified maintenance until reinspected by Engineer and found to be acceptable.

END OF SECTION

SECTION 32 93 12

PLANT INSTALLATION AND ESTABLISHMENT (MnDOT 2571)

PART 1 GENERAL

1.01 SUMMARY

- A. Section Includes:
1. Furnishing, planting, and establishing shrubs.
 - a. The term 'plant or plants' shall be considered a general reference to any plant type of shrub throughout this specification section.
- B. Related Section:
1. Section T-905 - Topsoil
- C. Method of Measurement:
1. Furnishing, Planting and Establishing Shrubs: Measure as a unit for each shrub acceptably planted.
 2. Furnishing and installing Topsoil Borrow (Imported): See Section T-905.
- D. Basis of Payment:
1. Payment for acceptable quantities of furnished and planted shrubs includes:
 - a. Furnishing and planting the materials as specified.
 - b. Furnishing and installing planting soil, mulch, material, protective materials and other specified materials.
 - c. Plant maintenance and replacement until acceptable.
 - d. Disposal of all excess excavated material.
 - e. Restoration in kind of all areas disturbed by Contractor's operations.
 2. Payment for acceptable quantities:
 - a. Payment for furnishing, installing and establishing shrubs shall be at the Contract Unit Price as listed on the Bid Form.
 - b. Payment for furnishing and installing Topsoil Borrow (Imported) shall be at the Contract Unit Price as listed on the Bid Form
 - c. All associated work items not otherwise compensated shall be considered incidental.
 3. All costs of plant establishment work shall be at the Contractor's expense, including the costs of any replacement materials required.
 4. Payment for acceptable quantities or furnishing and planting and transplanting shrubs will be based on the following schedule:

Item	Unit
Deciduous Shrub size and root category	Each
Note: State Root Category: , - Container Grown - Balled and Burlapped	

1.02 REFERENCES

- A. Perform work in accordance with the current edition of the *Inspection and Contract Administration Manual for MnDOT Landscape Project* (ICAMMLP).
- B. MnDOT:
1. 2571 - Plant Installation and Establishment
 2. 3861 - Plant Stock

3. 3877 - Topsoil Material
4. 3881 - Fertilizer
5. 3882 - Mulch Material
6. 3890 - Compost

1.03 SUBMITTALS

- A. Provide supply assurances, plant stock and material documentation, and substitution requests in accordance with MnDOT 2571.2.A.

PART 2 MATERIALS

2.01 MATERIALS

- A. Plant Stock: MnDOT 3861
 1. See planting schedule in Drawings for common and botanical names, types and sizes.
- B. Growing Medium Materials:
 1. Depth: See thickness requirements on the Drawings.
 2. Topsoil Borrow: Section T-905.
 3. Fertilizer: MnDOT 3881.
 4. Water: Shall be suitable for human consumption.

PART 3 EXECUTION

3.01 EXAMINATION

- A. Notify Engineer 3 Calendar Days prior to delivery of plant materials to arrange for inspection.

3.02 INSTALLATION

- A. General:
 1. Install and maintain plants only with an experienced crew under direct supervision of a qualified nurseryman or landscape specialist in accordance with MnDOT 2571.3.A.1.
 2. Plant only under favorable weather and soil conditions as approved by Engineer.
 3. Engineer will consider Work performed as follows to be unauthorized Work:
 - a. Without attending a landscaping preconstruction meeting.
 - b. Without required and acceptable documentation and notifications.
 - c. Without supervision by a certified landscape specialist.
 - d. Without conducting required and acceptable competency tests.
 - e. In conflict with the working hours of the Contract.
- B. Delivery and Storage of Plants:
 1. Install plants on day of delivery to Site.
 2. New plantings shall be containerized as indicated in the Drawings.
- C. Preparing Plant Holes:
 1. Prepare planting holes, widths and depths per Planting Details in Drawings.
 2. Scarify sides and bottom of hole.
 3. Maintain undisturbed soil in hole beneath the root ball, or compact planting soil to receive plants.
- D. Plant Installation:
 1. Do not drop plant material.
 2. Lift only from the bottom of pot or ball, never with the trunk, using dollies and front end loaders as necessary.

3. Containerized Shrubs:
 - a. If root bound, remove from pot by carefully rolling and pressing on the pot which has been placed on its side.
 - b. Score outside of soil mass to redirect and prevent circling fibrous roots. Remove or correct stem girdling roots.
 - c. Set plant in hole so the top of the root flare is at or up to 2 inches above the finished grade.
 - d. Plumb and backfill with planting soil.
 - e. Water thoroughly within 2 hours to settle plant and fill voids.
 - f. Backfill voids and water a second time.
 - g. Place mulch within 48 hours of the second watering, unless soil moisture is excessive.
- E. Topgrowth and Pruning:
 1. Prune only broken or dead branches and bare roots.
- F. Watering and Rock Mulch:
 1. Water each plant within 2 hours of planting.
 2. Water to thoroughly saturate all planting soil.
 3. Do not water trunk.
 4. Place rock mulch within 48 hours and as detailed in the Drawings.
 5. Water all plants when soil is dry at a 2-inch depth.
 6. Water all plants thoroughly at least once per week until the work is accepted.
- G. Disposal of Excavated Materials: Disposal of all excess excavated materials is the responsibility of the Contractor.
- H. Cleanup and Restoration:
 1. Collect and dispose of all excess materials, packaging and containers.
 2. Restore or replace in kind all turf or other facilities damaged by Contractor's operations.
- I. Plant Establishment Period:
 1. Maintain the work and care for plants installed as necessary all plantings for the plant establishment period which shall be up to 2 calendar years A plant establishment period begins on the date that initial planting operations on the project are completed and continues until final acceptance of the project, unless otherwise noted on the Drawings.
 2. Maintenance includes:
 - a. Keeping all plants in healthy growing condition.
 - b. Maintaining adequate, but not excessive, soil moisture at all times.
 - c. Repairing or replacing as necessary mulch material and planting soil.
 - d. Manually removing all weed growth in and 3 feet beyond all mulched areas.
 - e. Applying insecticide spray as necessary.
 - f. Furnishing and installing replacement plants as needed, including new mulch and planting soil.
 - g. Keeping all plants upright.
 - h. Contractor will be held responsible for all plants lost due to acts of vandalism, theft and rodent damage.
- J. Acceptance of Work:
 1. Engineer will Inspect Project:
 - a. Upon delivery of plant materials.
 - b. At the end of the plant establishment period.
 - c. Engineer will notify Contractor of any defective materials or work.
 2. Contractor will replace all defective work immediately on or at the beginning of the next planting season if directed by Engineer.
 3. Only plants that have completed the plant establishment period of care will be subject to acceptance.
 4. No payment will be made for unacceptable plantings.

END OF SECTION

Item T-905 Topsoil

DESCRIPTION

905-1.1 This item shall consist of preparing the ground surface for topsoil application, removing topsoil from designated stockpiles or areas to be stripped on the site or from approved sources off the site, and placing and spreading the topsoil on prepared areas in accordance with this specification at the locations shown on the plans or as directed by the RPR.

MATERIALS

905-2.1 Topsoil. Topsoil shall be the surface layer of soil with no admixture of refuse or any material toxic to plant growth, and it shall be reasonably free from subsoil and stumps, roots, brush, stones (2 inches (50 mm) or more in diameter), and clay lumps or similar objects. Brush and other vegetation that will not be incorporated with the soil during handling operations shall be cut and removed. Ordinary sod and herbaceous growth such as grass and weeds are not to be removed, but shall be thoroughly broken up and intermixed with the soil during handling operations. Heavy sod or other cover, which cannot be incorporated into the topsoil by discing or other means, shall be removed. The topsoil or soil mixture, unless otherwise specified or approved, shall have a pH range of approximately 5.5 pH to 7.6 pH, when tested in accordance with the methods of testing of the Association of Official Agricultural Chemists in effect on the date of invitation of bids. The organic content shall be not less than 3% nor more than 20% as determined by the wet-combustion method (chromic acid reduction). There shall be not less than 20% nor more than 80% of the material passing the 200 mesh (75 μ m) sieve as determined by the wash test in accordance with ASTM C117.

Natural topsoil may be amended by the Contractor with approved materials and methods to meet the above specifications.

905-2.2 Inspection and tests. Within 10 days following acceptance of the bid, the RPR shall be notified of the source of topsoil to be furnished by the Contractor. The topsoil shall be inspected to determine if the selected soil meets the requirements specified and to determine the depth to which stripping will be permitted. At this time, the Contractor may be required to take representative soil samples from several locations within the area under consideration and to the proposed stripping depths, for testing purposes as specified in paragraph 905-2.1.

CONSTRUCTION METHODS

905-3.1 General. Areas to be topsoiled shall be shown on the plans. If topsoil is available on the site, the location of the stockpiles or areas to be stripped of topsoil and the stripping depths shall be shown on the plans.

Suitable equipment necessary for proper preparation and treatment of the ground surface, stripping of topsoil, and for the handling and placing of all required materials shall be on hand, in good condition, and approved by the RPR before the various operations are started.

905-3.2 Preparing the ground surface. Immediately prior to dumping and spreading the topsoil on any area, the surface shall be loosened by discs or spike-tooth harrows, or by other means approved by the RPR, to a minimum depth of 2 inches (50 mm) to facilitate bonding of the topsoil to the covered subgrade soil. The surface of the area to be topsoiled shall be cleared of all stones larger than 2 inches (50 mm) in any diameter and all litter or other material which may be detrimental to proper bonding, the rise of

capillary moisture, or the proper growth of the desired planting. Limited areas, as shown on the plans, which are too compact to respond to these operations shall receive special scarification.

Grades on the area to be topsoiled, which have been established by others as shown on the plans, shall be maintained in a true and even condition. Where grades have not been established, the areas shall be smooth-graded and the surface left at the prescribed grades in an even and compacted condition to prevent the formation of low places or pockets where water will stand.

905-3.3 Obtaining topsoil. Prior to the stripping of topsoil from designated areas, any vegetation, briars, stumps and large roots, rubbish or stones found on such areas, which may interfere with subsequent operations, shall be removed using methods approved by the RPR. Heavy sod or other cover, which cannot be incorporated into the topsoil by discing or other means shall be removed.

When suitable topsoil is available on the site, the Contractor shall remove this material from the designated areas and to the depth as directed by the RPR. The topsoil shall be spread on areas already tilled and smooth-graded, or stockpiled in areas approved by the RPR. Any topsoil stockpiled by the Contractor shall be rehandled and placed without additional compensation. Any topsoil that has been stockpiled on the site by others, and is required for topsoil purposes, shall be removed and placed by the Contractor. The sites of all stockpiles and areas adjacent thereto which have been disturbed by the Contractor shall be graded if required and put into a condition acceptable for seeding.

When suitable topsoil is secured off the airport site, the Contractor shall locate and obtain the supply, subject to the approval of the RPR. The Contractor shall notify the RPR sufficiently in advance of operations in order that necessary measurements and tests can be made. The Contractor shall remove the topsoil from approved areas and to the depth as directed. The topsoil shall be hauled to the site of the work and placed for spreading, or spread as required. Any topsoil hauled to the site of the work and stockpiled shall be rehandled and placed without additional compensation.

905-3.4 Placing topsoil. The topsoil shall be evenly spread on the prepared areas to a uniform depth of 4 inches (50 mm) for restoration and depth of 6-inches for landscape planting after compaction, unless otherwise shown on the plans or stated in the special provisions. Spreading shall not be done when the ground or topsoil is frozen, excessively wet, or otherwise in a condition detrimental to the work. Spreading shall be carried on so that turfing operations can proceed with a minimum of soil preparation or tilling.

After spreading, any large, stiff clods and hard lumps shall be broken with a pulverizer or by other effective means, and all stones or rocks (2 inches (50 mm) or more in diameter), roots, litter, or any foreign matter shall be raked up and disposed of by the Contractor. After spreading is completed, the topsoil shall be satisfactorily compacted by rolling with a cultipacker or by other means approved by the RPR. The compacted topsoil surface shall conform to the required lines, grades, and cross-sections. Any topsoil or other dirt falling upon pavements as a result of hauling or handling of topsoil shall be promptly removed.

METHOD OF MEASUREMENT

905-4.1 Topsoil obtained on the site shall be measured by the number of cubic yards (cubic meters) of topsoil measured in its original position and stripped or excavated. Topsoil stockpiled by others and removed for topsoil by the Contractor shall be measured by the number of cubic yards (cubic meters) of topsoil measured in the stockpile. Topsoil shall be measured by volume in cubic yards (cubic meters) computed by the method of end areas.

905-4.2 Topsoil obtained off the site shall be measured by the number of cubic yards (cubic meters) of topsoil measured in its original position and stripped or excavated. Topsoil shall be measured by volume in cubic yards (meters) computed by the method of end areas.

BASIS OF PAYMENT

905-5.1 Payment will be made at the contract unit price per cubic yard (cubic meter) for topsoil (salvaged from stripping operations and importing for landscape planting) This price shall be full compensation for furnishing all materials and for all preparation, placing, and spreading of the materials, and for all labor, equipment, tools, and incidentals necessary to complete the item.

Payment will be made under:

Item T-905-5.1	Select Topsoil Borrow (Salvaged) (CV)
Item T-905-5.2	Select Topsoil Borrow (Imported) (CV)

REFERENCES

The publications listed below form a part of this specification to the extent referenced. The publications are referred to within the text by the basic designation only.

ASTM International (ASTM)

ASTM C117	Materials Finer than 75 μ m (No. 200) Sieve in Mineral Aggregates by Washing
-----------	--

Advisory Circulars (AC)

AC 150/5200-33	Hazardous Wildlife Attractants on or Near Airports
----------------	--

FAA/United States Department of Agriculture

Wildlife Hazard Management at Airports, A Manual for Airport Personnel

END OF ITEM T-905

This Page Left Blank Intentionally



Building a Better World
for All of Us®

May 31, 2023

RE: Sky Harbor Airport Terminal
Asbestos Inspection and
Regulated Waste Assessment
5000 Minnesota Ave
Duluth, MN 55802
SEH No. DULAI 172133

Mr. Mark Papko
Duluth Airport Authority
4701 Grinden Drive
Duluth, MN 55811

Dear Mr. Papko:

Short Elliott Hendrickson Inc. (SEH®) was retained by Duluth Airport Authority to complete an asbestos inspection and regulated waste assessment (RWA) at the Sky Harbor Airport Terminal site located at 5000 Minnesota Ave in Duluth, Minnesota.

ASBESTOS INSPECTION

Robert Hawkins, a certified asbestos inspector (**See Attachment A, Minnesota Department of Health [MDH] Certification**), completed the asbestos inspection on May 23, 2023. The asbestos inspections were conducted in accordance with MDH asbestos inspection and assessment rules (Section 4620.3460) and U.S. Environmental Protection Agency (USEPA) guidance documents. The asbestos inspection is intended to meet the requirements of the National Emission Standard for Hazardous Air Pollutants (NESHAP) Subpart M – National Emission Standard for Asbestos. The Minnesota Pollution Control Agency (MPCA) enforces the NESHAP regulation in Minnesota.

The parcel was occupied by an airport terminal building. The structure was constructed as a slab on grade, two-story building with concrete masonry unit (CMU) block foundation walls and wood and steel framing. Wall coverings consisted primarily of drywall. Floor coverings included carpet, vinyl sheeting, vinyl tile, and wood. The structure's exterior was primarily metal sheeting.

A walk-through inspection was conducted to identify suspect asbestos containing material (ACM). Select photographs of the building and samples are included in **Attachment B, Photo Journal Log**. Non-Destructive bulk samples of each suspect ACM were collected in accordance with USEPA guidance documents for the occupied structure. Samples were submitted directly to EMSL Analytical, Inc. (EMSL) and analyzed by polarized light microscopy (PLM). The EMSL laboratory is accredited by the National Institute of Science and Technology (NIST) through the National Voluntary Laboratory Accreditation Program (NVLAP) (NIST-NVLAP No. 200019-0). Results of the asbestos inspection indicate the presence of building materials in or on the structures meet the definition of ACM (i.e., contain more than 1% asbestos). The PLM analytical results for the structure are summarized in the table below. PLM analytical results are also included in **Attachment C, EMSL Analytical Report**.

Sample ID	Location	Description, ACM feature	Estimated Quantity	Asbestos Result
M-1-1	Kitchen and Laundry Room	Vinyl flooring, gray/orange layer	88 ft ²	30% Chrysotile
S-1-1	Kitchen	Coating on sink bottom	4 ft ²	6% Chrysotile
M-6-1	BR1	Vinyl flooring, white/green layer	64 ft ²	25% Chrysotile
M-10-1	BR2, BR3, and Lobby	Tile flooring, mastic	560 ft ²	10% Chrysotile

REGULATED WASTE ASSESSMENT

SEH conducted a regulated waste assessment and collected caulk and peeling paint samples on April 13, 2023.

The purpose of a regulated waste assessment (RWA) is to identify materials, other than ACMs, that were encountered at the properties and would need to be segregated from construction and demolition debris prior to demolition. Hazardous and regulated waste items must be removed and properly disposed prior to demolition of the basement foundations and cannot be treated as construction and demolition waste material as defined in MN Administrative Rule 7035.0030, subpart 30.

The building was occupied at the time of the RWA. Items stored inside the building that will be removed prior to demolition were not included in the RWA. The following regulated waste observations were made at the Sky Harbor terminal building:

Ground Floor

- 4' Fluorescent Bulbs – 22
- Ballasts – 11
- Thermostats – 2
- Exit Signs – 2
- Security Camera – 1

Upstairs

- 4' Fluorescent Bulbs – 20
- Ballasts – 10
- Thermostats – 2
- Heater – 1
- Water Heater – 1
- 7' Baseboard Heater – 1

During the regulated waste assessment, caulking was observed around several of the windows on the ground floor of the building. A representative sample of the material was collected (Caulk-1) and analyzed using EPA Method 8082A. No PCB concentrations were detected in the sample above method reporting limits.

Additionally, SEH observed peeling paint on several interior components of the terminal building. A sample of the peeling paint was collected and submitted to the EMSL for lead analysis. The table below includes a description, location and reported analytical lead concentration of the collected sample. Lead based paint is defined as 0.5% or 5,000 mg/kg in accordance with the EPA's Renovation, Repair, and Painting Rule (RRP), MDHs Lead Poisoning Prevention statutes and Residential Lead Abatement rules, and the MPCAs Lead Paint Removal rules. Laboratory Results are included in **Attachment A**.

Sample ID	Location	Description	Analytical Results
Paint-1	Kitchen	Bottom layer of wall paint	<110 ppm


LIMITATIONS

To minimize disturbance of the structure, discrete sampling techniques were used during completion of the asbestos inspection. Due to the limited nature of the discrete sampling activities, the potential exists for unidentified ACM to be present in the structure. Additionally, in order to maintain the integrity of the structures, the roofing materials of the structure were not sampled.

Thank you for choosing SEH to complete this assessment. Please feel free to contact Jennifer at 612.839.2430 if you have any questions.

Sincerely,

SHORT ELLIOTT HENDRICKSON INC.

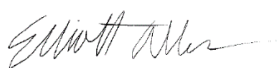

Elliott Allen, GIT
Environmental Technician



Robert Hawkins, GIT
Graduate Scientist II



Jennifer Force, PG (MN)
Senior Scientist II

Efa

Attachments:

Figures

- Figure 1, Project Location
- Figure 2, Sample Locations

Attachment A, Inspector Certification

Attachment B, Photo Journal Log

Attachment C, EMSL Laboratory Reports

x:\ae\d\dulal\172133\3-env-stdy-reg\30-env-doc\16-phase2\asbestos report\asbestos inspection and regulated waste assessment report.docx

Figures

Figure 1, Project Location

Figure 2, Sample Locations

Attachment A

Inspector Certifications

Certificate No: 5LM02142306IR

Expiration Date: February 14, 2024


This is to certify that
Robert Hawkins
has attended and successfully completed an
ASBESTOS INSPECTOR
REFRESHER TRAINING COURSE

permitted by
the State of Minnesota under Minnesota Rules 4620.3702 to 4620.3722
and meets the requirements of
Section 206 of Title II of the Toxic Substances Control Act (TSCA)
conducted by

Lake States Environmental, Ltd.

in
St. Paul, MN on February 14, 2023
Examination Date: February 14, 2023

Lake States Environmental, Ltd.
P. O. Box 645, Rice Lake, WI 54868
www.lakestates.com
(800) 254-9811

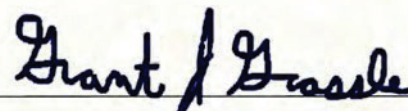
Training Instructor




DEPARTMENT
OF HEALTH

**ASBESTOS
INSPECTOR**

Certified by:
State of Minnesota
Department of Health

Expires: 02/14/2024

Robert R Hawkins
2224 Westview Dr
Hastings, MN 55033

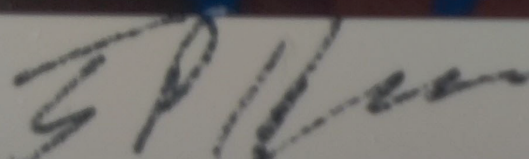
Director, Env. Health Div.

No. A14377

Issued: 03/31/2023

Attachment B

Photo Journal Log



Photo 1 Bathroom with vinyl flooring



Photo 2 Lounge with vinyl tile flooring

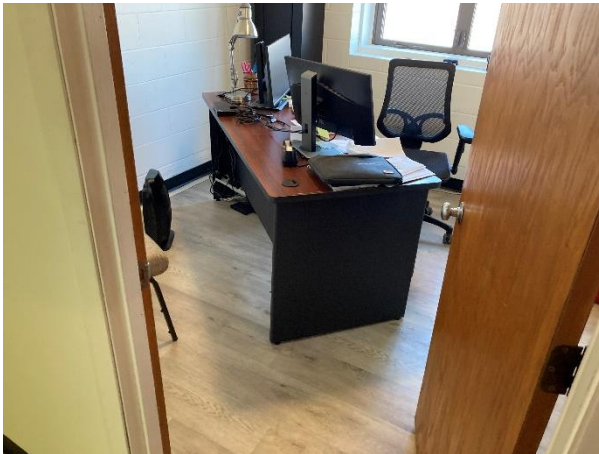


Photo 3 Office area



Photo 4 Laundry room with vinyl flooring



Photo 5 Office area



Photo 6 Kitchen area



Photo 7 Kitchen area with vinyl flooring and paint



Photo 8 Exterior of building



Photo 9 Sample M-10-1

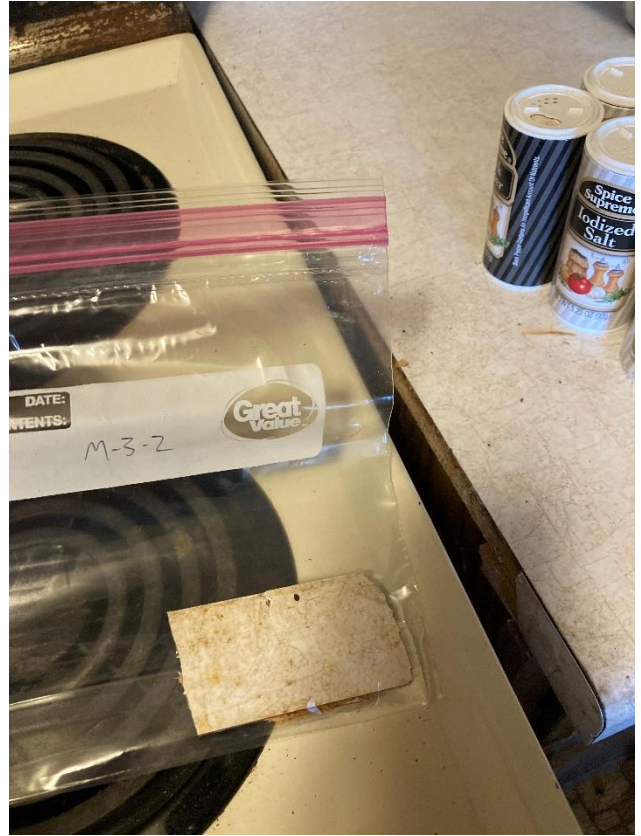


Photo 10 Sample M-3-2



Photo 11 Sample S-1-3

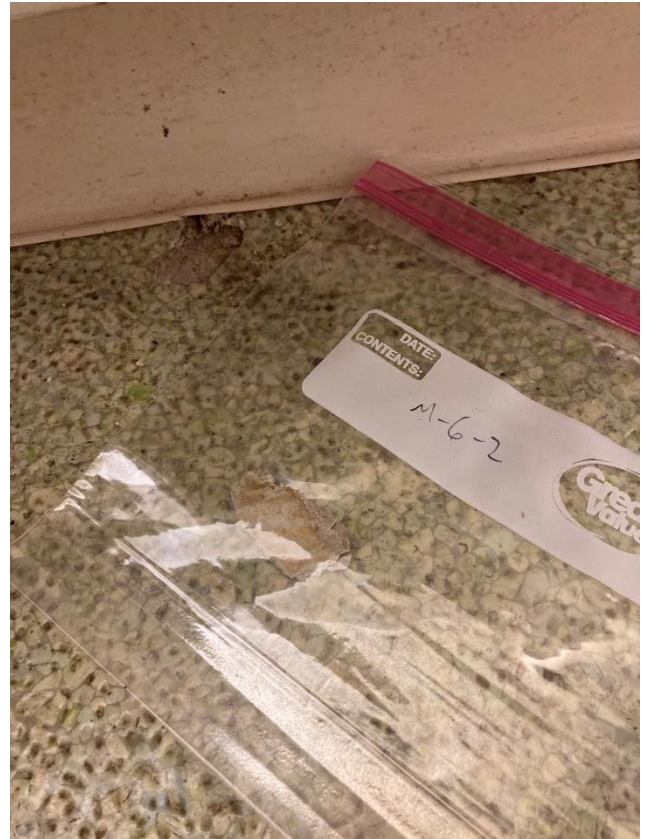


Photo 12 Sample M-6-2

Attachment C

EMSL Laboratory Reports



EMSL Analytical, Inc.

3410 Winnetka Avenue North New Hope, MN 55427

Tel/Fax: (763) 449-4922 / (763) 449-4924

<http://www.EMSL.com> / minneapolislab@emsl.com

EMSL Order: 352304525

Customer ID: SEHI80

Customer PO:

Project ID:

Attention: Jennifer Force

Short Elliot & Hendrickson

3535 Vadnais Center Drive

Saint Paul, MN 55110

Phone: (651) 490-2000

Fax: (651) 490-2150

Received Date: 05/25/2023 10:05 AM

Analysis Date: 05/31/2023

Collected Date: 05/23/2023

Project: DULAI 172133 Sky Harbor

Test Report: Asbestos Analysis of Bulk Materials via AHERA Method 40CFR 763 Subpart E Appendix E supplemented with EPA 600/R-93/116 using Polarized Light Microscopy

Sample	Description	Appearance	Non-Asbestos		Asbestos % Type
			% Fibrous	% Non-Fibrous	
M-1-1-Vinyl Sheet Flooring 352304525-0001	Kitchen, vinyl flooring	Gray/Orange Fibrous Heterogeneous		70% Non-fibrous (Other)	30% Chrysotile
M-1-1-Adhesive 352304525-0001A	Kitchen, vinyl flooring	Yellow Non-Fibrous Homogeneous		100% Non-fibrous (Other)	None Detected
M-1-2 352304525-0002 <i>No adhesive on sample.</i>	Laundry Room, vinyl flooring				Positive Stop (Not Analyzed)
M-1-3-Vinyl Sheet Flooring 352304525-0003	Laundry Room, vinyl flooring				Positive Stop (Not Analyzed)
M-1-3-Adhesive 352304525-0003A	Laundry Room, vinyl flooring	Yellow Non-Fibrous Homogeneous		100% Non-fibrous (Other)	None Detected
M-2-1 352304525-0004	Kitchen Closte, drywall	Tan/White Fibrous Heterogeneous	10% Cellulose	90% Non-fibrous (Other)	None Detected
M-2-2 352304525-0005	Office 1, drywall	Tan/White Fibrous Heterogeneous	10% Cellulose	90% Non-fibrous (Other)	None Detected
M-2-3 352304525-0006	BR 1, drywall	Tan/White Fibrous Heterogeneous	10% Cellulose	90% Non-fibrous (Other)	None Detected
M-2-4 352304525-0007	Office 2, drywall	Tan/White Fibrous Heterogeneous	10% Cellulose	90% Non-fibrous (Other)	None Detected
M-2-5-Drywall Composite 352304525-0008 <i>This is a composite result of drywall and joint compound</i>	Laundry Room, drywall	Tan/White Fibrous Heterogeneous	10% Cellulose	90% Non-fibrous (Other)	None Detected
M-2-5-Adhesive 352304525-0008A	Laundry Room, drywall	Brown Non-Fibrous Homogeneous		100% Non-fibrous (Other)	None Detected
M-3-1-Countertop 352304525-0009	Kitchen, vinyl kitchen countertop	Brown/White Non-Fibrous Heterogeneous	90% Cellulose	10% Non-fibrous (Other)	None Detected
M-3-1-Adhesive 352304525-0009A	Kitchen, vinyl kitchen countertop	Yellow Non-Fibrous Homogeneous		100% Non-fibrous (Other)	None Detected
M-3-2-Countertop 352304525-0010	Kitchen, vinyl kitchen countertop	Brown/White Non-Fibrous Heterogeneous	95% Cellulose	5% Non-fibrous (Other)	None Detected

Initial report from: 05/31/2023 12:35:29



EMSL Analytical, Inc.

3410 Winnetka Avenue North New Hope, MN 55427

Tel/Fax: (763) 449-4922 / (763) 449-4924

<http://www.EMSL.com> / minneapolislab@emsl.com

EMSL Order: 352304525

Customer ID: SEHI80

Customer PO:

Project ID:

Test Report: Asbestos Analysis of Bulk Materials via AHERA Method 40CFR 763 Subpart E Appendix E supplemented with EPA 600/R-93/116 using Polarized Light Microscopy

Sample	Description	Appearance	Non-Asbestos		Asbestos
			% Fibrous	% Non-Fibrous	% Type
M-3-2-Adhesive 352304525-0010A	Kitchen, vinyl kitchen countertop	Yellow Non-Fibrous Homogeneous		100% Non-fibrous (Other)	None Detected
M-3-3-Countertop 352304525-0011	Kitchen, vinyl kitchen countertop	Brown/White Non-Fibrous Heterogeneous	95% Cellulose	5% Non-fibrous (Other)	None Detected
M-3-3-Adhesive 352304525-0011A	Kitchen, vinyl kitchen countertop	Yellow Non-Fibrous Homogeneous		100% Non-fibrous (Other)	None Detected
S-1-1 352304525-0012	Coating on Kitchen Sink	Pink Non-Fibrous Homogeneous		94% Non-fibrous (Other)	6% Chrysotile
S-1-2 352304525-0013	Coating on Kitchen Sink				Positive Stop (Not Analyzed)
S-1-3 352304525-0014	Coating on Kitchen Sink				Positive Stop (Not Analyzed)
M-4-1-Baseboard 352304525-0015	Office 1, vinyl baseboard trim w/adhesive	Tan Non-Fibrous Homogeneous		100% Non-fibrous (Other)	None Detected
M-4-1-Yellow Adhesive 352304525-0015A	Office 1, vinyl baseboard trim w/adhesive	Yellow Non-Fibrous Homogeneous		100% Non-fibrous (Other)	None Detected
M-4-1-Brown Adhesive 352304525-0015B	Office 1, vinyl baseboard trim w/adhesive	Brown Non-Fibrous Homogeneous		100% Non-fibrous (Other)	None Detected
M-4-2-Baseboard 352304525-0016	Office 1, vinyl baseboard trim w/adhesive	Tan Non-Fibrous Homogeneous		100% Non-fibrous (Other)	None Detected
M-4-2-Yellow Adhesive 352304525-0016A	Office 1, vinyl baseboard trim w/adhesive	Yellow Non-Fibrous Homogeneous		100% Non-fibrous (Other)	None Detected
M-4-2-Brown Adhesive 352304525-0016B	Office 1, vinyl baseboard trim w/adhesive	Brown Non-Fibrous Homogeneous		100% Non-fibrous (Other)	None Detected
M-4-3-Baseboard 352304525-0017	Office 1, vinyl baseboard trim w/adhesive	Tan Non-Fibrous Homogeneous		100% Non-fibrous (Other)	None Detected
M-4-3-Yellow Adhesive 352304525-0017A	Office 1, vinyl baseboard trim w/adhesive	Yellow Non-Fibrous Homogeneous		100% Non-fibrous (Other)	None Detected
M-4-3-Brown Adhesive 352304525-0017B	Office 1, vinyl baseboard trim w/adhesive	Brown Non-Fibrous Homogeneous		100% Non-fibrous (Other)	None Detected
M-5-1 352304525-0018	Office 2, ceiling tile w/swirls	Tan/White Fibrous Homogeneous	95% Cellulose	5% Non-fibrous (Other)	None Detected
M-5-2 352304525-0019	Office 2, ceiling tile w/swirls	Tan/White Fibrous Homogeneous	95% Cellulose	5% Non-fibrous (Other)	None Detected
M-5-3 352304525-0020	Office 2, ceiling tile w/swirls	Tan/White Fibrous Homogeneous	95% Cellulose	5% Non-fibrous (Other)	None Detected
M-6-1-Vinyl Sheet Flooring 352304525-0021	BR 1, vinyl flooring	White/Green Fibrous Heterogeneous		75% Non-fibrous (Other)	25% Chrysotile

Initial report from: 05/31/2023 12:35:29



EMSL Analytical, Inc.

3410 Winnetka Avenue North New Hope, MN 55427

Tel/Fax: (763) 449-4922 / (763) 449-4924

<http://www.EMSL.com> / minneapolislab@emsl.com

EMSL Order: 352304525

Customer ID: SEHI80

Customer PO:

Project ID:

Test Report: Asbestos Analysis of Bulk Materials via AHERA Method 40CFR 763 Subpart E Appendix E supplemented with EPA 600/R-93/116 using Polarized Light Microscopy

Sample	Description	Appearance	Non-Asbestos		Asbestos
			% Fibrous	% Non-Fibrous	% Type
M-6-1-Adhesive 352304525-0021A	BR 1, vinyl flooring	Yellow Non-Fibrous Homogeneous		100% Non-fibrous (Other)	None Detected
M-6-2 352304525-0022 No adhesive on sample	BR 1, vinyl flooring				Positive Stop (Not Analyzed)
M-6-3 352304525-0023 No adhesive on sample	BR 1, vinyl flooring				Positive Stop (Not Analyzed)
M-7-1-Baseboard 352304525-0024	BR 1, vinyl baseboard trim w/adhesive	White Non-Fibrous Homogeneous		100% Non-fibrous (Other)	None Detected
M-7-1-Adhesive 352304525-0024A	BR 1, vinyl baseboard trim w/adhesive	Yellow Non-Fibrous Homogeneous		100% Non-fibrous (Other)	None Detected
M-7-1-Caulking 352304525-0024B	BR 1, vinyl baseboard trim w/adhesive	White Non-Fibrous Homogeneous		100% Non-fibrous (Other)	None Detected
M-7-2-Baseboard 352304525-0025	BR 1, vinyl baseboard trim w/adhesive	White Non-Fibrous Homogeneous		100% Non-fibrous (Other)	None Detected
M-7-2-Adhesive 352304525-0025A	BR 1, vinyl baseboard trim w/adhesive	Yellow Non-Fibrous Homogeneous		100% Non-fibrous (Other)	None Detected
M-7-3-Baseboard 352304525-0026	BR 1, vinyl baseboard trim w/adhesive	White Non-Fibrous Homogeneous		100% Non-fibrous (Other)	None Detected
M-7-3-Adhesive 352304525-0026A	BR 1, vinyl baseboard trim w/adhesive	Brown Non-Fibrous Homogeneous		100% Non-fibrous (Other)	None Detected
M-8-1 352304525-0027	BR 1, caulk under sink	Tan Non-Fibrous Homogeneous		100% Non-fibrous (Other)	None Detected
M-9-1-Baseboard 352304525-0028	BR 2, vinyl baseboard trim w/adhesive	Brown Non-Fibrous Homogeneous		100% Non-fibrous (Other)	None Detected
M-9-1-Yellow Adhesive 352304525-0028A	BR 2, vinyl baseboard trim w/adhesive	Yellow Non-Fibrous Homogeneous		100% Non-fibrous (Other)	None Detected
M-9-1-Brown Adhesive 352304525-0028B	BR 2, vinyl baseboard trim w/adhesive	Brown Non-Fibrous Homogeneous		100% Non-fibrous (Other)	None Detected
M-9-2-Baseboard 352304525-0029	Hallway, vinyl baseboard trim w/adhesive	Brown Non-Fibrous Homogeneous		100% Non-fibrous (Other)	None Detected
M-9-2-Adhesive 352304525-0029A	Hallway, vinyl baseboard trim w/adhesive	Yellow Non-Fibrous Homogeneous		100% Non-fibrous (Other)	None Detected
M-9-3-Baseboard 352304525-0030	BR 3, vinyl baseboard trim w/adhesive	Brown Non-Fibrous Homogeneous		100% Non-fibrous (Other)	None Detected
M-9-3-Adhesive 352304525-0030A	BR 3, vinyl baseboard trim w/adhesive	Yellow Non-Fibrous Homogeneous		100% Non-fibrous (Other)	None Detected

Initial report from: 05/31/2023 12:35:29



EMSL Analytical, Inc.

3410 Winnetka Avenue North New Hope, MN 55427

Tel/Fax: (763) 449-4922 / (763) 449-4924

<http://www.EMSL.com / minneapolislab@emsl.com>

EMSL Order: 352304525

Customer ID: SEHI80

Customer PO:

Project ID:

Test Report: Asbestos Analysis of Bulk Materials via AHERA Method 40CFR 763 Subpart E Appendix E supplemented with EPA 600/R-93/116 using Polarized Light Microscopy

Sample	Description	Appearance	Non-Asbestos		Asbestos
			% Fibrous	% Non-Fibrous	% Type
M-10-1-Floor Tile 352304525-0031	BR 2, tile flooring	Tan Non-Fibrous Homogeneous		100% Non-fibrous (Other)	None Detected
M-10-1-Mastic 352304525-0031A	BR 2, tile flooring	Black Non-Fibrous Homogeneous		90% Non-fibrous (Other)	10% Chrysotile
M-10-2-Floor Tile 352304525-0032	BR 3, tile flooring	Tan Non-Fibrous Homogeneous		100% Non-fibrous (Other)	None Detected
M-10-2-Mastic 352304525-0032A	BR 3, tile flooring				Positive Stop (Not Analyzed)
M-10-3-Floor Tile 352304525-0033	Lobby, tile flooring	Tan Non-Fibrous Homogeneous		100% Non-fibrous (Other)	None Detected
M-10-3-Mastic 352304525-0033A	Lobby, tile flooring				Positive Stop (Not Analyzed)
M-11-1 352304525-0034	Kitchen, cinder block wall	Gray Non-Fibrous Homogeneous		100% Non-fibrous (Other)	None Detected
M-12-1 352304525-0035	Upstairs by Stairwell, concrete floor	Gray Non-Fibrous Homogeneous		100% Non-fibrous (Other)	None Detected

Analyst(s)

Daniel Nordland (51)

Rachel Travis, Laboratory Manager
or Other Approved Signatory

EMSL maintains liability limited to cost of analysis. Interpretation and use of test results are the responsibility of the client. This report relates only to the samples reported above, and may not be reproduced, except in full, without written approval by EMSL. EMSL bears no responsibility for sample collection activities or analytical method limitations. The report reflects the samples as received. Results are generated from the field sampling data (sampling volumes and areas, locations, etc.) provided by the client on the Chain of Custody. Samples are within quality control criteria and met method specifications unless otherwise noted. The above analyses were performed in general compliance with Appendix E to Subpart E of 40 CFR (previously EPA 600/M4-82-020 "Interim Method") but augmented with procedures outlined in the 1993 ("final") version of the method. This report must not be used by the client to claim product certification, approval, or endorsement by NVLAP, NIST or any agency of the federal government. Non-friable organically bound materials present a problem matrix and therefore EMSL recommends gravimetric reduction prior to analysis. Unless requested by the client, building materials manufactured with multiple layers (i.e. linoleum, wallboard, etc.) are reported as a single sample. Estimation of uncertainty is available on request.

Samples analyzed by EMSL Analytical, Inc. New Hope, MN NVLAP Lab Code 200019-0; Colorado AL-24478

Initial report from: 05/31/2023 12:35:29



EMSL ANALYTICAL, INC.
TESTING LABS • PRODUCTS • TRAINING

Asbestos Chain of Custody (Air, Bulk, Soil)

EMSL Order Number / Lab Use Only

352304525

EMSL Analytical, Inc.
200 Route 130 North
Cinnaminson, NJ 08077

PHONE: (800) 220-3675
EMAIL: CinnAbLab@EMSL.com

Customer Information Customer ID: _____ Company Name: <u>SEH</u> Contact Name: <u>Jennifer Force</u> Street Address: <u>3535 Vadnais Center Dr.</u> City, State, Zip: <u>St. Paul MN 55110</u> Country: _____ Phone: <u>612 834 2430</u> Email(s) for Report: <u>JForce@SEH-AL.COM</u>		If Bill-To is the same as Report-To leave this section blank. Third-party billing requires written authorization. Billing ID: _____ Company Name: _____ Billing Contact: _____ Street Address: _____ City, State, Zip: _____ Country: _____ Phone: _____ Email(s) for Invoice: _____	
Project Information			
Project Name/No: <u>DULAI 172133 Sky Harbor</u>		Purchase Order: _____	
EMSL LIMS Project ID: _____ (If applicable, EMSL will provide)		US State where samples collected: <u>MN</u>	
Sampled By Name: <u>Robert Hawkins</u>		Sampled By Signature: <u>[Signature]</u>	
		State of Connecticut (CT) must select project location: <input type="checkbox"/> Commercial (Taxable) <input type="checkbox"/> Residential (Non-Taxable)	
		No. of Samples In Shipment: _____	
Turn-Around-Time (TAT) <input type="checkbox"/> 3 Hour <input type="checkbox"/> 4-6 Hour AHERA ONLY <input type="checkbox"/> 6 Hour <input type="checkbox"/> 24 Hour <input type="checkbox"/> 32 Hour <input type="checkbox"/> 48 Hour <input checked="" type="checkbox"/> 72 Hour <input type="checkbox"/> 96 Hour <input type="checkbox"/> 1 Week <input type="checkbox"/> 2 Week <small>TEM Air 3-6 Hour, please call ahead to schedule. 32 Hour TAT available for select tests only; samples must be submitted by 11:30 a.m.</small>			
Test Selection			
PCM Air <input type="checkbox"/> NIOSH 7400 <input type="checkbox"/> NIOSH 7400 w/ 8hr. TWA <input checked="" type="checkbox"/> PLM - Bulk (reporting limit) <input checked="" type="checkbox"/> PLM EPA 600/R-93/116 (<1%) <input type="checkbox"/> PLM EPA NOB (<1%) <input type="checkbox"/> POINT COUNT <input type="checkbox"/> 400 (<0.25%) <input type="checkbox"/> 1,000 (<0.1%) POINT COUNT w/ GRAVIMETRIC <input type="checkbox"/> 400 (<0.25%) <input type="checkbox"/> 1,000 (<0.1%) <input type="checkbox"/> NIOSH 9002 (<1%) <input type="checkbox"/> NYS 198.1 (Friable - NY) <input type="checkbox"/> NYS 198.6 NOB (Non-Friable - NY) <input type="checkbox"/> NYS 198.8 (Vermiculite SM-V)		TEM - Air <input type="checkbox"/> AHERA 40 CFR, Part 763 <input type="checkbox"/> NIOSH 7402 <input type="checkbox"/> EPA Level II <input type="checkbox"/> ISO 10312* TEM - Bulk <input type="checkbox"/> TEM EPA NOB <input type="checkbox"/> NYS NOB 198.4 (Non-Friable-NY) <input type="checkbox"/> TEM EPA 600/R-93/116 w/ Milling Prep (0.1%) Other Test (please specify) _____	
		TEM - Settled Dust <input type="checkbox"/> Microvac - ASTM D5755 <input type="checkbox"/> Wipe - ASTM D6460 <input type="checkbox"/> Qualitative via Filtration Prep <input type="checkbox"/> Qualitative via Drop Mount Prep	
		Soil - Rock - Vermiculite (reporting limit)* <input type="checkbox"/> PLM EPA 600/R-93/116 with milling prep (<0.25%) <input type="checkbox"/> PLM EPA 600/R-93/116 with milling prep (<0.1%) <input type="checkbox"/> TEM EPA 600/R-93/116 with milling prep (<0.1%) <input type="checkbox"/> TEM Qualitative via Filtration Prep <input type="checkbox"/> TEM Qualitative via Drop Mount Prep	
<small>*Please call with your project-specific requirements.</small>			
<input checked="" type="checkbox"/> Positive Step - Clearly Identified Homogeneous Areas (HA)		Filter Pore Size (Air Samples) <input type="checkbox"/> 0.8um <input type="checkbox"/> 0.45um	
Sample Number	Sample Location / Description	Volume, Area or Homogeneous Area	Date / Time Sampled (Air Monitoring Only)
M-1-1	Kitchen, Vinyl Flooring	88 ft ²	5/23/23
M-1-2	Laundry Room, Vinyl Flooring	" "	" "
M-1-3	" "	" "	" "
M-2-1	Kitchen Closet, Drywall	1.032 ft ²	" "
M-2-2	Office 1, " "	" "	" "
M-2-3	BR 1, " "	" "	" "
M-2-4	Office 2, " "	" "	" "
M-2-5	Laundry Room, " "	" "	" "
Special Instructions and/or Regulatory Requirements (Sample Specifications, Processing Methods, Limits of Detection, etc.) _____			
Method of Shipment: _____		Sample Condition Upon Receipt: _____	
Relinquished by: _____	Date/Time: _____	Received by: <u>[Signature]</u>	Date/Time: <u>5/23/23 10:05</u>
Relinquished by: _____	Date/Time: _____	Received by: _____	Date/Time: _____

Controlled Document - COC-95 Asbestos R16 10/25/2021

☐ AGREE TO ELECTRONIC SIGNATURE (By checking, I consent to signing this Chain of Custody document by electronic signature.)

EMSL Analytical, Inc.'s Laboratory Terms and Conditions are incorporated into this Chain of Custody by reference in their entirety. Submission of samples to EMSL Analytical, Inc. constitutes acceptance and acknowledgment of all terms and conditions by Customer.

F-E. 2963709304

Page 1 of



Asbestos Chain of Custody (Air, Bulk, Soil)

EMSL Order Number / Lab Use Only

EMSL Analytical, Inc.
200 Route 130 North
Cinnaminson, NJ 08077

PHONE: (800) 220-3675

EMAIL: CinnAsblab@EMSL.com

EMSL ANALYTICAL, INC.
TESTING LABS • PRODUCTS • TRAINING

Additional Pages of the Chain of Custody are only necessary if needed for additional sample information.

Special Instructions and/or Regulatory Requirements (Sample Specifications, Processing Methods, Limits of Detection, etc.)

Sample Number	Sample Location / Description	Volume, Area or Homogeneous Area	Date / Time Sampled (Air Monitoring Only)
M-3-1	Kitchen, Vinyl Kitchen Countertop	16 ft ²	5/23/23
M-3-2	" "	" "	
M-3-3	" "	" "	
S-1-1	Coating on Kitchen Sink	4 ft ²	
S-1-2	" "	" "	
S-1-3	" "	" "	
M-4-1	Office 1, Vinyl baseboard trim w/ Adhesive	12 ft ²	
M-4-2	" "	" "	
M-4-3	" "	" "	
M-5-1	Office 2, Ceiling tile w/ swirls	584 ft ²	
M-5-2	" "	" "	
M-5-3	" "	" "	
M-6-1	BR1, Vinyl flooring	64 ft ²	
M-6-2	" "	" "	
M-6-3	" "	" "	
M-7-1	BR1, Vinyl baseboard trim w/ Adhesive	9 ft ²	
M-7-2	" "	" "	
M-7-3	" "	" "	
M-8-1	BR1, Caulk under Sink	< 1 ft ²	
M-9-1	BR2, Vinyl baseboard trim w/ Adhesive	50 ft ²	
M-9-2	Hallway, " "	" "	
M-9-3	BR3, " "	" "	
M-10-1	BR2, Tile Flooring	560 ft ²	
M-10-2	BR3, " "	" "	
M-10-3	Lobby, " "	" "	

Method of Shipment:		Sample Condition Upon Receipt:	
Relinquished by:	Date/Time:	Received by:	Date/Time:
Relinquished by:	Date/Time:	Received by:	Date/Time:

Controlled Document - CDC-45 Asbestos R16 10/26/2021

☐ AGREE TO ELECTRONIC SIGNATURE (By checking, I consent to signing this Chain of Custody document by electronic signature.)

EMSL Analytical, Inc.'s Laboratory Terms and Conditions are incorporated into this Chain of Custody by reference in their entirety. Submission of samples to EMSL Analytical, Inc. constitutes acceptance and acknowledgment of all terms and conditions by Customer.

EMSL Order Number / Lab Use Only

Cinnaminson, NJ 08077

Additional Pages of the Chain of Custody

EMAIL: CinnAsblab@EMSL.com

Additional Pages of the Chain of Custody are only necessary if needed for additional sample information

Special Instructions and/or Regulatory Requirements (Sample Specifications, Processing Methods, Limits of Detection, etc.)

Controlled Document - CDC-05 Asbestos R10 10/26/2021

AGREE TO ELECTRONIC SIGNATURE (By checking, I consent to signing this Chain of Custody document by electronic signature.)

Page of



EMSL Analytical, Inc.

3410 Winnetka Avenue North, New Hope, MN 55427

Phone/Fax: (763) 449-4922 / (763) 449-4924

<http://www.EMSL.com>

minneapolislab@emsl.com

EMSL Order: 352303133

CustomerID: SEHI80

CustomerPO:

ProjectID:

Attn: **Jennifer Force**
Short Elliot & Hendrickson
3535 Vadnais Center Drive
Saint Paul, MN 55110

Phone: (651) 490-2000
Fax: (651) 490-2150
Received: 4/14/2023 09:20 AM
Collected: 4/13/2023

Project: **Sky Harbor Survey Dulai 172133**

Test Report: Lead in Paint Chips by Flame AAS (SW 846 3050B/7000B)*

Client SampleDescription	Collected	Analyzed	Weight	RDL	Lead Concentration
Paint-1 352303133-0001	4/13/2023	4/24/2023 Site: Kitchen Wall	0.1872 g	110 ppm	<110 ppm

Rachel Travis, Laboratory Manager
or other approved signatory

EMSL maintains liability limited to cost of analysis. Interpretation and use of test results are the responsibility of the client. This report relates only to the samples reported above, and may not be reproduced, except in full, without written approval by EMSL. EMSL bears no responsibility for sample collection activities or analytical method limitations. The report reflects the samples as received. Results are generated from the field sampling data (sampling volumes and areas, locations, etc.) provided by the client on the Chain of Custody. Samples are within quality control criteria and met method specifications unless otherwise noted.

* Analysis following Lead in Paint by EMSL SOP/Determination of Environmental Lead by FLAA. Reporting limit is 0.008% wt based on the minimum sample weight per our SOP. "<" (less than) result signifies the analyte was not detected at or above the reporting limit. Measurement of uncertainty is available upon request. Definitions of modifications are available upon request.

Samples analyzed by EMSL Analytical, Inc. New Hope, MN AIHA LAP, LLC-ELLAP Accredited #101103

Initial report from 04/24/2023 16:25:30



EMSL Analytical, Inc.
3410 Winnetka Avenue North
New Hope, MN 55427
(763) 449-4922

Jennifer Force
Short Elliot & Hendrickson
3535 Vadnais Center Drive
Saint Paul, MN 55110

May 09, 2023
Report #: 2300165

RE: Sky Harbor Survey Dulai 172133

Dear Jennifer Force:

EMSL Analytical, Inc. received samples for the project identified above on April 14, 2023. All samples were received in acceptable condition and analyzed in the EMSL Analytical, Inc. laboratory unless otherwise noted. Analytical results are summarized in the following report. These results are not method blank or field blank corrected unless otherwise indicated. All routine quality assurance procedures were followed and all quality control acceptance criteria were met, unless otherwise noted.

EMSL Analytical, Inc. (ID 101103) is an EPA-recognized NLLAP laboratory based on its accreditation by the AIHA Laboratory Accreditation Programs, LLC (AIHA-LAP, LLC) in the Environmental Lead and Industrial Hygiene laboratory accreditation programs as documented by the Scope of Accreditation Certificate and associated Scope.

Where possible, the samples will be retained by the laboratory for 60 days following issuance of the initial final report. The samples will be disposed of or returned at that time. Arrangements can be made for extended storage by contacting me at this time.

We appreciate your decision to use EMSL Analytical, Inc. for this project. We are committed to being your vendor of choice to meet your analytical chemistry needs.

If you have any questions please contact me at the above phone number.

Sincerely,

Mark Erickson
Project Manager



EMSL Analytical, Inc.
3410 Winnetka Avenue North
New Hope, MN 55427
(763) 449-4922

Short Elliot & Hendrickson
3535 Vadnais Center Drive
Saint Paul, MN 55110

Client Ref: Sky Harbor Survey Dulai 172133
Client Contact: Jennifer Force
PO Number: NA

Report #: 2300165
Project Mgr: Mark Erickson
Account ID: SEHI80

Qualifiers and Abbreviations

qn	The spike recovery is outside of laboratory control limits for the matrix spike (MS) and/or the matrix spike duplicate (MSD).
COC	Chain of Custody
MRL	Method Reporting Limit
ppm	Parts per million in Air
NA	Not Applicable
NR	Not Reported
%Rec	Percent Recovery
RPD	Relative Percent Difference

EMSL maintains liability limited to cost of analysis. Interpretation and use of test results are the responsibility of the client. This report relates only to the samples reported above, and may not be reproduced, except in full, without written approval by EMSL. EMSL bears no responsibility for sample collection activities or analytical method limitations. The report reflects the samples as received. Results are generated from the field sampling data (sampling volumes and areas, locations, etc.) provided by the client on the Chain of Custody. Samples are within quality control criteria and met method specifications unless otherwise noted.



EMSL Analytical, Inc.
3410 Winnetka Avenue North
New Hope, MN 55427
(763) 449-4922

Short Elliot & Hendrickson
3535 Vadnais Center Drive
Saint Paul, MN 55110

Client Ref: Sky Harbor Survey Dulai 172133
Client Contact: Jennifer Force
PO Number: NA

Report #: 2300165
Project Mgr: Mark Erickson
Account ID: SEHI80

Sample Summary

Sample ID	Laboratory ID	Matrix	Area, Air Volume or Time Sampled	Date Sampled	Date Received
Caulk-1 - Window caulk sample	2300165-01	Solid	NA	04/13/23 00:00	04/14/23 09:20

EMSL maintains liability limited to cost of analysis. Interpretation and use of test results are the responsibility of the client. This report relates only to the samples reported above, and may not be reproduced, except in full, without written approval by EMSL. EMSL bears no responsibility for sample collection activities or analytical method limitations. The report reflects the samples as received. Results are generated from the field sampling data (sampling volumes and areas, locations, etc.) provided by the client on the Chain of Custody. Samples are within quality control criteria and met method specifications unless otherwise noted.



EMSL Analytical, Inc.
3410 Winnetka Avenue North
New Hope, MN 55427
(763) 449-4922

Short Elliot & Hendrickson
3535 Vadnais Center Drive
Saint Paul, MN 55110

Client Ref: Sky Harbor Survey Dulai 172133
Client Contact: Jennifer Force
PO Number: NA

Report #: 2300165
Project Mgr: Mark Erickson
Account ID: SEHI80

Analyte	Result	MRL	Units	Dilution	Prepared	Analyzed	Analyst	Method	Notes
EMSL Analytical, Inc.									
2300165-01 Caulk-1 - Window caulk sample (Solid)									
Aroclor-1016	< 0.45	0.45	mg/kg	1	4/27/23	5/5/23	MDE	EPA 8082A	
Aroclor-1221	< 0.45	0.45	mg/kg	1	4/27/23	5/5/23	MDE	EPA 8082A	
Aroclor-1232	< 0.45	0.45	mg/kg	1	4/27/23	5/5/23	MDE	EPA 8082A	
Aroclor-1242	< 0.45	0.45	mg/kg	1	4/27/23	5/5/23	MDE	EPA 8082A	
Aroclor-1248	< 0.45	0.45	mg/kg	1	4/27/23	5/5/23	MDE	EPA 8082A	
Aroclor-1254	< 0.45	0.45	mg/kg	1	4/27/23	5/5/23	MDE	EPA 8082A	
Aroclor-1260	< 0.45	0.45	mg/kg	1	4/27/23	5/5/23	MDE	EPA 8082A	
Aroclor-1262	< 0.45	0.45	mg/kg	1	4/27/23	5/5/23	MDE	EPA 8082A	
Aroclor-1268	< 0.45	0.45	mg/kg	1	4/27/23	5/5/23	MDE	EPA 8082A	
Surrogate: Decachlorobiphenyl	73.9 %	Limits: 50-150%			4/27/23	5/5/23	MDE	EPA 8082A	
Surrogate: TCMX	81.9 %	Limits: 50-140%			4/27/23	5/5/23	MDE	EPA 8082A	

EMSL maintains liability limited to cost of analysis. Interpretation and use of test results are the responsibility of the client. This report relates only to the samples reported above, and may not be reproduced, except in full, without written approval by EMSL. EMSL bears no responsibility for sample collection activities or analytical method limitations. The report reflects the samples as received. Results are generated from the field sampling data (sampling volumes and areas, locations, etc.) provided by the client on the Chain of Custody. Samples are within quality control criteria and met method specifications unless otherwise noted.



EMSL Analytical, Inc.
3410 Winnetka Avenue North
New Hope, MN 55427
(763) 449-4922

Short Elliot & Hendrickson
3535 Vadnais Center Drive
Saint Paul, MN 55110

Client Ref: Sky Harbor Survey Dulai 172133
Client Contact: Jennifer Force
PO Number: NA

Report #: 2300165
Project Mgr: Mark Erickson
Account ID: SEH180

Environmental Chemistry Chain of Custody									
EMSL Order Number / Lab Use Only									
2300165-352303045									
EMSL ANALYTICAL, INC. PHONE: (800) 220-3675 EMAIL: EnvChemistry2@EMSL.com									
Customer Information					Billing Information				
Customer ID:					Billing ID:				
Company Name: SEH					Company Name:				
Contact Name: Jennifer Force					Billing Contact:				
Street Address: 3535 Vadnais Center Dr.					Street Address:				
City, State, Zip: St. Paul, MN 55110					City, State, Zip:				
Country: USA					Country:				
Phone: 651.424.0535					Phone:				
Email(s) for Report: jforce@sehinc.com					Email(s) for Invoice:				
Project Name/No: Sky Harbor Survey Dulai 172133									
Purchase Order:									
EMSL LIMS Project ID: (If applicable, EMSL will provide)									
US State where samples collected:									
State of Connecticut (CT) must select project location:									
<input type="checkbox"/> Commercial (Taxable) <input type="checkbox"/> Residential (Non-Taxable)									
PWS ID:									
State Reporting Required?									
<input type="checkbox"/> Yes <input type="checkbox"/> No									
Samples for Compliance? <input type="checkbox"/> Yes <input type="checkbox"/> No If Yes, for NPDES? <input type="checkbox"/> Yes <input type="checkbox"/> No Other (Specify)									
Samples Collected by (Check One): <input type="checkbox"/> EMSL <input checked="" type="checkbox"/> CLIENT Samples Received Chilled? <input type="checkbox"/> Yes <input checked="" type="checkbox"/> No									
Sample(s) Temperature Upon Receipt (LAB ONLY)									
Sampled By Name: Elliott Allen Sampled By Signature: [Signature]									
No. of Samples in Shipment:									
Turn-Around-Time (TAT) Standard Turn-Around-Time: <input checked="" type="checkbox"/> 2 Weeks The following TAT's are subject to Lab approval. Call lab to confirm TAT before submital: <input type="checkbox"/> 1 Week <input type="checkbox"/> 4 Days <input type="checkbox"/> 3 Days <input type="checkbox"/> 2 Days <input type="checkbox"/> 1 Day									
Client Sample ID									
Comp									
Grab									
Date / Time Collected									
Matrix									
Preservative									
List Test(s) Needed (Write in test below, then check on sample line:)									
W=Water S=Soil A=Air SL=Sludge O=Other									
1 HCL 2 HNO3 3 H2SO4 4 ICE 5 Other Describe below in Special Instructions									
Test 1: PCBs									
Test 2:									
Test 3:									
Test 4:									
Test 5:									
Test 6:									
Test 7:									
Test 8:									
Comments									
Caulk-1									
X									
4/13									
0									
X									
Window caulk sample									
Special Instructions and/or Regulatory Requirements (Sample Specifications, Processing Methods, Limits of Detection, etc.)									
Reporting Requirements: <input type="checkbox"/> Results Only <input checked="" type="checkbox"/> Results and QC <input type="checkbox"/> Reduced Deliverables <input type="checkbox"/> Hzresults EDD <input type="checkbox"/> Excel <input type="checkbox"/> Other (Describe Above)									
Method of Shipment: FedEx									
Sample Condition Upon Receipt:									
Relinquished by: Elliott Allen									
Date/Time: 1515 4/13/23									
Received by: DL									
Date/Time: 4/14/23 9:20am									
Relinquished by:									
Date/Time:									
Received by:									
Date/Time:									
Controlled Document - COC-07 Chemistry R11 02/26/2021									
<input type="checkbox"/> AGREE TO ELECTRONIC SIGNATURE (By checking, I consent to signing this Chain of Custody document by electronic signature.)									
FE: 3969 9913 5815 Page 1 of									

EMSL maintains liability limited to cost of analysis. Interpretation and use of test results are the responsibility of the client. This report relates only to the samples reported above, and may not be reproduced, except in full, without written approval by EMSL. EMSL bears no responsibility for sample collection activities or analytical method limitations. The report reflects the samples as received. Results are generated from the field sampling data (sampling volumes and areas, locations, etc.) provided by the client on the Chain of Custody. Samples are within quality control criteria and met method specifications unless otherwise noted.



Building a Better World for All of Us®

Building a Better World for All of Us®

Sustainable buildings, sound infrastructure, safe transportation systems, clean water, renewable energy and a balanced environment. Building a Better World for All of Us communicates a companywide commitment to act in the best interests of our clients and the world around us.

We're confident in our ability to balance these requirements.



Save: 5/17/2023 6:17 AM: sldtteman_Plot_6/2/2023 3:42 PM X:\AE\DU\AL\172133\5-final.dwg 151-drawings\05-Aviation\PLANS\DYT-172133_TOC.dwg

Statement of Estimated Quantities		
Page #	Sheet #	Sheet Title
1 of 55	G0.00	TITLE SHEET
2 of 55	G0.01	TABLE OF CONTENTS
3 of 55	G1.00	CONSTRUCTION SAFETY PLAN
4 of 55	G1.10	CONSTRUCTION PHASING PLAN
5 of 55	G2.00	GENERAL NOTES
6 of 55	G2.10	STATEMENT OF ESTIMATED QUANTITIES
7 of 55	G3.00	SURVEY CONTROL AND EXISTING CONDITIONS PLAN
8 of 55	C1.00	EROSION CONTROL PLAN
9 of 55	C1.10	EROSION CONTROL DETAILS
10 of 55	C2.00	DEMOLITION PLAN (BUILDING)
11 of 55	C2.10	DEMOLITION PLAN (SITE)
12 of 55	C2.20	INTERIM TERMINAL FACILITY & TEMPORARY SETUP
13 of 55	C3.00	TYPICAL SECTIONS
14 of 55	C3.10	PEDESTRIAN CURB RAMP DETAILS (1 OF 6)
15 of 55	C3.11	PEDESTRIAN CURB RAMP DETAILS (2 OF 6)
16 of 55	C3.12	PEDESTRIAN CURB RAMP DETAILS (3 OF 6)
17 of 55	C3.13	PEDESTRIAN CURB RAMP DETAILS (4 OF 6)
18 of 55	C3.14	PEDESTRIAN CURB RAMP DETAILS (5 OF 6)
19 of 55	C3.15	PEDESTRIAN CURB RAMP DETAILS (6 OF 6)
20 of 55	C4.00	PAVEMENT PLAN
21 of 55	C5.00	GRADING PLAN
22 of 55	C5.01	GRADING PLAN (AIRSIDE SLAB & SLOPED WALKWAY)
23 of 55	C5.02	GRADING PLAN
	C5.03	LANDSCAPE PLAN
24 of 55	C6.00	UTILITY PLAN (SEWER & WATER)
25 of 55	C6.01	UTILITY DETAILS - WATER & SANITARY
26 of 55	C7.00	PAVEMENT MARKING AND FENCING PLAN
27 of 55	S001	GENERAL ABBREVIATIONS AND SYMBOLS
28 of 55	S002	GENERAL STRUCTURAL NOTES
29 of 55	S003	GENERAL STRUCTURAL NOTES
30 of 55	S101	FOUNDATION PLAN
31 of 55	S201	ROOF FRAMING PLAN
32 of 55	S501	FOUNDATION DETAILS
33 of 55	S502	FOUNDATION DETAILS
34 of 55	S503	FRAMING DETAILS
35 of 55	A001	CODE PLAN
36 of 55	A002	CODE ANALYSIS
37 of 55	A003	ARCHITECTURAL SYMBOLS, LEGEND, NOTES, WALL TYPES AND ACCESSIBILITY DETAILS
38 of 55	A004	DEMOLITION PLANS AND SECTIONS
39 of 55	A100	OVERALL FLOOR PLAN
40 of 55	A101	ADDITION FLOOR PLAN
41 of 55	A102	ROOF PLAN AND CEILING PLAN
	A200	EXTERIOR ELEVATIONS
	A201	EXTERIOR ELEVATIONS
	A300	WALL SECTIONS AND DETAILS
	A301	WALL SECTIONS AND DETAILS
42 of 55	A400	INTERIOR ELEVATIONS AND DETAILS
43 of 55	A500	SCHEDULES, DOOR, WINDOW AND FRAME TYPES
44 of 55	MEP100	EQUIPMENT SCHEDULE
45 of 55	MP000	MECHANICAL/PLUMBING DEMOLITION PLAN
46 of 55	P100	UNDERFLOOR PLUMBING PLAN
47 of 55	P101	ABOVE FLOOR PLUMBING PLAN
48 of 55	P102	PLUMBING RISERS
49 of 55	M100	HVAC PLAN
50 of 55	EOOO	LOWER LEVEL AND UPPER LEVEL ELECTRICAL DEMOLITION PLAN
51 of 55	E100	POWER PLAN
52 of 55	E200	LIGHTING PLAN
53 of 55	E300	ELECTRICAL SCHEDULES & DETAILS
54 of 55	E301	ELECTRICAL SCHEDULES & DETAILS
55 of 55	E400	ELECTRICAL SITE PLAN



I HEREBY CERTIFY THAT THIS PLAN, SPECIFICATION, OR REPORT WAS PREPARED BY ME OR UNDER MY DIRECT SUPERVISION AND THAT I AM A DULY LICENSED PROFESSIONAL ENGINEER UNDER THE LAWS OF THE STATE OF MINNESOTA.


RYAN FALCH, PE

DATE: 5/17/2023 LICENSE NO. 60494



SKY HARBOR AIRPORT
2023 RECONSTRUCT TERMINAL BUILDING

DULUTH, MN

This drawing is an instrument of service and shall remain the property of Short Elliott Hendrickson, Inc. (SEH). This drawing, concepts and ideas contained herein shall not be used, reproduced, revised, or retained without the express written approval of SEH. All Rights Reserved.

Submission or distribution of this drawing to meet official or regulatory requirements or for purposes of publication in derogation of any of the rights of SEH.

SEH Project DULAI_172133
Checked By RF
Drawn By ALS

Project Status Issue Date
CONSTRUCTION 05/17/2023
PLANS

REVISION SCHEDULE		
REV. #	DESCRIPTION	DATE
1	ADDENDUM #2	6/2/2023

TABLE OF CONTENTS

G0.01



I HEREBY CERTIFY THAT THIS PLAN, SPECIFICATION, OR REPORT WAS PREPARED BY ME OR UNDER MY DIRECT SUPERVISION AND THAT I AM A DULY LICENSED PROFESSIONAL ENGINEER UNDER THE LAWS OF THE STATE OF MINNESOTA.

Ryan Falch
RYAN FALCH, P.E.
DATE 05/17/2023 LICENSE NO. 60494



SKY HARBOR AIRPORT
2023 RECONSTRUCT TERMINAL BUILDING
DULUTH, MN

This drawing is an instrument of service and shall remain the property of Short Elliott Hendrickson, Inc. (SEH). This drawing, concepts and ideas contained herein shall not be used, reproduced, revised, or related without the express written approval of SEH.

Submission or distribution of this drawing to meet official or regulatory requirements or for purposes in connection with the project is not to be construed as publication in derogation of any of the rights of SEH.

COPYRIGHT © 2023
Short Elliott Hendrickson, Inc.
All Rights Reserved


SEH Project DULAL_172133
Checked By RF
Drawn By ALS

Project Status Issue Date
CONSTRUCTION 05/17/2023
PLANS

REVISION SCHEDULE		
REV. #	DESCRIPTION	DATE
1	ADDENDUM #2	6/2/2023

CONSTRUCTION PHASING
PLAN

G1.10

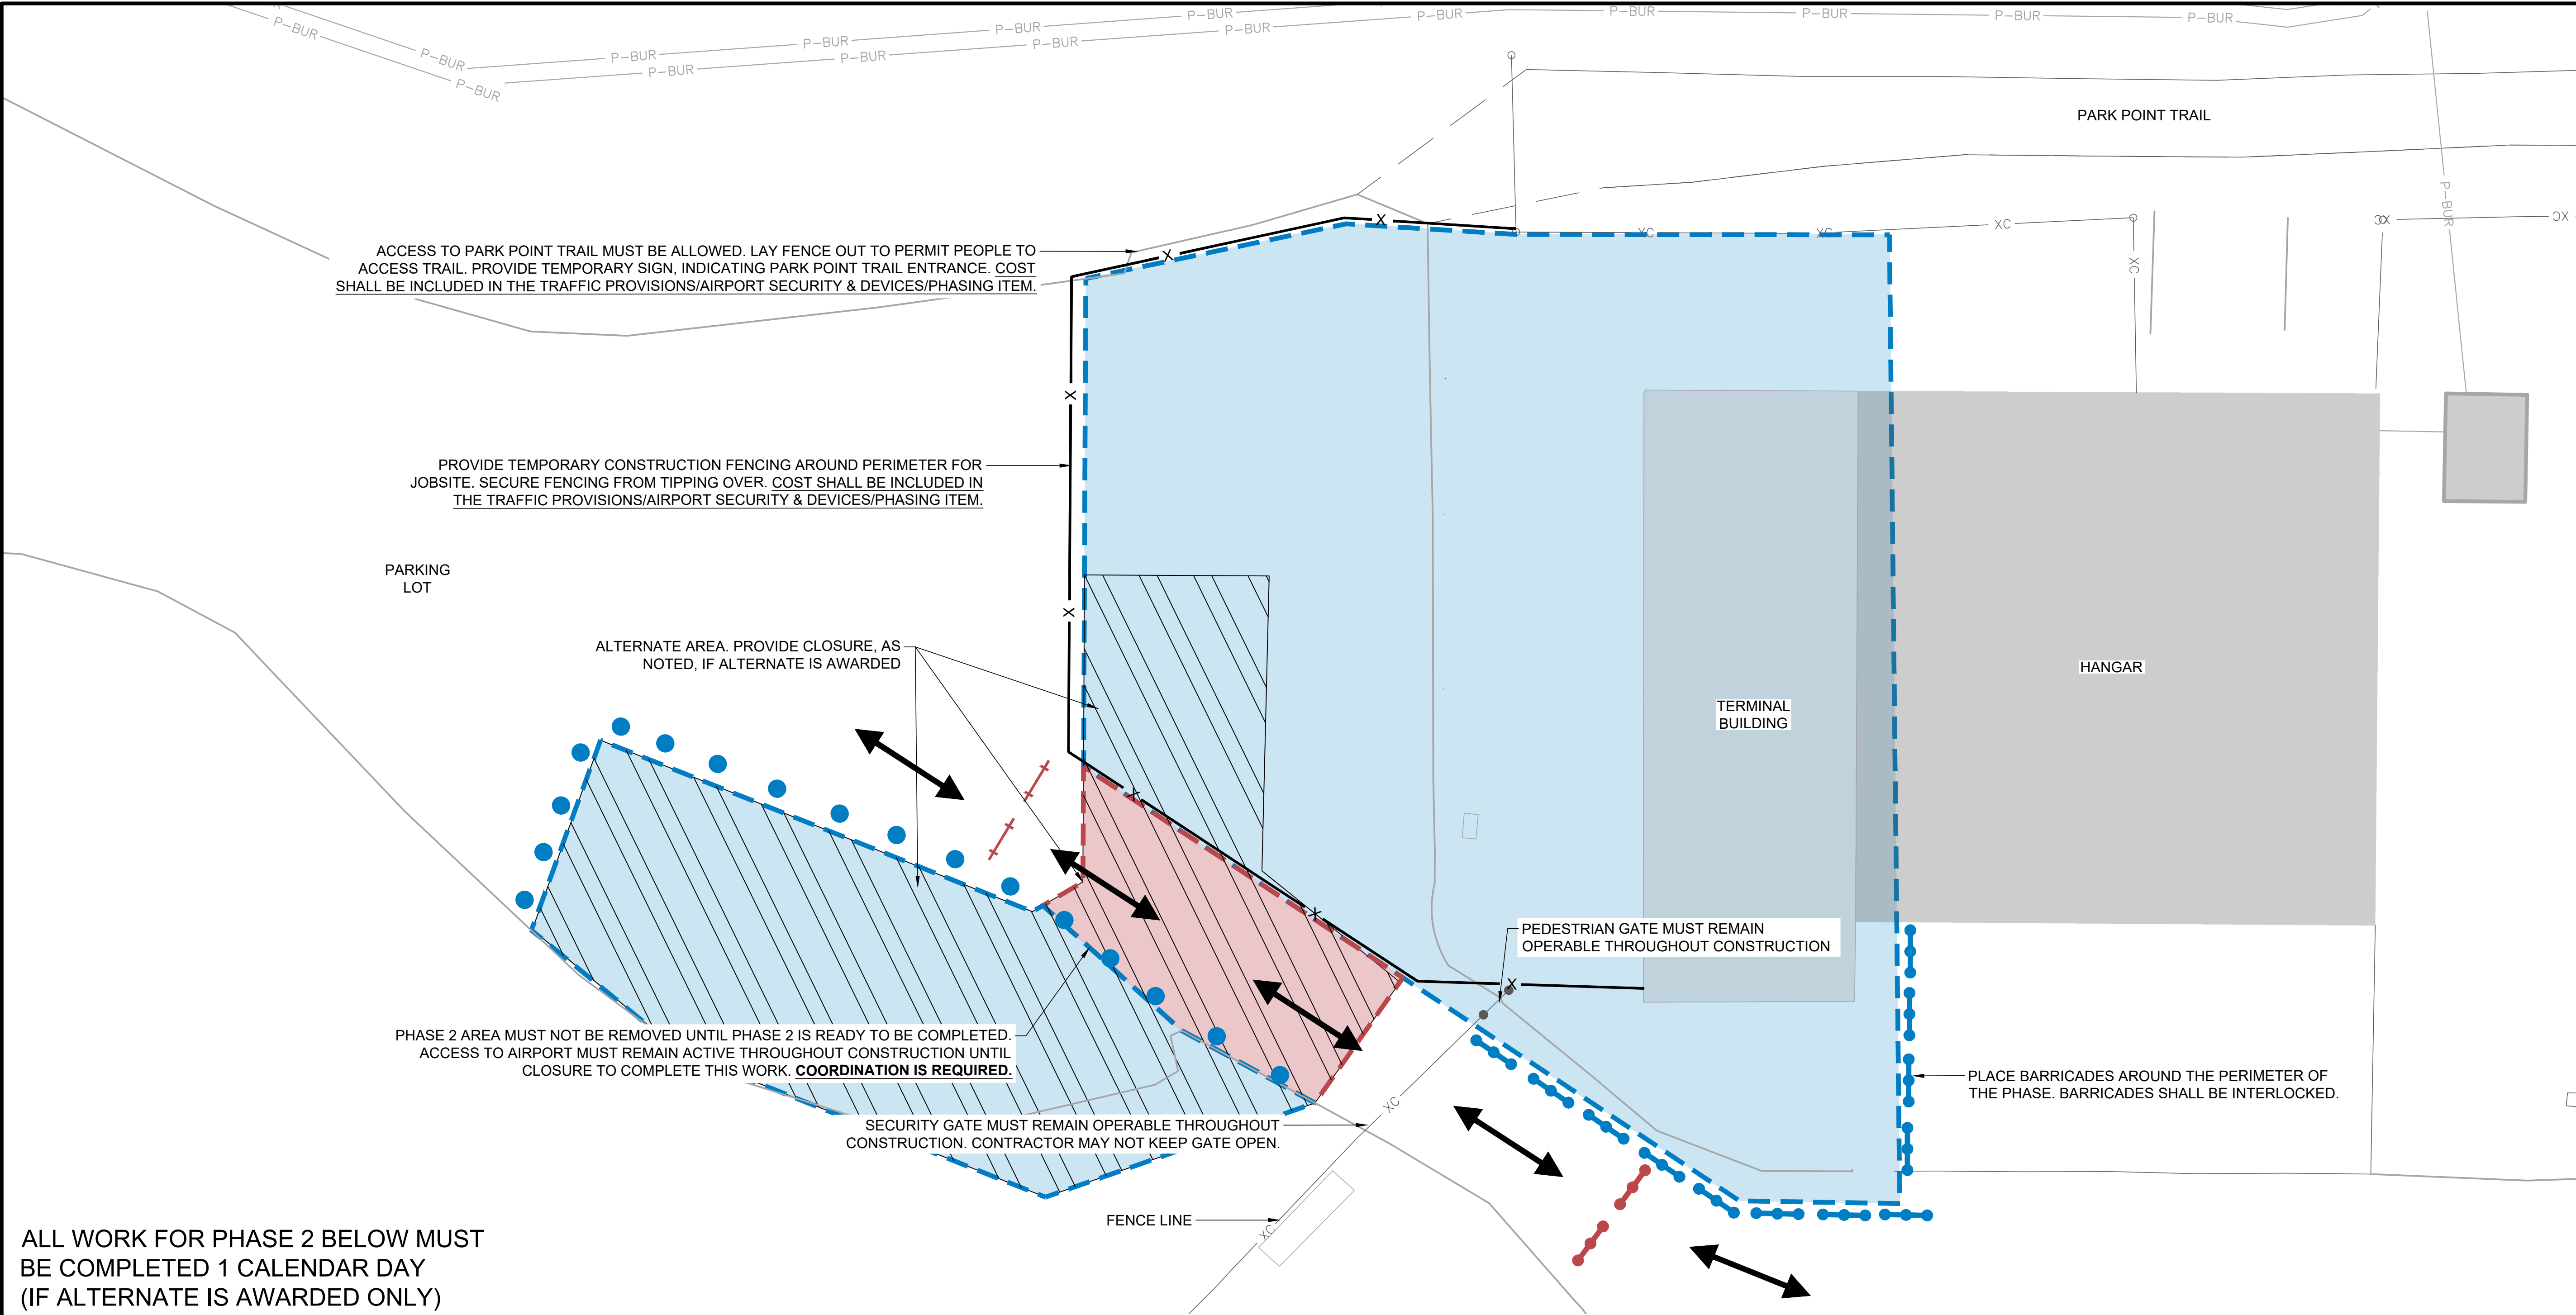

ACCESS TO PARK POINT TRAIL MUST BE ALLOWED. LAY FENCE OUT TO PERMIT PEOPLE TO ACCESS TRAIL. PROVIDE TEMPORARY SIGN, INDICATING PARK POINT TRAIL ENTRANCE. COST SHALL BE INCLUDED IN THE TRAFFIC PROVISIONS/AIRPORT SECURITY & DEVICES/PHASING ITEM.

PROVIDE TEMPORARY CONSTRUCTION FENCING AROUND PERIMETER FOR JOBSITE. SECURE FENCING FROM TIPPING OVER. COST SHALL BE INCLUDED IN THE TRAFFIC PROVISIONS/AIRPORT SECURITY & DEVICES/PHASING ITEM.

ALTERNATE AREA. PROVIDE CLOSURE, AS NOTED, IF ALTERNATE IS AWARDED

PHASE 2 AREA MUST NOT BE REMOVED UNTIL PHASE 2 IS READY TO BE COMPLETED. ACCESS TO AIRPORT MUST REMAIN ACTIVE THROUGHOUT CONSTRUCTION UNTIL CLOSURE TO COMPLETE THIS WORK. **COORDINATION IS REQUIRED.**

SECURITY GATE MUST REMAIN OPERABLE THROUGHOUT CONSTRUCTION. CONTRACTOR MAY NOT KEEP GATE OPEN.

PEDESTRIAN GATE MUST REMAIN OPERABLE THROUGHOUT CONSTRUCTION

PLACE BARRICADES AROUND THE PERIMETER OF THE PHASE. BARRICADES SHALL BE INTERLOCKED.

ALL WORK FOR PHASE 2 BELOW MUST BE COMPLETED 1 CALENDAR DAY (IF ALTERNATE IS AWARDED ONLY)

PHASE 2 AREA - ACCESS DRIVE TO AIRPORT

1. NOTIFY AIRPORT 72-HOURS IN ADVANCE OF WORK COMMENCING.
2. PLACE BARRICADES AS SHOWN ON THE PLAN.
3. REMOVE ASPHALT, AGGREGATE BASE AND SUBBASE TO PLAN ELEVATIONS.
4. PLACE GEOTEXTILE FABRIC, SUBBASE AND AGGREGATE MATERIAL.
5. PLACE ASPHALT - BASE COURSE LAYER. (SEPARATE CLOSURE FOR PLACEMENT OF ALL HMA SURFACE COURSE LAYER)
6. SWEEP PAVEMENT CLEAR OF FOD BEFORE OPENING TO VEHICLE TRAFFIC TO ENTER AIRFIELD. INSPECTION BY AIRPORT AND/OR ENGINEER BEFORE OPENING TO VEHICLE TRAFFIC.
7. REMOVE BARRICADES.


LEGEND

- PHASE 1 (THROUGHOUT CONSTRUCTION)
- PHASE 2 (1 CALENDAR DAY CLOSURE)
- ALTERNATE AREA (CONSTRUCT ONLY IF AWARDED)
- 6-FT TEMPORARY FENCE (SECURED AND WEIGHTED DOWN)
- EXISTING FENCE
- LOW PROFILE BARRICADE - PHASE 1
- LOW PROFILE BARRICADE - PHASE 2
- VEHICLE ACCESS FOR TENANTS - PHASE 1
- TYPE III BARRICADE (LIGHTED)
- TRAFFIC CONTROL DRUM (NON-LIGHTED)

GENERAL PHASING NOTES:

1. THERE MUST BE ACCESS TO THE AIRFIELD AT ALL TIMES, EXCEPT DURING PHASE 2. CLOSURE IS LIMITED TO 1 CALENDAR DAY TO COMPLETE WORK INDICATED ON THE SHEET. UNDER NO CIRCUMSTANCES MAY PHASE 2 AREA BE CLOSED LONGER THAN A CALENDAR DAY OR CONSECUTIVE CALENDAR DAYS.
2. PHASE 2 AREA PAVEMENTS MUST NOT BE REMOVED UNTIL PHASE 2 BEGINS.
3. PHASE 2 WORK AREA INCLUDES BITUMINOUS/AGGREGATE REMOVALS AND COMPLETION OF TYPICAL PAVEMENT SECTION THROUGH BITUMINOUS BASE COURSE. THIS WORK MUST BE COMPLETED IN 1 CALENDAR DAY. COORDINATION WITH PAVING SCHEDULE IS REQUIRED.
4. AN ADDITIONAL CLOSURE WILL BE REQUIRED TO COMPLETE THE FINAL BITUMINOUS PAVING LIFT.
5. **PHASE 2 WORK MUST BE COORDINATED WITH 72-HRS NOTICE. CONTRACTOR TO NOTIFY AIRPORT PRIOR TO WORK BEING COMPLETED. TENANT NOTIFICATION IS REQUIRED.**
6. THE CONTRACTOR MUST PROVIDE TEMPORARY PERIMETER FENCING ALONG PAVEMENT REMOVAL LIMITS TO ENSURE A SECURE SITE. THE FENCE MUST BE SECURED TO THE GROUND TO PREVENT TIPPING AND MAINTAINED THROUGHOUT CONSTRUCTION. THE COST SHALL BE INCLUDED IN TRAFFIC CONTROL ITEM.
7. BARRICADES NOT SHOWN TO SCALE. IT IS THE RESPONSIBILITY OF THE CONTRACTOR TO PROVIDE ADEQUATE AMOUNT OF BARRICADES.

KEYMAP

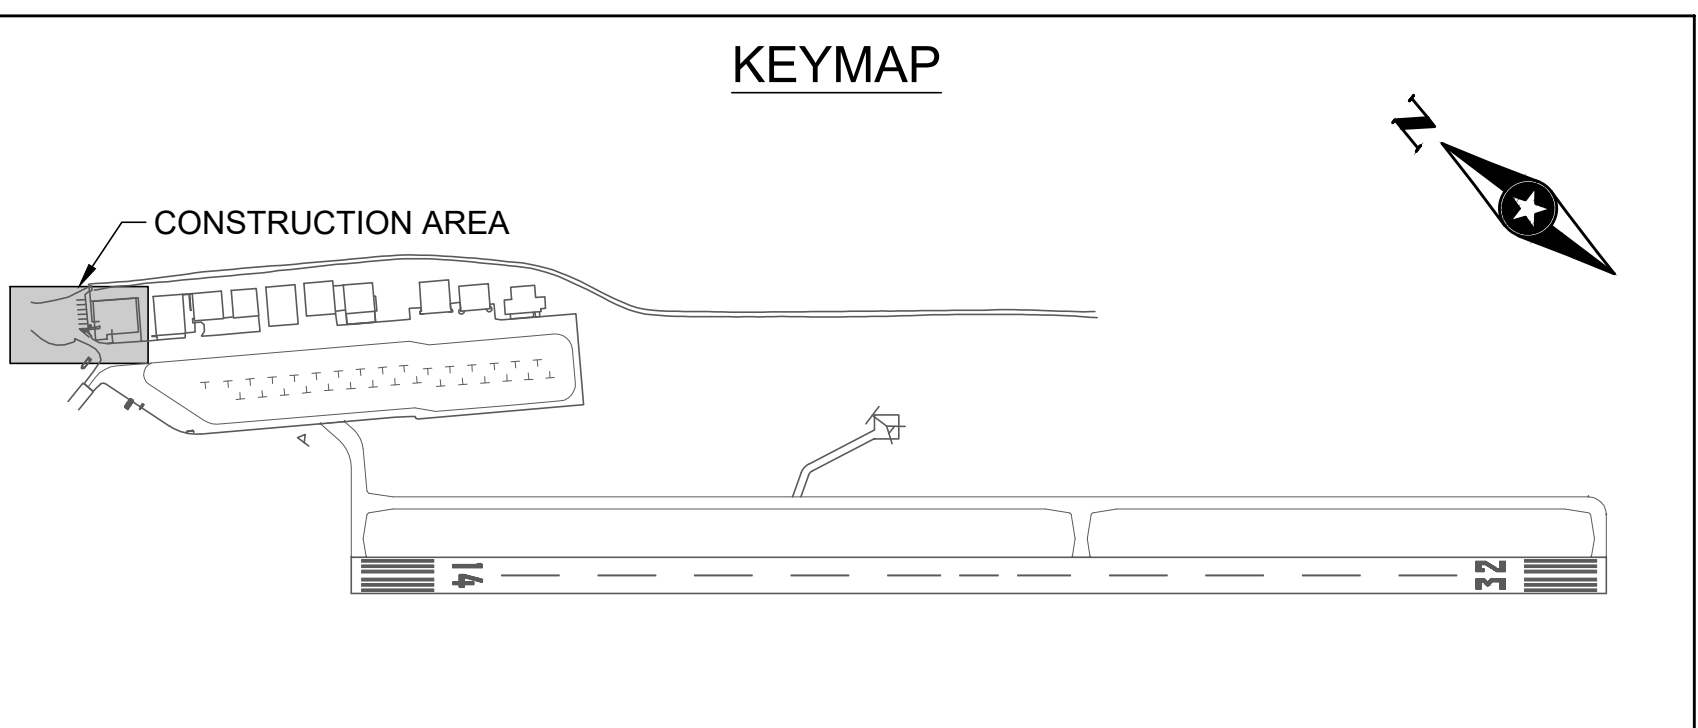

GENERAL NOTES:




- THE EXISTING UTILITY LOCATIONS SHOWN ON THE PLANS ARE APPROXIMATE AND MAY NOT INCLUDE ALL UTILITIES PRESENT. THE CONTRACTOR SHALL BE RESPONSIBLE TO CALL MINNESOTA'S ONE-CALL NOTIFICATION CENTER (GSOC) AT 1-800-252-1166, AND COORDINATE FIELD LOCATIONS OF EXISTING UNDERGROUND UTILITIES PRIOR TO BEGINNING GRADING AND UTILITY WORK. THE CONTRACTOR SHALL IMMEDIATELY REPAIR ANY UTILITIES DAMAGED DURING CONSTRUCTION TO THE SATISFACTION OF THE UTILITY OWNER AT NO COST.
- THE CONTRACTOR SHALL BE RESPONSIBLE FOR OBTAINING ALL PERMITS INCLUDING APPLICABLE CITY OF DULUTH PERMITS AND PAY ALL FEES AS REQUIRED BY THE CONSTRUCTION COVERED IN THESE PLANS.
- ALL WORK SHALL CONFORM TO APPLICABLE LOCAL, STATE, AND FEDERAL LAWS AND REGULATIONS.
- THE CONTRACTOR SHALL CONTACT THE ENGINEER IMMEDIATELY UPON DISCOVERY OF ANY ERRORS OR INCONSISTENCIES.
- ALL ESTIMATES OF QUANTITIES ARE FOR INFORMATIONAL PURPOSES ONLY. THE CONTRACTOR AND SUBCONTRACTOR SHALL BE RESPONSIBLE FOR DETERMINING ALL QUANTITIES THROUGH CERTIFIED SURVEYS OR AGREEMENTS WITH ENGINEERING STAFF PRIOR TO EXCAVATION AND EMBANKMENT EFFORTS. THE CONTRACTOR SHALL PROVIDE ALL WORK AND MATERIALS AS SHOWN ON THE PLANS.
- THE CONTRACTOR SHALL BE RESPONSIBLE FOR REPAIRING ALL EXISTING AREAS, PAVEMENTS, STRUCTURES, OR OTHER FACILITIES DAMAGED DURING CONSTRUCTION ACTIVITIES TO EQUAL OR BETTER CONDITION.
- THE CONTRACTOR SHALL REMOVE ALL DEBRIS RESULTING FROM WORK UNDER THIS CONTRACT TO AN APPROVED DUMP SITE.
- THE 2020 EDITION OF THE MINNESOTA DEPARTMENT OF TRANSPORTATION "STANDARD SPECIFICATIONS FOR CONSTRUCTION" SHALL BE GOVERN EXCEPT AS MODIFIED BY THE SPECIFICATIONS FOR THIS PROJECT.
- THE CONTRACTOR SHALL BE RESPONSIBLE FOR PROVIDING THE OWNER OR THE OWNER'S REPRESENTATIVE WITH REDLINED PLANS AND AS-BUILTS SURVEYS, CERTIFIED BY A PROFESSIONAL LAND SURVEYOR IN THE STATE OF MINNESOTA.
- LOCATING OF ANY AIRPORT OWNED UTILITIES SHALL BE THE CONTRACTOR'S RESPONSIBILITY AND INCIDENTAL TO THE PROJECT.
- CONTRACTOR IS RESPONSIBLE FOR ALL CONSTRUCTION STAKING, PAID UNDER FIELD ENGINEERING BID ITEM AND PERMITTING, PAID FOR UNDER GENERAL CONDITIONS.
- CONTRACTOR STORAGE AREA - IT IS EXPECTED THE CONTRACTOR STORAGE AREA WILL BE USED BY TWO SEPARATE PROJECTS OVER THE DURATION OF THIS PROJECT. THE CONTRACTOR SHALL COORDINATE WITH THE OTHER PROJECT CONTRACTOR THROUGHOUT CONSTRUCTION TO ENSURE ADEQUATE SPACING, USE AND EFFORTS BETWEEN BOTH PARTIES.

GRADING NOTES:

- THE CONTRACTOR SHALL BE RESPONSIBLE FOR KEEPING THE PUBLIC STREETS AND ACCESS ROUTES IN THE VICINITY OF THE JOB SITE CLEAN AND FREE OF ROCKS, SOILS AND DEBRIS.
- THE CONTRACTOR SHALL BE RESPONSIBLE FOR CONTROLLING DOWNSTREAM EROSION AND SILTATION DURING ALL PHASES OF CONSTRUCTION. EROSION CONTROL MEASURES SHALL BE IN PLACE PRIOR TO BEGINNING SOIL DISTURBANCE ACTIVITIES.
- CONTRACTOR AND ENGINEER TO VERIFY EXISTING TOPSOIL CONDITIONS BEFORE PROPOSED CONSTRUCTION AREAS ARE TO BE DISTURBED. STRIPPING, STOCKPILING, PLACING OF TOPSOIL CONSIDERED INCIDENTAL TO THE PROJECT.
- IF THE CONTRACTOR ENCOUNTERS SAND MATERIAL NOT SUITABLE FOR REUSE, THE MATERIAL MUST REMAIN ONSITE. THE CONTRACTOR SHALL PLACE THE MATERIAL IN THE CONTRACTOR STORAGE AREA AND GRADE TO DRAIN FOR RESTORATION.**


SECURITY REQUIREMENTS:

- GENERAL INTENT:** IT IS INTENDED THAT THE CONTRACTOR SHALL COMPLY WITH ALL REQUIREMENTS OF THE AIRPORT SECURITY PLAN AND WITH THE SECURITY REQUIREMENTS SPECIFIED BY AIRPORT OPERATIONS. THE CONTRACTOR SHALL DESIGNATE TO THE ENGINEER AND AIRPORT OPERATIONS, IN WRITING, THE NAME OF HIS "CONTRACTOR SECURITY AND SAFETY OFFICER (CSSO)." THE CSSO SHALL BE AN EMPLOYEE OF THE CONTRACTOR AND REPRESENT THE CONTRACTOR ON THE SECURITY REQUIREMENTS FOR THE CONTRACT. THE AIRPORT WILL PROVIDE A SECURITY PLAN OVERVIEW PRIOR TO CONSTRUCTION COMMENCING.
- IDENTIFICATION - VEHICLES:** THE CONTRACTOR, THROUGH THE CSSO, SHALL ESTABLISH AND MAINTAIN A LIST OF CONTRACTOR AND SUBCONTRACTOR VEHICLES AUTHORIZED TO OPERATE ON THE SITE OR DELIVER TO THE SITE. THE LIST MAY BE UPDATED, AS NEEDED, TO ACCOUNT FOR DIFFERENT OPERATIONAL COMPONENTS OF THE WORK.
- SECURE ACCESS TO THE AIRFIELD:** CONTRACTOR'S ACCESS TO THE SITE SHALL BE AS SHOWN ON THE PLANS. NO OTHER ACCESS POINTS SHALL BE ALLOWED UNLESS APPROVED BY AIRPORT OPERATIONS. THE CONTRACTOR SHALL BE RESPONSIBLE FOR TRAFFIC CONTROL TO AND FROM THE VARIOUS CONSTRUCTION AREAS ON THE SITE.
- TEMPORARY FENCING:** PROVIDE TEMPORARY FENCING, AS REQUIRED AND WHERE EXISTING FENCE HAS BEEN REMOVED FOR CONSTRUCTION, TO MAINTAIN SECURITY PERIMETER. THIS COST SHALL BE INCLUDED IN TRAFFIC PROVISIONS/AIRPORT SECURITY & DEVICE/PHASING ITEM. TEMPORARY FENCING SHALL INCLUDE PROVIDING SECURING FENCE FROM WIND/TIPPING OVER AND MAINTAINING THROUGHOUT.

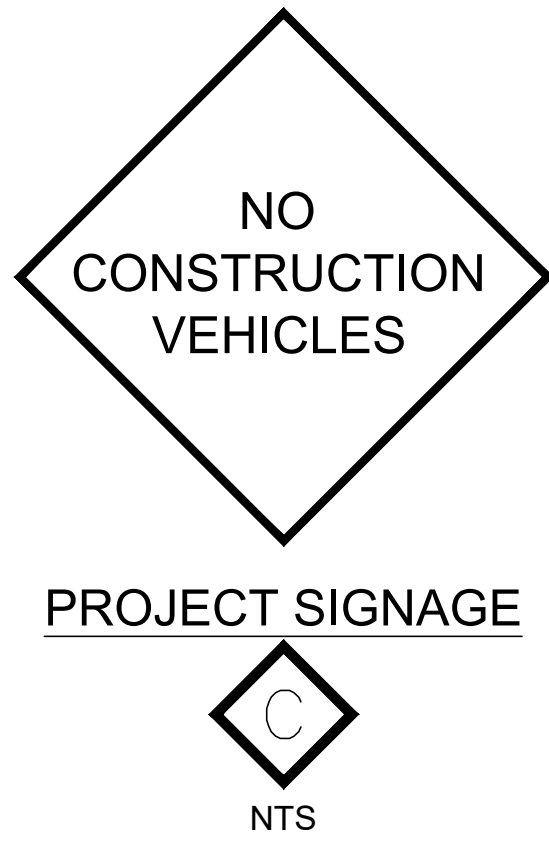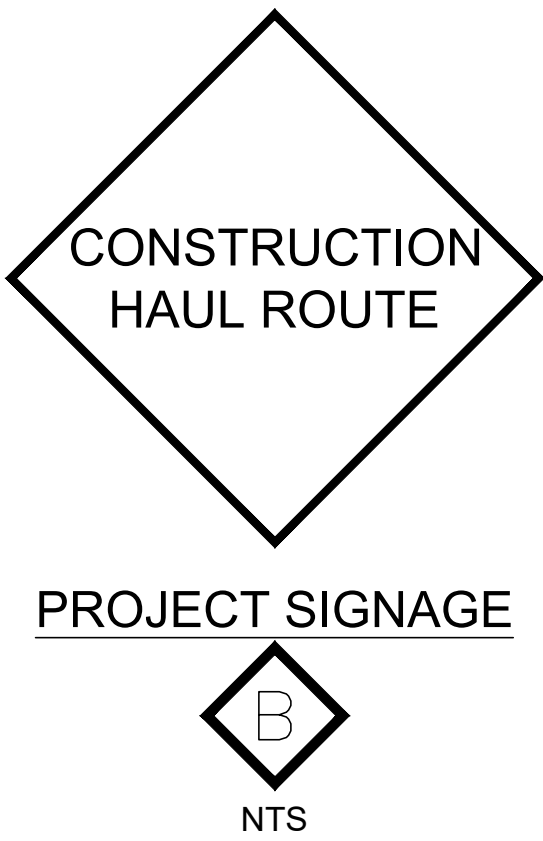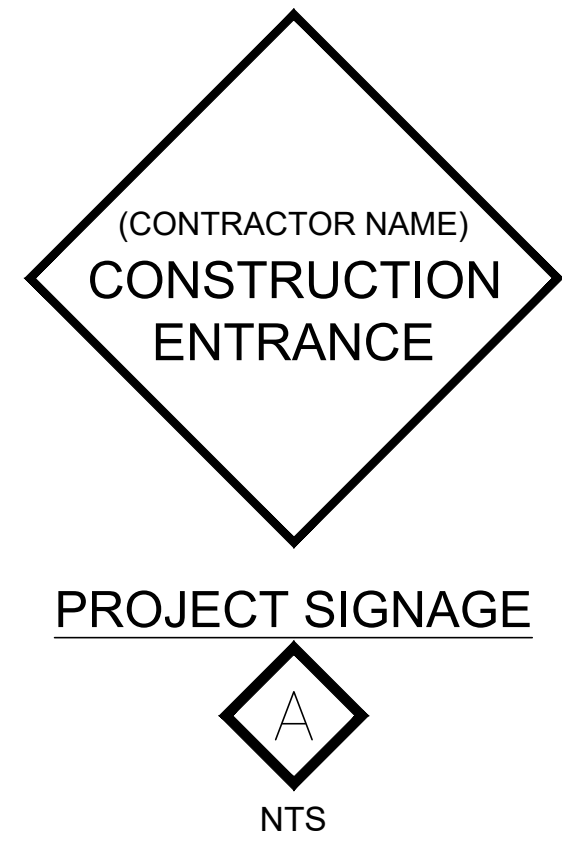

SIGN NOTES:


- SIGNS SHALL BE ALUMINUM AT LEAST 0.10" THICK.
- SIGNS TO BE PLACED, SUPPLIED AND MAINTAINED BY CONTRACTOR.
- SIGNS SHALL BE ORANGE RETROREFLECTIVE BACKGROUND WITH THE EXCEPTION OF THE BLACK LETTERING.

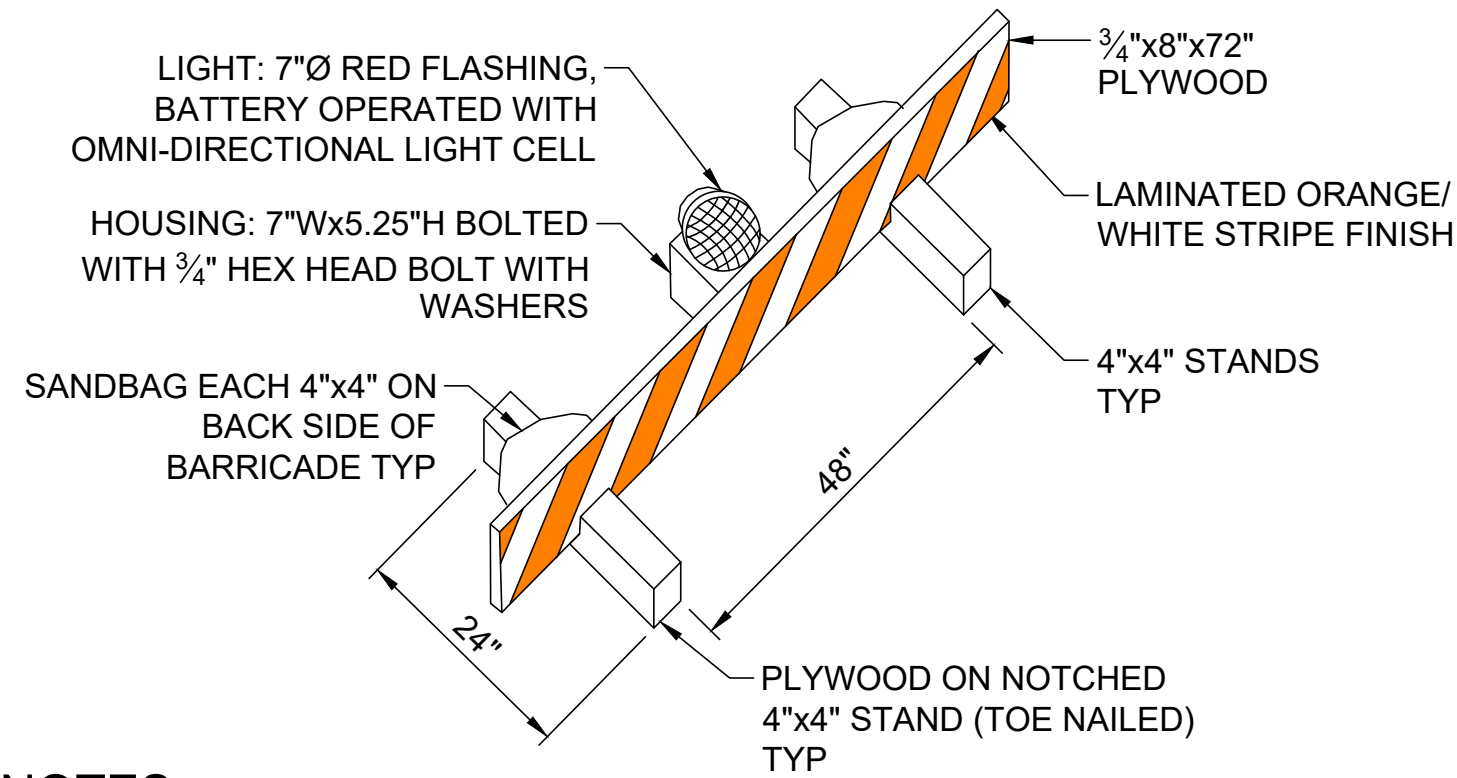


NOTES:

- BARRICADES SHALL BE CONSTRUCTED AND PLACED A MAXIMUM OF 20' APART ACROSS THE FULL WIDTH OF CLOSED PAVEMENT PER FAA ADVISORY CIRCULAR 150/5370-2G.
- ALL LOW PROFILE BARRICADES SHALL BE CONSTRUCTED AS SHOWN UNLESS OTHERWISE APPROVED BY THE ENGINEER.


LOW PROFILE BARRICADE
NTS

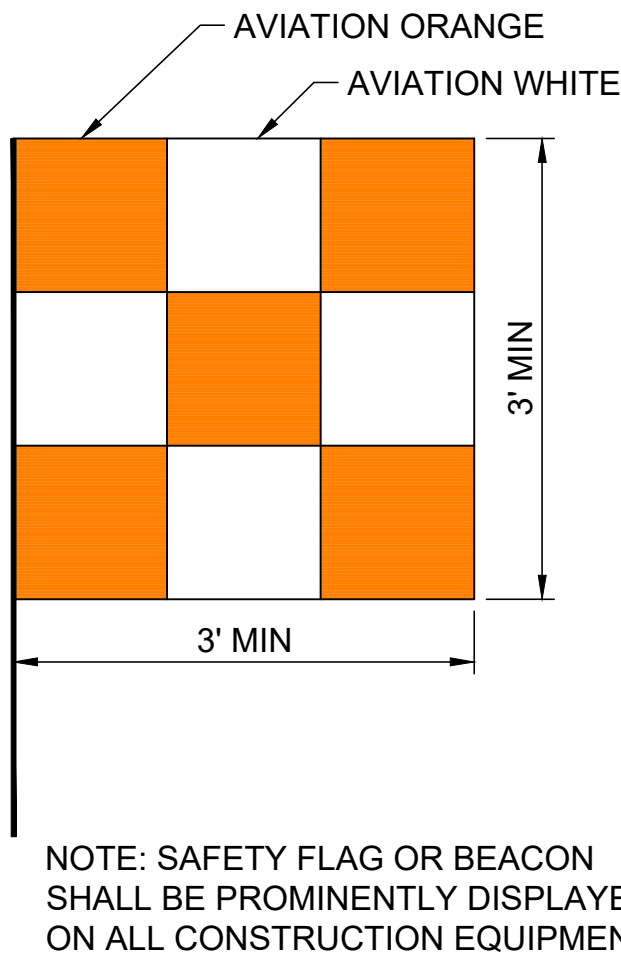


CONSTRUCTION SAFETY FLAG
NTS

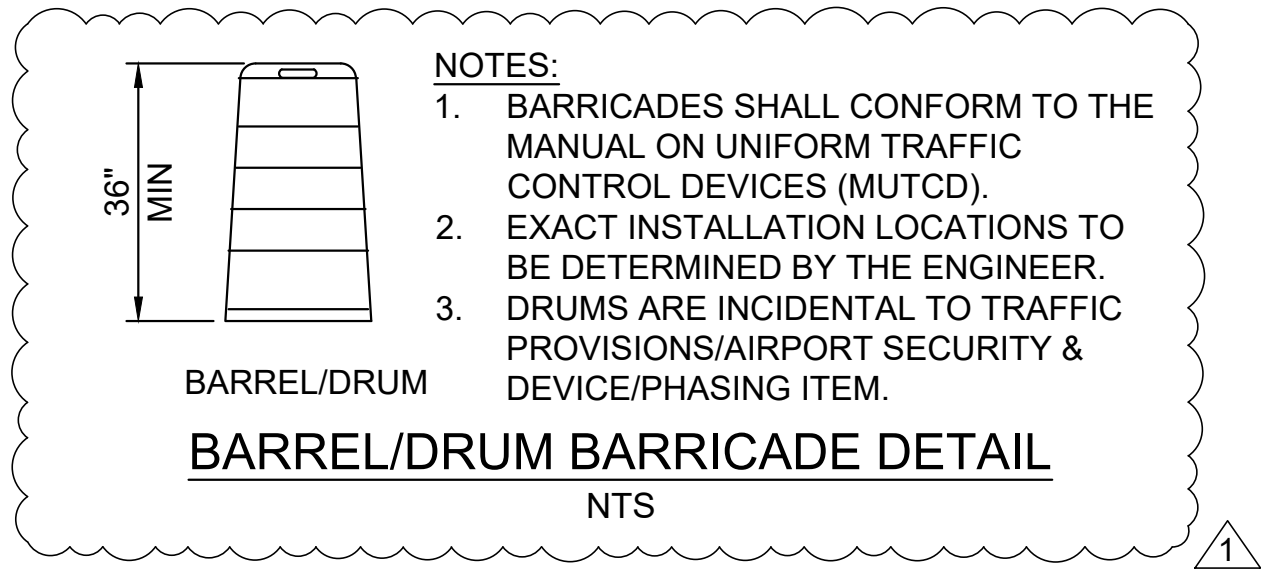


BARREL/DRUM BARRICADE DETAIL
NTS



I HEREBY CERTIFY THAT THIS PLAN, SPECIFICATION, OR REPORT WAS PREPARED BY ME OR UNDER MY DIRECT SUPERVISION AND THAT I AM A DULY LICENSED PROFESSIONAL ENGINEER UNDER THE LAWS OF THE STATE OF MINNESOTA.


RYAN FALCH, P.E.
DATE 05/17/2023 LICENSE NO. 60494


DULUTH INTERNATIONAL AIRPORT

SKY HARBOR AIRPORT
2023 RECONSTRUCT TERMINAL BUILDING
DULUTH, MN

This drawing is an instrument of service and shall remain the property of Short Elliott Hendrickson, Inc. (SEH). This drawing, concepts and ideas contained herein shall not be used, reproduced, revised, or retained without the express written approval of SEH.

Submission or distribution of this drawing to meet official or regulatory requirements or for purposes in connection with the project is not to be construed as publication in derogation of any of the rights of SEH.

COPYRIGHT © 2023
Short Elliott Hendrickson, Inc.
All Rights Reserved

SEH Project DULAL_172133
Checked By RF
Drawn By ALS

Project Status Issue Date
CONSTRUCTION 05/17/2023
PLANS

REVISION SCHEDULE		
REV. #	DESCRIPTION	DATE
1	ADDENDUM #2	6/2/2023

GENERAL NOTES

G2.00

STATEMENT OF ESTIMATED QUANTITIES									
-----------------------------------	--	--	--	--	--	--	--	--	--


BASE BID SCHEDULE A - CONSTRUCT SITE WORK (FAA ELIGIBLE)	

LINE NO.	ITEM NO.	ITEM DESCRIPTION	UNIT	ESTIMATED QUANTITY	FINAL QUANTITY
1	C-105	MOBILIZATION (10% OF OVERALL BID SCHEDULE A)	LS	1	
2	70-08	TRAFFIC PROVISIONS/AIRPORT SECURITY & DEVICES/PHASING	LS	1	
3	70-08	ORANGE CONSTRUCTION FENCE	LF	150	
4	01 51 00	TEMPORARY UTILITIES	LS	1	
5	01 55 15	MAINTENANCE AND RESTORATION OF HAUL ROADS	LS	1	
6	01 58 13	CONSTRUCTION PROJECT SIGN (\$1,000 MAXIMUM ALLOWED)	LS	1	
7	01 71 23	FIELD ENGINEERING	LS	1	
8	02 41 33	REMOVE AND SALVAGE EXISTING SIGN AND POST	LS	3	
9	02 41 33	REMOVE AND SALVAGE EXISTING 6-FT CHAIN-LINK FENCE (BY ENTRANCE GATE)	LF	15	
10	02 41 33	REMOVE EXISTING 6-FT CHAIN-LINK FENCE (BY TRAIL)	LF	25	
11	2540.602	RELOCATE MAIL BOX SUPPORT	EACH	1	
12	02 41 33	REMOVE SEWER PIPE (SANITARY)	LF	15	
13	02 41 33	REMOVE WATER SERVICE PIPE (INCLUDING DISCONNECTION OF CURB STOP & CAPPING)	LF	25	
14	02 41 33	REMOVE CONCRETE SIDEWALK, PATIO & APPROACH	SF	475	
15	02 41 33	REMOVE DRY WELL	LS	1	
16	02 41 33	REMOVE & RELOCATE TELEPHONE LINE	LS	1	
17	02 41 33	REMOVE ELECTRICAL HANDHOLE	EACH	1	
18	02 41 33	SAWING BITUMINOUS PAVEMENT (FULL DEPTH)	LF	245	
19	02 41 33	REMOVE BITUMINOUS PAVEMENT (6.5" THICK)	SY	300	
20	02 41 13	SELECTIVE DEMOLITION	LS	1	
21	02 41 13	REGULATED WASTE REMOVAL	LS	1	
22	02 82 20	REGULATED ABESTOS REMOVAL	LS	1	
23	P-152	COMMON EXCAVATION (EV)	CY	135	
24	P-152	UNCLASSIFIED OVER EXCAVATION (EV)	CY	50	
25	P-152	BORROW (EV) (OFFSITE)	CY	50	
26	31 25 10	ROCK CONSTRUCTION ENTRANCE (INCLUDES MAINTENANCE AND REMOVAL)	EACH	1	
27	31 25 10	SILT FENCE, TYPE PREASSEMBLED (INCLUDES MAINTENANCE AND REMOVAL)	LF	835	
28	31 25 10	SEDIMENT CONTROL LOG (INCLUDES MAINTENANCE AND REMOVAL)	LF	225	
29	31 34 10	GEOTEXTILE FABRIC, TYPE 7 (SEPARATION FABRIC)	SY	300	
30	32 10 22	SUBBASE MATERIAL (SELECT GRANULAR MATERIAL) (CV)	CY	85	
31	32 11 22	AGGREGATE BASE (CLASS 5) (CV)	CY	65	
32	32 12 13	BITUMINOUS MATERIAL FOR TACK COAT	GAL	10	
33	32 12 16	BITUMINOUS 1.75" (SPWEA340C)	TON	30	
34	32 12 16	BITUMINOUS 2.25" (SPNWB330C)	TON	40	
35	32 13 10	6" CONCRETE PAVEMENT (HANGAR APPROACH)	SY	15	
36	32 16 20	CONCRETE CURBING (6" HEIGHT - V CURB)	LF	110	
37	32 17 23	PAVEMENT MARKING LINEAR, 4-INCH WIDTH, WHITE TYPE I (EPOXY)	LF	140	
38	32 17 23	PAVEMENT MARKING MESSAGES, HANDICAP SYMBOL & NO PARKING, WHITE TYPE I (EPOXY)	EACH	2	
39	32 18 20	4-INCH CONCRETE SIDEWALK (5-FOOT WIDE, INCLUDES SLOPED WALK)	SF	430	
40	32 18 20	DETECTABLE WARNING PANELS	SF	15	
41	32 40 00	HANDICAP PARKING AND NO PARKING SIGNS (INCLUDING POST AND FASTENERS)	EACH	2	
42	2503.603	4" PVC SANITARY SERVICE PIPE (SDR 35)	LF	75	
43	2503.603	4" PVC SANITARY CLEANOUT (INCLUDING BENDS AND FITTINGS)	EACH	2	
44	33 36 10	INSTALL 1,000 GALLON SEPTIC HOLDING TANK (FOR HANGAR FLOOR DRAINS)	LS	1	
45	33 36 10	UPGRADES TO EXISTING 1,500 SEPTIC TANK	LS	1	
46	2504.602	8" x 2" TAPPING TEE W/ ELECTROFUSION SADDLE	EACH	1	
47	2504.602	2" CURB STOP AND BOX	EACH	1	
48	2504.602	WATER TRACER BOX	EACH	1	
49	2504.603	2" HDPE SDR 11 SERVICE PIPE (INCLUDING FITTINGS AND TRACE WIRE)	LF	20	
50	F-162.5.1	CHAIN-LINK FENCE, 6-FT HEIGHT (REINSTALL SALVAGED)	LF	15	
51	32 90 00	LANDSCAPING (INCLUDES ROCK & FABRIC)	SF	800	
52	T-901.5.1	TURF ESTABLISHMENT (INCLUDES FERTILIZER, SEED, MULCHING AND STABILIZATION)	LS	1	
53	T-905.5.1	SELECT TOPSOIL BORROW (SALVAGED) (CV)	CY	75	

BASE BID SCHEDULE B - CONSTRUCT TERMINAL BUILDING (PRORATED - FAA ATP ELIGIBLE)

LINE NO.	ITEM NO.	ITEM DESCRIPTION	UNIT	ESTIMATED QUANTITY	FINAL QUANTITY
54	GENERAL	GENERAL CONDITIONS	LS	1	
55	01 71 23	FIELD ENGINEERING	LS	1	
56	31 22 20	STRUCTURE EXCAVATION	CY	675	
57	31 22 30	STRUCTURE BACKFILL (ENGINEERED FILL)	CY	675	
58	P-152	UNCLASSIFIED OVER EXCAVATION (EV)	CY	100	
59	ARCH/STRC.	BUILDING CONSTRUCTION	LS	1	
60	MECH.	BUIDLING PLUMBING AND HVAC	LS	1	
61	ELEC.	BUILDING ELECTRICAL AND UTILITIES	LS	1	

ALTERNATE A - CONSTRUCT BUILDING ELEMENTS (FAA INELIGIBLE)									
--	--	--	--	--	--	--	--	--	--

LINE NO.	ITEM NO.	ITEM DESCRIPTION	UNIT	ESTIMATED QUANTITY	FINAL QUANTITY
62	GENERAL	GENERAL CONDITIONS	LS	1	
63	ARCH.	KITCHNETTE AREA (COUNTERTOP, BASE CABINETS, SINK, AND ASSOCIATED PLUMBING TO KITCHENTTE SINK)	LS	1	
64	ELEC.	CONDUIT & WIRING INSTALLATION FOR FUTURE SECURITY CAMERAS	LS	1	
65	ELEC.	ELECTRICAL PEDESTAL FOR EXTERIOR VENDING TRUCK (INCLUDING CONDUIT & WIRING)	LS	1	
66	32 18 20	EXTERIOR 5" CONCRETE SLAB (8' x 14')	 SF	112	
67	31 34 10	GEOTEXTILE FABRIC, TYPE 7 (SEPARATION FABRIC)	SY	25	
68	32 10 22	SUBBASE MATERIAL (SELECT GRANULAR MATERIAL) (CV)	CY	10	
69	32 11 22	AGGREGATE BASE (CLASS 5) (CV)	CY	10	
70	32 93 12	LANDSCAPE PLANTING, SIZE 5 GALLON (DECIDUOUS SHRUB)	EACH	17	
71	T-905.5.2	SELECT TOPSOIL BORROW (IMPORTED) (CV)	CY	5	

ALTERNATE B - RECONSTRUCT AUTO PARKING AREA (FAA BIL ELIGIBLE)

LINE NO.	ITEM NO.	ITEM DESCRIPTION	UNIT	ESTIMATED QUANTITY	FINAL QUANTITY
72	C-105	MOBILIZATION (10% OF OVERALL BID SCHEDULE ALTERNATE B)	LS	1	
73	70-08	TRAFFIC PROVISIONS/AIRPORT SECURITY & DEVICES/PHASING	LS	1	
74	01 71 23	FIELD ENGINEERING	LS	1	
75	02 41 33	SAWING BITUMINOUS PAVEMENT (FULL DEPTH)	LF	130	
76	02 41 33	REMOVE BITUMINOUS PAVEMENT (6.5" THICK)	SY	350	
77	P-152	COMMON EXCAVATION (EV)	CY	205	
78	31 34 10	GEOTEXTILE FABRIC, TYPE 7 (SEPARATION FABRIC)	SY	385	
79	32 10 22	SUBBASE MATERIAL (GRANULAR) (CV)	CY	145	
80	32 11 22	AGGREGATE BASE (CLASS 5) (CV)	CY	100	
81	32 12 13	BITUMINOUS MATERIAL FOR TACK COAT	GAL	20	
82	32 12 16	BITUMINOUS 1.75" (SPNWB330B)	TON	50	
83	32 12 16	BITUMINOUS 2.25" (SPWEA340B)	TON	65	
84	32 17 23	PAVEMENT MARKING LINEAR, 4-INCH WIDTH, WHITE TYPE I (EPOXY)	LF	550	
85	32 17 23	PAVEMENT MARKING MESSAGE, NO PARKING, WHITE TYPE 1 (EPOXY)	EACH	1	
86	32 92 12	TURF ESTABLISHMENT (INCLUDES FERTILIZER, SEED, MULCHING AND STABILIZATION)	LS	1	
87	T-905.5.1	SELECT TOPSOIL BORROW (SALVAGED) (CV)	CY	20	

ALTERNATE C - REPLACE EXISTING HANGAR ROOFING AND SIDING (FAA BIL ELIGIBLE)

LINE NO.	ITEM NO.	ITEM DESCRIPTION	UNIT	ESTIMATED QUANTITY	FINAL QUANTITY
88	GENERAL	GENERAL CONDITIONS	LS	1	
89	ARCH.	REMOVE EXISTING HANGAR ROOFING AND SIDING	LS	1	
90	ARCH.	INSTALL METAL ROOFING	LS	1	
91	ARCH.	INSTALL METAL WALL PANEL SIDING	LS	1	

ALTERNATE D - PROVIDE INTERIM TERMINAL FACILITY AND TOILET FACILITIES (FAA ATP ELIGIBLE)

LINE NO.	ITEM NO.	ITEM DESCRIPTION	UNIT	ESTIMATED QUANTITY	FINAL QUANTITY
92	C-105	MOBILIZATION (10% OF OVERALL BID SCHEDULE ALTERNATE D)	LS	1	
93	01 52 13	ADA ACCESSIBLE INTERIM TERMINAL FACILITY	LS	1	
94	01 52 13	ADA ACCESSIBLE TEMPORARY SANITARY FACILITIES	LS	1	

STATEMENT OF ESTIMATE QUANTITY NOTES:

ITEM NO.1/72/92: LIMITED TO 10% OF THE TOTAL PROJECT COSTS RELATED TO THE BID SCHEDULE.

ITEM NO.2: INCLUDES INSTALLATION, MAINTENANCE AND REMOVAL OF ALL TRAFFIC CONTROL SIGNAGE, BARRICADES, TEMPORARY FENCING, AND TRAFFIC CONTROL DEVICES.

ITEM NO.4: PROVIDE TEMPORARY UTILITIES FOR FUELING MONITORING EQUIPMENT, FUEL SYSTEM, AWOS, SECURITY GATE, AND CAMERA OBSERVATION SETUP.

ITEM NO. 7: PROVIDING CONSTRUCTION SURVEY THROUGHOUT THE PROJECT, INCLUDING DOCUMENTING ELEVATIONS OF STRUCTURE EXCAVATION, STRUCTURAL FILL, SUBGRADE, BASE COURSE AND OTHER QUANTITY SURVEYS SUPPLIED TO THE ENGINEER FOR PAYMENT.

ITEM NO. 11: COORDINATION WITH USPS TO RELOCATE MAILBOX AND TEMPORARILY SET UP LOCATION FOR DURATION OF PROJECT.

ITEM NO. 14 REMOVING CONCRETE SIDEWALK, CONCRETE PATIO AND ASSOCIATED LANDSCAPING ADJACENT TO THE SIDEWALK.

ITEM NO. 16: COORDINATION WITH LOCAL PROVIDER TO RELOCATE EXISTING TELEPHONE LINE OUTSIDE BUILDING FOOTPRINT.

ITEM NO. 36: PROVIDING CONCRETE PAVEMENT THAT WAS REMOVED FOR INSTALLATION OF FOUNDATION AND STAIRS NEXT TO EXISTING HANGAR APPROACH. THIS ITEM INCLUDES PROVIDING AND INSTALLING THE BARS AND NECESSARY DRILLING TO EXISTING CONCRETE PAVEMENT.

ITEM NO. 39: CONSTRUCTING SLOPED SIDEWALK INCLUDING REINFORCEMENT AND THICKENED EDGE.

ITEMS NO. 42/43: PROVIDING SANITARY SERVICE TO THE TERMINAL BUILDING. ITEMS INCIDENTAL TO THE WORK INCLUDE TRACER WIRE, PVC FITTINGS, TESTING AND OTHER APPLICABLE CITY OF DULUTH SPECIFICATION REQUIREMENTS.

ITEM NO. 44: PROVIDING SEPTIC HOLDING TANK FOR EXISTING HANGAR DRAINS, INCLUDING CONNECTIONS, PERMITTING, OVERFILL ALARM, EQUIPMENT AND ACCESSORIES TO MAKE AN OPERABLE SYSTEM.

ITEM NO. 45: PROVIDING UPGRADES TO EXISTING SEPTIC SYSTEM TANK, INCLUDING REPLACING PUMP, FLOAT, REMOVING EXISTING ELECTRICAL SERVICE, OVERFILL ALARM AND ACCESSORIES TO MAKE AN OPERABLE SYSTEM.

ITEMS NO. 46-49: PROVIDING WATER SERVICE TO THE TERMINAL BUILDING. ITEMS INCIDENTAL TO THE WORK INCLUDE TRACER WIRE, FITTINGS, BACKFILL, TRENCHING, TESTING, AND OTHER APPLICABLE CITY OF DULUTH SPECIFICATION REQUIREMENTS.

ITEM NO. 50: REINSTALLING SALVAGED 6-FT HIGH FENCE, POSTS, FABRIC AND FASTENERS.

ITEM NO. 51: INSTALLING LANDSCAPE ROCK AND WEED BARRIER FABRIC.

ITEMS NO. 54/62/88: THE TERM "GENERAL CONDITIONS" IS USED TO DESCRIBE EXPENSES THAT SUPPORT A PROJECT WITHOUT DIRECTLY RELATING TO JOBSITE ACTIVITIES, INCLUDING BUT NOT LIMITED TO SITE MANAGEMENT, PERMITTING, PROJECT MANAGEMENT AND COORDINATION FOR EACH SCHEDULE.

ITEM NO 63: PROVIDING AND INSTALLING BASE CABINETS, COUNTERTOP AND SINK IN KITCHENETTE AREA AND INSTALLING ASSOCIATED PLUMBING TO SUPPLY THE SINK.

ITEM NO. 64: PROVIDING CONDUIT AND WIRING FOR FUTURE INSTALLATION OF SECURITY CAMERAS.

ITEM NO. 65: PROVIDING ELECTRICAL PEDESTAL FOR EXTERIOR VENDING TRUCK, WHICH INCLUDES CONDUIT, WIRING AND BORING (IF EXISTING DUCT IS NOT SUITABLE) TO MAKE AN OPERABLE SYSTEM.

ITEM NO. 66: PROVIDING CONCRETE SLAB ON AIRSIDE OF BUILDING SITE, INCLUDING REINFORCEMENT AND THICKENED EDGE.

ITEM NO. 70/71: PROVIDING LANDSCAPE PLANTING ALONG THE TERMINAL BUILDING AND IMPORTED TOPSOIL FOR PLANTING MIX.

ITEM NO. 93: PROVIDING ADA-COMPLIANT INTERIM TERMINAL AND OTHER ITEMS TO SET UP THE FACILITY.

ITEM NO. 94: PROVIDING TEMPORARY TOILET FACILITIES FOR DURATION OF PROJECT (ADA-COMPLIANT AND NON-ADA COMPLIANT).

ALTERNATE A: SCHEDULE IS TO INSTALL FAA INELIGIBLE BUILDING ELEMENTS FOR THE TERMINAL BUILDING.
ALTERNATE B: SCHEDULE IS TO CONSTRUCT AN FAA INELIGIBLE ADDITIONAL PARKING AREA FOR AUTO PARKING SPOTS.
ALTERNATE C: SCHEDULE IS TO REMOVE AND REPLACE SIDING AND ROOFING ASSOCIATED WITH THE EXISTING HANGAR.
ALTERNATE D: SCHEDULE IS TO PROVIDE TEMPORARY INTERIM TERMINAL FACILITY AND TOILET FACILITIES.



I HEREBY CERTIFY THAT THIS PLAN,
SPECIFICATION, OR REPORT WAS PREPARED
BY ME OR UNDER MY DIRECT SUPERVISION
AND THAT I AM A DULY LICENSED
PROFESSIONAL ENGINEER UNDER THE LAWS
OF THE STATE OF MINNESOTA.


RYAN FALCH, PE

DATE 05/17/2023 LICENSE NO. 60494



SKY HARBOR AIRPORT
2023 RECONSTRUCT TERMINAL BUILDING

DULUTH, MN

This drawing is an instrument of service and shall remain the property of Short Elliott Hendrickson, Inc. (SEH). This drawing, concepts and ideas contained herein shall not be used, reproduced, revised, or retained without the express written approval of SEH.

Submission or distribution of this drawing to meet official or regulatory requirements or for purposes in connection with the project is not to be construed as publication in derogation of any of the rights of SEH.


SEH Project
Checked By
Drawn By

Project Status	Issue
CONSTRUCTION	05/17
PLANS	

REVISION SCHEDULE		
REV. #	DESCRIPTION	DATE

STATEMENT OF ESTIMATED
QUANTITIES

G2.10

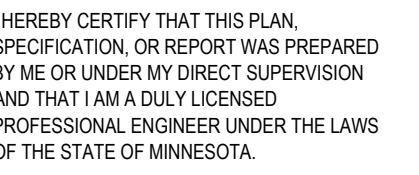

DATE 05/17/2023 LICENSE NO. 60494



DULUTH, MN

COPYRIGHT © 2023
Short Elliott Hendrickson, Inc.
All Rights Reserved

AL
R
_17213


AL

Due Date
6/17/202

REV. #	DESCRIPTION	DATE
1	ADDENDUM #2	6/2/2023


DEMOLITION PLAN
(BUILDING)

C2.00

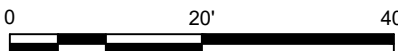


REMOVE EXISTING TERMINAL BUILDING

KEYMAP

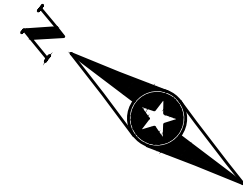

NOTES:

- 1

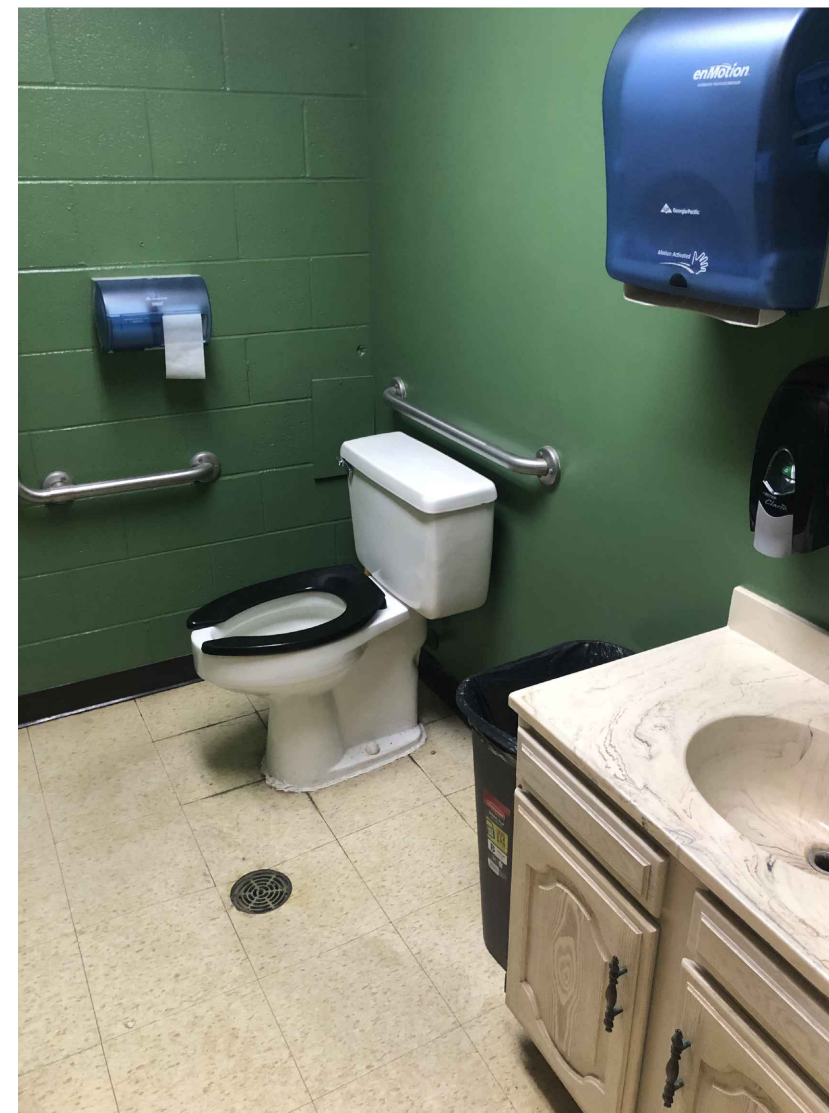



I HEREBY CERTIFY THAT THIS PLAN, SPECIFICATION, OR REPORT WAS PREPARED BY ME OR UNDER MY DIRECT SUPERVISION AND THAT I AM A DULY LICENSED PROFESSIONAL ENGINEER UNDER THE LAWS OF THE STATE OF MINNESOTA.

RYAN FALCH, PE
DATE 05/17/2023 LICENSE NO. 60494



SKY HARBOR AIRPORT
2023 RECONSTRUCT TERMINAL BUILDING
DULUTH, MN

This drawing is an instrument of service and shall remain the property of Short Elliott Hendrickson, Inc. (SEH). This drawing, concepts and ideas contained herein shall not be used, reproduced, revised, or retained without the express written approval of SEH.


SEH Project Checked By Drawn By
DULAL172133 RF ALS

Project Status Issue Date
CONSTRUCTION 05/17/2023
PLANS

REVISION SCHEDULE		
REV. #	DESCRIPTION	DATE
1	ADDENDUM #2	6/2/2023

DEMOLITION PLAN (SITE)

C2.10

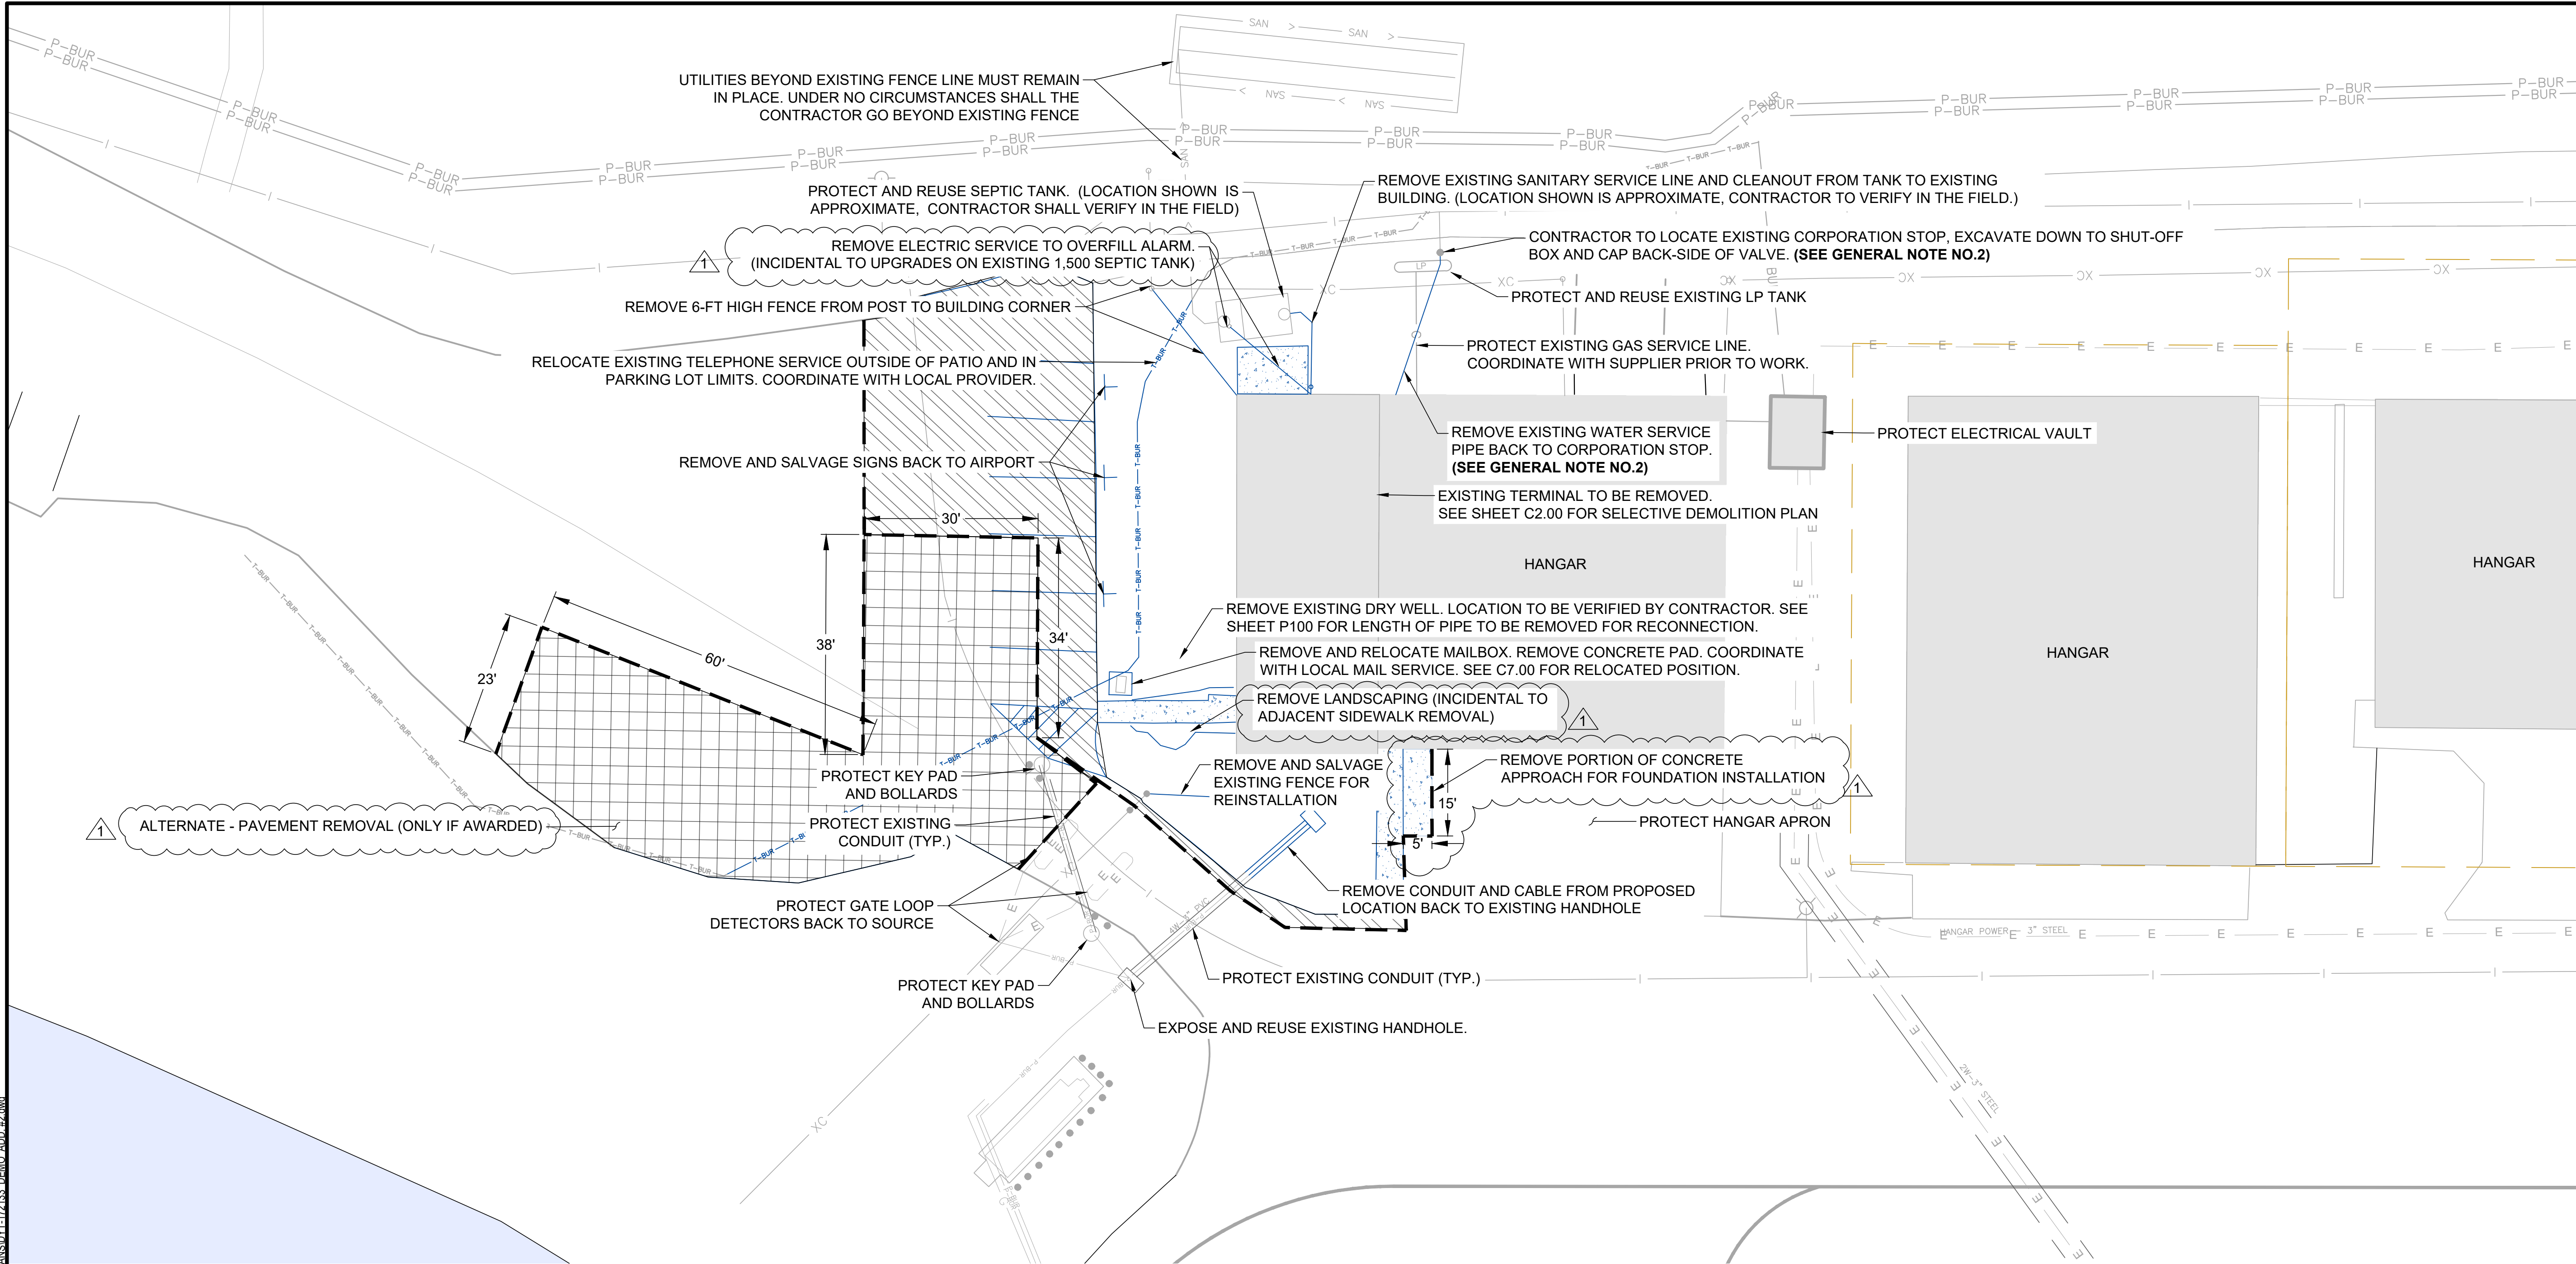

NOTES:



- PRIOR TO ANY OTHER WORK, THE INTERIM TERMINAL FACILITY MUST BE SET UP AND OPERATIONAL INCLUDING FUELING MONITORING EQUIPMENT WHICH SHALL BE TEMPORARILY SET UP IN THE HANGAR.
- REMOVAL OF EXISTING WATER SERVICE MUST NOT TAKE PLACE UNTIL NEW WATER SERVICE TO 8" HPDE WATER MAIN HAS BEEN INSTALLED, TESTED, AND OPERABLE. EXISTING WATER TO BUILDING MUST REMAIN OPERABLE FOR SERVICE TO TEMPORARY SANITARY FACILITY. IF SERVICE MUST BE DISCONNECTED, CONTRACTOR MUST PROVIDE ALTERNATIVE SETUP.
- UTILITIES SHOWN ON PLANS ARE APPROXIMATE. ALL UTILITIES AND ELECTRICAL DUCTS TO BE PROTECTED BY CONTRACTOR. ANY DAMAGED UTILITIES TO BE REPAIRED BY CONTRACTOR AT NO COST TO OWNER.
- CONCRETE HANGAR PADS, AIRPORT PARKING LOT, AND APRON PAVEMENT TO BE MATCHED AS DIRECTED BY THE ENGINEER. SAWCUTTING MAY BE NECESSARY TO PROPERLY MATCH EXISTING PAVEMENTS.
- ALL PAVEMENTS REMOVALS SHALL BE PERFORMED SUCH THAT NO DAMAGE IS DONE TO ADJACENT PAVEMENTS AND/OR UNDERLYING BASE LAYERS. DAMAGE TO PAVEMENTS AND UNDERLYING BASE LAYERS TO REMAIN CAUSED BY CONTRACTOR SHALL BE REPAIRED AT THE DIRECTION OF THE ENGINEER AT NO ADDITIONAL COST.
- ALL SURFACES (PAVEMENT, TURF, OR OTHERS) SHALL BE RESTORED TO THEIR PRECONSTRUCTION CONDITION OR BETTER TO THE SATISFACTION OF THE ENGINEER AT NO ADDITIONAL COST.
- ALL SAWCUTS ARE TO BE FULL DEPTH AND PROTECTED. PAYMENT WILL BE ONLY FOR ONE-TIME.
- SEE SHEET C2.00 FOR SELECTIVE DEMOLITION.
- OTHER THAN HMA, THE EXCAVATED MATERIAL FOR NEW TERMINAL BUILDING MAY BE USED OUTSIDE OF PAVEMENT LIMITS FOR FILL ON THE SLOPES. DISPOSE OF UNUSED MATERIAL OFFSITE. PLACEMENT OF EXCAVATED MATERIAL ON AREAS OUTSIDE OF PAVEMENT WILL BE PAID FOR BY COMMON BORROW.


LEGEND

- REMOVAL (PAVEMENT AND AGGREGATE)
- ALTERNATE - REMOVAL (PAVEMENT AND AGGREGATE)
- DEMO ITEMS
- SAWCUT LIMITS

KEYMAP

CONSTRUCTION AREA

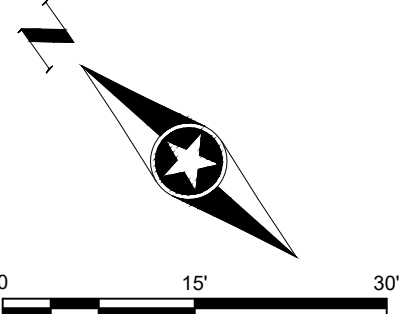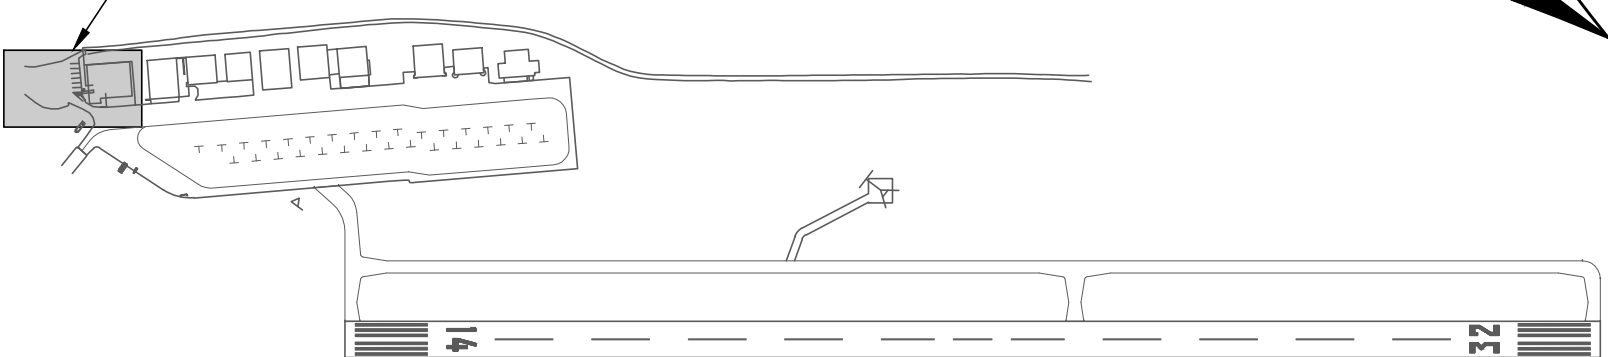

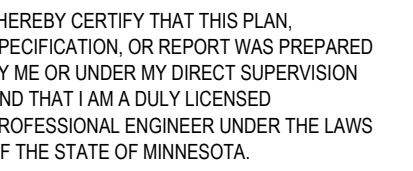

DULUTH, MN


COPYRIGHT © 2023
Short Elliott Hendrickson, Inc.
All Rights Reserved

AL_17213
R
AL







Issue Date
5/17/202

REV. #	DESCRIPTION	DATE
1	ADDENDUM #1	5/30/202
2	ADDENDUM #2	6/2/2023

C2.20

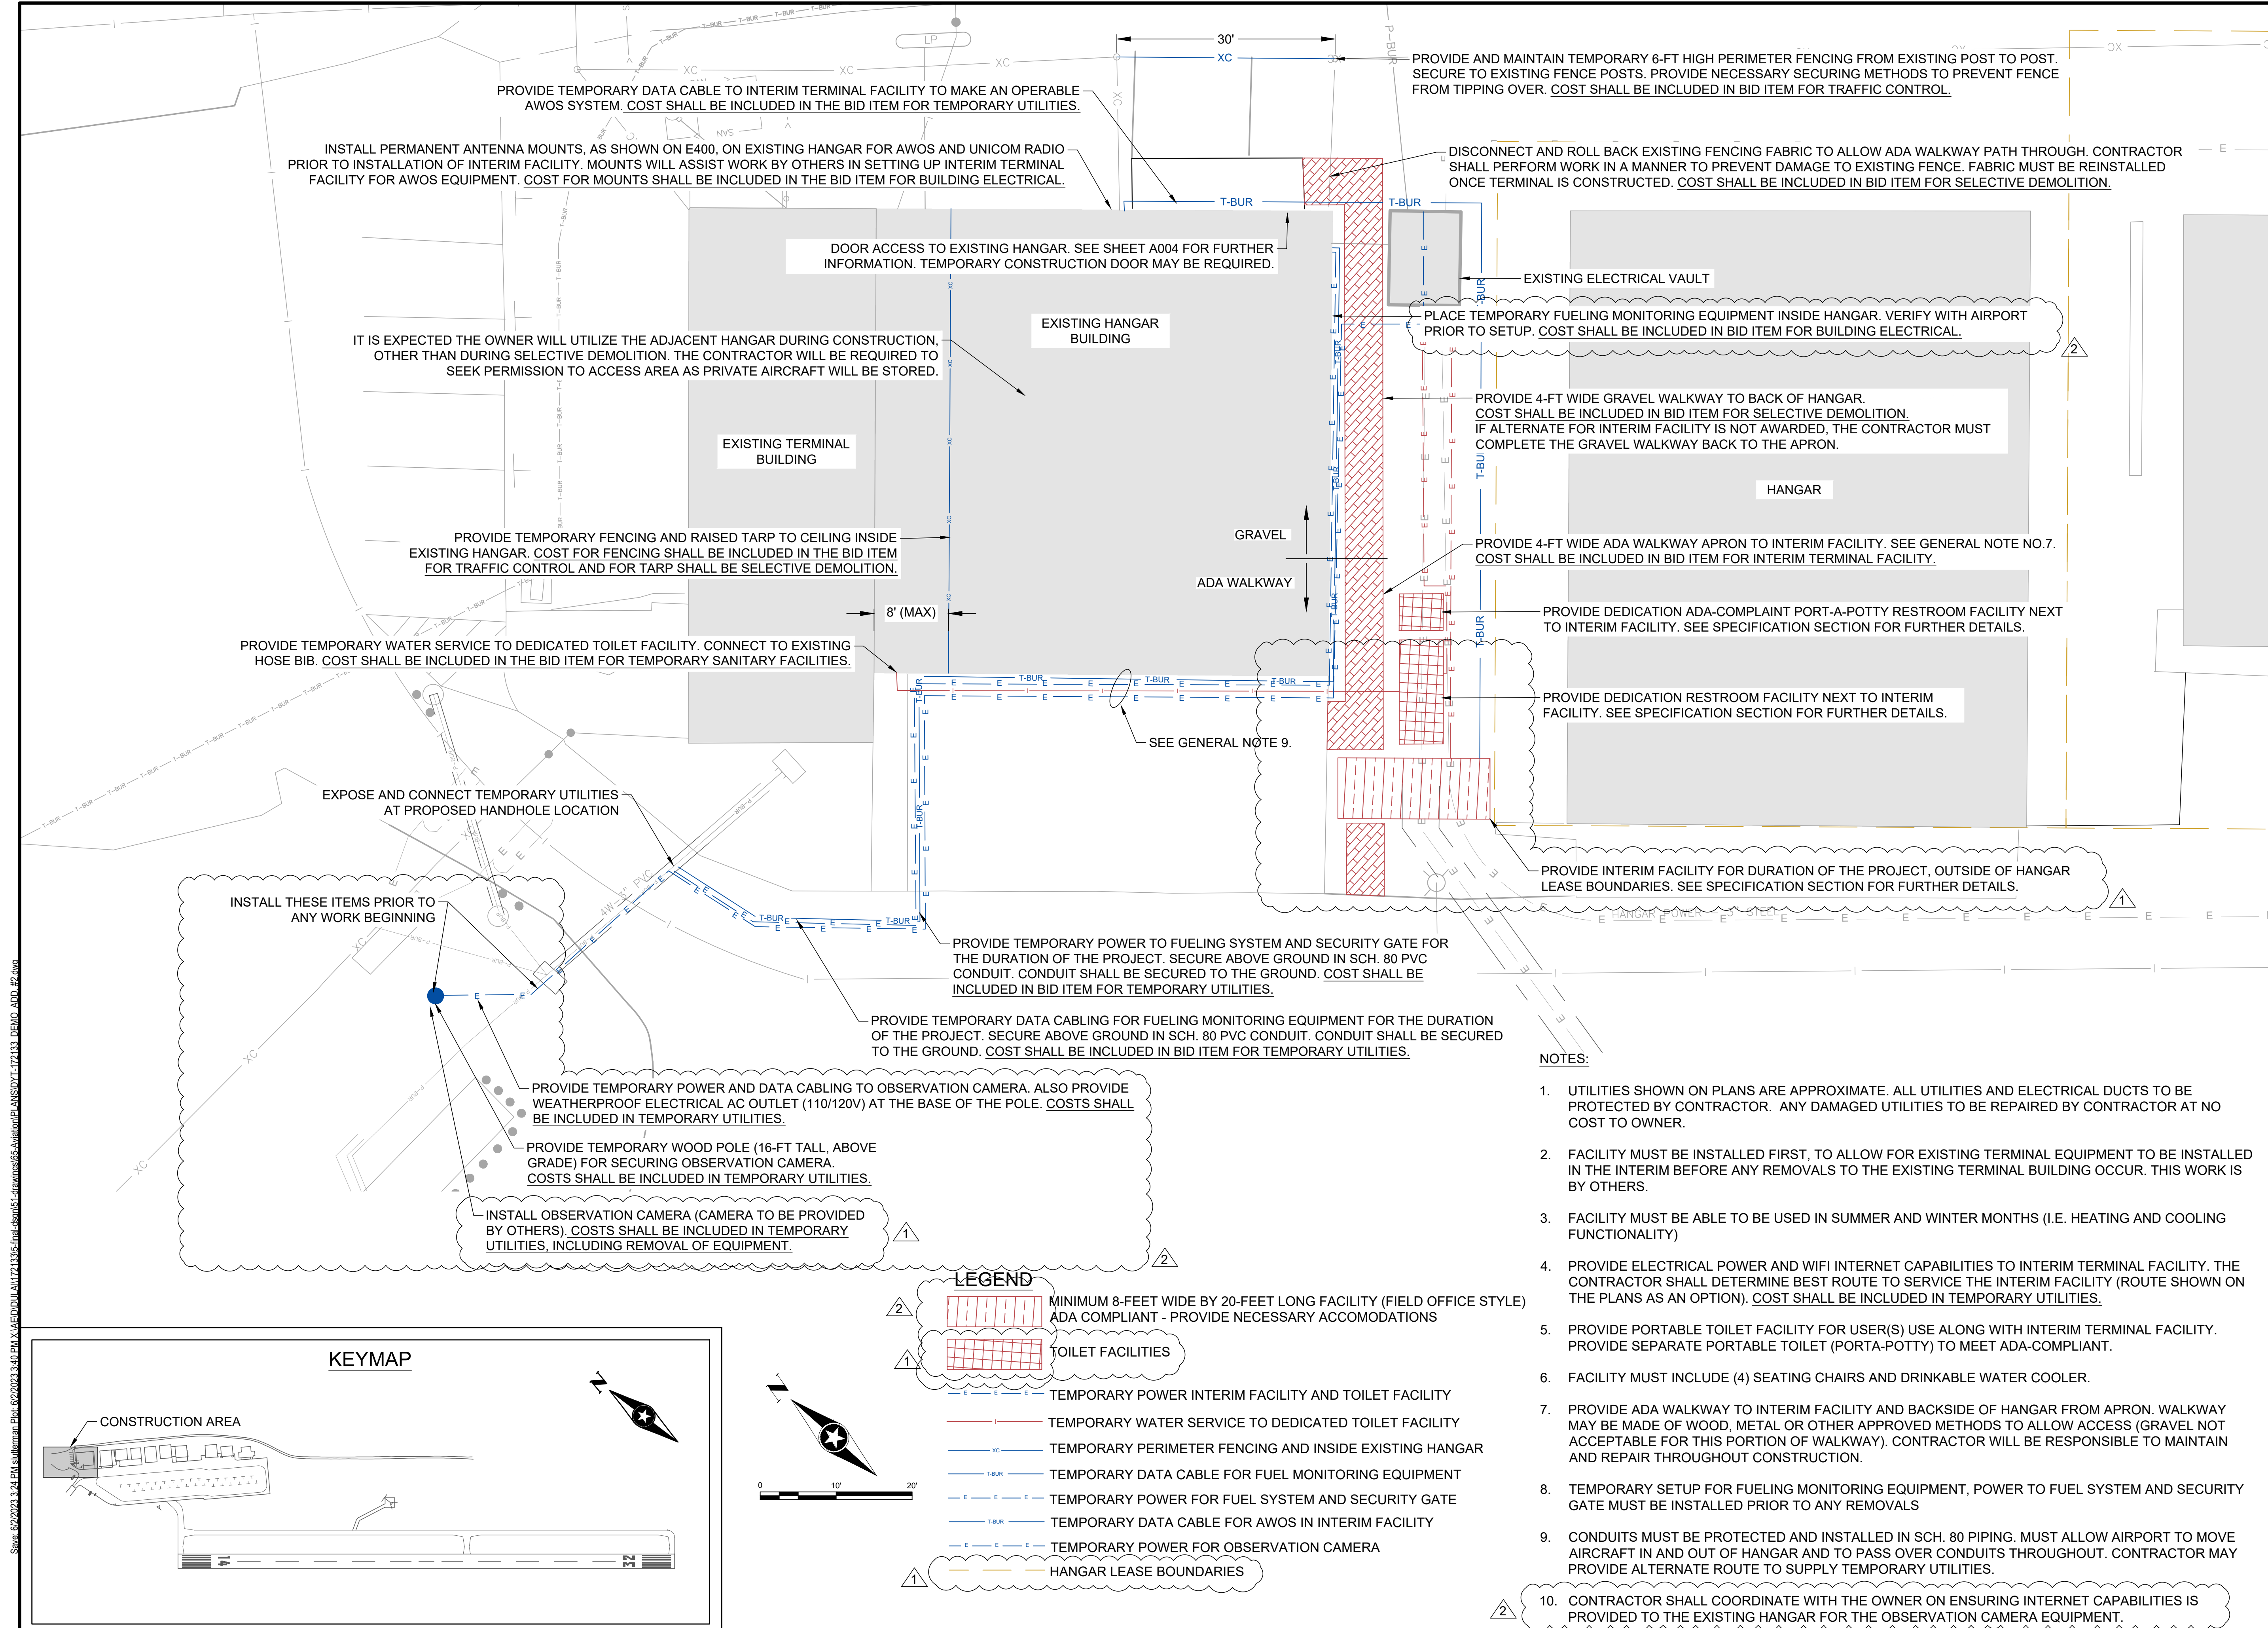


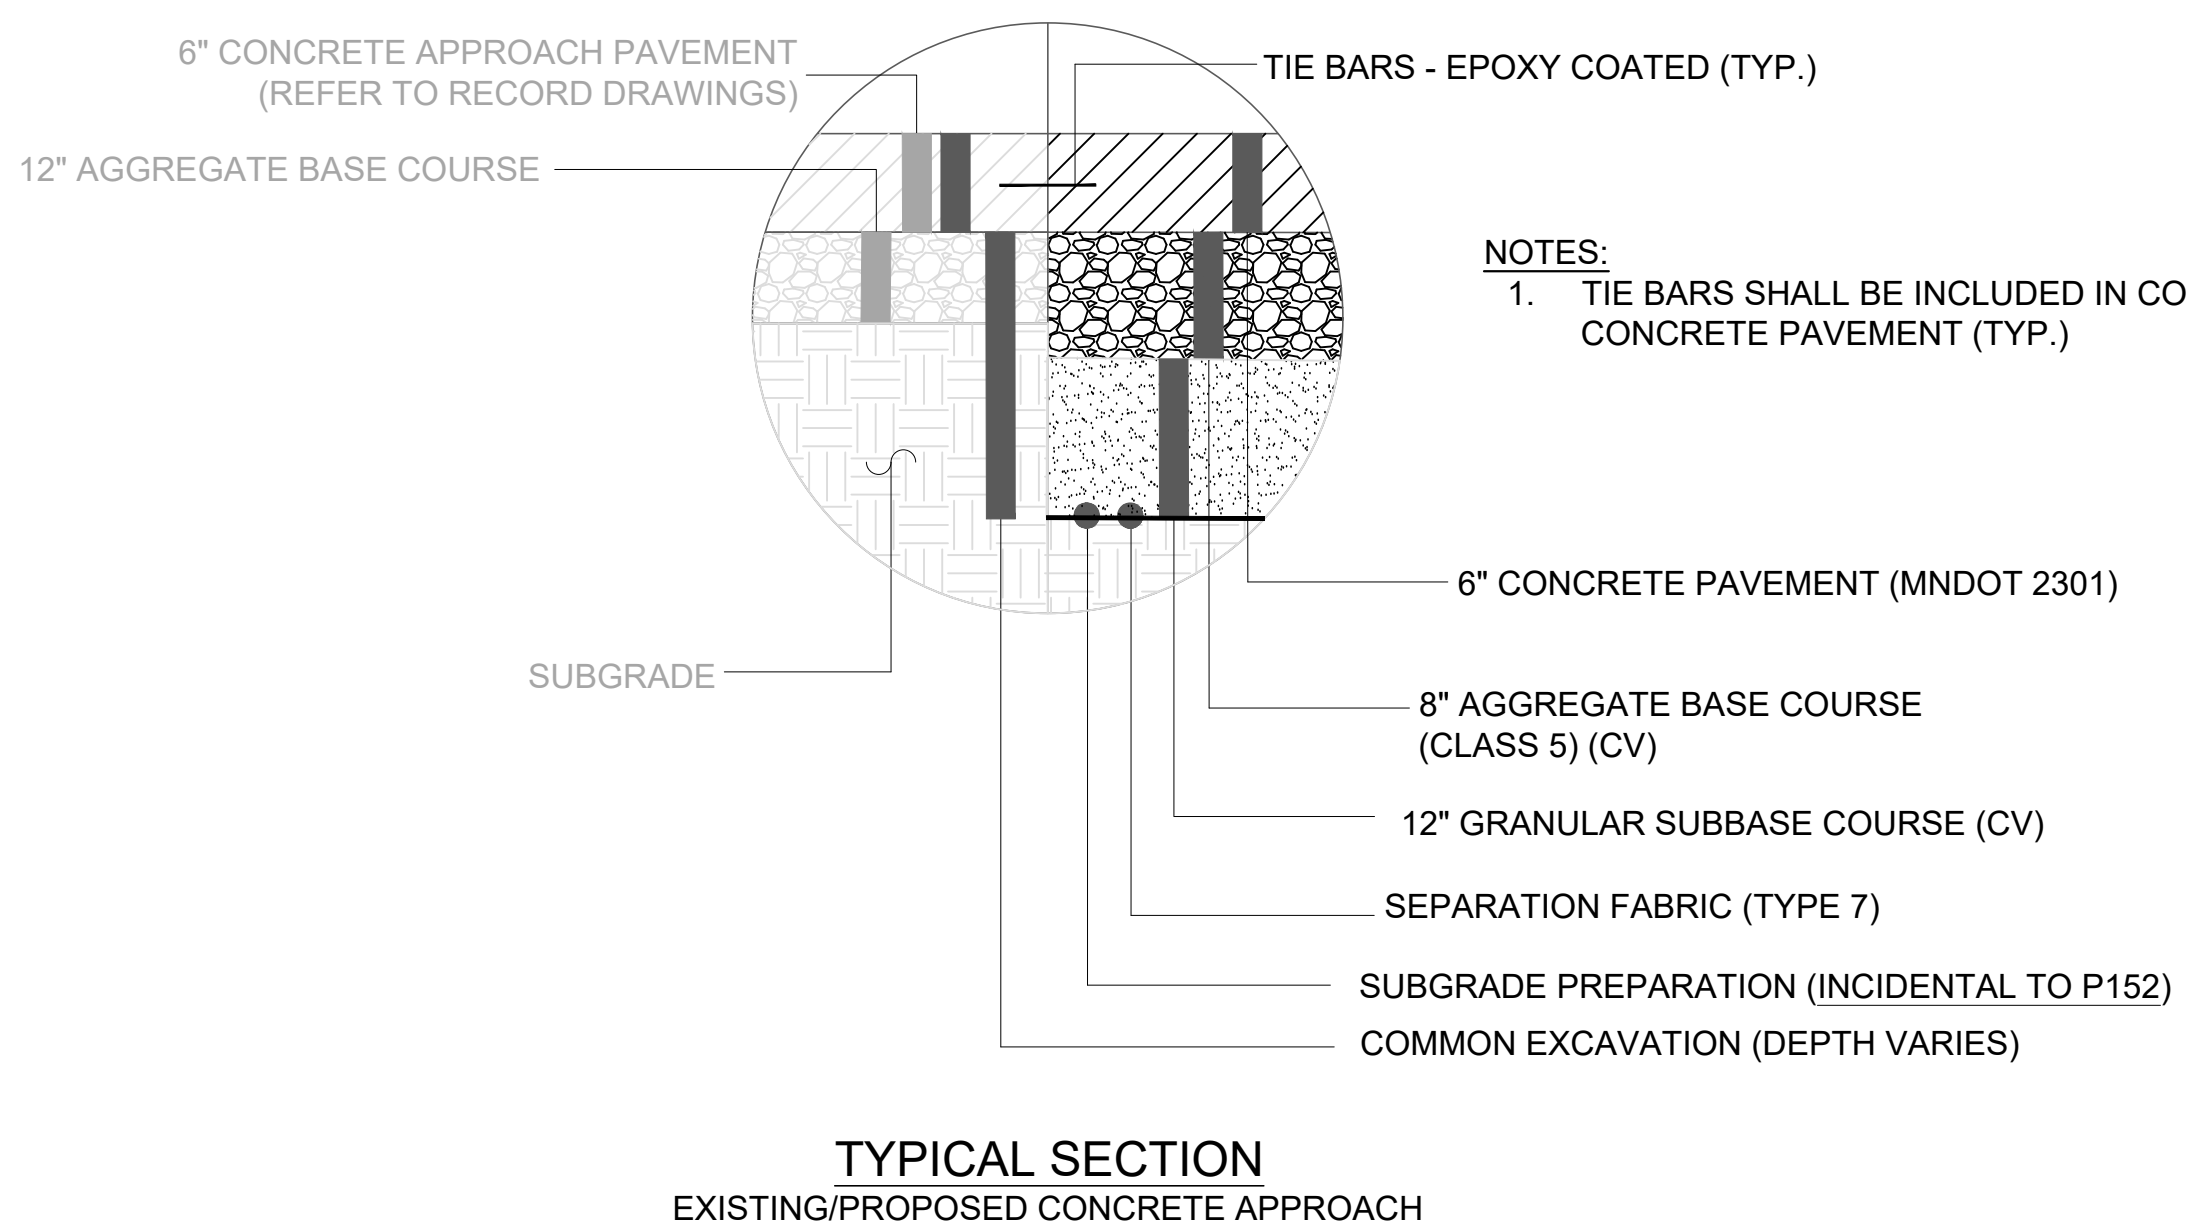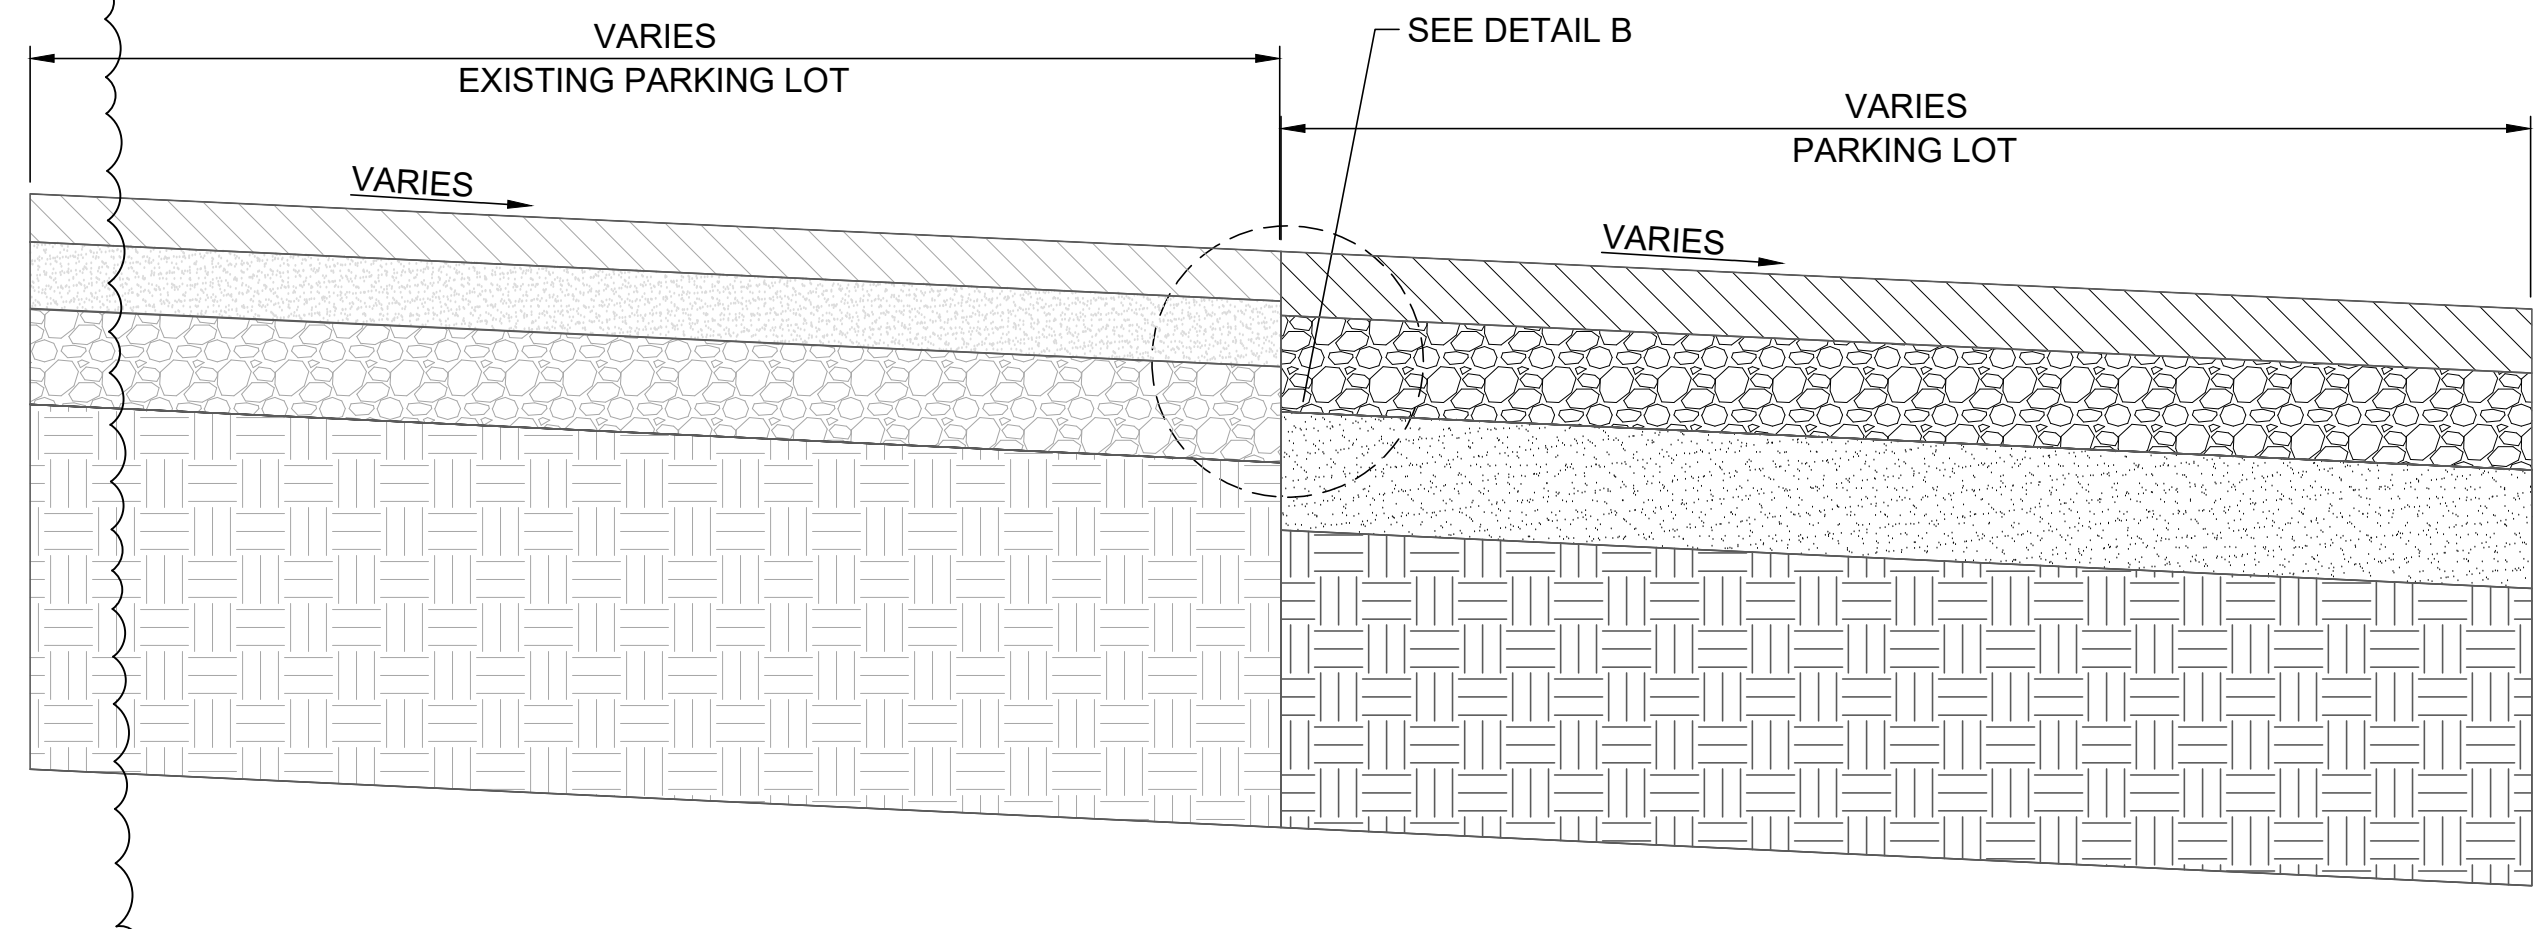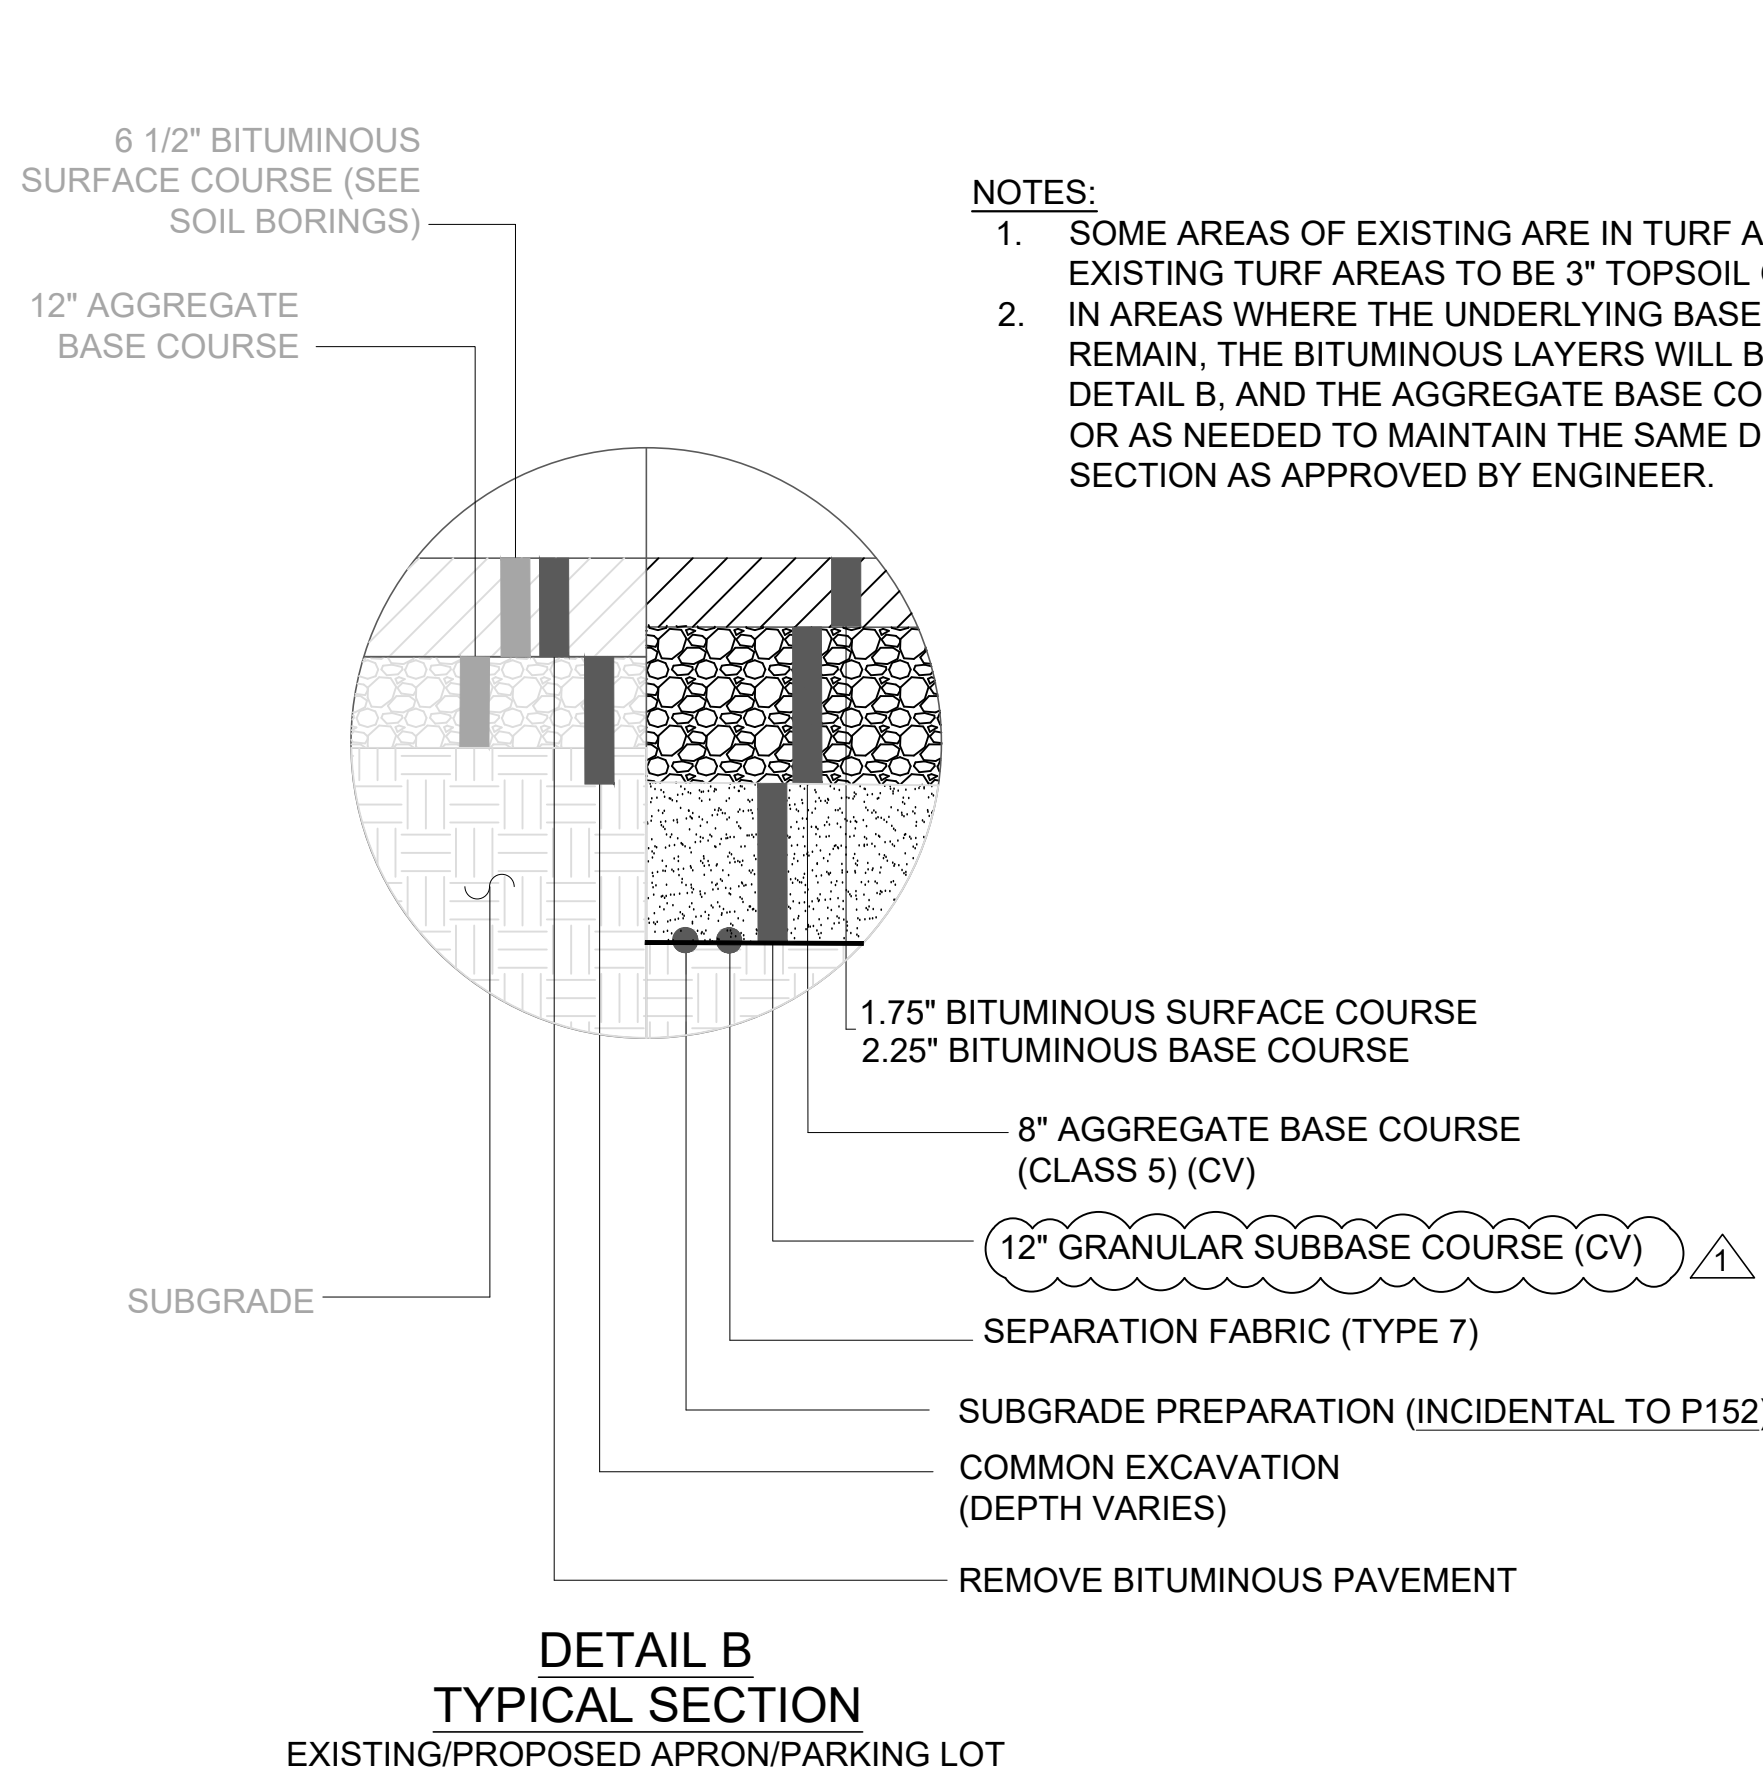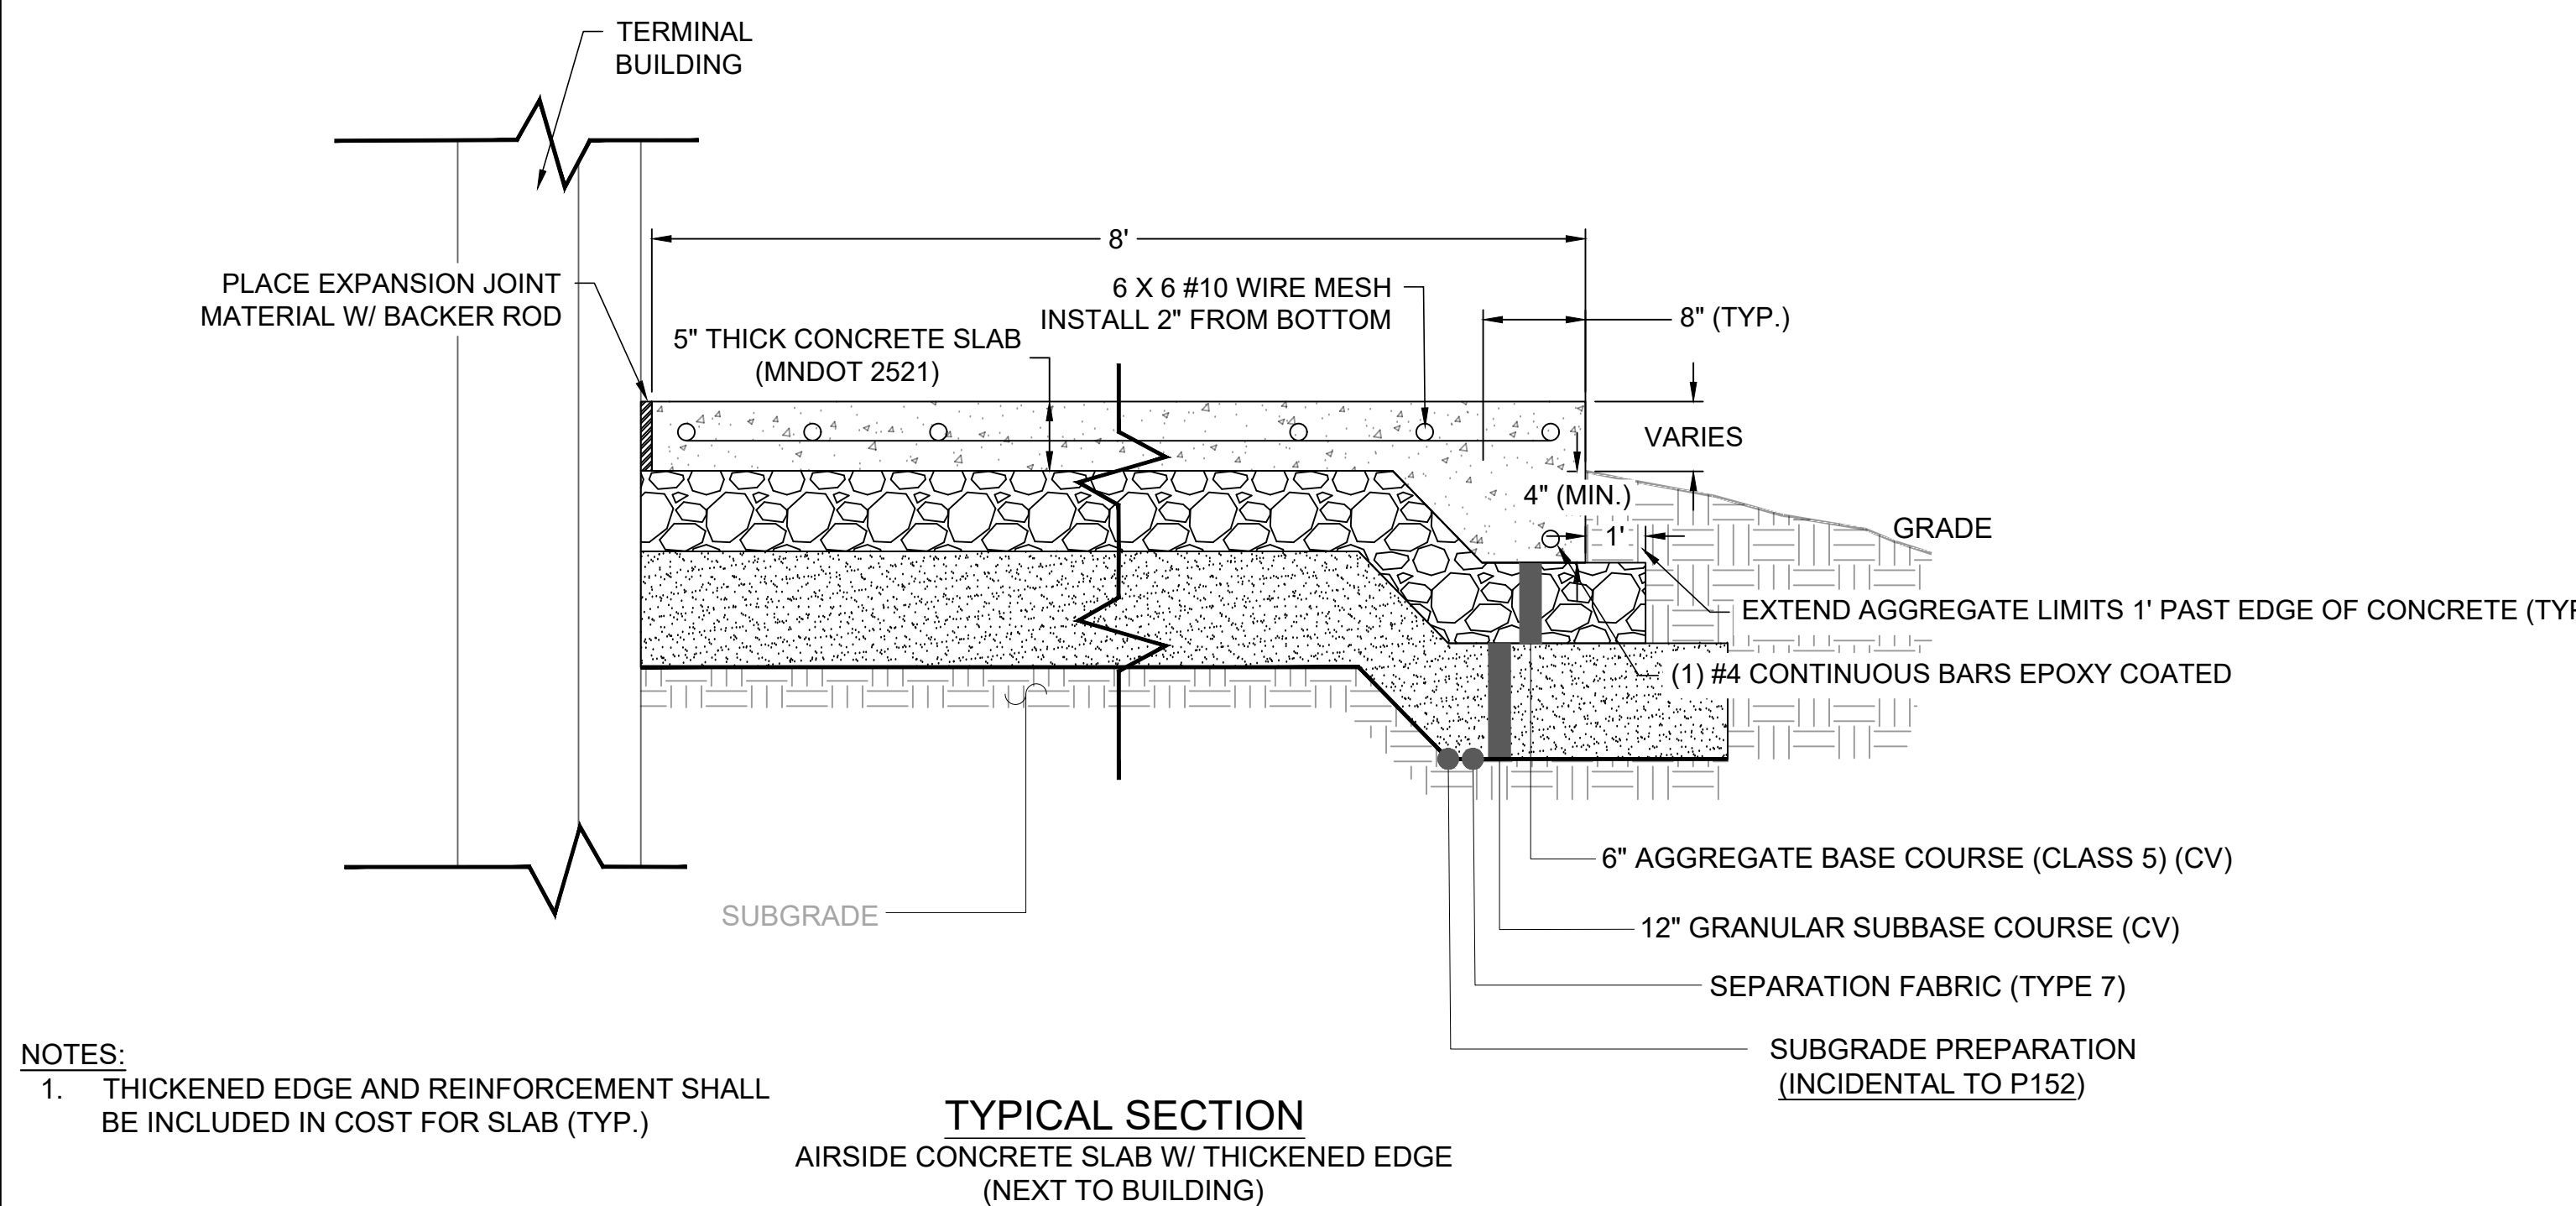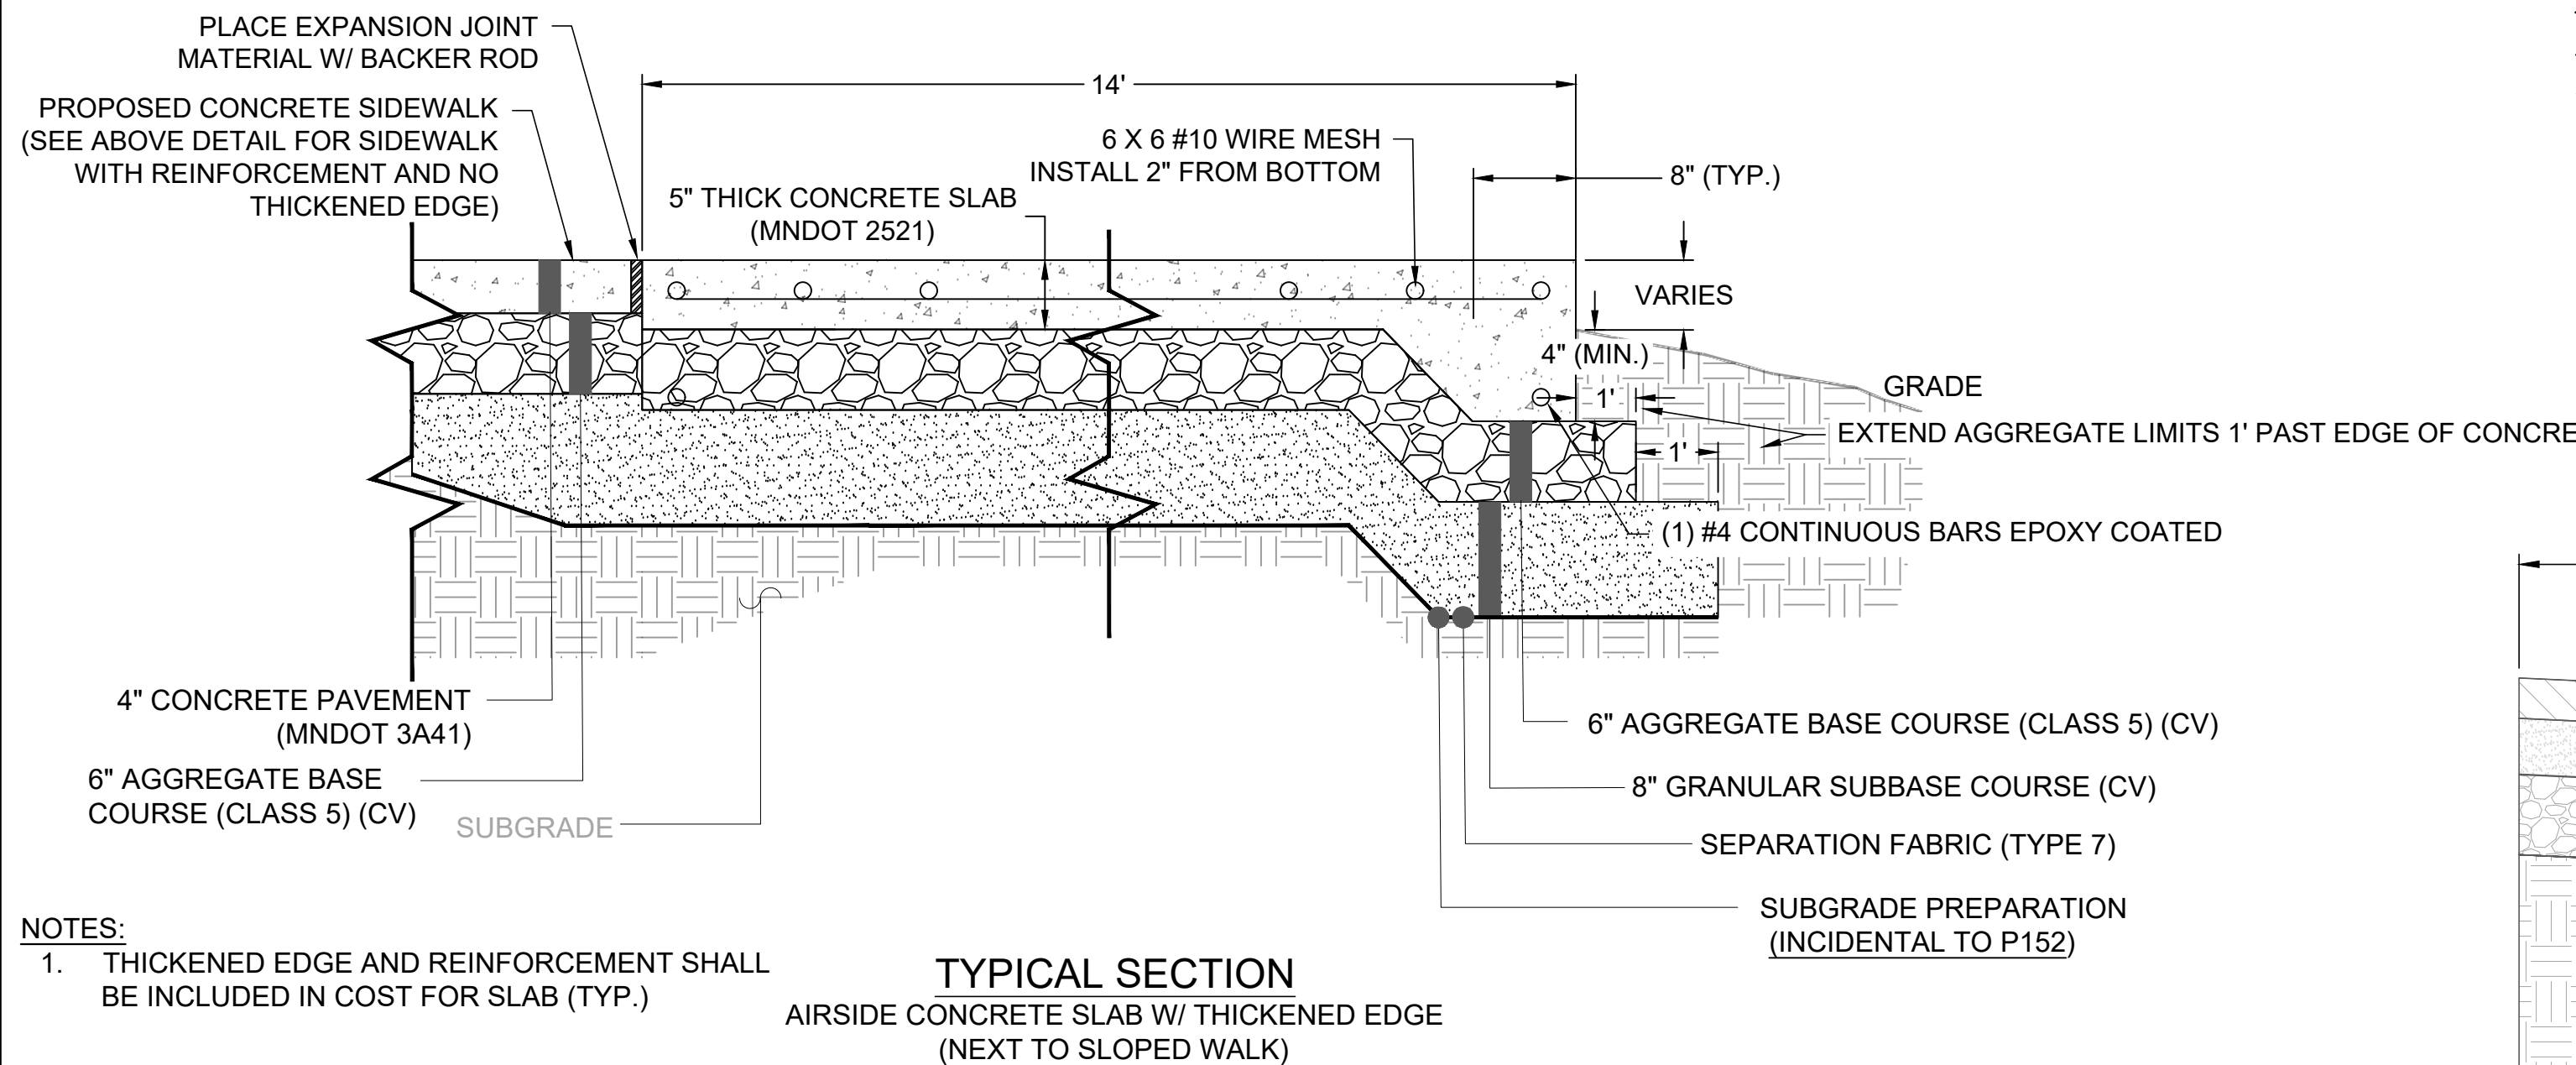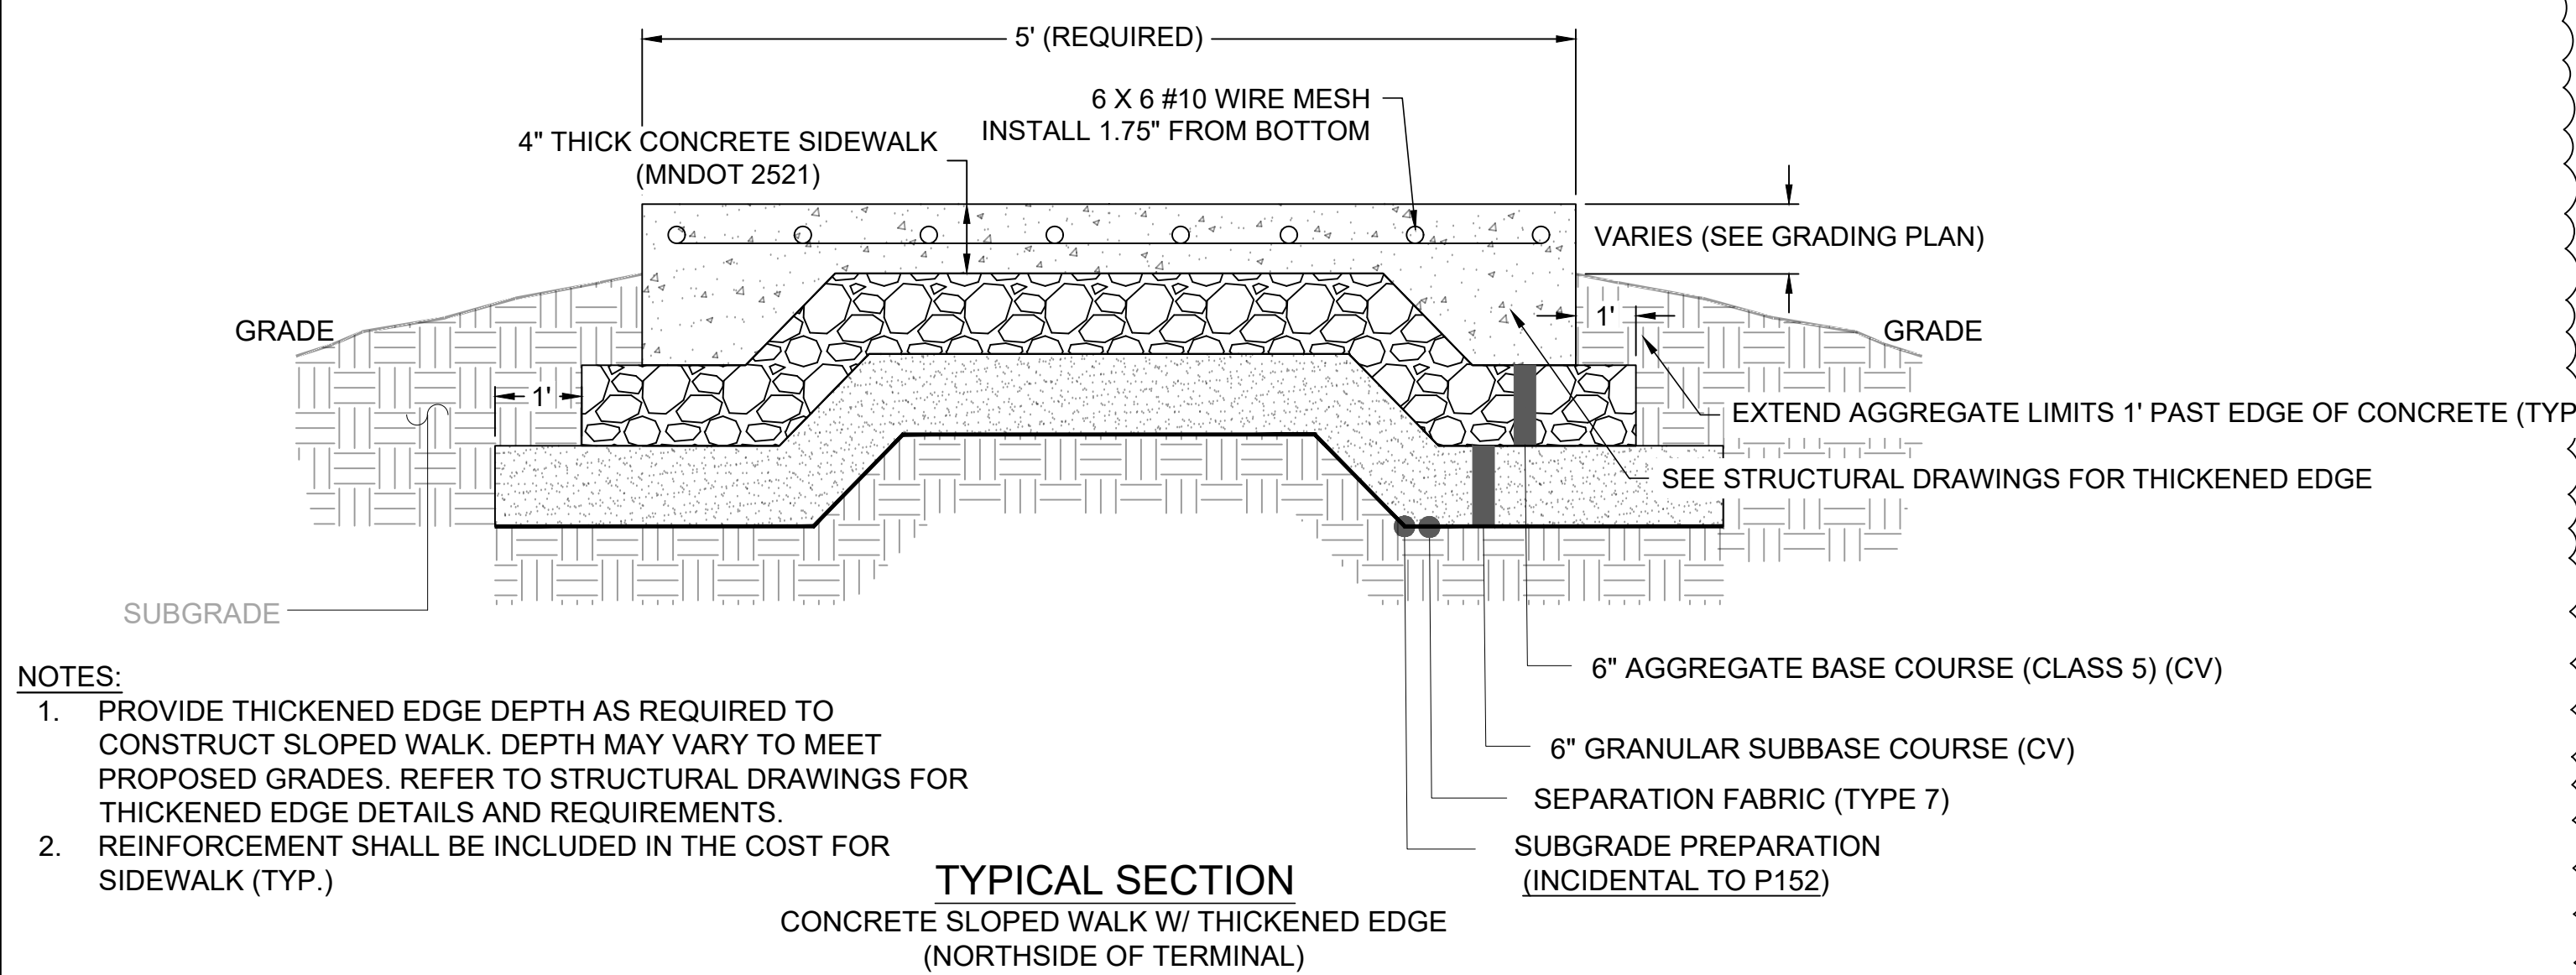

I HEREBY CERTIFY THAT THIS PLAN, SPECIFICATION, OR REPORT WAS PREPARED BY ME OR UNDER MY DIRECT SUPERVISION AND THAT I AM A DULY LICENSED PROFESSIONAL ENGINEER UNDER THE LAWS OF THE STATE OF MINNESOTA.

RYAN FALCH, P.E.
DATE: 06/17/2023 LICENSE NO.: 60494



SKY HARBOR AIRPORT
2023 RECONSTRUCT TERMINAL BUILDING
DULUTH, MN

This drawing is an instrument of service and shall remain the property of Short Elliott Hendrickson, Inc. (SEH). This drawing, concepts and ideas contained herein shall not be used, reproduced, revised, or retained without the express written approval of SEH.

SEH Project Checked By Drawn By
DULAL172133 RF ALS

Project Status Construction Plans
Issue Date 05/17/2023

REVISION SCHEDULE		
REV. #	DESCRIPTION	DATE
1	ADDENDUM #2	6/2/2023

TYPICAL SECTIONS

C3.00



I HEREBY CERTIFY THAT THIS PLAN, SPECIFICATION, OR REPORT WAS PREPARED BY ME OR UNDER MY DIRECT SUPERVISION AND THAT I AM A DULY LICENSED PROFESSIONAL ENGINEER UNDER THE LAWS OF THE STATE OF MINNESOTA.

Ryan Falch
RYAN FALCH, P.E.
DATE 05/17/2023 LICENSE NO. 60494



SKY HARBOR AIRPORT
2023 RECONSTRUCT TERMINAL BUILDING
DULUTH, MN

This drawing is an instrument of service and shall remain the property of Short Elliott Hendrickson, Inc. (SEH). This drawing, concepts and ideas contained herein shall not be used, reproduced, revised, or retained without the express written approval of SEH.

Submission or distribution of this drawing to meet official or regulatory requirements or for purposes in connection with the project is not to be construed as publication in derogation of any of the rights of SEH.

COPYRIGHT © 2023
Short Elliott Hendrickson, Inc.
All Rights Reserved



SEH Project DULAL172133
Checked By RF
Drawn By ALS

Project Status Issue Date
CONSTRUCTION 05/17/2023
PLANS

REVISION SCHEDULE		
REV. #	DESCRIPTION	DATE
1	ADDENDUM #2	6/2/2023

PAVEMENT PLAN


C4.00

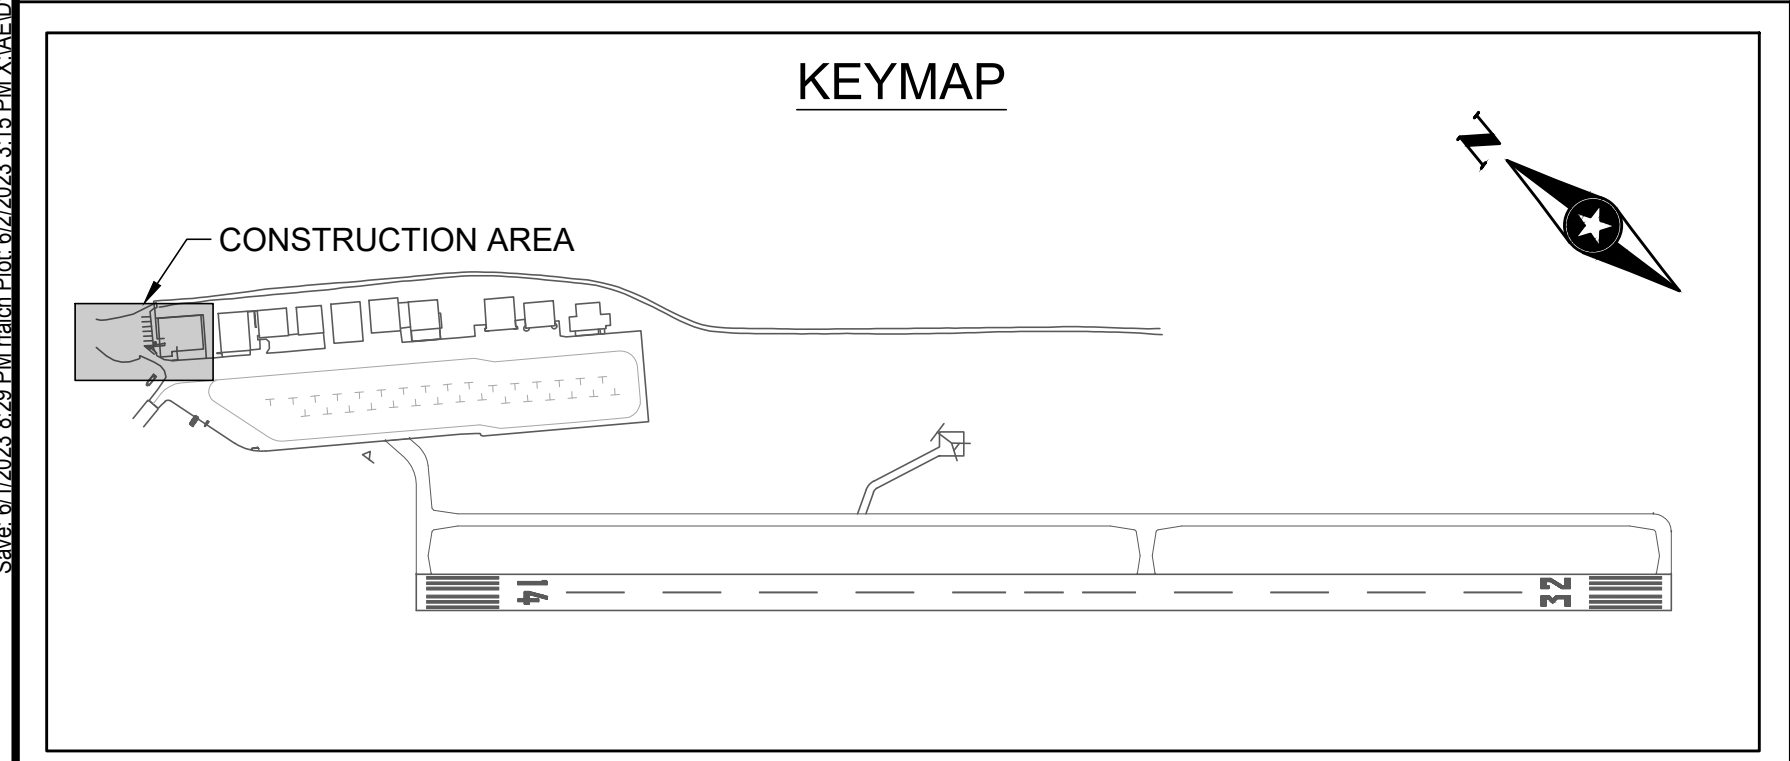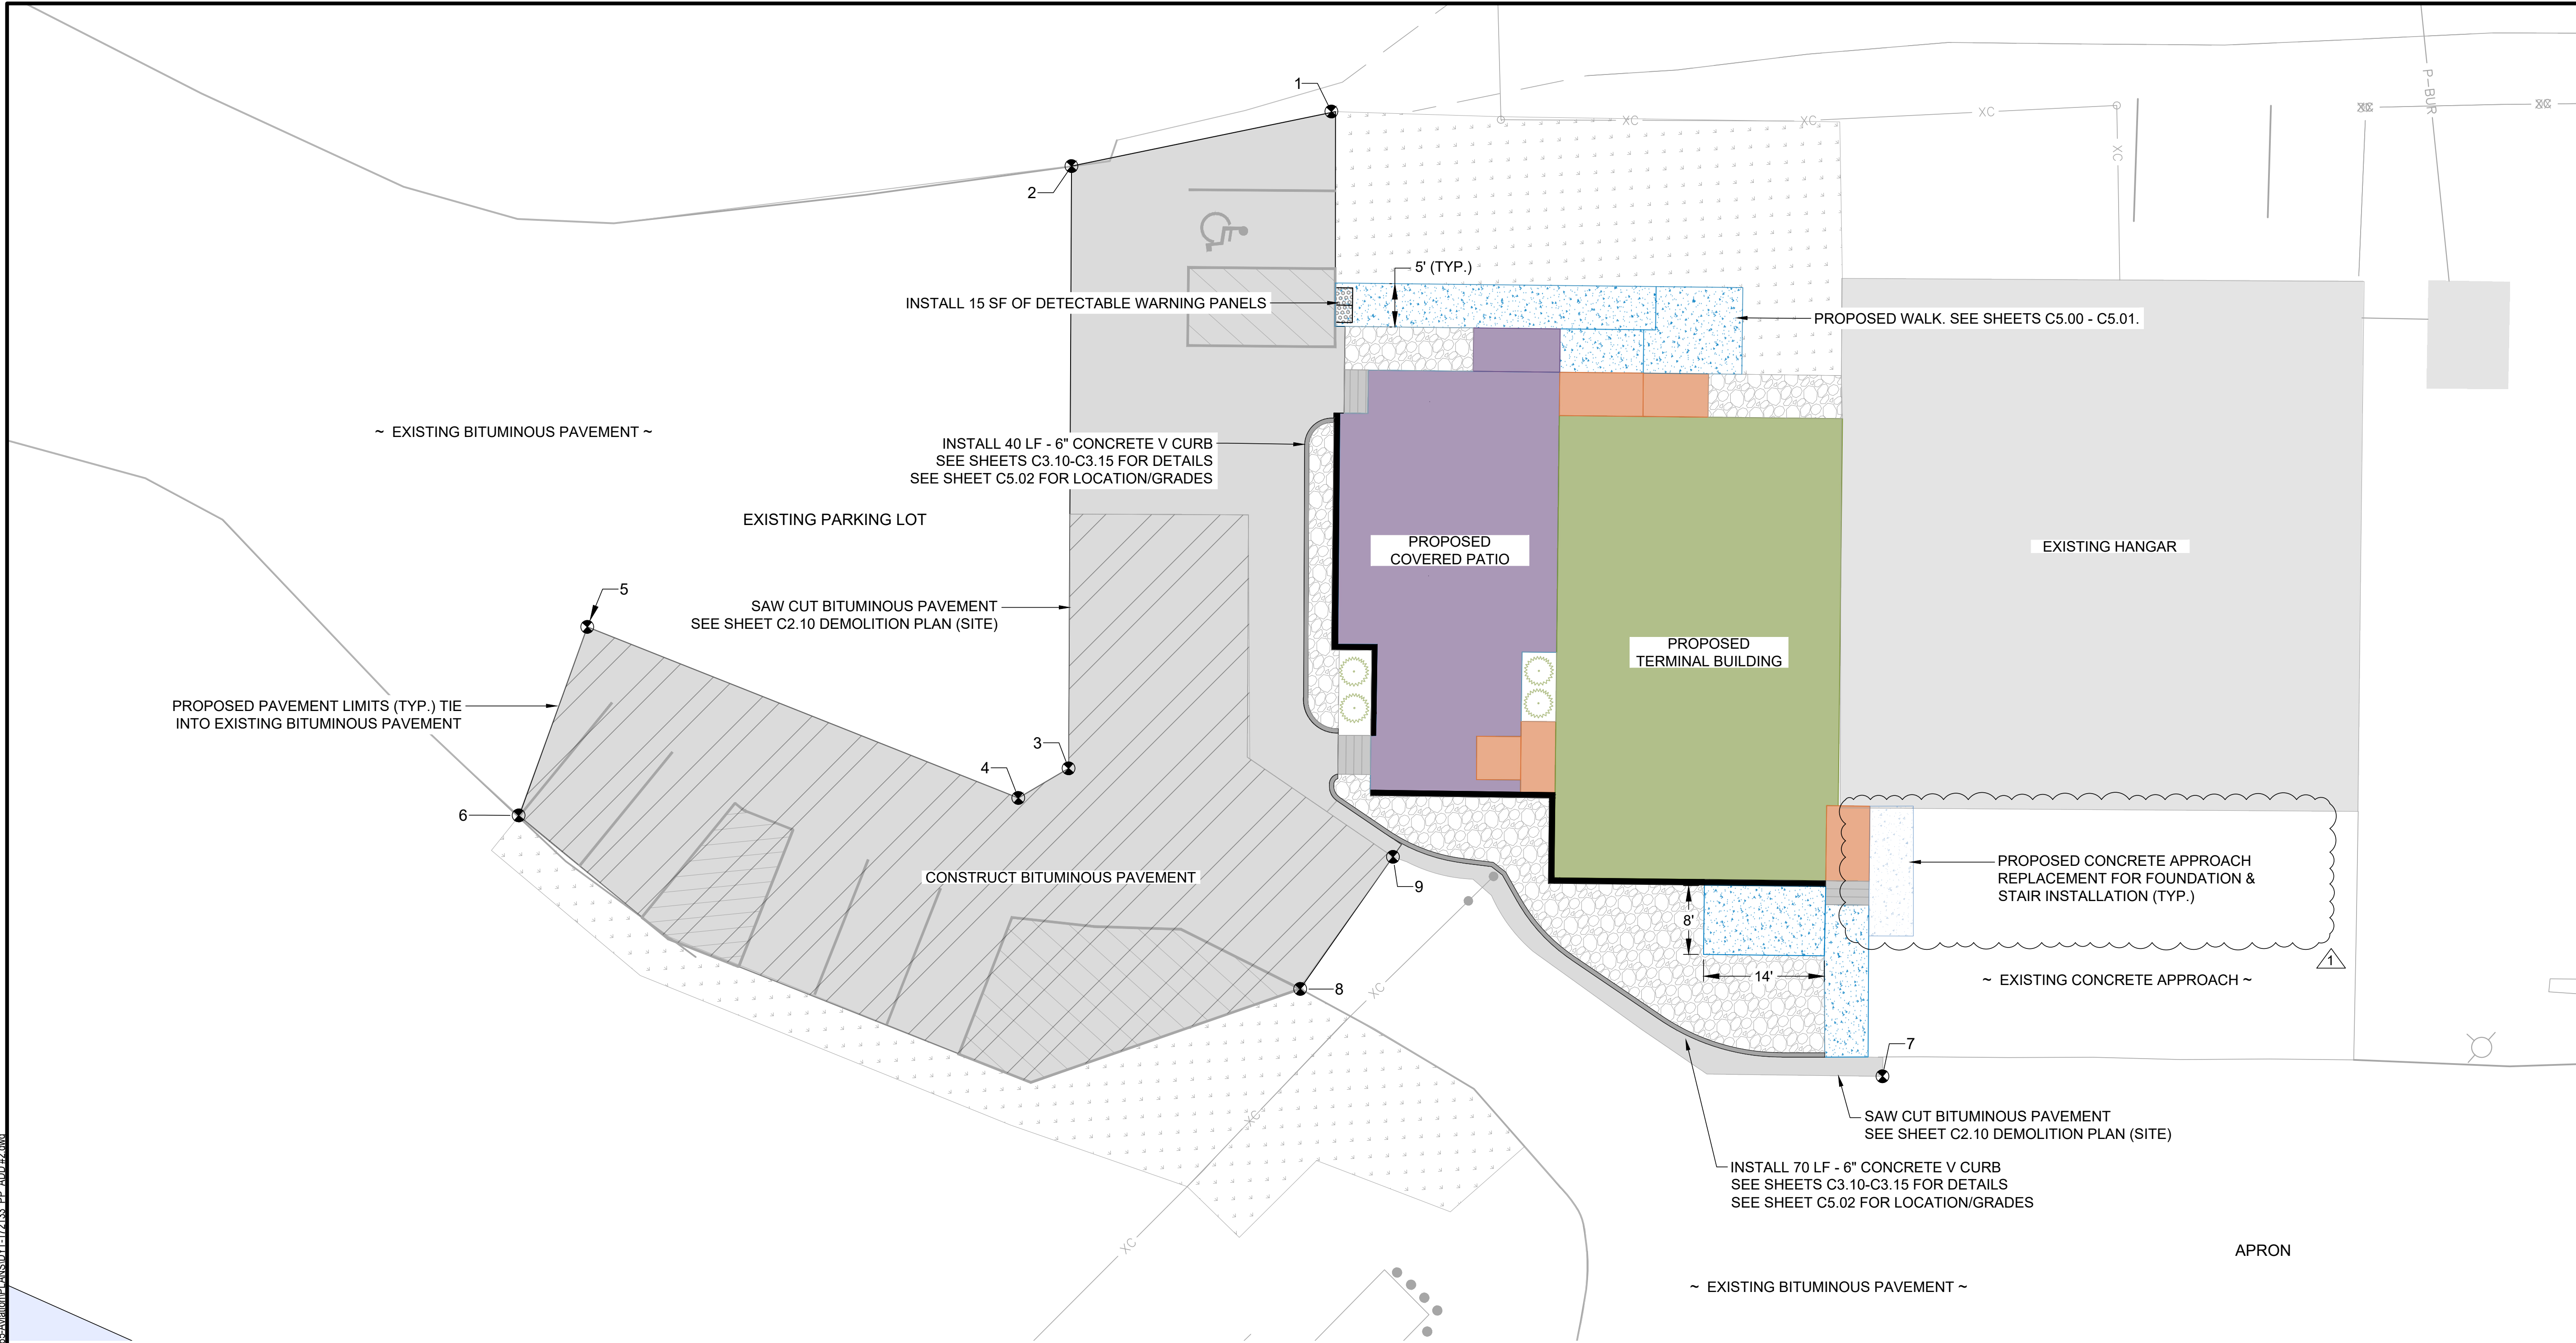






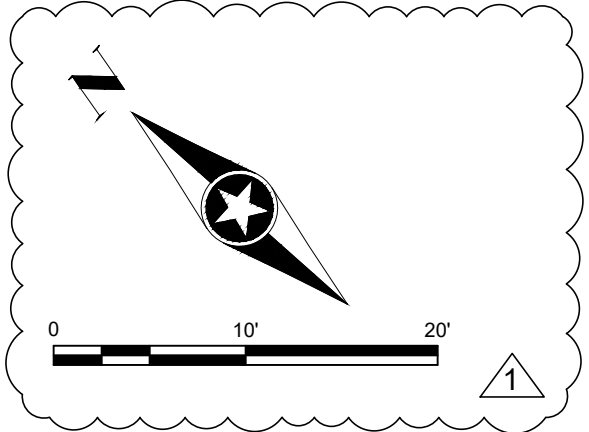

LEGEND

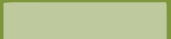- PROPOSED TERMINAL BUILDING (SEE ARCHITECTURAL)
- CONCRETE WALK & SLAB (SEE TYPICAL SECTIONS)
- BITUMINOUS PAVEMENT - ELIGIBLE (SEE TYPICAL SECTIONS)
- ALTERNATE - BITUMINOUS PAVEMENT - INELIGIBLE (SEE TYPICAL SECTIONS)
- CONCRETE STOOP (SEE STRUCTURAL)
- PATIO (SEE STRUCTURAL)
- CONCRETE APPROACH (SEE TYPICAL SECTIONS)

Point Table					
Point #	Northing	Easting	Latitude	Longitude	Raw Description
1	128407.0295	601085.0083	N46° 43' 37.82"	W92° 02' 49.08"	PAVEMENT LIMITS
2	128425.1094	601060.2916	N46° 43' 37.99"	W92° 02' 49.43"	PAVEMENT LIMITS
3	128378.9051	601008.3880	N46° 43' 37.54"	W92° 02' 50.18"	PAVEMENT LIMITS
4	128380.9405	601001.9705	N46° 43' 37.56"	W92° 02' 50.27"	PAVEMENT LIMITS
5	128431.1090	600983.4067	N46° 43' 38.06"	W92° 02' 50.53"	PAVEMENT LIMITS
6	128422.4455	600961.9371	N46° 43' 37.97"	W92° 02' 50.84"	PAVEMENT LIMITS
7	128285.3385	601044.7350	N46° 43' 36.62"	W92° 02' 49.66"	PAVEMENT LIMITS
8	128342.0269	601007.3250	N46° 43' 37.18"	W92° 02' 50.20"	PAVEMENT LIMITS
9	128344.2471	601025.8181	N46° 43' 37.20"	W92° 02' 49.93"	PAVEMENT LIMITS



	PROPOSED TERMINAL BUILDING
	PROPOSED SIDEWALK (SEE TYPICAL SECTIONS)
	PROPOSED AIRSIDE CONCRETE SLAB (SEE TYPICAL SECTIONS)
	PROPOSED BITUMINOUS PAVEMENT (SEE TYPICAL SECTIONS)
	PROPOSED TURF ESTABLISHMENT
	PROPOSED LANDSCAPE AREA (INCLUDES 4" THICK OF ROCK & WEED BARRIER)
x 995.50	PROPOSED/EXISTING ELEVATIONS
1.50% 	PROPOSED SLOPE AND DIRECTION



1. STRIPPING, SALVAGE, AND STOCKPILE OF EXISTING ON-SITE TOPSOIL SHALL BE COVERED UNDER ITEM "COMMON EXCAVATION". EXCESS STOCKPILED TOPSOIL SHALL BE DISPOSED OF OFF AIRPORT PROPERTY. NO EXCESS STOCKPILED TOPSOIL SHALL BE WASTED AT THE SITE UNLESS APPROVED BY ENGINEER. EXCESS STOCKPILED TOPSOIL OFF SITE DISPOSAL OR RELOCATION WITH APPROVAL FROM ENGINEER SHALL BE PAID FOR UNDER "COMMON EXCAVATION".
2. SUBGRADE EXCAVATION AS DIRECTED BY ENGINEER IN FIELD ONLY INCLUDES PAVEMENT AREAS. PAYMENT FOR SUBGRADE EXCAVATION INCLUDES REPLACEMENT OF REMOVED MATERIAL WITH SUITABLE GRANULAR MATERIAL WILL BE COVERED UNDER ITEM NO. P-152, "UNCLASSIFIED OVER EXCAVATION (EV)"
3. SUBGRADE EXCAVATION FOR TERMINAL BUILDING FLOOR, FOOTINGS AND SLAB WILL BE COVERED UNDER ITEM NO. P-152, "UNCLASSIFIED OVER EXCAVATION (EV)"
4. COMMON EXCAVATION FOR TERMINAL BUILDING FOUNDATION, FOOTINGS AND SLAB WILL BE COVERED UNDER ITEM NO. 31 20 30, "STRUCTURE EXCAVATION."
5. AGGREGATE BASE FOR TERMINAL BUILDING FLOOR WILL BE COVERED UNDER ITEM "BUILDING CONSTRUCTION."
6. SELECT GRANULAR BORROW, FOR TERMINAL BUILDING FLOOR WILL BE COVERED UNDER ITEM NO. 31 22 30, "STRUCTURAL BACKFILL (ENGINEERED FILL)."
7. EARTHWORK CONVERSION FACTORS ARE FOR REFERENCE ONLY. QUANTITIES WILL BE DETERMINED BY PRE AND POST EXCAVATION SURVEYS PERFORMED BY CONTRACTOR AT NO ADDITIONAL COST TO OWNER.
8. EXCAVATION OR FIELD GRADING QUANTITIES OUTSIDE OF THE GRADING LIMITS SHALL BE DETERMINED FROM A TOPOGRAPHIC SURVEY FROM BEFORE & AFTER THE WORK. THE SURVEY DATA SHALL BE SUBMITTED TO THE ENGINEER.
9. UNCLASSIFIED OVER EXCAVATION QUANTITIES ARE ESTIMATES ONLY. QUANTITIES FOR PAYMENT MUST BE JUSTIFIED FROM A TOPOGRAPHIC SURVEY FROM BEFORE & AFTER THE WORK OR AS AGREED UPON BY THE ENGINEER. THE SURVEY DATA SHALL BE SUBMITTED TO THE ENGINEER.
10. EXCAVATION WASTE MATERIALS REMOVED FROM THE CONSTRUCTION AREA SHALL BE DISPOSED OF OFF THE AIRPORT PROPERTY. NO MATERIAL SHALL BE WASTED ON THE AIRPORT SITE UNLESS APPROVED BY ENGINEER. WASTE AND DISPOSAL AREAS SHALL BE SEEDED AND RESTORED IN A SMOOTH, GRADED AND DRAINABLE CONDITION. BORROW AREAS, IF REQUIRED, SHALL BE LOCATED AS DIRECTED BY THE FIELD ENGINEER AND SHALL ALSO BE RESTORED IN A SMOOTH, GRADED AND DRAINABLE CONDITION.
11. CONTRACTOR SHALL VERIFY ALL EXISTING PIPES, INLETS MANHOLE INVERTS AND ALL OTHER ELEVATIONS FOR TIE IN TO PROPOSED PAVEMENT TO EXISTING PAVEMENT.
12. WORK WITHIN OBJECT FREE AREAS AND SAFETY AREAS SHALL BE COORDINATED WITH AIRPORT AUTHORITY FOR APPROPRIATE CLOSURE LIMITS AND DATES TO OPTIMIZE AIRPORT OPERATIONS.
13. PLACEMENT OF SALVAGED TOPSOIL WILL BE PAID UNDER "SELECT TOPSOIL BORROW (SALVAGED)"
14. **IF THE CONTRACTOR ENCOUNTERS SAND MATERIAL NOT SUITABLE FOR REUSE, THE MATERIAL MUST REMAIN ONSITE. THE CONTRACTOR SHALL PLACE THE MATERIALS IN THE CONTRACTOR STORAGE AREA AND GRADE TO DRAIN FOR RESTORATION.**

GEOMETRIC CONTROL NOTES:

1. COORDINATES SHOWN ARE BASED ON THE ST. LOUIS COUNTY COORDINATE SYSTEM. PACS/SACS CONTROL INFORMATION AT THE AIRPORT WILL BE PROVIDED TO THE CONTRACTOR TO SET PROJECT CONTROL SHOWN ON SHEET G3.00.
2. CONTRACTOR SHALL FIELD VERIFY ALL ELEVATIONS FOR TIE IN OF PROPOSED PAVEMENT TO EXISTING PAVEMENT.

GRADING NOTES:

1. THE CONTRACTOR SHALL BE RESPONSIBLE FOR KEEPING THE PUBLIC STREETS AND ACCESS ROUTES IN THE VICINITY OF THE JOB SITE CLEAN AND FREE OF ROCKS, SOILS AND DEBRIS. SWEEP DAILY AROUND ALL CONSTRUCTION LIMITS AND WITHIN 3 HOURS OF NOTICE BY ENGINEER.
2. THE CONTRACTOR IS RESPONSIBLE FOR THE PROTECTION OF ALL CONTROL POINTS. ANY CONTROL POINTS DISTURBED OR DAMAGED BY GRADING ACTIVITIES SHALL BE RESET BY A PROFESSIONAL LAND SURVEYOR LICENSED IN THE STATE OF MINNESOTA, AT THE CONTRACTOR'S EXPENSE.
3. THE CONTRACTOR SHALL BE RESPONSIBLE FOR CONTROLLING DOWNSTREAM EROSION AND SILTATION DURING ALL PHASES OF CONSTRUCTION. EROSION CONTROL MEASURES SHALL BE IN PLACE PRIOR TO BEGINNING SOIL DISTURBANCE ACTIVITIES.
4. NUMEROUS EROSION CONTROL FEATURES MAY EXIST ON THE PROJECT SITE. CONTRACTOR SHALL KEEP AS MANY OF THOSE FEATURES IN PLACE AS POSSIBLE, UNTIL THE SITE IS STABILIZED.

EARTHWORK SUMMARY & NOTES:

EXCAVATION SHALL BE DEFINED AS FOLLOWS:

COMMON EXCAVATION = ALL AREAS REQUIRING EXCAVATION TO MEET PROPOSED ELEVATION.

UNCLASSIFIED EXCAVATION = ADDITIONAL AREAS BELOW PROPOSED SUBGRADE NOT MEETING COMPACTION SPECIFICATIONS AND NEED TO BE REMOVED AND REPLACED.

BORROW EXCAVATION = ALL AREAS REQUIRED BORROW MATERIAL TO BE BROUGHT IN TO MEET PROPOSED ELEVATIONS.

1.00 CY (EV) = 1.15 CY (LV)
1.00 CY (CV) = 1.30 CY (LV)
1.00 CY (CV) AGGREGATE BASE, CLASS 5 = 1.8 TONS



I HEREBY CERTIFY THAT THIS PLAN,
SPECIFICATION, OR REPORT WAS PREPARED
BY ME OR UNDER MY DIRECT SUPERVISION
AND THAT I AM A DULY LICENSED
PROFESSIONAL ENGINEER UNDER THE LAWS
OF THE STATE OF MINNESOTA.


RYAN FALCH, PE



SKY HARBOR AIRPORT
2023 RECONSTRUCT TERMINAL BUILDING

DULUTH, MN

This drawing is an instrument of service and shall remain the property of Short Elliott Hendrickson, Inc. (SEH). This drawing, concepts and ideas contained herein shall not be used, reproduced, revised, or retained without the express written approval of SEH.

COPYRIGHT © 2023
Short Elliott Hendrickson, Inc.
All Rights Reserved


SEH Project	DULAI_17213
Checked By	R
Drawn By	AL

Project Status	Issue Date
CONSTRUCTION	05/17/202
PLANS	

REVISION SCHEDULE		
REV. #	DESCRIPTION	DATE
1	ADDENDUM #2	6/2/2023

GRADING PLAN

C5.00

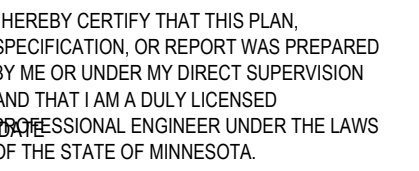


DULUTH, MN

COPYRIGHT © 2023
Short Elliott Hendrickson, Inc.
All Rights Reserved


DULAI_17213
R
AL

Issue Date
05/17/202

REV. #	DESCRIPTION	DATE
1	ADDENDUM #2	6/2/2023


C5.01

S:\proj\2023\11-07-AM_Victorowski_Plot_6/2/2023_11:36 AM_X:\EID\DLA\172133-5-final.dgn(5-drawings)25-Plant\ADYT-172133_LA.dwg

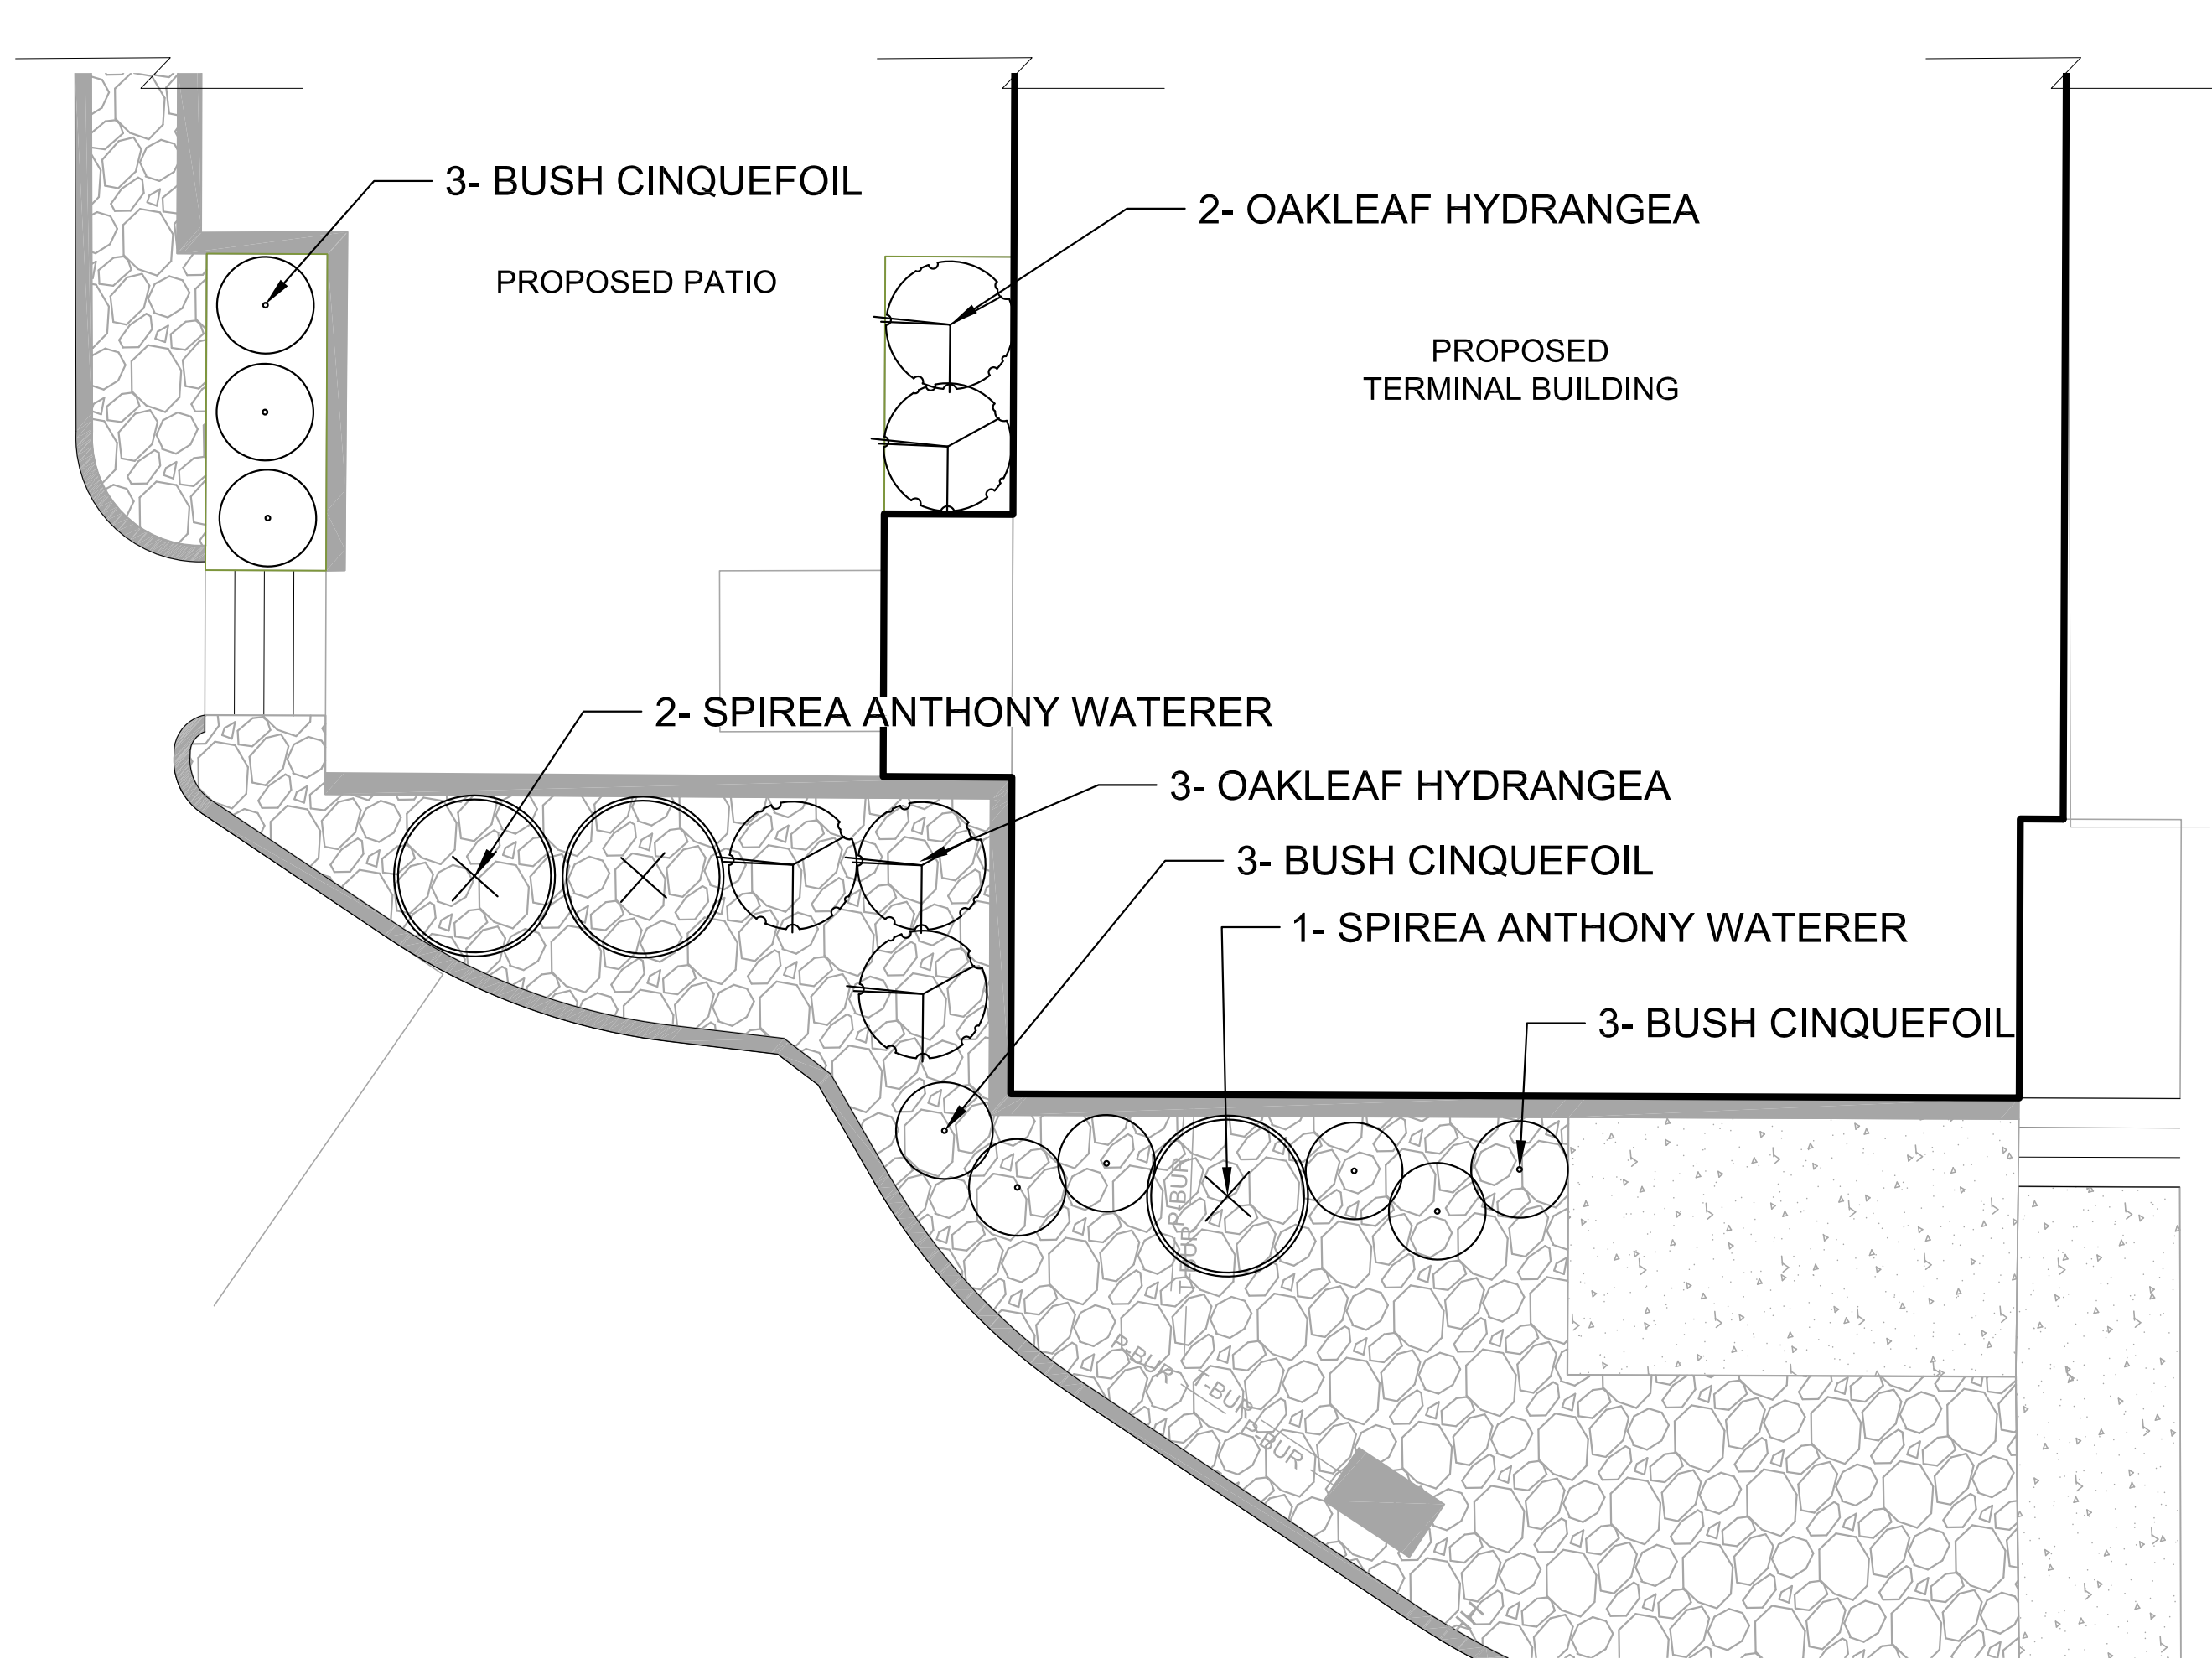

LANDSCAPE PLAN

Plant Schedule			
QTY	Common Name	Botanical Name	Size
9	Bush Cinquefoil	<i>Potentilla fruticosa</i>	5 Gal. Cont.
5	Oakleaf Hydrangea	<i>Hydrangea quercifolia</i>	5 Gal. Cont.
3	Spirea Anthony Waterer	<i>Spirea x bumalda</i> 'Anthony Waterer'	5 Gal. Cont.

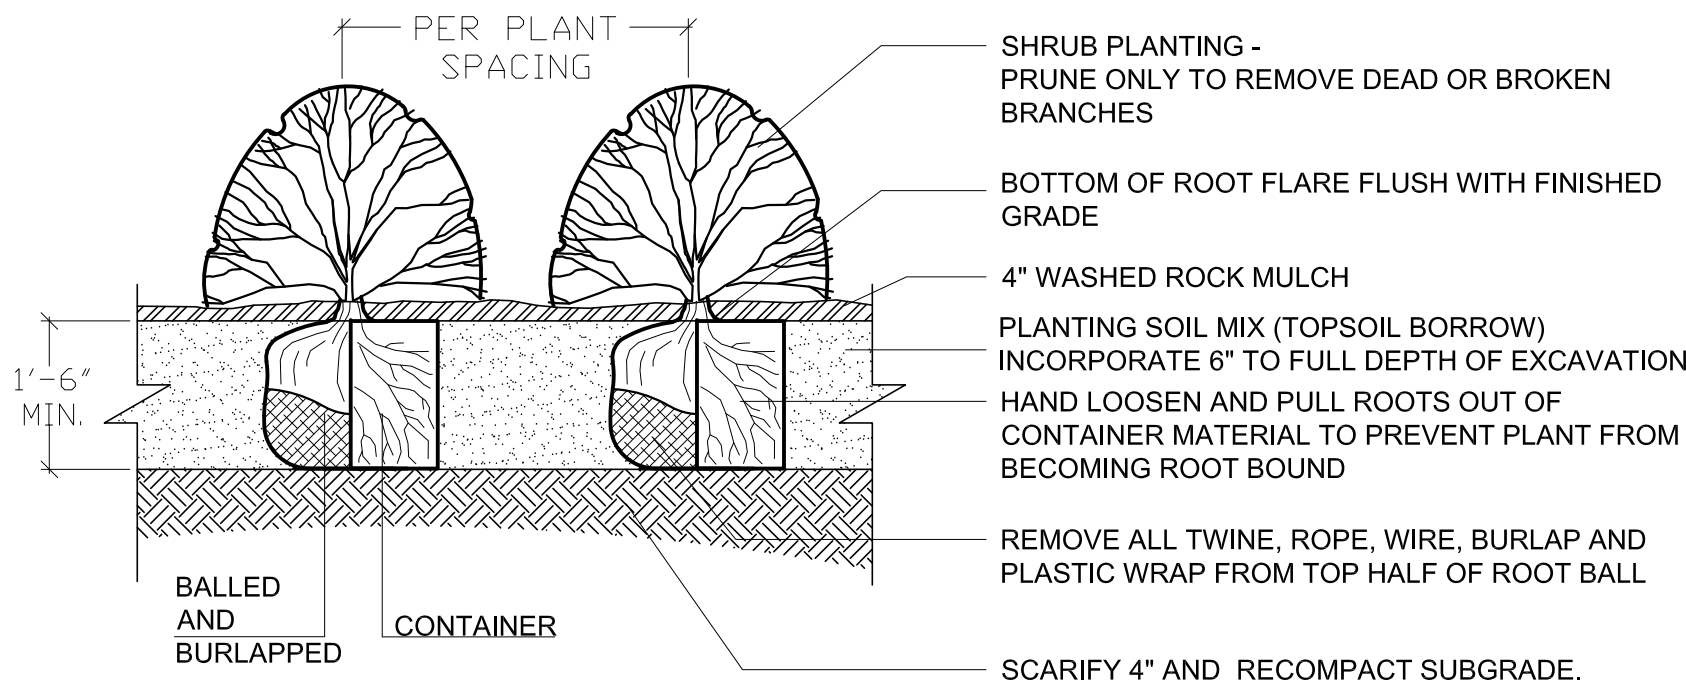

SHRUB PLANTING DETAIL
NOT TO SCALE

LANDSCAPE SPECIFICATIONS

- TREES, SHRUBS, AND PERENNIALS
- REFERENCES
 - MNDOT - MINESOTA DEPARTMENT OF TRANSPORTATION, 2020 EDITION.
 - AMERICAN STANDARD FOR NURSERY STOCK, ANSI Z60.1-2014.
 - QUALITY ASSURANCE
 - WORK SHALL BE PERFORMED BY A LANDSCAPE CONTRACTOR WITH EXTENSIVE HORTICULTURE KNOWLEDGE, AND A MIN. OF 3 YEARS EXPERIENCE.
 - HANDLE PLANTS IN SUCH A WAY AS TO PROTECT FROM DAMAGE EITHER PHYSICAL OR BY EXPOSURE TO SUN AND WIND. MISHANDLED PLANTS ARE SUBJECT TO REJECTION BY LANDSCAPE ARCHITECT.
 - PLANTS USED ON THIS PROJECT SHALL MEET THE GRADING STANDARDS RECOMMENDED BY THE ANSI Z60.1-2014.
 - PRODUCTS
 - PLANTS: PROVIDE AS SPECIFIED ON PLANT SCHEDULE.
 - EDGING: RYERSON STEEL EDGING $\frac{3}{8}$ " X 5" W/ 18" STAKES, OR EQUAL.
 - MULCH: WASHED ROCK MULCH, COLOR AS APPROVED BY THE LANDSCAPE ARCHITECT.
 - WATER: CONTRACTOR TO PROVIDE.
 - PLANTING SOIL MIX: RICH SANDY LOAM, FREE OF DEBRIS AND SEEDS, AND CONFORMING TO MNDOT 3877 (TOPSOIL MATERIAL).
 - SOIL AMENDMENTS: CONFORMING TO MNDOT 3877 (TOPSOIL MATERIAL) AND ALL OTHER APPLICABLE MNDOT MATERIALS AND CONSTRUCTION REQUIREMENTS.
 - PLANTING DATES: SPRING PLANTING: APR. 1- JUNE 15. THESE DATES MAY BE EXTENDED IF DAYTIME TEMPS. REMAIN BELOW 80 DEGREES. FALL: SEPT. 30 - OCT. 30TH. DAYTIME TEMPS. NEED TO DROP BELOW 80 DEGREES BEFORE PLANTING BEGINS, AND MAY CONTINUE UNTIL FREEZE UP. CONIFEROUS TREES AUG.15- OCT. 1ST. PLANT UNDER FAVORABLE WEATHER CONDITIONS. DO NO PLANT DURING DAYS OF EXTREME HEAT.
 - EXECUTION
 - PLANT INTO PREPARED PLANTING BEDS.
 - PRIOR TO DIGGING, CONTRACTOR TO HAVE UTILITIES LOCATED AND MARKED.
 - CONTRACTOR TO NOTIFY LANDSCAPE ARCHITECT 3 DAYS IN ADVANCE OF WHEN PLANTING WORK WILL OCCUR.
 - INSTALL SHRUBS PER PLANTING DETAILS, ADJUST LOCATION IF IN CONFLICT WITH UTILITIES. VERIFY NEW LOCATION WITH LANDSCAPE ARCHITECT PRIOR TO PLANTING.
 - SEPARATE ALL SHRUB BEDS FROM SOD AREAS WITH METAL EDGER.
 - CLEAN-UP ENTIRE SITE FOLLOWING PLANTING OPERATIONS.
 - ACCEPTANCE OF PLANTING WORK
 - CONTRACTOR TO NOTIFY OWNER WHEN PLANTING WORK IS COMPLETE FOR REVIEW AND PUNCH LIST.
 - CONTRACTOR TO WATER AND MAINTAIN THE SHRUBS UNTIL OWNER ACCEPTANCE.
 - OWNER WILL GIVE ACCEPTANCE OF WORK, FOLLOWING SATISFACTORY CORRECTION OF PUNCH LIST ITEMS.
 - WATERING AND REGULAR LANDSCAPE MAINTENANCE OF SHRUBS WILL BE OWNERS RESPONSIBILITY FOLLOWING OWNER ACCEPTANCE OF WORK.
 - GUARANTEE PERIOD
 - CONTRACTOR TO WARRANTY SHRUBS FOR TWO YEARS FOLLOWING ACCEPTANCE OF WORK BY OWNER.
 - REPLACEMENTS: AT THE END OF THE GUARANTEE PERIOD, ALL PLANTS WHICH ARE UNHEALTHY, DEAD, NOT HAVING A NORMAL DENSITY, SIZE, SHAPE OR COLOR SHALL BE REPLACED. REPLACEMENTS SHALL MATCH CALIPER AND/OR HEIGHT OF THE OTHER PLANTS AT TIME OF REPLACEMENT. SELECTION OF REPLACEMENT MATERIAL AND INSTALLATION PRACTICES SHALL FOLLOW THE REQUIREMENTS OF THE DRAWINGS AND SPECIFICATIONS.



I HEREBY CERTIFY THAT THIS PLAN, SPECIFICATION, OR REPORT WAS PREPARED BY ME OR UNDER MY DIRECT SUPERVISION AND THAT I AM A DULY LICENSED PROFESSIONAL ENGINEER UNDER THE LAWS OF THE STATE OF MINNESOTA.

Ryan Falch
RYAN FALCH, PE
05/17/2023 LICENSE NO. 60494



SKY HARBOR AIRPORT
2023 RECONSTRUCT TERMINAL BUILDING
DULUTH, MN

This drawing is an instrument of service and shall remain the property of Short Elliott Hendrickson, Inc. (SEH). This drawing, concepts and ideas contained herein shall not be used, reproduced, revised, or related without the express written approval of SEH.

Substitution or distribution of this drawing to meet official or regulatory requirements or for purposes in connection with the project is not to be construed as publication in derogation of any of the rights of SEH.

SEH Project
Checked By
Drawn By
DULAI_172133
KW
VT

Project Status
CONSTRUCTION
PLANS
Issue Date
05/17/2023

REVISION SCHEDULE		
REV. #	DESCRIPTION	DATE
1	ADDENDUM #2	6/2/2023

LANDSCAPE PLAN

C5.03

ARCHITECTURE SYMBOLS LEGEND

	BUILDING SECTION CUT		ROOM OPENING NUMBER
	WALL SECTION CUT		ROOM NAME ROOM NUMBER
	DETAIL CUT		NEW DOOR
	DETAIL AREA		WINDOW TYPE
	ENLARGED PLAN		VERTICAL HEIGHT IDENTIFIER
	ELEVATIONS		REVISION TAG WITH CLOUD
	NORTH ARROW		
	WALL TYPES		
	CONSTRUCTION KEY NOTE		


MATERIALS LEGEND

	BRICK / STONE VENEER
	C.I.P. CONCRETE OR PRECAST CONCRETE
	GROUT
	CONCRETE MASONRY UNIT
	EARTH
	EXISTING
	GRANULAR FILL
	GYPSUM BOARD
	INSULATION - BATT
	INSULATION - RIGID
	INSULATION - SPRAYED
	METAL
	PLYWOOD
	WOOD - FINISH
	WOOD - ROUGH

GENERAL NOTES


- ALL CONSTRUCTION SHALL BE ACCORDING TO STATE AND LOCAL CODES.
- ALL CONTRACTORS SHALL VERIFY EXISTING CONDITIONS AND NOTIFY THE ARCHITECT OF ANY DISCREPANCIES.
- ALL CONTRACTORS SHALL FAMILIARIZE THEMSELVES WITH THE CONSTRUCTION DOCUMENTS AND NOTIFY THE ARCHITECT OF ANY DISCREPANCIES.
- MECHANICAL AND ELECTRICAL PLANS ARE DIAGRAMMATIC ONLY. CROSS-REFERENCE ARCHITECTURAL DRAWINGS WITH STRUCTURAL, MECHANICAL AND ELECTRICAL DRAWINGS TO ASSURE COORDINATION OF LOCATIONS, SIZES, AND MATERIALS.
- VERIFY LOCATION, SIZE AND WALL THICKNESS REQD TO RECESS MECHANICAL AND ELECTRICAL ITEMS AND MAINTAIN FIRE RATING REQ'S OF THE WALL AT THESE BUILT-INS: UNIT HEATERS, CONVECTORS, ELECTRICAL PANELS, FIRE EXTINGUISHER CABINETS, DUCTS, PIPING, AND ALL OTHER SUCH RECESSES.
- VERIFY ELEVATION OF ALL FLOOR SLAB DEPRESSIONS TO RECEIVE FLOOR MATERIAL PER FINISH SCHEDULE REQUIRED AND DETAILS.
- EXTEND ALL NONBEARING GYPSUM BOARD PARTITIONS TO UNDERSIDE OF STRUCTURE OR DECK
- MAINTAIN BUILDING FIRE EXITS DURING CONSTRUCTION.
- PROVIDE BLOCKING IN GYP BD. PARTITIONS AS REQD.
- DO NOT SCALE DRAWINGS FOR DIMENSIONS

TYPICAL MOUNTING HEIGHTS

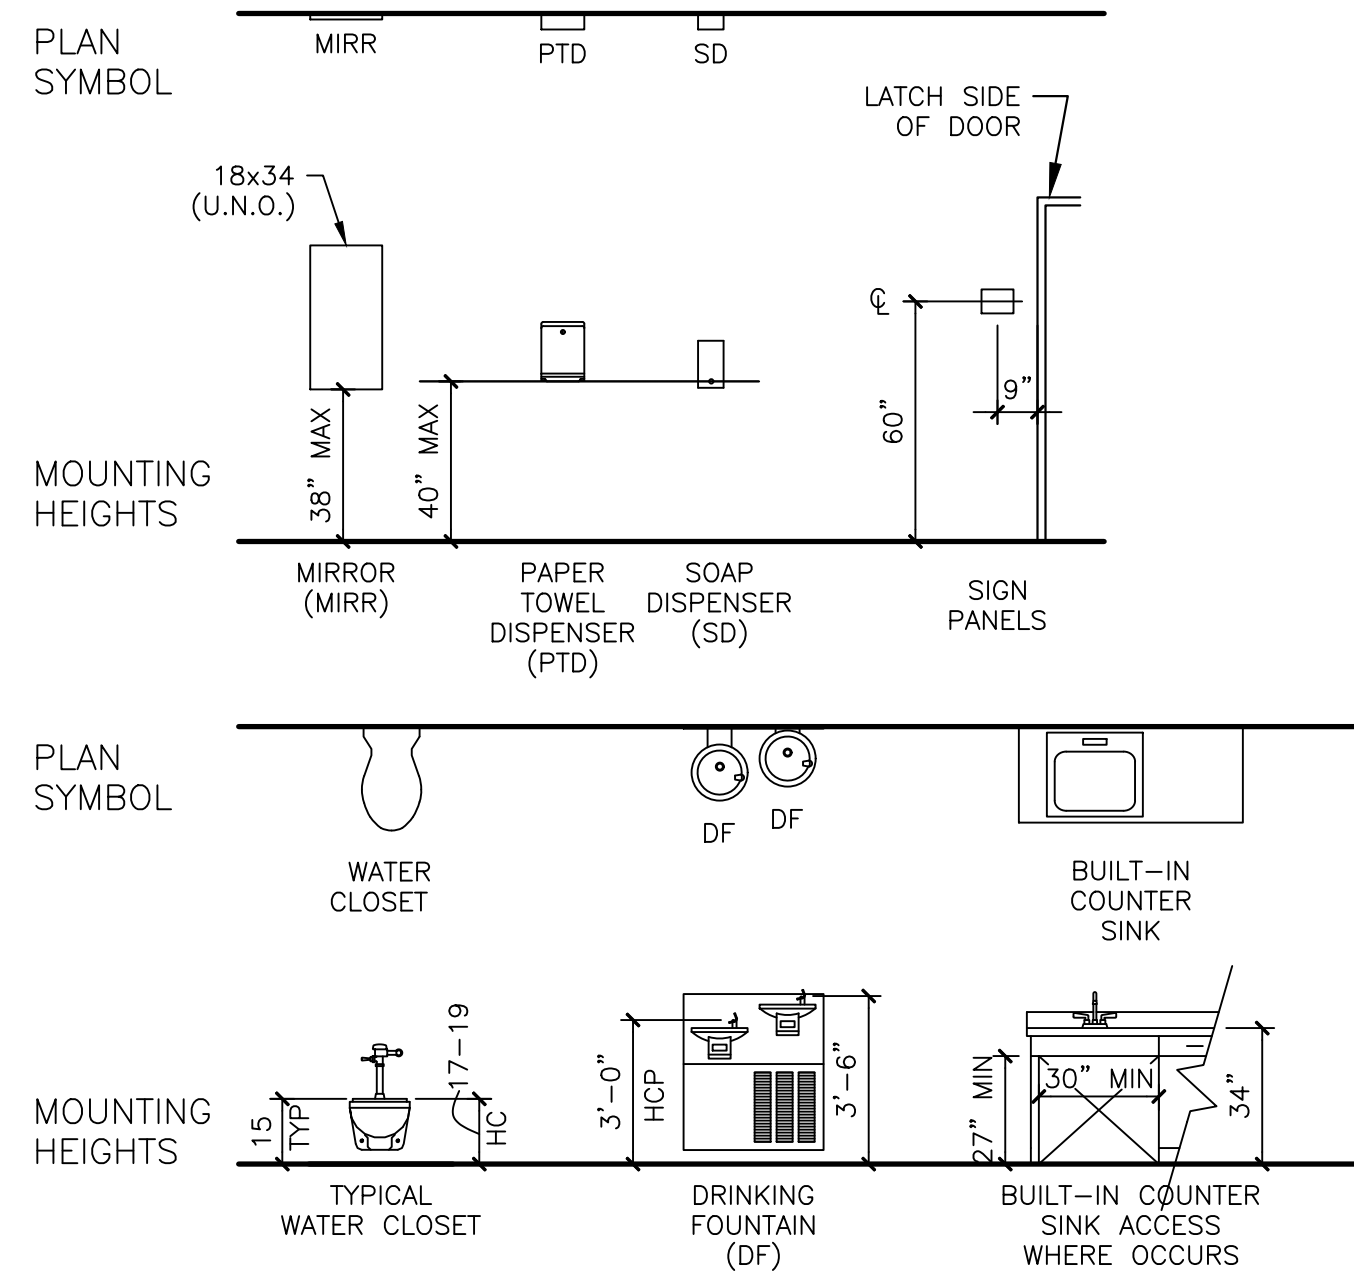

STANDARD ABBREVIATIONS

AFF	ABOVE FINISH FLOOR	DWS	DOWELS	HORIZ	HORIZONTAL	PT	PAINT	TS	TACK STRIP
AP	ACCESS PANEL	DN	DOWN	HC	HANDICAPPED	PNL	PANEL OR PANELING	TVL	TOP OF VENEER LEDGE
ADJ	ADJUSTABLE	DS	DOWNSPOUT	H	HARDENER	PTD	PAPER TOWEL DISPENSER	TEL	TELEPHONE
AGG	AGGREGATE	DWG	DRAWING	HR	HYDRANT	PTD/R	PAPER TOWEL DISPENSER & RECEPTOR	TV	TELEVISION
ALT	ALTERNATE	DF	DRINKING FOUNTAIN	IN	INCH			TEMP	TEMPERED, TEMPORARY
ALUM	ALUMINUM	DKG	DUCTILE IRON PIPE DECKING	ID	INSIDE DIAMETER	PART	PARTITION	TERR	TERRAZZO
ANCH	ANCHOR			IF	INSIDE FACE	P BD	PEG BOARD	TH	THRESHOLD
AB	ANCHOR BOLT	EA	EACH	INSUL	INSULATION	PERF	PERFORATED	TO	TOILET PAPER DISPENSER
APPROX	APPROXIMATE	EF	EACH FACE, EXHAUST FAN	INT	INTERIOR	PLAS	PLASTER	TLT PTN	TONGUE AND GROOVE
ARCH	ARCHITECT(URAL)	EWY	EACH WAY	INV	INVERT	PLAM	PLASTIC LAMINATE	T AND B	TOP AND BOTTOM
AS	ATTIC SCUTTLE	E	EAST			PL	PLATE	T AND B	TOP OF FOOTING ELEVATION
AV	AUDIO VISUAL	EL	ELEVATION	JAN	JANITOR	PL GL	PLATE GLASS	TO MAS	TOP OF MASONRY
ACQUST	ACOUSTICAL	ELEC	ELECTRIC(AL)	JT	JOINT	PLBG	PLUMBING	TOS	TOP OF STEEL
ADO	AUTOMATIC DOOR OPERATOR	EWC	ELECTRIC WATER COOLER	JST	JOIST	PLYWD	PLYWOOD	TB	TACK BOARD
		ELEV	ELEVATION (BLDG);	KP	KICK PLATE	POL	POLISHED	TF	TREAD
BCS	BABY CHANGING STATION	ENAM	ENAMEL	KD	KNOCK DOWN	PRE F	PREFINISHED	TS	TUBE STEEL
BLK	BLOCK	ENT	ENTRANCE	KO	KNOCK OUT	PROJ	PROJECTION	TYP	TYPICAL
BCMU	BURNISHED CONCRETE MASONRY UNIT	EQ	EQUAL			PVMT	PAVEMENT		
BD	BOARD	EQUIP	EQUIPMENT	LAB	LABORATORY	QT	QUARRY TILE	UNFIN	UNFINISHED
BOT	BOTTOM	ET	ET CETERA	LAM	LAMINATED			UH	UNIT HEATERS
BFE	BOTTOM FOOTING ELEVATION	EX	EXISTING	LAV	LAVATORY	RAD	RADIATION RADIATOR	UNO	UNIT VENTILATOR
BR	BRICK	EXJ	EXPANSION JOINT	LDR	LADDER	REINF CONC	REINFORCED CONCRETE	UNO	UNLESS NOTED OTHERWISE
BR C	BRICK COURSE	EXT	EXTERIOR	LIN	LINOLEUM	RWL	RAIN WATER LEADER	UNO	UNLESS OTHERWISE NOTED
BR L	BRICK LEDGE	EP	ELECTRICAL PANEL	LOC	LOCATE	REC	RECESSED	UR	URINAL
BLDG	BUILDING	EUH	ELECTRICAL UNIT HEATER	LLH	LONG LEG HORIZONTAL	REDWD	REDWOOD	UR SCR	URINAL SCREEN
B.O.	BY OWNER			LLV	LONG LEG VERTICAL	REFR	REFRIGERATOR		
B BO	BULLETIN BOARD	EW	EYE WASH STATION	LP	LOW POINT	REINF	REINFORCED(ING)	VAC	VACUUM
		FLRG	FLOORING	LB	POUND	REIN	REINFORCED(ING)	VB	VINYL BASE
CAB	CABINET	FB	FACE BRICK	LWCB	LIGHT WEIGHT CONC BLOCK	REM	RECESSED ENTRY MAT	VENT	VENTILATOR
CPT	CARPET	FAP	FIRE ALARM PANEL			REQD	REQUIRED	VERM	VERMICULITE
CSWK	CASEWORK	FIN	FINISH	MB	MARKER BOARD	RES	RESILIENT	V PLAS	VERMICULITE PLASTER
CI	CAST IRON	FR	FIRE RATED	MFR	MOP & BROOM HOLDER	RH	RIGHT HAND	VEST	VESTIBULE
CB	CEMENT BOARD	FIXT	FIXTURE	MAS	MASONRY	R	RISER OR RADIUS	VCT	VINYL COMPOSITE TILE
CBD	CORKBOARD	FHS	FLAT HEAD SCREW	MO	MASONRY OPENING	RD	ROOF DRAIN	VT	VINYL TILE
CLG	CORKBOARD	FTAS	FLOOR FINISH AS SCHEDULE	MATL	MATERIAL	RV	ROOF VENT	VTR	VENT THROUGH ROOF
CEM	CEMENT	FFE	FINISHED FLOOR ELEVATION	MAX	MAXIMUM	RM	ROOM	VWC	VINYL WALL COVERING
CL	CENTERLINE	FE	FIRE EXTINGUISHER	MECH	MECHANICAL	RO	ROUGH OPENING	VWF	VINYL WALL FABRIC
C TO C	CENTER TO CENTER	FT	FOOT, FEET	MLBX	MAIL BOX	RUB	RUBBER		
CT	CERAMIC TILE	FTG	FOOTING	MEMB	MEMBRANE	RT	RUBBER TILE OR TREAD	WSC	WAINSCOT
C BD	CHALK BOARD	FDN	FOUNDATION	MET	METAL	RS	ROUGH SLAB	WF	WALL FABRIC
CIRCT	CIRCUT (CIRCUMFERENCE)	FR	FRAME	MEZZ	MEZZANINE	RCP	ROLL DOWN CONCRETE PIPE	WC	WATER CLOSET
CO	CLEANOUT	FA	FRESH AIR	MIN	MINIMUM	RPS	ROLL DOWN PROJECTION SCREEN	WH	WATER HEATER
CLOS	CLOSET	FS	FULL SIZE	MIR	MIRROR	SCU	SCUPPER	WMP	WIRE MESH PARTITION
CH	CLOTHES HOOK	FURR	FURRING	M/S	MIRROR WITH SHELF	SCV	SCUPPER	WP	WATER PROOFING
CR	COLD ROLLED	FRMG	FRAMING	MISC	MISCELLANEOUS	SHLVG	SHELVING	WR	WATER RESISTANT
CP	COMMUNICATION PANEL	G BLK	GLASS BLOCK	MV	MISCELLANEOUS METAL	SNDU	SANITARY NAPKIN DISPOSAL UNIT	WS	WATER SOFTENER
CONC	CONCRETE	GPM	GALLONS PER MINUTE	MLDG	MOLDING	SF	SQUARE FOOT	WSP	WEATHERSTRIP
CONC BLK	CONCRETE BLOCK (STD)	GALV	GALVANIZED	MP	METAL PANEL	SCHED	SCHEDULE	WST	WEIGHT/WALL TILE
C BLK	CONCRETE BLOCK	MTG	MOUNTING			SILT	SILT	WWF	WELDED WIRE FABRIC
CMU	CONCRETE MASONRY UNIT	G	GAUGE	MULL	MULLION	SRC	SEAMLESS RESILIENT FLOOR	WF	WIDE FLANGE (STEEL)
CONSTR	CONSTRUCTION	GEN	GENERAL	MSU	METAL STORAGE UNIT	SECT	SECTION		
CJ	CONTROL JOINT	GC	GENERAL CONTRACTOR	MSC	METAL STORAGE CABINET	SS	SERVICE SINK	WDW	WINDOW
CONT	CONTINUOUS	GL	GLASS OR GLAZING	MPBC	MASTER PUSH BUTTON	SHT	SHEET	W/O	WITH OUT
CONV	CONVECTOR	GCMU	GLAZED CONCRETE MASONRY UNIT			SIM	SIMILAR	WG	WIRE GLASS
CG	CORNER GUARD	GB	GRAB BAR			SOG	SLAB ON GRADE	WD	WOOD
CMP	CORRUGATED METAL PIPE	GR	GRADE			SD	SOAP DISPENSER	WR	WASTE RECEPTACLE
CSK	COUNTER SINK	GRV	GRAVITY ROOF VENTILATOR			S	SOUTH OR SINK	YD	YARD
CS	COURSE	GYP BD	GYPSUM BOARD			SH	SHEATHING		
CU	CUBIC					ST	STONE		
CFM	CUBIC FOOT PER MINUTE					STD	STANDARD		
CUH	CABINET UNIT HEATER					STL	STEEL		
CORR	CORRUGATED-CORRIDOR					STR	STORAGE		
						STRUCT	STRUCTURAL		
DPG	DAMP-PROOFING					SA	SUPPLY AIR		
DEPT	DEPARTMENT					SUSP	SUSPENDED		
DET	DETAIL					SW	SWITCH		
DGB	DEMOUNTABLE GRAB BAR					SRCUH	SEMI-RECESSED CABINET		
DIA	DIAMETER						UNIT HEATER		
DIM	DIMENSION						SHELVING UNIT		
DISP	DISPENSER								
DO	DITTO								
DR	DOOR								

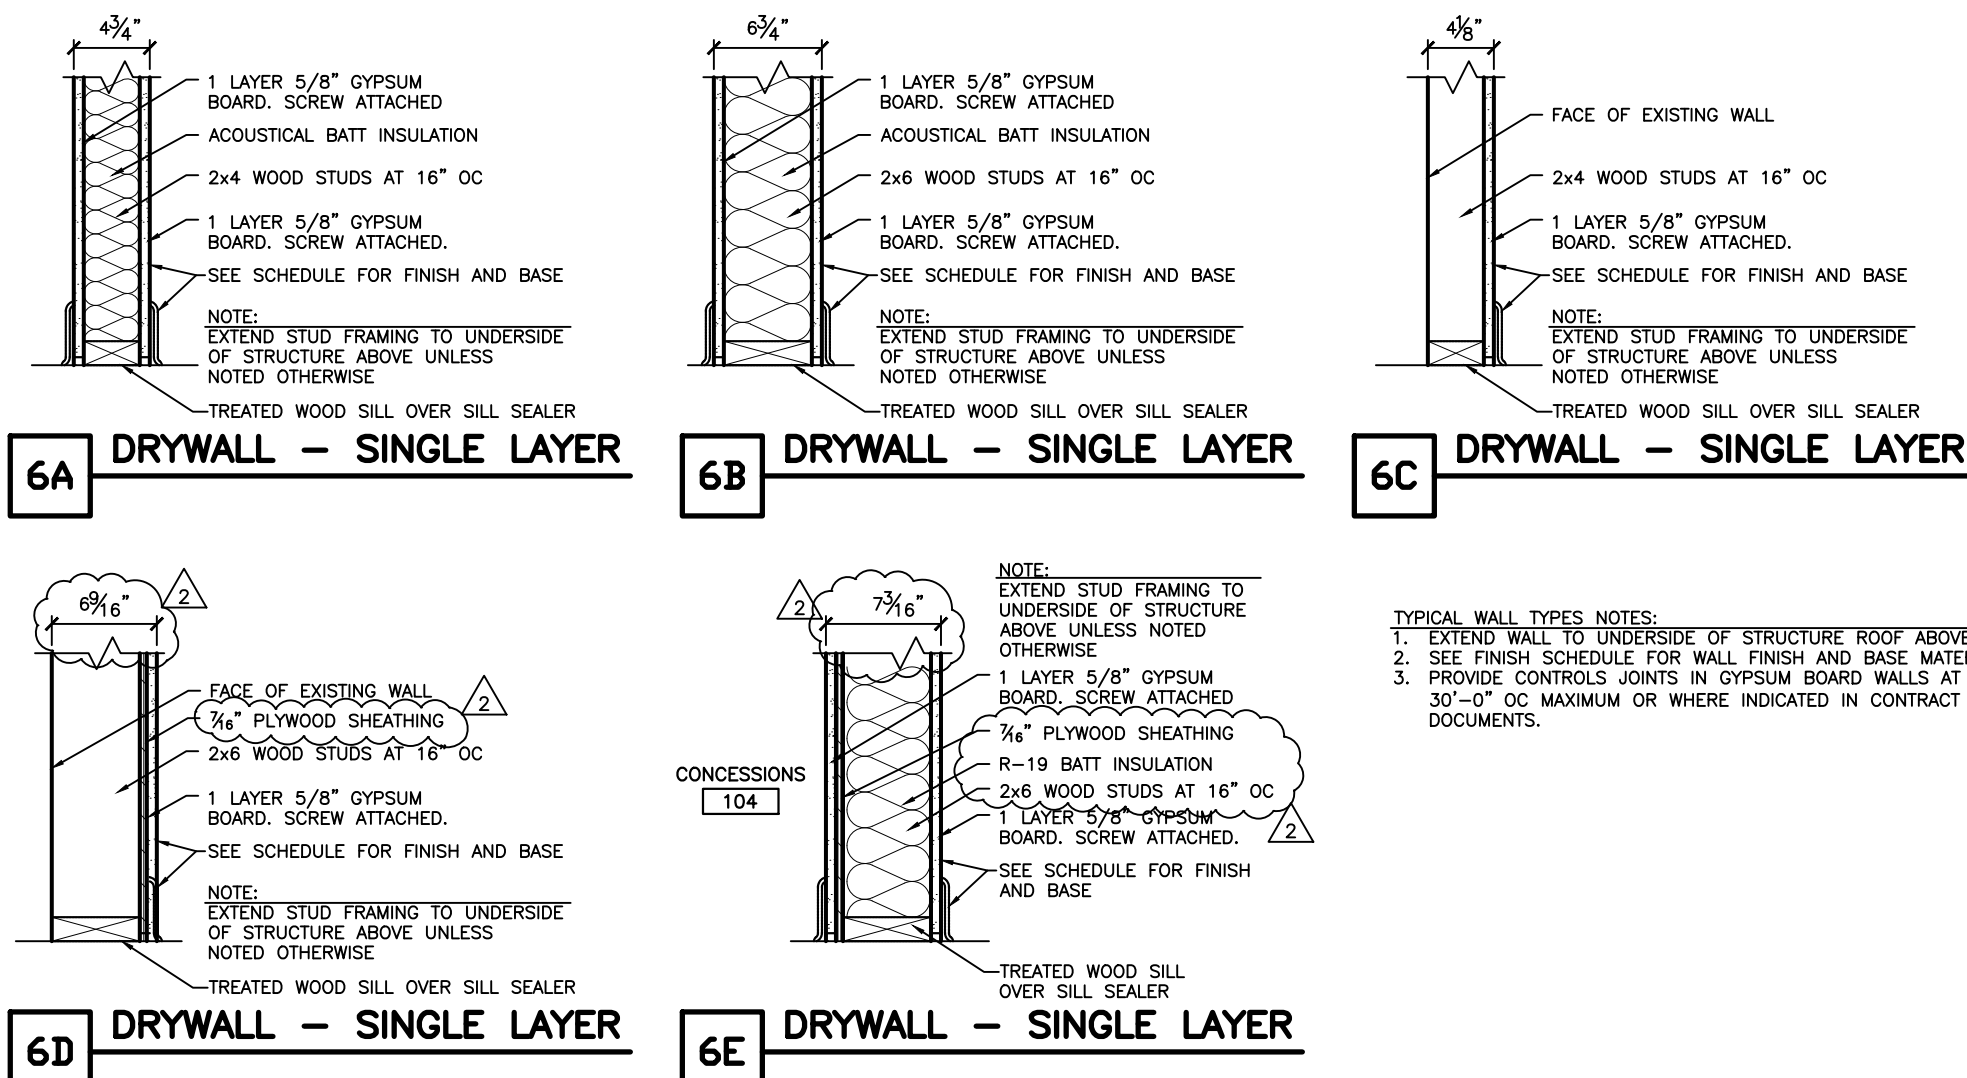

WALL TYPES

0 6" 1'-0" 1'-6"



I HEREBY CERTIFY THAT THIS PLAN, SPECIFICATION, OR REPORT WAS PREPARED BY ME OR UNDER MY DIRECT SUPERVISION AND THAT I AM A DULY LICENSED ARCHITECT UNDER THE LAWS OF THE STATE OF MINNESOTA.

DATE 5-16-2023 LICENSE NO. 51092



SKY HARBOR AIRPORT
2023 RECONSTRUCT TERMINAL BUILDING
DULUTH, MN

This drawing is an instrument of service and shall remain the property of Short Elliott Hendrickson, Inc. (SEH). This drawing, concepts and ideas contained herein shall not be used, reproduced, revised, or retained without the express written approval of SEH.

Submission or distribution of this drawing to meet official or regulatory requirements or for purposes in connection with the project is not to be construed as publication in derogation of any of the rights of SEH.

SEH Project Checked By Drawn By

Project Status Construction Plans

REVISION SCHEDULE

ARCHITECTURAL SYMBOLS, LEGEND, NOTES, WALL TYPES AND ACCESSIBILITY DETAILS

A003

DEMOLITION PLAN KEYNOTES:

- 1

REMOVE EXISTING CONCRETE FLOOR, METAL DECK AND BAR JOIST STRUCTURAL FRAMING
- 2

REMOVE EXISTING MASONRY BEARING WALLS WITH EXTERIOR FURRING, INSULATION, METAL SIDING AND WINDOWS
- 3

REMOVE EXISTING DOOR AND FRAME, PREP OPENING FOR NEW FRAME
- 4

EXISTING STEEL FRAME TO REMAIN
- 5

REMOVE EXISTING PLUMBING FIXTURES AND RESTROOM ACCESSORIES
- 6

REMOVE EXISTING SINK, SEE PLUMBING
- 7

REMOVE EXISTING CONCRETE FLOOR SLAB AND FOUNDATIONS
- 8

REMOVE EXISTING INTERIOR WOOD STUD AND GYPSUM BOARD WALL
- 9

REMOVE EXISTING PRE-ENGINEERED BUILDING FRAME, GIRTS, PURLINS, SIDING AND INSULATION
- 10

REMOVE EXISTING EXTERIOR METAL SIDING, PREP FOR REPLACEMENT SIDING INSTALLATION
- 11

REMOVE EXISTING METAL ROOFING PANELS, PREP FOR STANDING SEAM METAL ROOFING REPLACEMENT PANELS (INSULATION TO REMAIN)
- 12

REMOVE EXISTING WOOD STAIR AND GUARDRAIL
- 13

EXISTING CMU WALL TO REMAIN
- 14

EXISTING WOOD STUD WALL, SHEATHING AND INSULATION TO BE REMOVED
- 15

EXISTING WINDOW TO BE REMOVED
- 16

REMOVE EXISTING METAL PANEL CLADDING ON HANGAR DOOR, PREP DOOR FOR INSTALLATION OF NEW METAL CLADDING
- 17

REMOVE CONCRETE STOOP, FOUNDATION AND PAVEMENT
- 18

SAW CUT AND REMOVE PORTION OF EXISTING MASONRY WALL TO RAISE DOOR OPENING. PREP FOR STEEL LINTEL PER STRUCTURAL
- 19

REMOVE EXISTING FURRING AND GYPSUM BOARD TO EXPOSE EXISTING CMU WALL
- 20

DISCONNECT EXISTING ROOF BEAM FROM STEEL COLUMN, COLUMN TO REMAIN
- 21




CUT EXISTING STEEL ROOF BEAM FLUSH WITH FACE OF STEEL COLUMN, COLUMN TO REMAIN
- 22

SAW CUT AND REMOVE PORTION OF EXISTING CONCRETE SLAB - THICKENED EDGE FOUNDATION TO REMAIN
- 23

SUPPORT EXISTING ROOF PURLIN PRIOR TO REMOVING STEEL MAINFRAME SUPPORT, COORDINATE WITH STRUCTURAL
- 24

REMOVE EXISTING INTERIOR FINISHES INCLUDING, BUT NOT LIMITED TO, FLOORING, CEILINGS, WALL FURRING AND GYPSUM BOARD, CASEWORK, AND TRIM
- 25

GRIND OR SAW CUT 2" DEEP DEPRESSION IN EXISTING CONCRETE SLAB FOR SLOPED RAMP

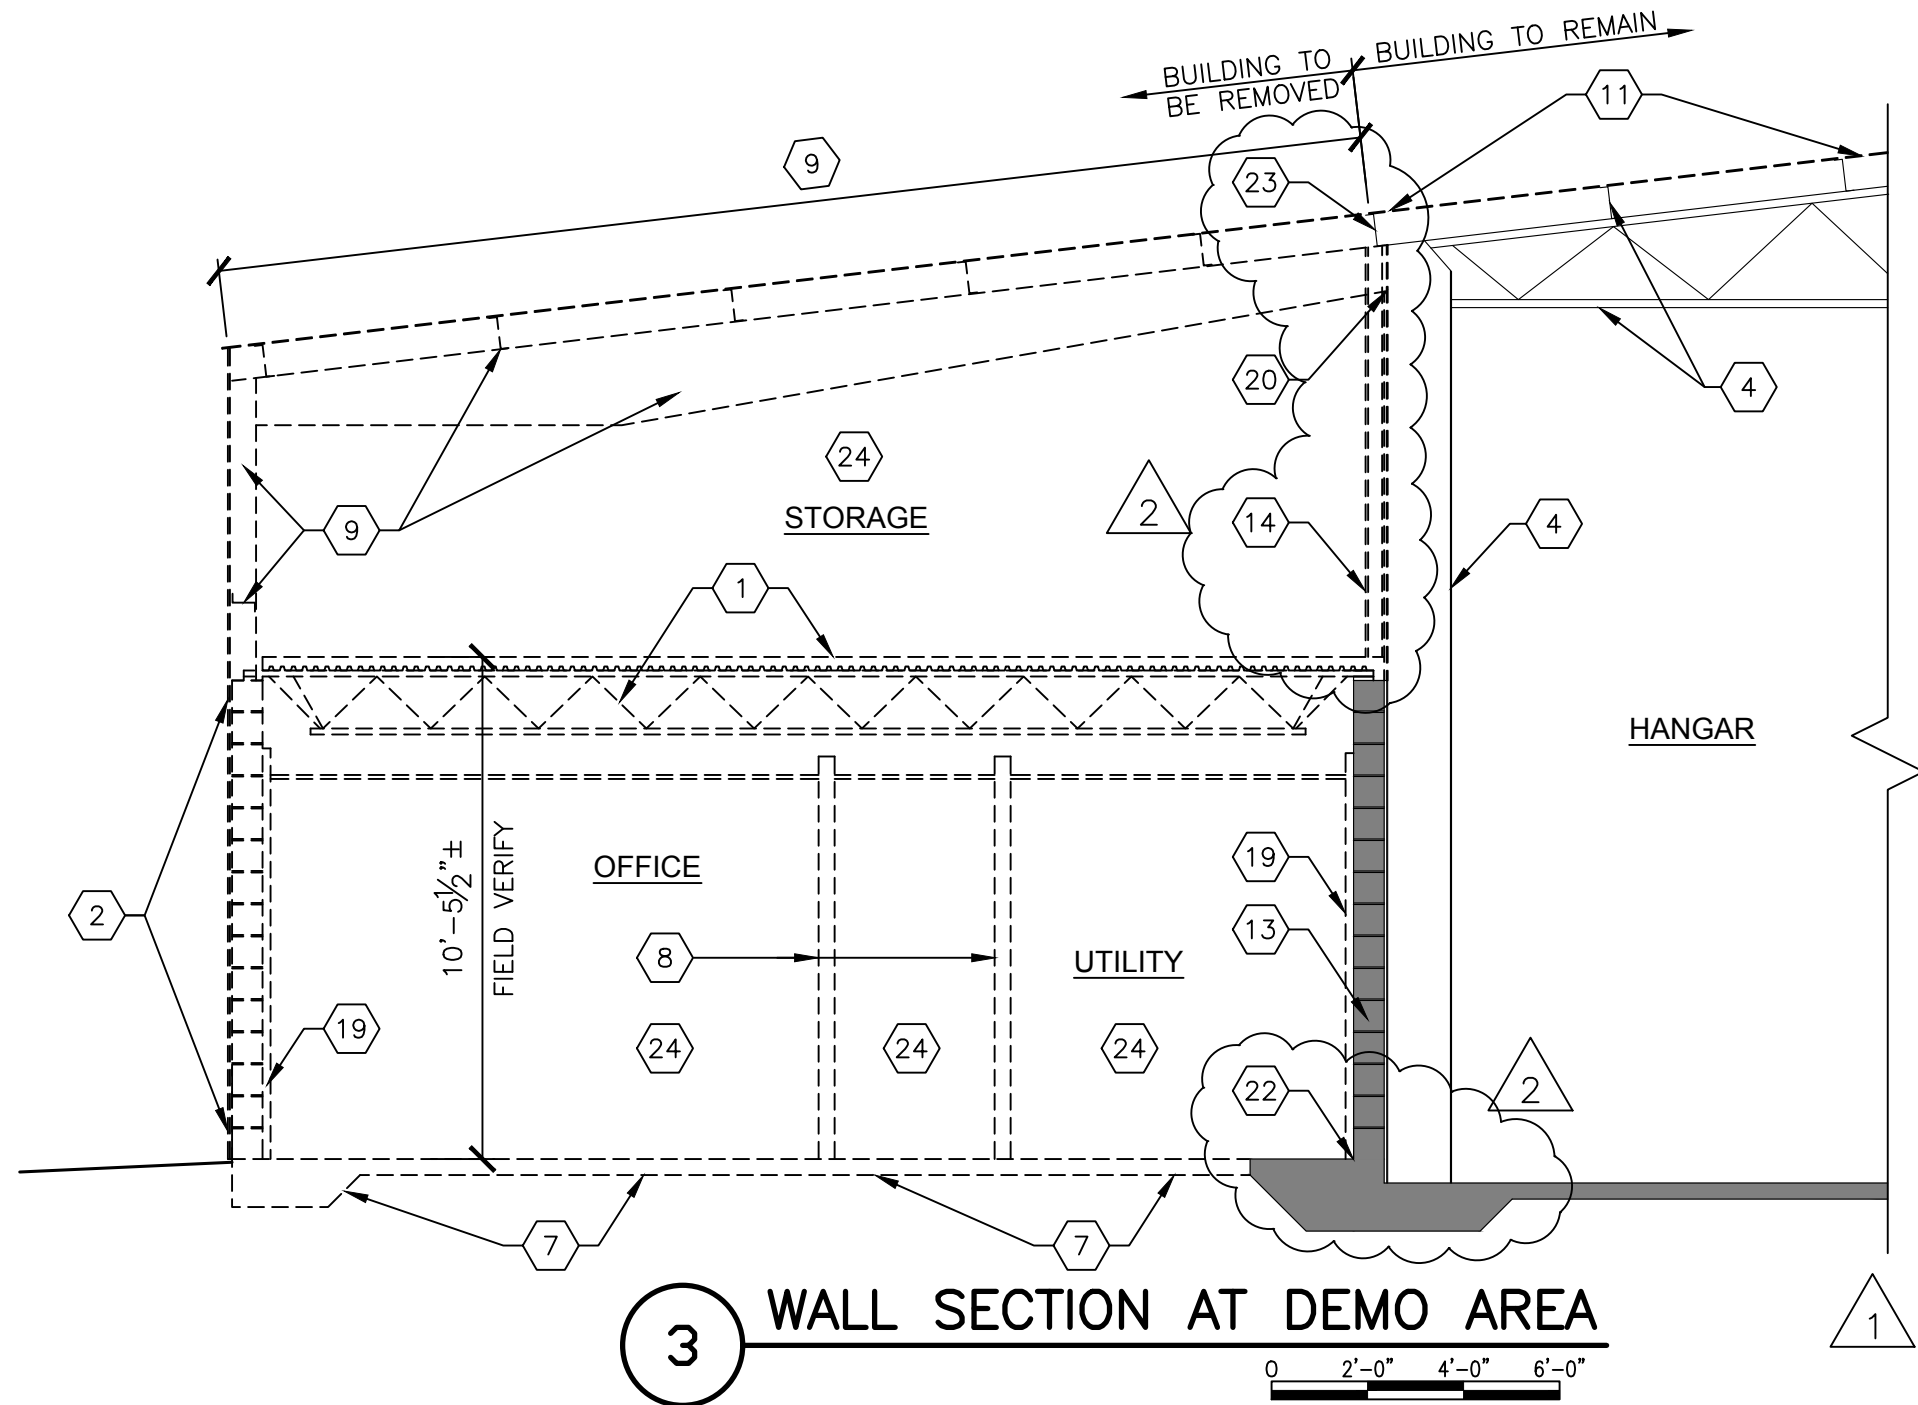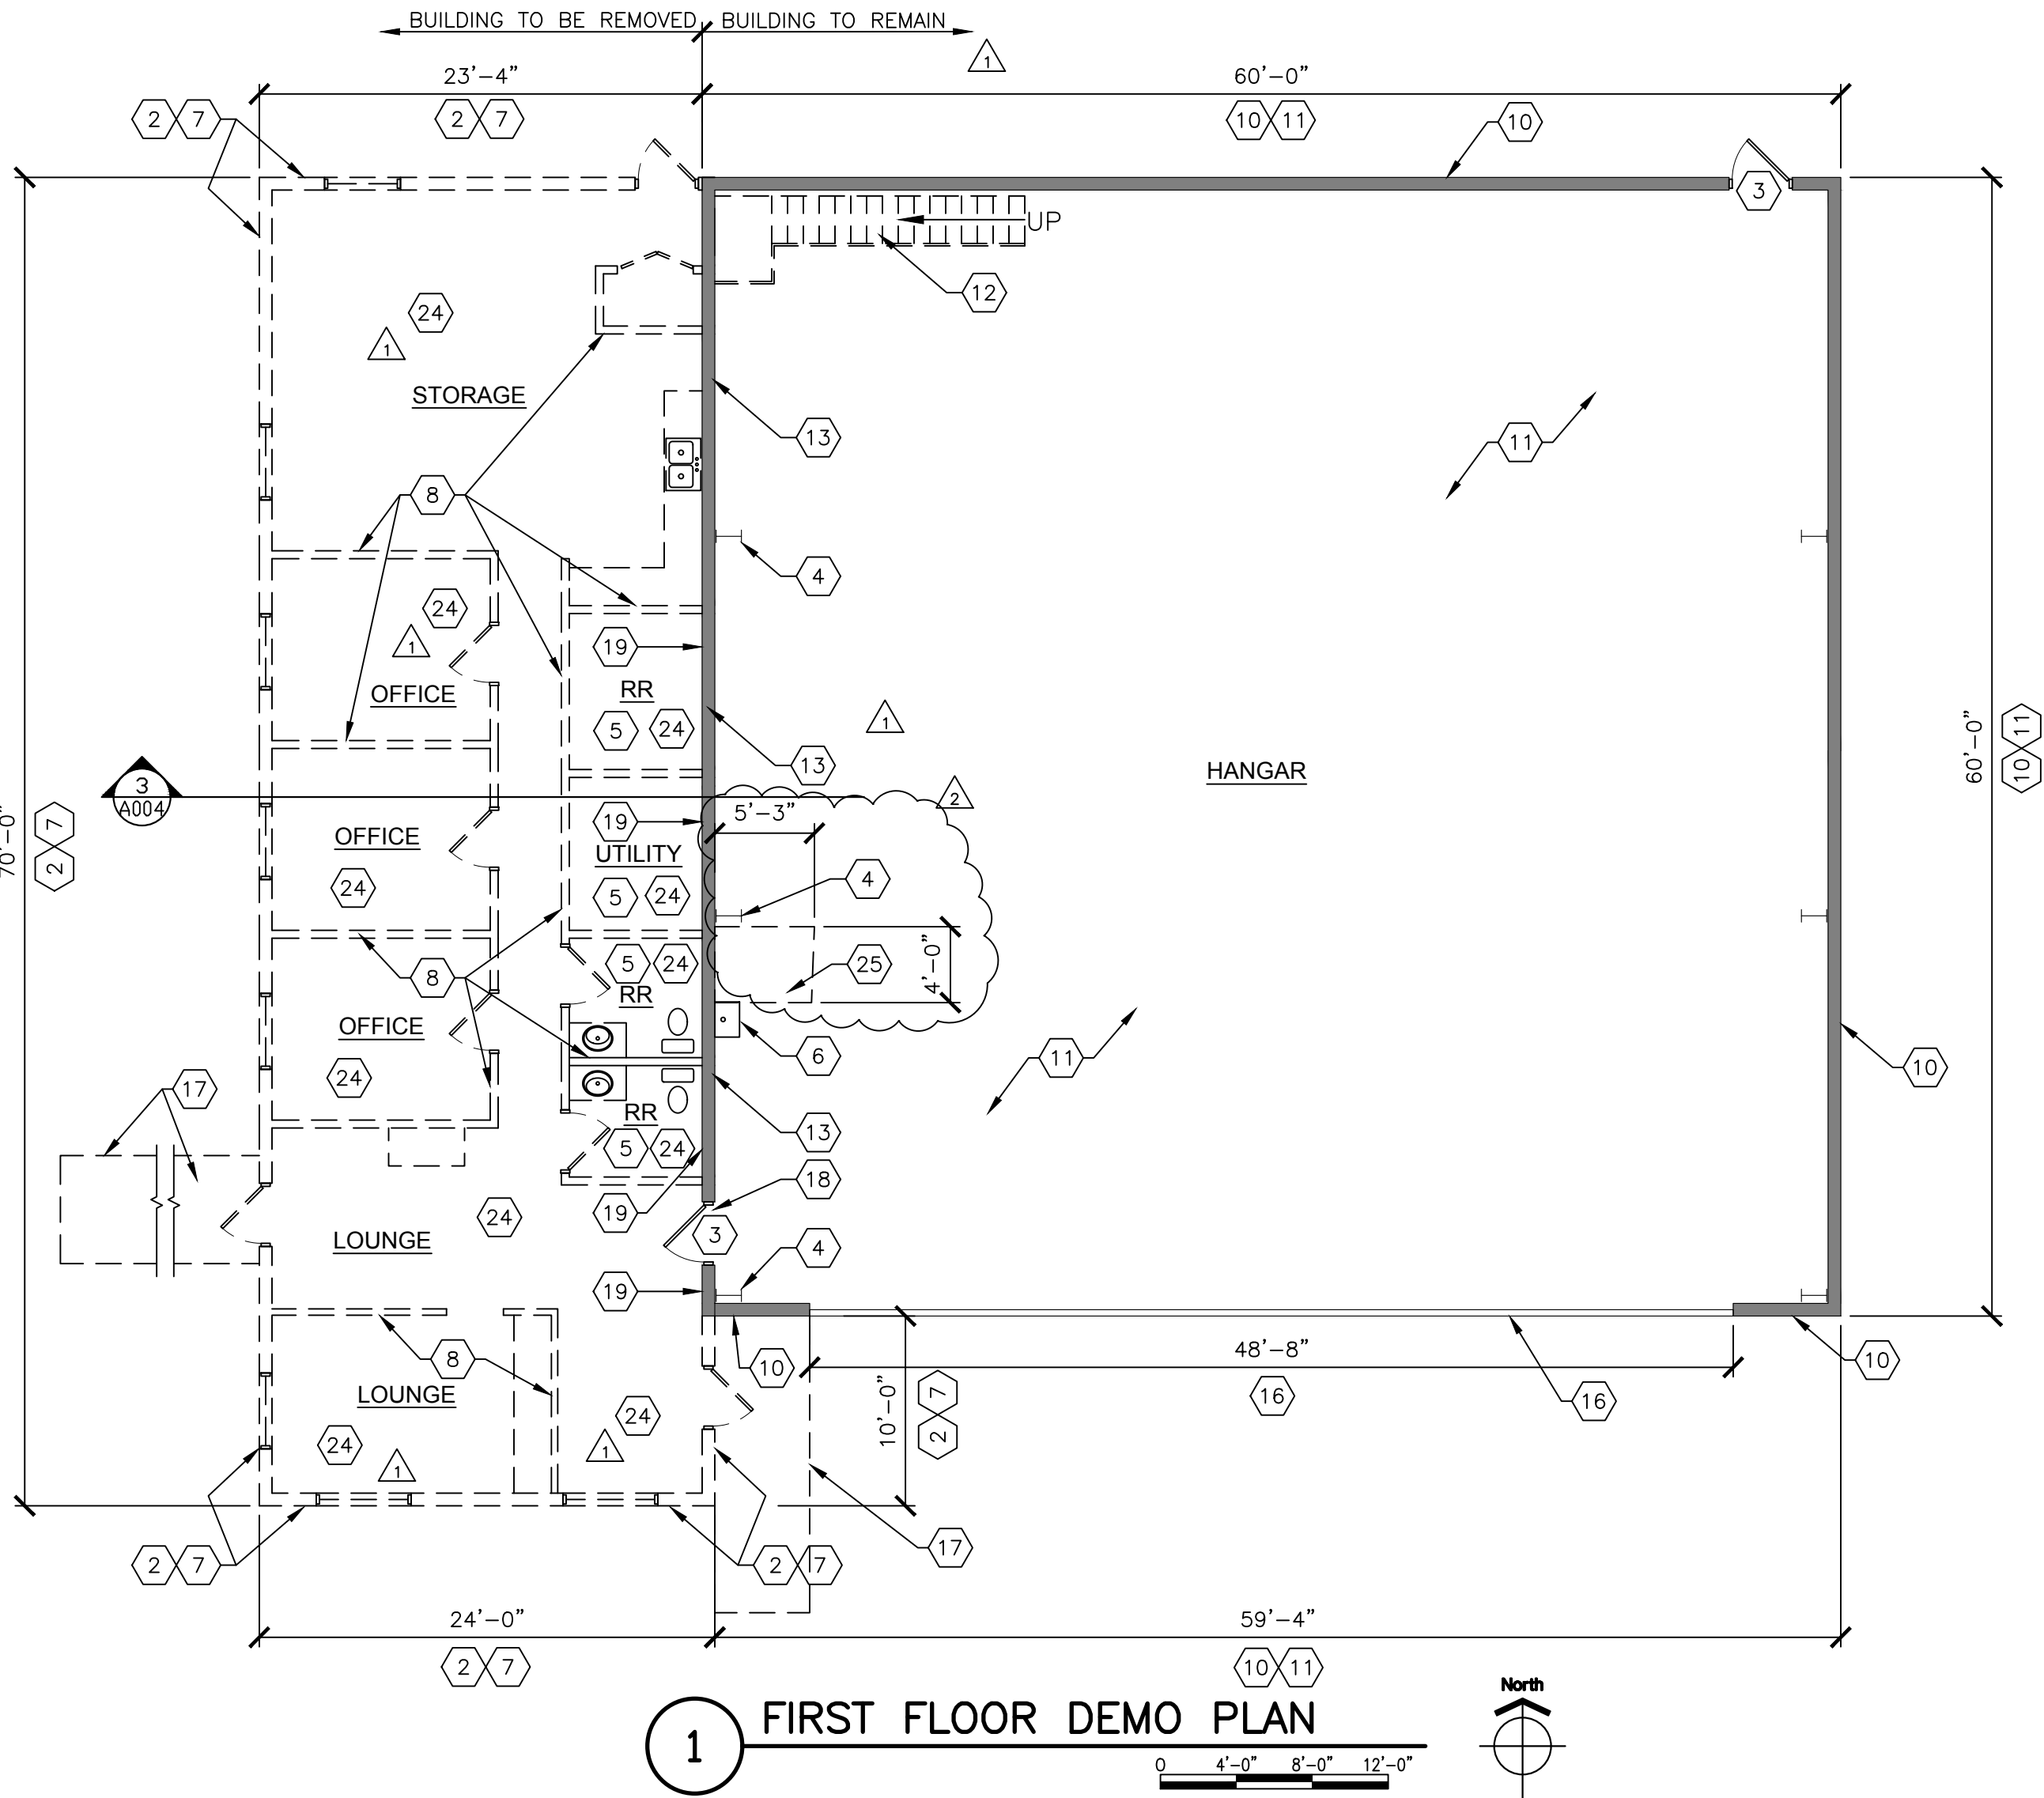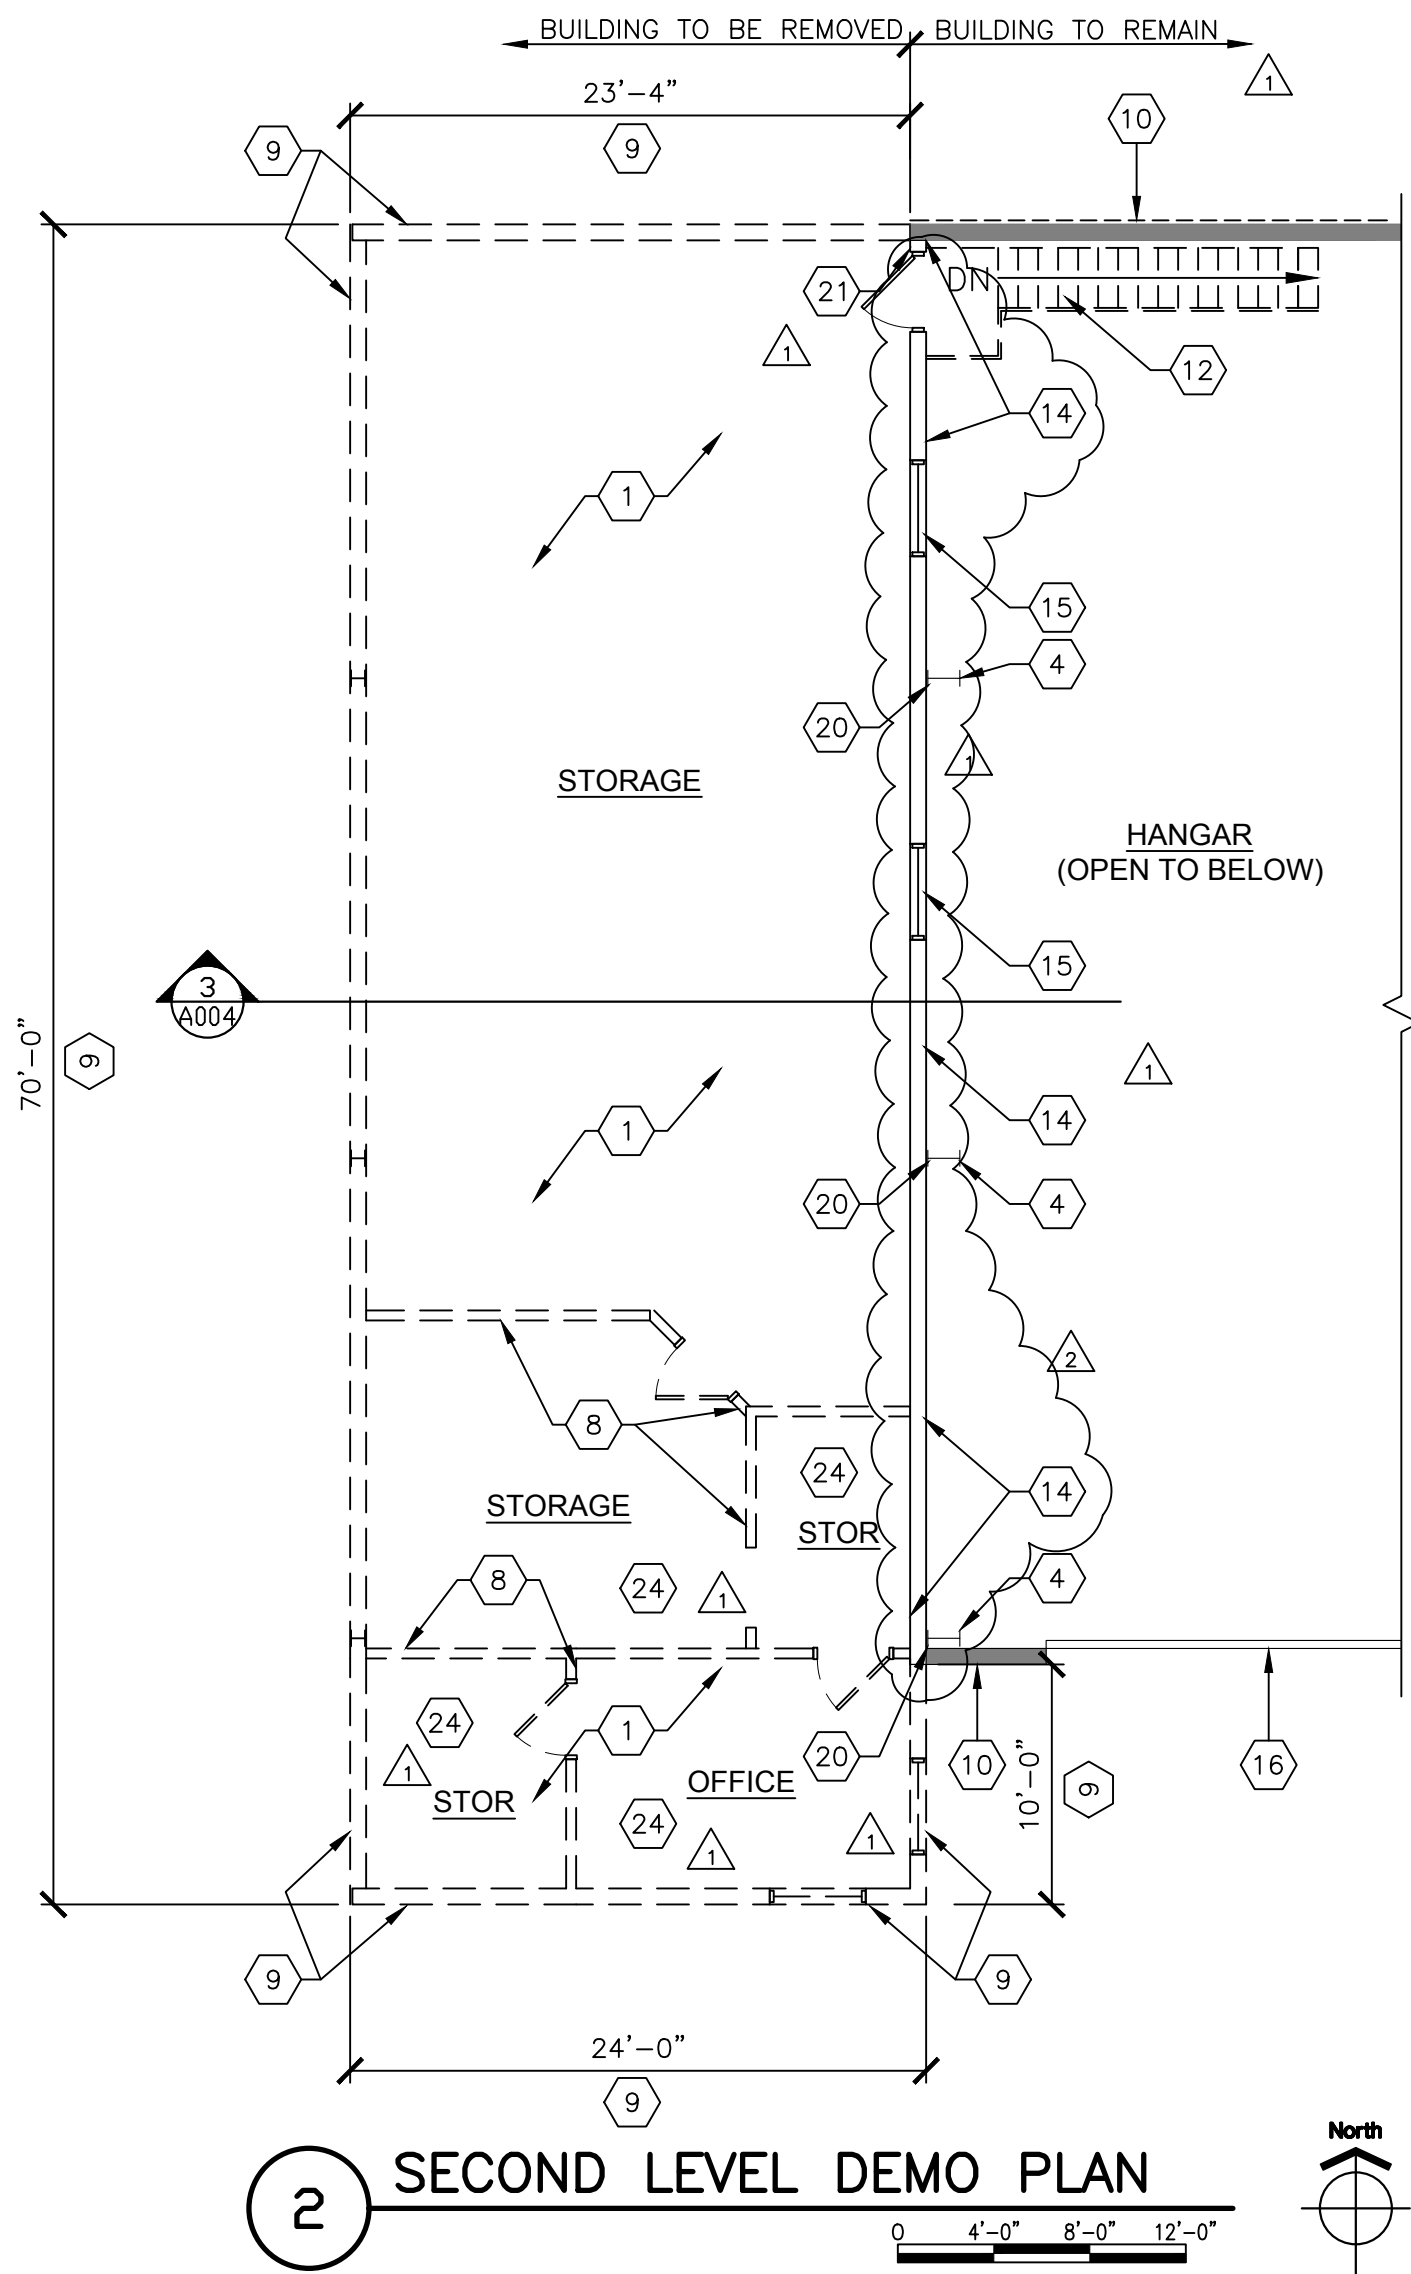

SKY HARBOR AIRPORT
2023 RECONSTRUCT TERMINAL BUILDING

DULUTH, MN

This drawing is an instrument of service and shall remain the property of Short Elliott Hendrickson, Inc. (SEH). This drawing, concepts and ideas contained herein shall not be used, reproduced, revised, or retained without the express written approval of SEH.

Submission or distribution of this drawing to meet official or regulatory requirements or for purposes in connection with the project is not to be construed as publication in derogation of any of the rights of SEH.

COPYRIGHT © 2023
Short Elliott Hendrickson, Inc.
All Rights Reserved

SEH Project
Checked By
Drawn By

DULAL_172133
SB
BB

Project Status
CONSTRUCTION
PLANS

Issue Date
5.16.23

REVISION SCHEDULE		
REV. #	DESCRIPTION	DATE
1	ADDENDUM #1	5.30.2023
2	ADDENDUM #2	6.2.2023

DEMOLITION PLANS AND
SECTIONS

A004




I HEREBY CERTIFY THAT THIS PLAN, SPECIFICATION, OR REPORT WAS PREPARED BY ME OR UNDER MY DIRECT SUPERVISION AND THAT I AM A DULY LICENSED ARCHITECT UNDER THE LAWS OF THE STATE OF MINNESOTA.

Scott Blank, AIA

DATE 5-16-2023 LICENSE NO. 51092



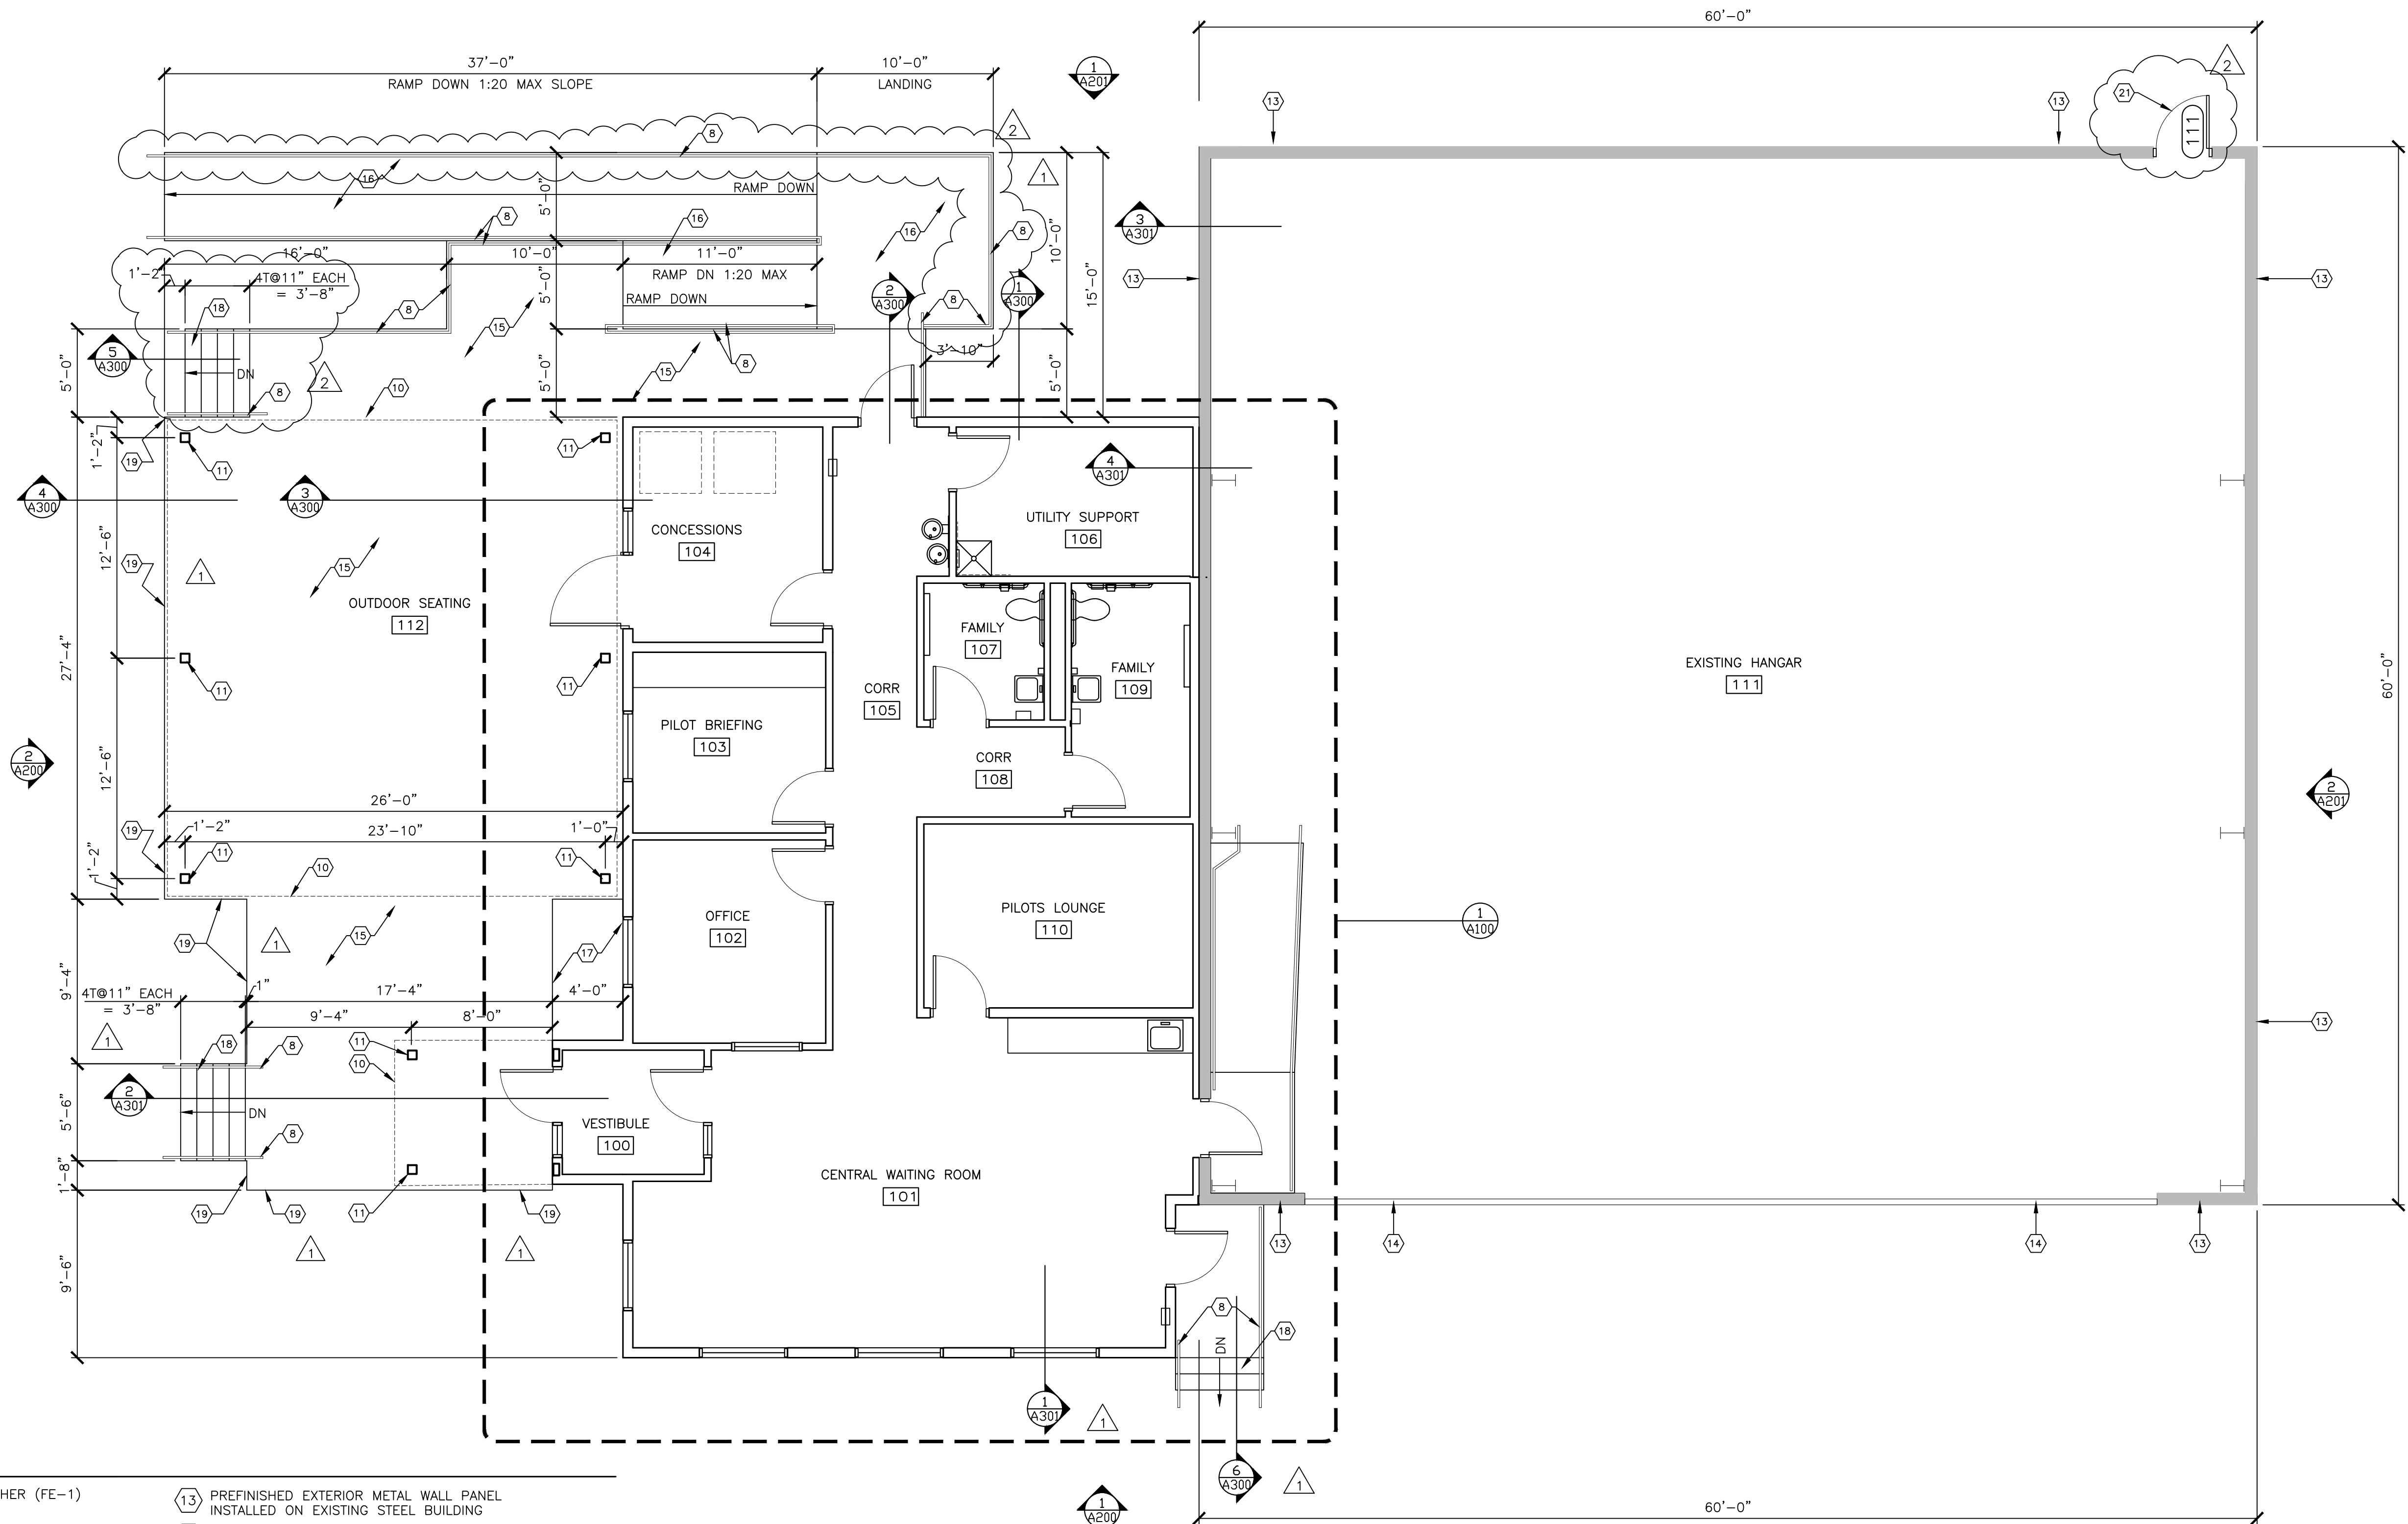

FLOOR PLAN KEYNOTES:

- 1 CABINET MOUNTED FIRE EXTINGUISHER (FE-1)
2 DUAL-HEIGHT DRINKING FOUNTAIN
3 FLOOR MOUNTED MOP SINK, SEE MECHANICAL
4 4'-0" HIGH FRP WALL FINISH AT MOP SINK
5 DIMENSION TO EXTERIOR FACE OF WALL SHEATHING
6 PLASTIC LAMINATE COUNTERTOP AT 30" ABOVE FINISHED FLOOR WITH SUPPORT BRACKETS AT 36" OC, SCRIBE TO WALL
7 VENDING MACHINE, BY OWNER
8 1 1/2" DIAMETER STEEL PIPE HANDRAIL (PAINT) - EMBED RAILING IN THICKENED CONCRETE EDGE OR WALL IN SLEEVE AND GROUT SOLID, TYPICAL
9 CONCRETE RAMP AND LANDING, SLOPE DOWN AT 1:12 MAXIMUM - FIELD VERIFY FINAL RAMP LENGTH
10 CANOPY ABOVE (SHOWN DASHED)
11 STEEL COLUMN, SEE STRUCTURAL (PAINT)
12 STEEL COLUMN IN STUD CAVITY, SEE STRUCTURAL
13 PREFINISHED EXTERIOR METAL WALL PANEL INSTALLED ON EXISTING STEEL BUILDING
14 PREFINISHED EXTERIOR METAL WALL PANEL INSTALLED ON EXISTING HANGAR DOOR
15 RAISED CONCRETE PATIO, SEE STRUCTURAL
16 CONCRETE PAVEMENT/WALK, SEE CIVIL - THICKEN EDGE FOR HANDRAIL EMBEDMENT, TYPICAL
17 4" THICK LANDSCAPE ROCK OVER LANDSCAPING FABRIC
18 CONCRETE STAIRS
19 CLAD FACE OF RAISED CONCRETE PATIO WALL WITH SIMULATED MASONRY VENEER
20 2x8 WOOD STUD WALL CONSTRUCTED ON TOP OF EXISTING CMU WALL AND EXTENDED TO UNDERSIDE OF EXISTING ROOF STRUCTURE, SEE 3/A301 AND 4/A301
21 PRIOR TO COMMENCEMENT OF CONSTRUCTION THE CONTRACTOR SHALL PROVIDE A CONSTRUCTION CORE IN THE EXISTING DOOR OR REPLACE DOOR WITH A TEMPORARY CONSTRUCTION DOOR AND PROVIDE (10) KEYS TO OWNER FOR DISTRIBUTION TO AIRPORT TENANTS

1 OVERALL FLOOR PLAN



I HEREBY CERTIFY THAT THIS PLAN, SPECIFICATION, OR REPORT WAS PREPARED BY ME OR UNDER MY DIRECT SUPERVISION AND THAT I AM A DULY LICENSED ARCHITECT UNDER THE LAWS OF THE STATE OF MINNESOTA.

Scott Blank, AIA
DATE 5-16-2023 LICENSE NO. 51092



SKY HARBOR AIRPORT
2023 RECONSTRUCT TERMINAL BUILDING
DULUTH, MN

This drawing is an instrument of service and shall remain the property of Short Elliott Hendrickson, Inc. (SEH). This drawing, concepts and ideas contained herein shall not be used, reproduced, revised, or retained without the express written approval of SEH. Submission or distribution of this drawing to meet official or regulatory requirements or for purposes in connection with the project is not to be construed as publication in derogation of any of the rights of SEH.

SEH Project DULAI_172133
Checked By SB
Drawn By BB

Project Status Issue Date
CONSTRUCTION 5.16.23
PLANS


REVISION SCHEDULE		
REV. #	DESCRIPTION	DATE
1	ADDENDUM #1	5.30.2023
2	ADDENDUM #2	6.2.2023

OVERALL FLOOR PLAN

A100

FLOOR PLAN KEYNOTES:

- 1 CABINET MOUNTED FIRE EXTINGUISHER (FE-1)
- 2 DUAL-HEIGHT DRINKING FOUNTAIN
- 3 FLOOR MOUNTED MOP SINK, SEE MECHANICAL
- 4 4'-0" HIGH FRP WALL FINISH AT MOP SINK
- 5 DIMENSION TO EXTERIOR FACE OF WALL SHEATHING
- 6 PLASTIC LAMINATE COUNTERTOP AT 30" ABOVE FINISHED FLOOR WITH SUPPORT BRACKETS AT 36" OC, SCRIBE TO WALL
- 7 VENDING MACHINE, BY OWNER
- 8 1 1/2" DIAMETER STEEL PIPE HANDRAIL (PAINT) - EMBED RAILING IN THICKENED CONCRETE EDGE OR WALL IN SLEEVE AND GROUT SOLID, TYPICAL
- 9 CONCRETE RAMP AND LANDING, SLOPE DOWN AT 1:12 MAXIMUM - FIELD VERIFY FINAL RAMP LENGTH
- 10 CANOPY ABOVE (SHOWN DASHED)
- 11 STEEL COLUMN, SEE STRUCTURAL (PAINT)
- 12 STEEL COLUMN IN STUD CAVITY, SEE STRUCTURAL
- 13 PREFINISHED EXTERIOR METAL WALL PANEL INSTALLED ON EXISTING STEEL BUILDING
- 14 PREFINISHED EXTERIOR METAL WALL PANEL INSTALLED ON EXISTING HANGAR DOOR
- 15 RAISED CONCRETE PATIO, SEE STRUCTURAL
- 16 CONCRETE PAVEMENT/WALK, SEE CIVIL - THICKEN EDGE FOR HANDRAIL EMBEDMENT, TYPICAL
- 17 4" THICK LANDSCAPE ROCK OVER LANDSCAPING FABRIC
- 18 CONCRETE STAIRS
- 19 CLAD FACE OF RAISED CONCRETE PATIO WALL WITH SIMULATED MASONRY VENEER
- 20 2x8 WOOD STUD WALL CONSTRUCTED ON TOP OF EXISTING CMU WALL AND EXTENDED TO UNDERSIDE OF EXISTING ROOF STRUCTURE, SEE 3/A301 AND 4/A301
- 21 PRIOR TO COMMENCEMENT OF CONSTRUCTION THE CONTRACTOR SHALL PROVIDE A CONSTRUCTION CORE IN THE EXISTING DOOR OR REPLACE DOOR WITH A TEMPORARY CONSTRUCTION DOOR AND PROVIDE (10) KEYS TO OWNER FOR DISTRIBUTION TO AIRPORT TENANTS

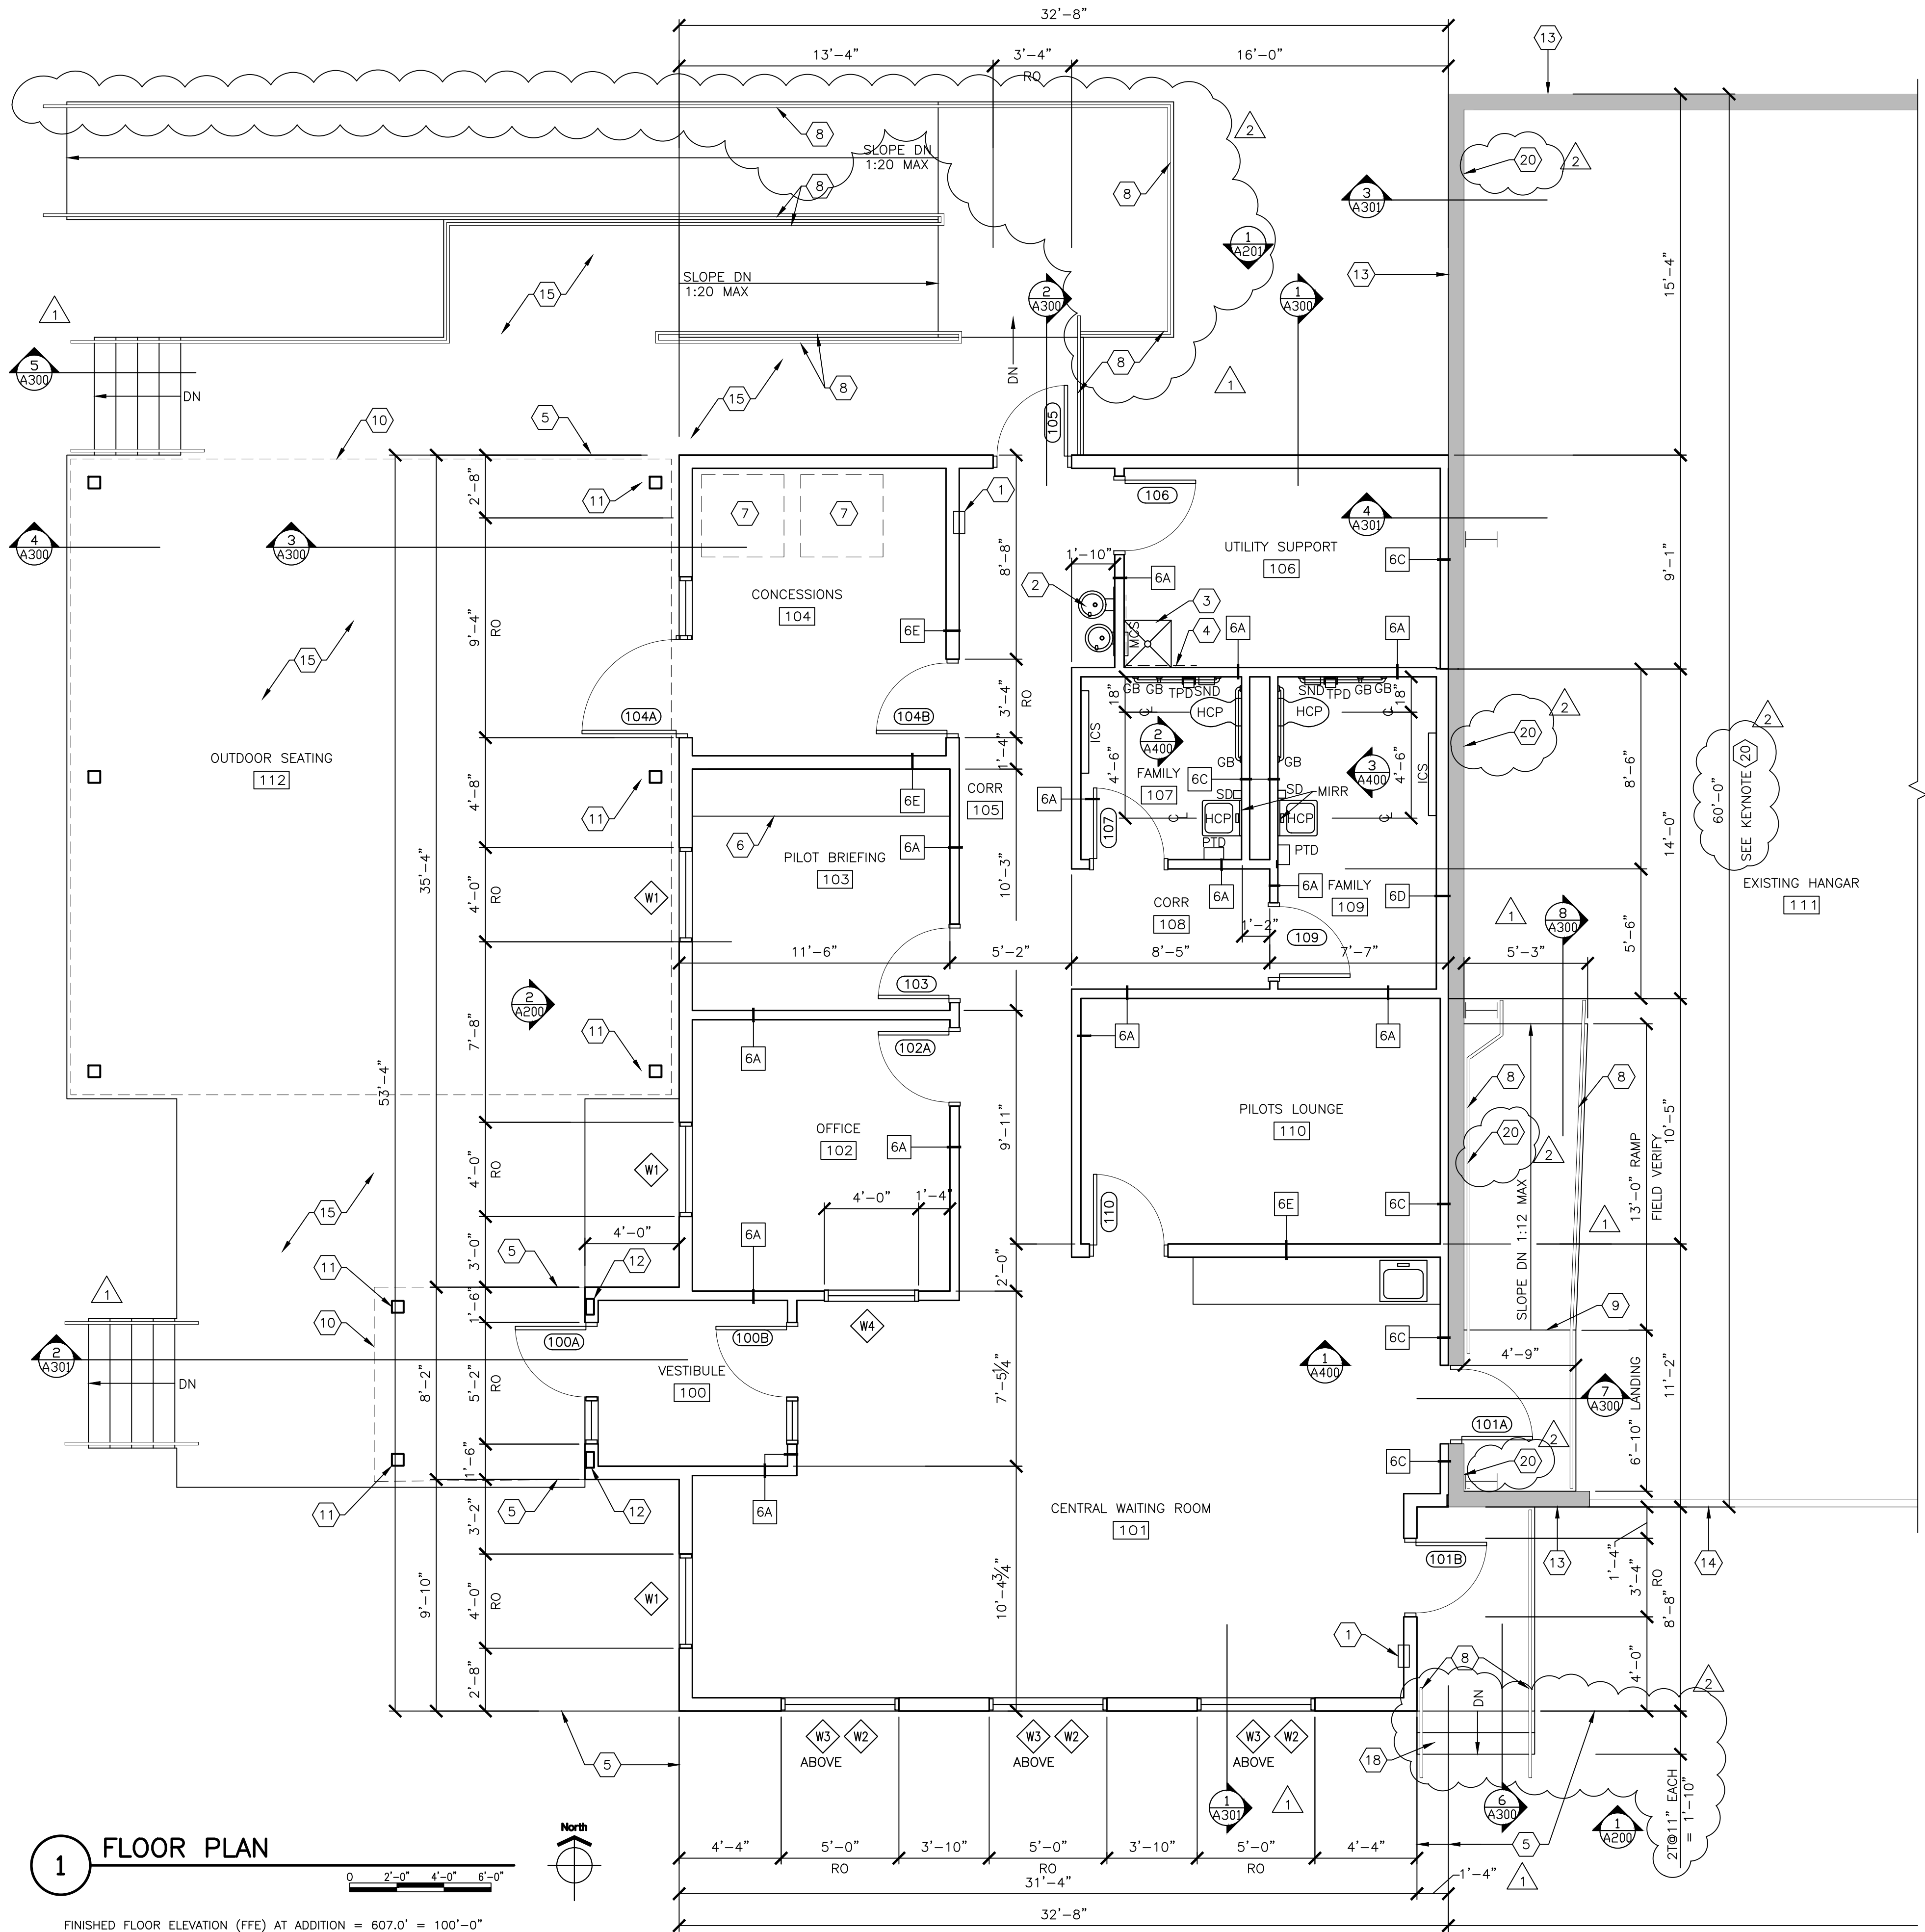

SKY HARBOR AIRPORT
2023 RECONSTRUCT TERMINAL BUILDING

DULUTH, MN

This drawing is an instrument of service and shall remain the property of Short Elliott Hendrickson, Inc. (SEH). This drawing, concepts and ideas contained herein shall not be used, reproduced, revised, or retained without the express written approval of SEH.

Submission or distribution of this drawing to meet official or regulatory requirements or for purposes in connection with the project is not to be construed as publication in derogation of any of the rights of SEH.

Copyright © 2023
Short Elliott Hendrickson, Inc.
All Rights Reserved

SEH Project DULAI_172133
Checked By SB
Drawn By BB

Project Status Issue Date
CONSTRUCTION 5.16.23
PLANS

REVISION SCHEDULE		
REV. #	DESCRIPTION	DATE
1	ADDENDUM #1	5.30.2023
2	ADDENDUM #2	6.2.2023

ADDITION FLOOR PLAN

A101



I HEREBY CERTIFY THAT THIS PLAN, SPECIFICATION, OR REPORT WAS PREPARED BY ME OR UNDER MY DIRECT SUPERVISION AND THAT I AM A DULY LICENSED ARCHITECT UNDER THE LAWS OF THE STATE OF MINNESOTA.

Scott Blank
Scott Blank, AIA

DATE 5-16-2023 LICENSE NO. 51092



SKY HARBOR AIRPORT
2023 RECONSTRUCT TERMINAL BUILDING
DULUTH, MN

This drawing is an instrument of service and shall remain the property of Short Elliott Hendrickson, Inc. (SEH). This drawing, concepts and ideas contained herein shall not be used, reproduced, revised, or retained without the express written approval of SEH.

Submission or distribution of this drawing to meet official or regulatory requirements or for purposes in connection with the project is not to be construed as publication in derogation of any of the rights of SEH.

Copyright © 2023
Short Elliott Hendrickson, Inc.
All Rights Reserved

SEH Project Checked By Drawn By
DULAL_172133 SB BB


Project Status Construction Plans
Issue Date 5.16.23

REVISION SCHEDULE		
REV. #	DESCRIPTION	DATE
1	ADDENDUM #1	5.30.2023
2	ADDENDUM #2	6.2.2023

ROOF PLAN AND
CEILING PLAN

A102


- ROOF PLAN KEYNOTES
- 1 PREFINISHED STANDING SEAM METAL ROOFING (PANEL TYPE-1)
 - 2 8" WIDE x 6" DEEP PREFINISHED METAL GUTTER
 - 3 4"x5" PREFINISHED METAL DOWNSPOUT
 - 4 PREFINISHED METAL RIDGE CAP, MATCH METAL ROOFING FINISH AND COLOR
 - 5 DASHED LINE REPRESENTS EXTERIOR FACE OF WALL BELOW
 - 6 PREFINISHED STANDING SEAM METAL ROOFING (PANEL TYPE-2)
 - 7 PREFINISHED STANDING SEAM METAL ROOFING (PANEL TYPE-3)
 - 8 6" WIDE x 4½" DEEP PREFINISHED METAL GUTTER
 - 9 3"x4" PREFINISHED METAL DOWNSPOUT

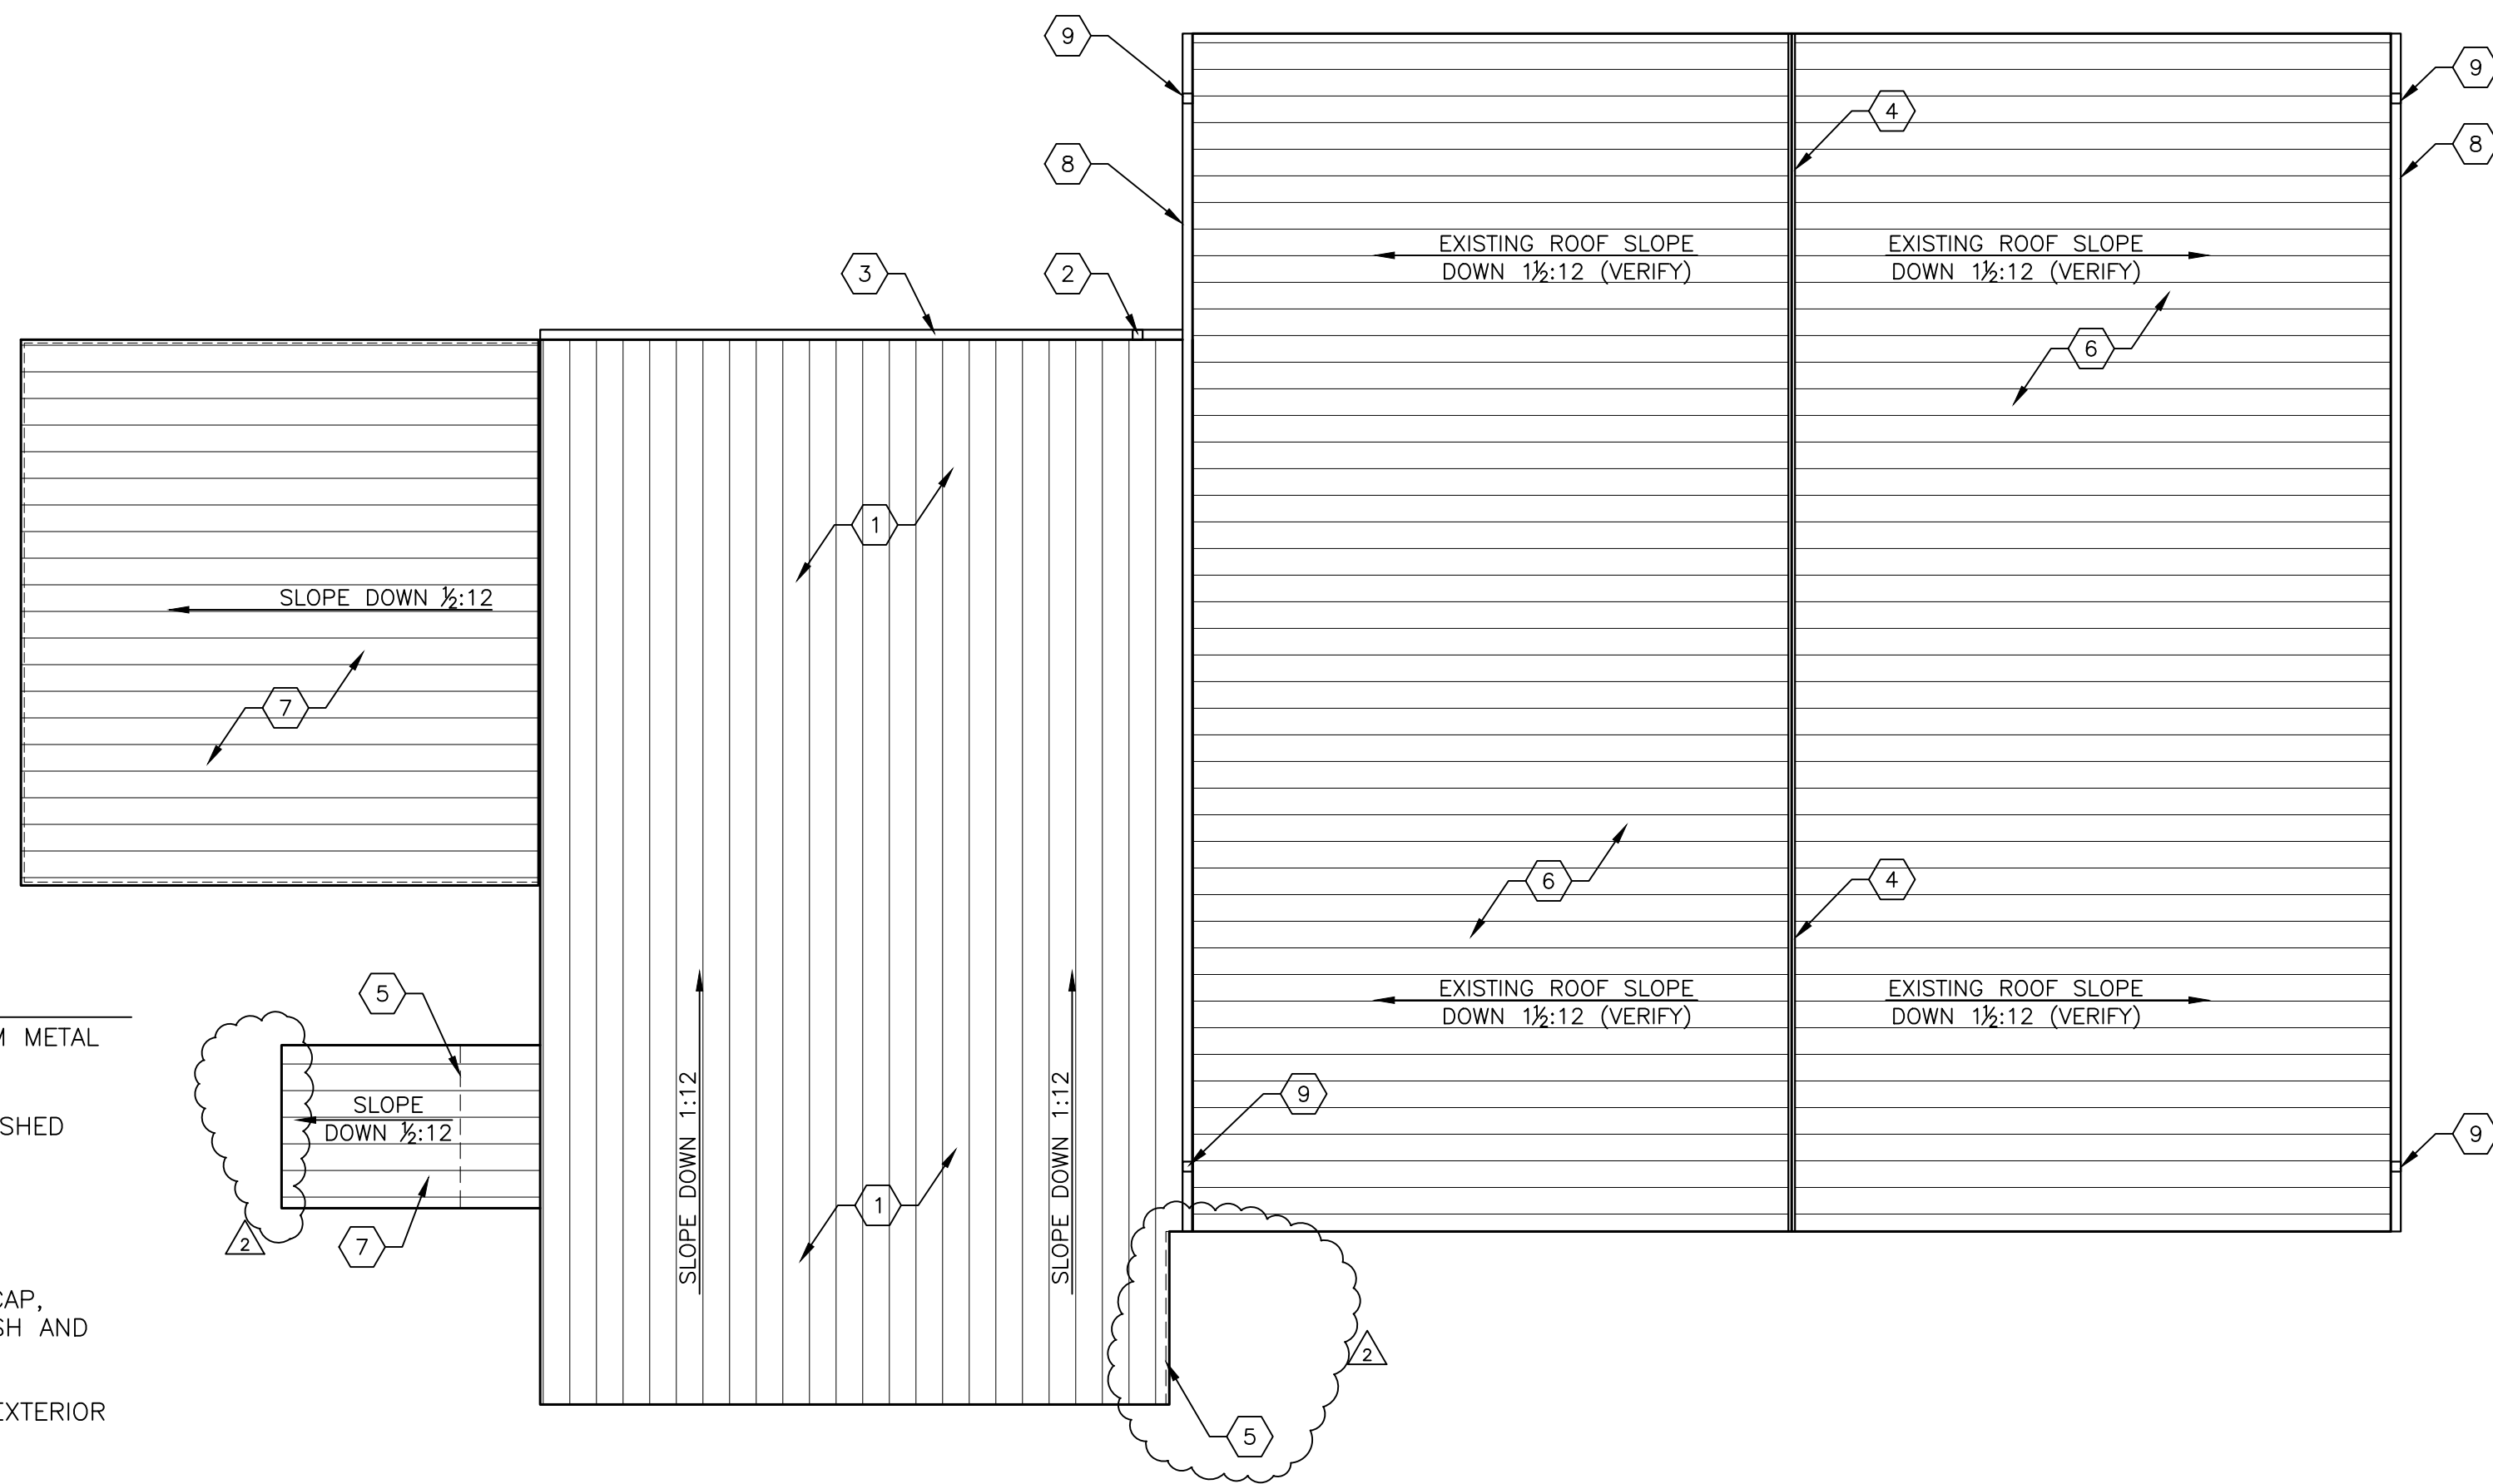

1 ROOF PLAN

0 4'-0" 8'-0" 12'-0"


North

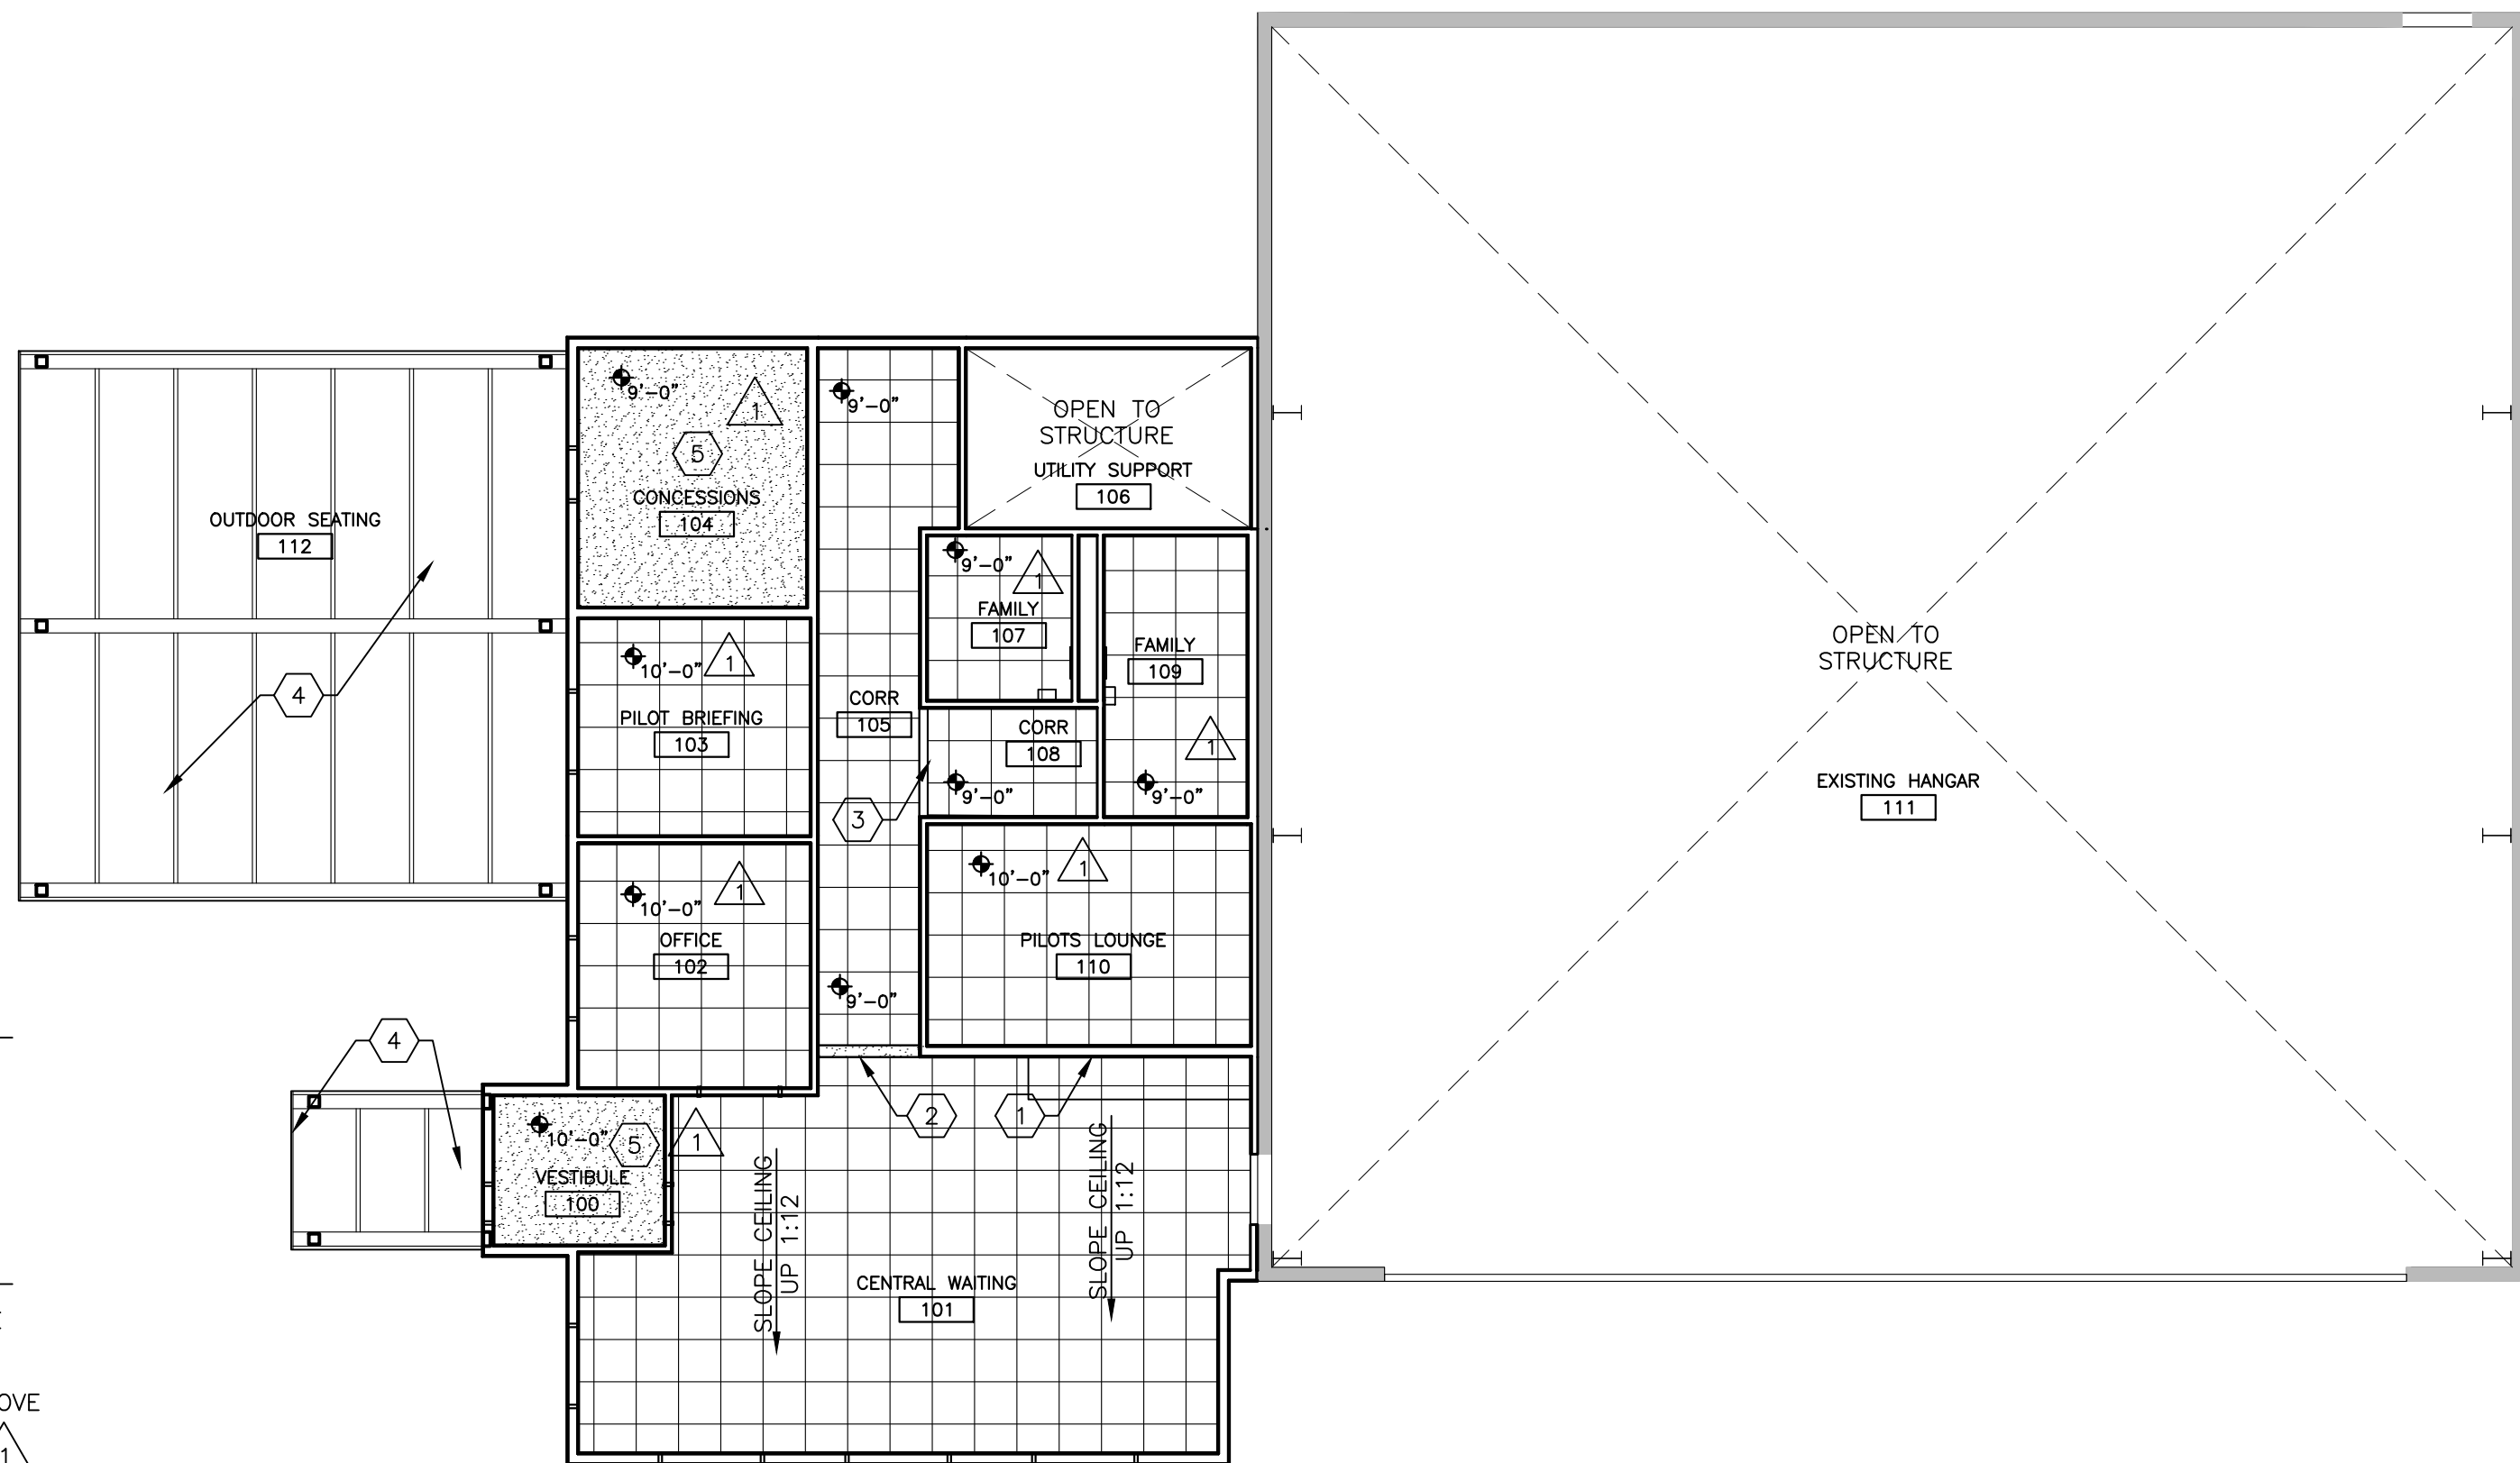

2 CEILING PLAN

0 4'-0" 8'-0" 12'-0"



North

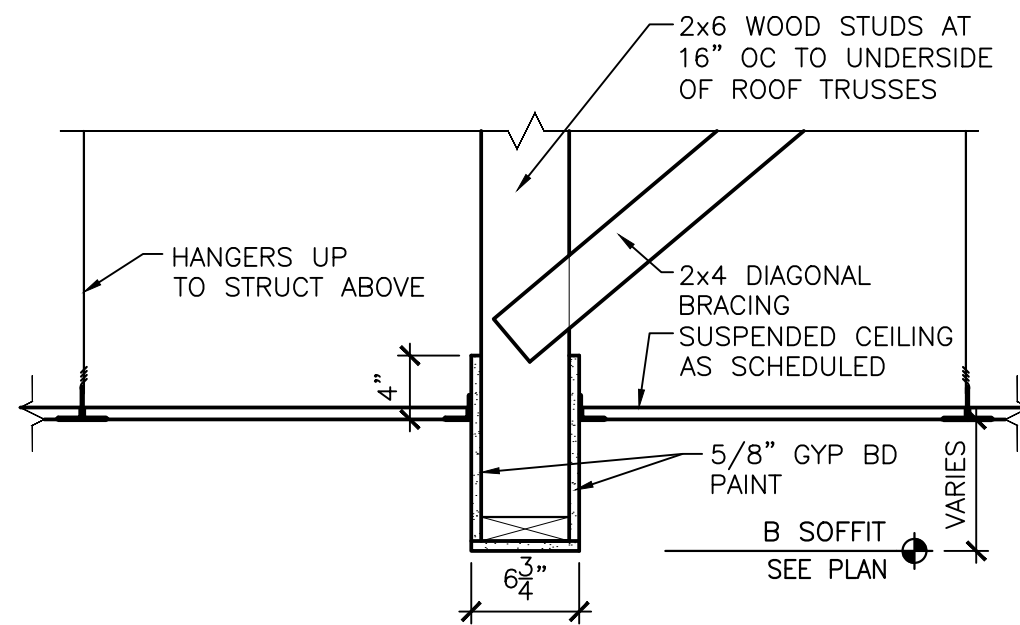

3 TYPICAL BULK HEAD DETAIL

0 6" 1'-0" 1'-6"

- CEILING PLAN LEGEND:
- 5/8" GYPSUM BOARD
 - 2'x2' ACOUSTICAL CEILING PANELS
- CEILING PLAN KEYNOTES:
- 1 ACOUSTICAL CEILING AT 11'-0" ABOVE FINISHED FLOOR AT FACE OF WALL
 - 2 GYPSUM BOARD SOFFIT AT 8'-10" ABOVE FINISHED FLOOR, SEE 3/A102
 - 3 GYPSUM BOARD SOFFIT AT 8'-10" ABOVE FINISHED FLOOR, SEE 3/A102
 - 4 PAINT UNDERSIDE OF CANOPY INCLUDING, BUT NOT LIMITED TO, STRUCTURAL STEEL FRAMING, METAL DECKING AND EXPOSED CONDUIT
 - 5 5/8" GYPSUM BOARD CEILING FASTENED TO 2x6 WOOD FRAMING AT 16" OC

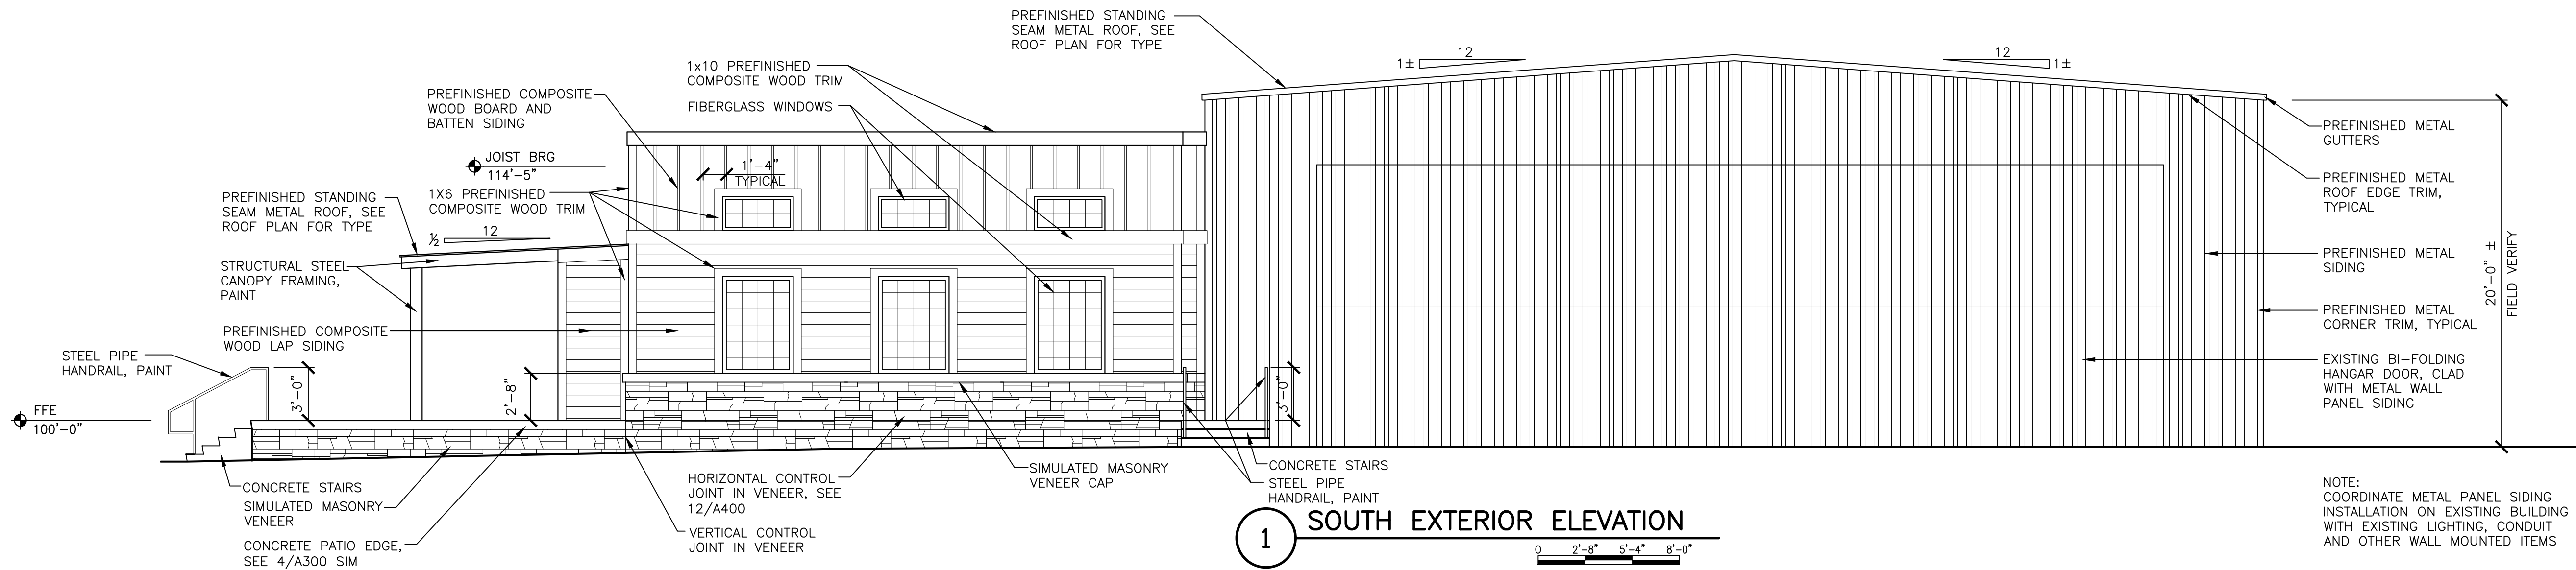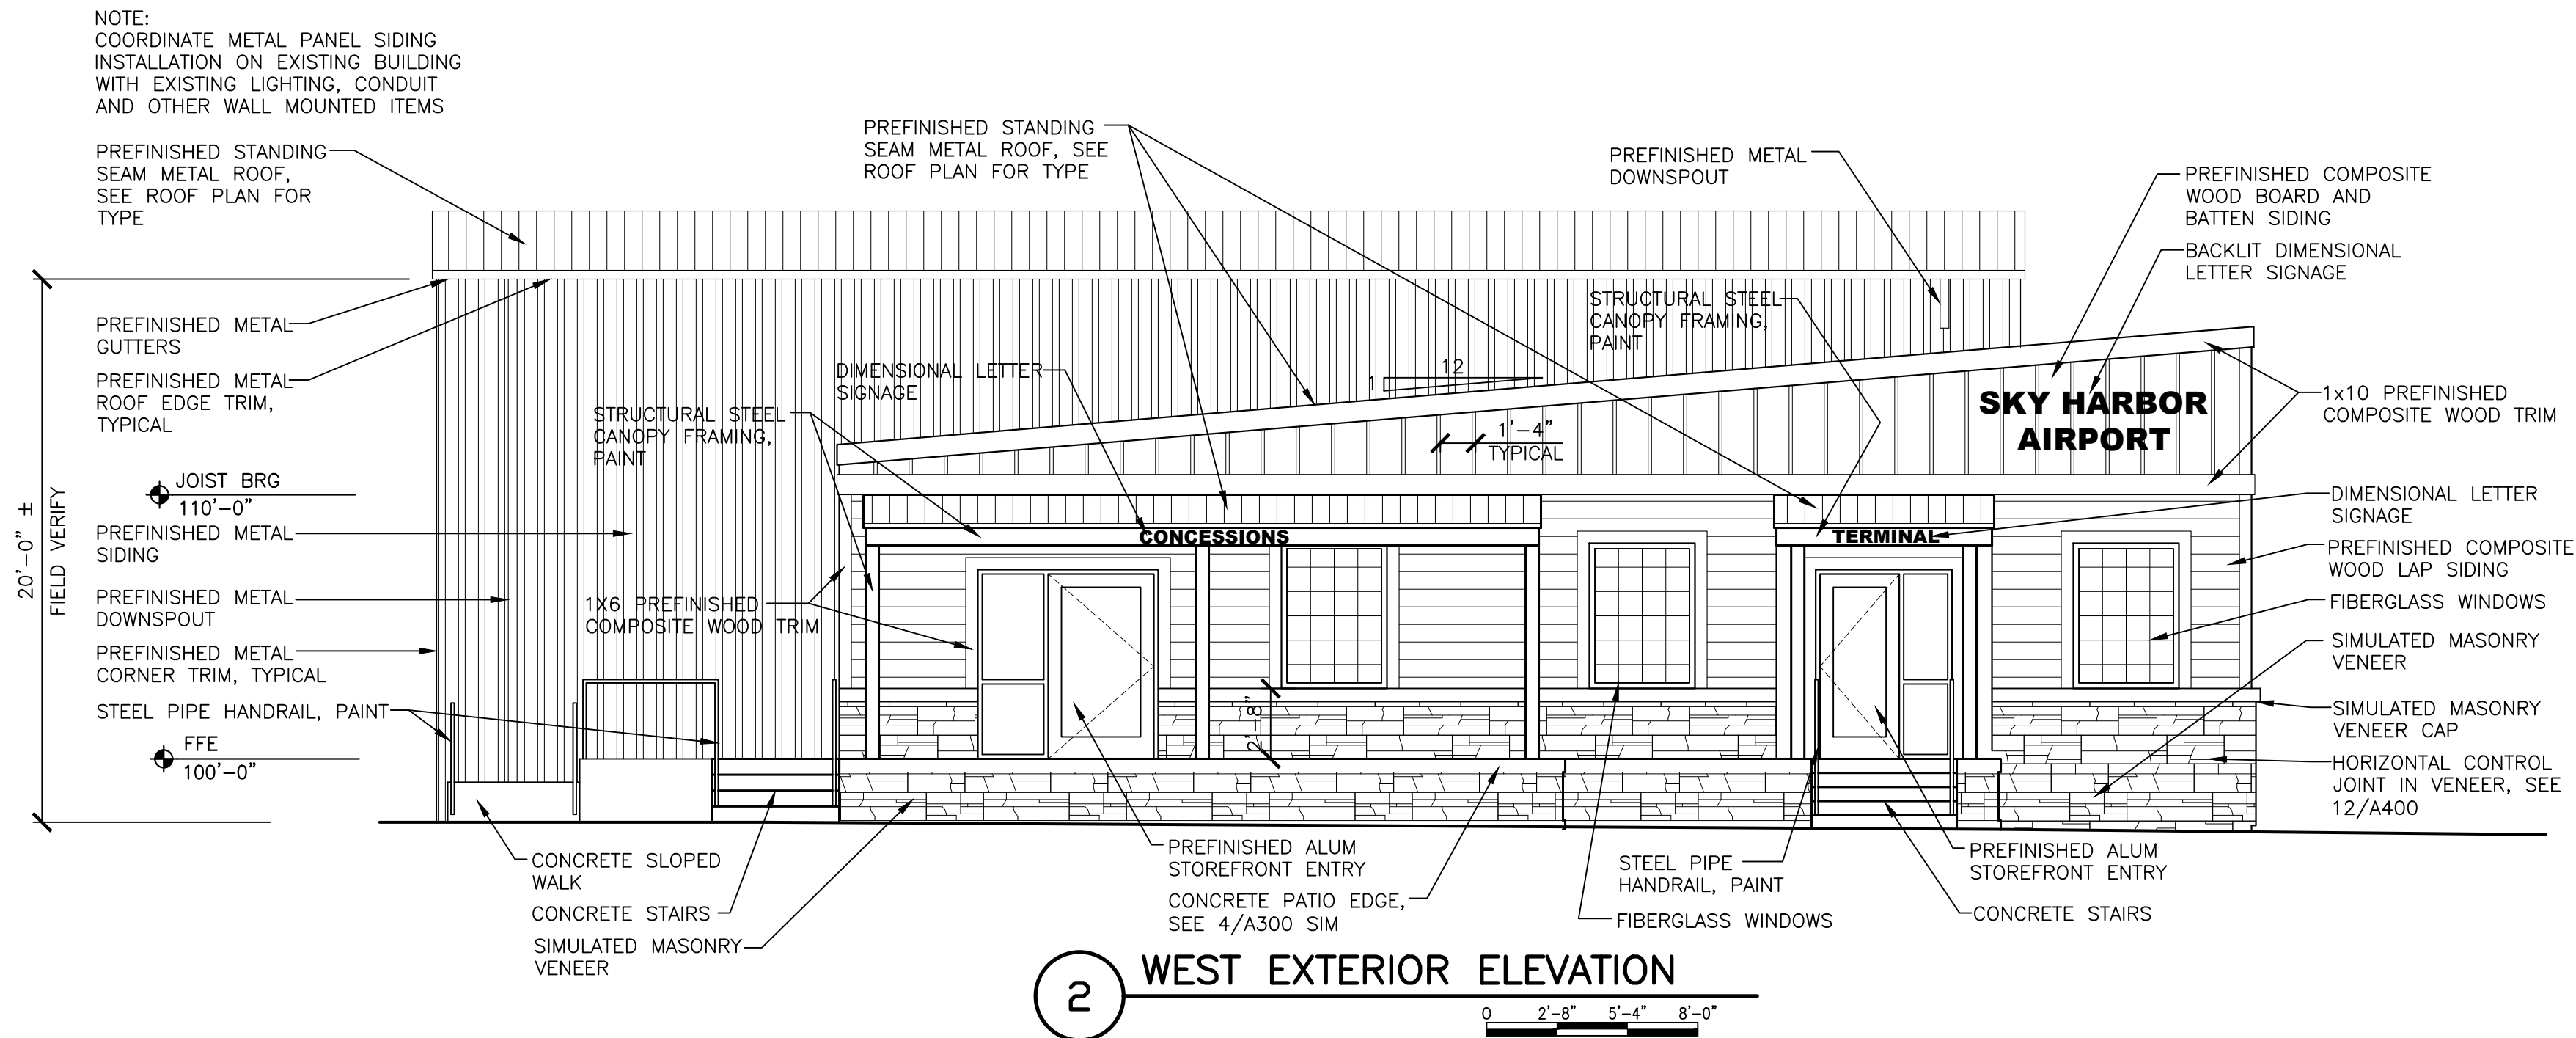



I HEREBY CERTIFY THAT THIS PLAN, SPECIFICATION, OR REPORT WAS PREPARED BY ME OR UNDER MY DIRECT SUPERVISION AND THAT I AM A DULY LICENSED ARCHITECT UNDER THE LAWS OF THE STATE OF MINNESOTA.

Scott Blank
Scott Blank, AIA

DATE 5-16-2023 LICENSE NO. 51092



SKY HARBOR AIRPORT
2023 RECONSTRUCT TERMINAL BUILDING
DULUTH, MN

This drawing is an instrument of service and shall remain the property of Short Elliott Hendrickson, Inc. (SEH). This drawing, concepts and ideas contained herein shall not be used, reproduced, revised, or retained without the express written approval of SEH.

Submission or distribution of this drawing to meet official or regulatory requirements or for purposes in connection with the project is not to be construed as publication in derogation of any of the rights of SEH.

COPYRIGHT © 2023
Short Elliott Hendrickson, Inc.
All Rights Reserved


SEH Project DULAL_172133
Checked By SB
Drawn By BB

Project Status Issue Date
CONSTRUCTION 5.16.23
PLANS


REVISION SCHEDULE		
REV. #	DESCRIPTION	DATE
2	ADDENDUM #2	6.2.2023

EXTERIOR ELEVATIONS


A201

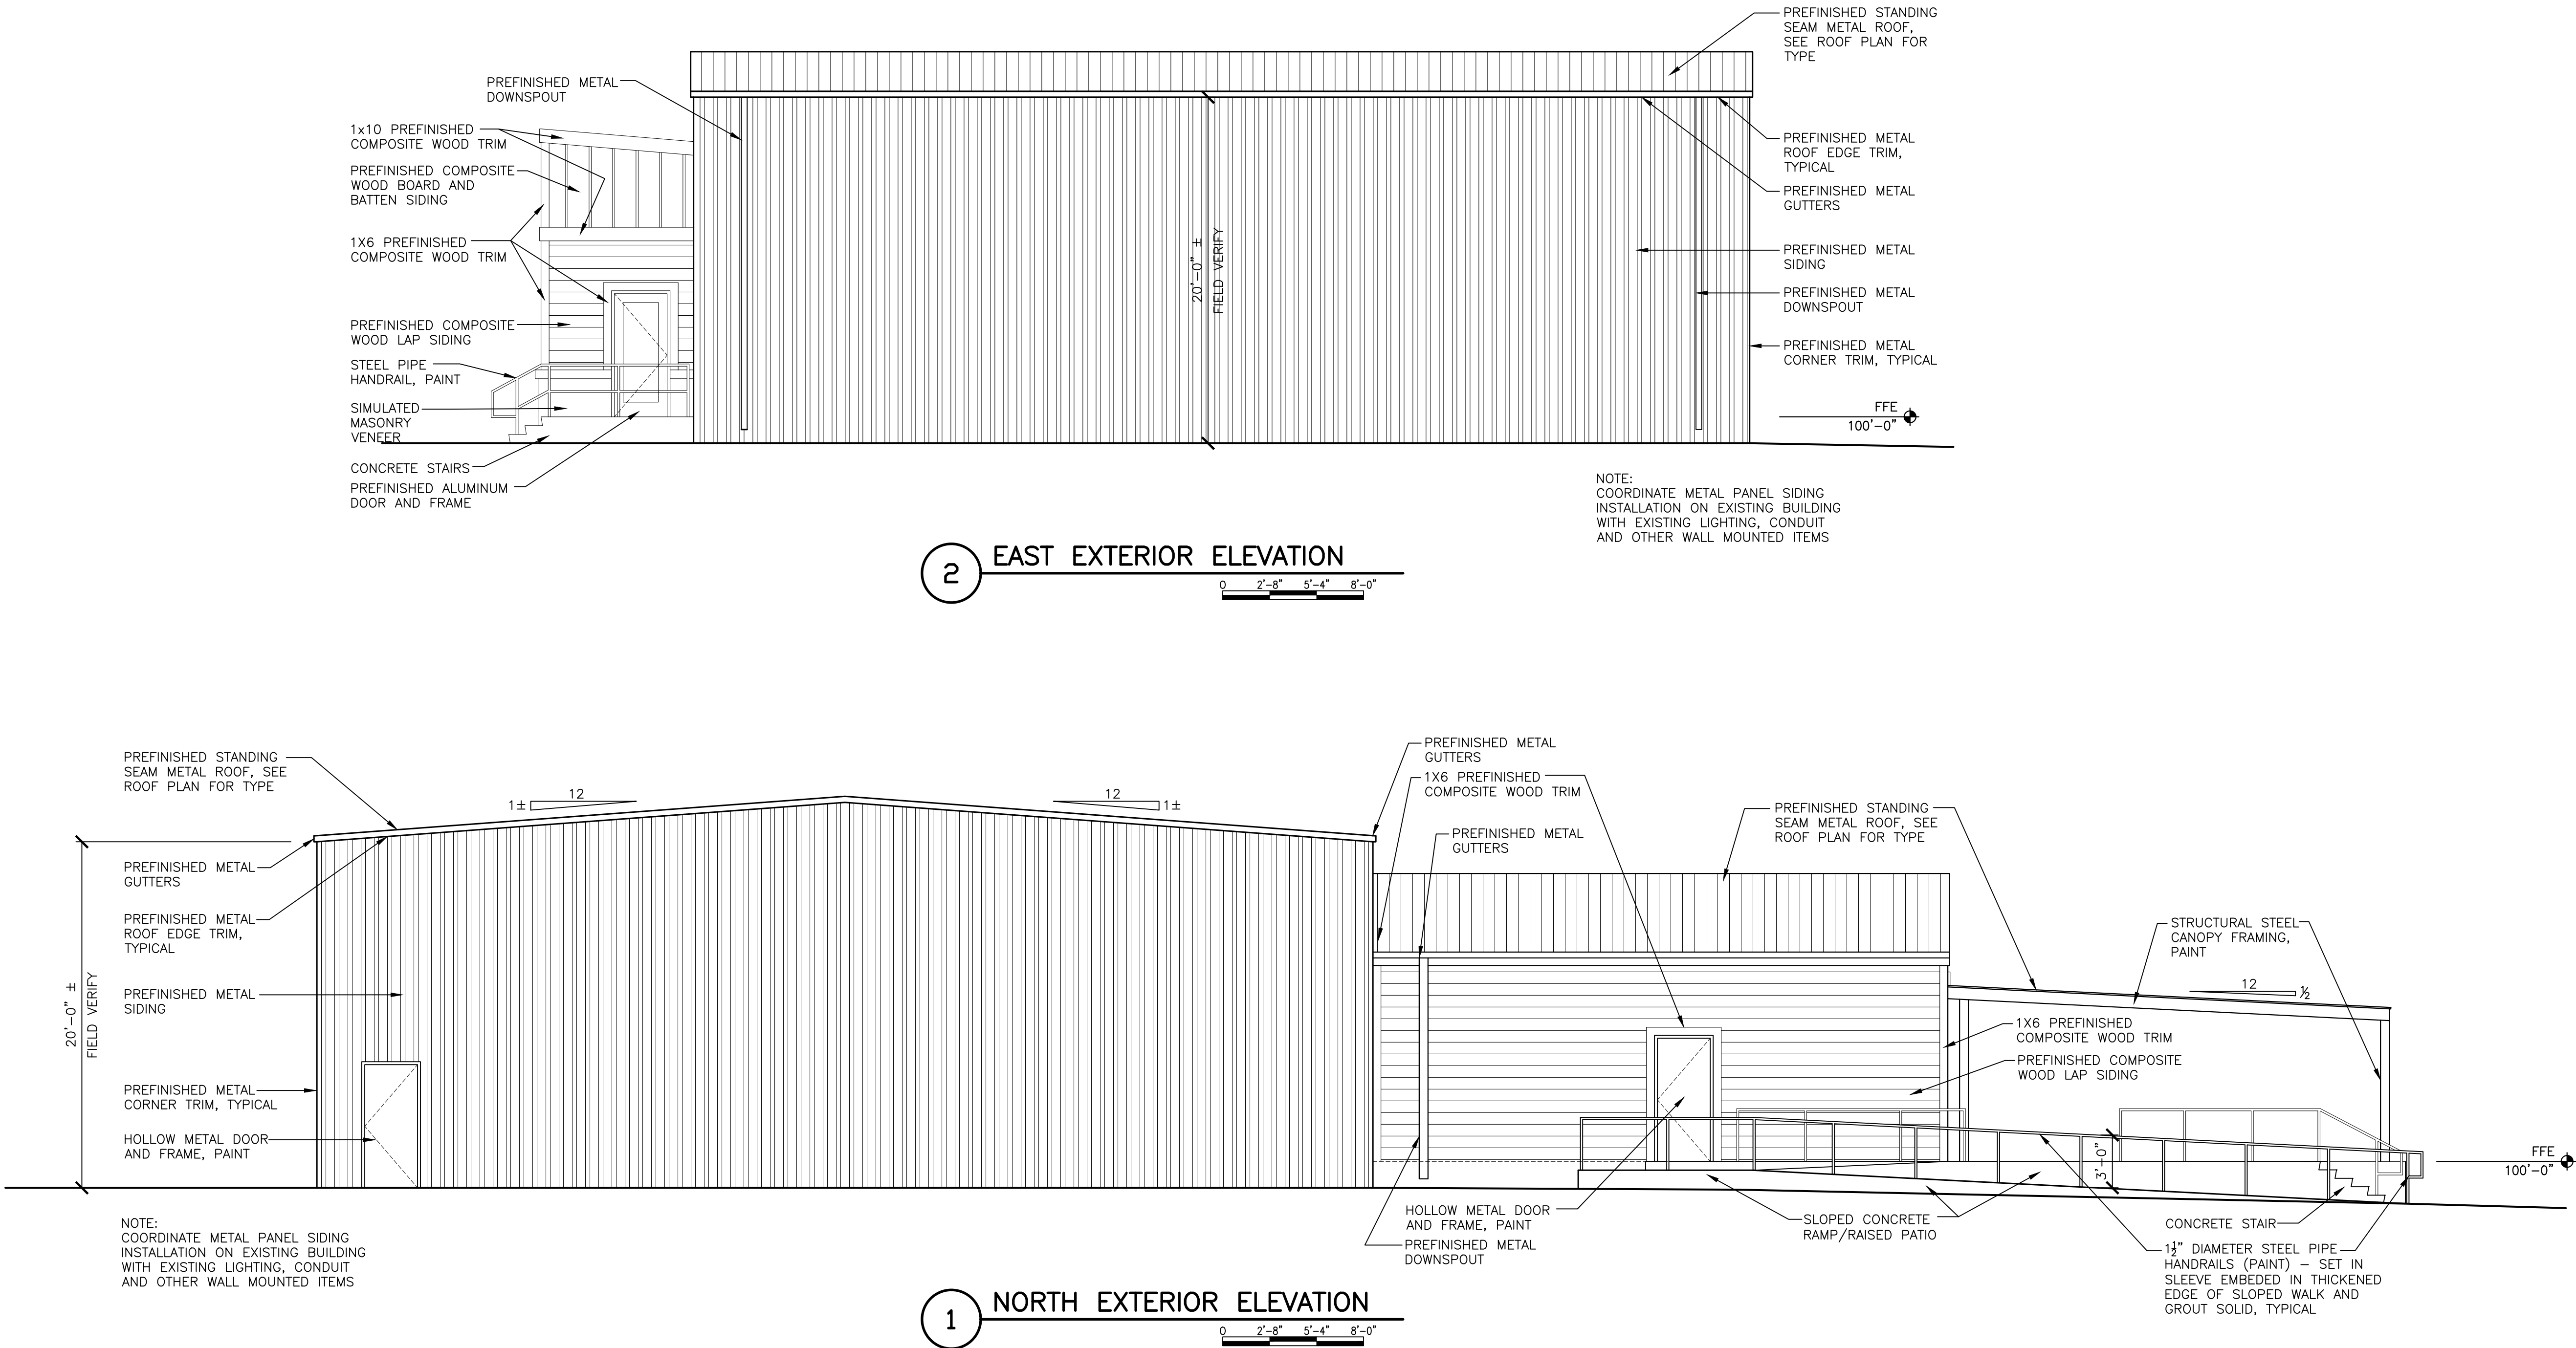


8 SECTION AT INTERIOR RAMP

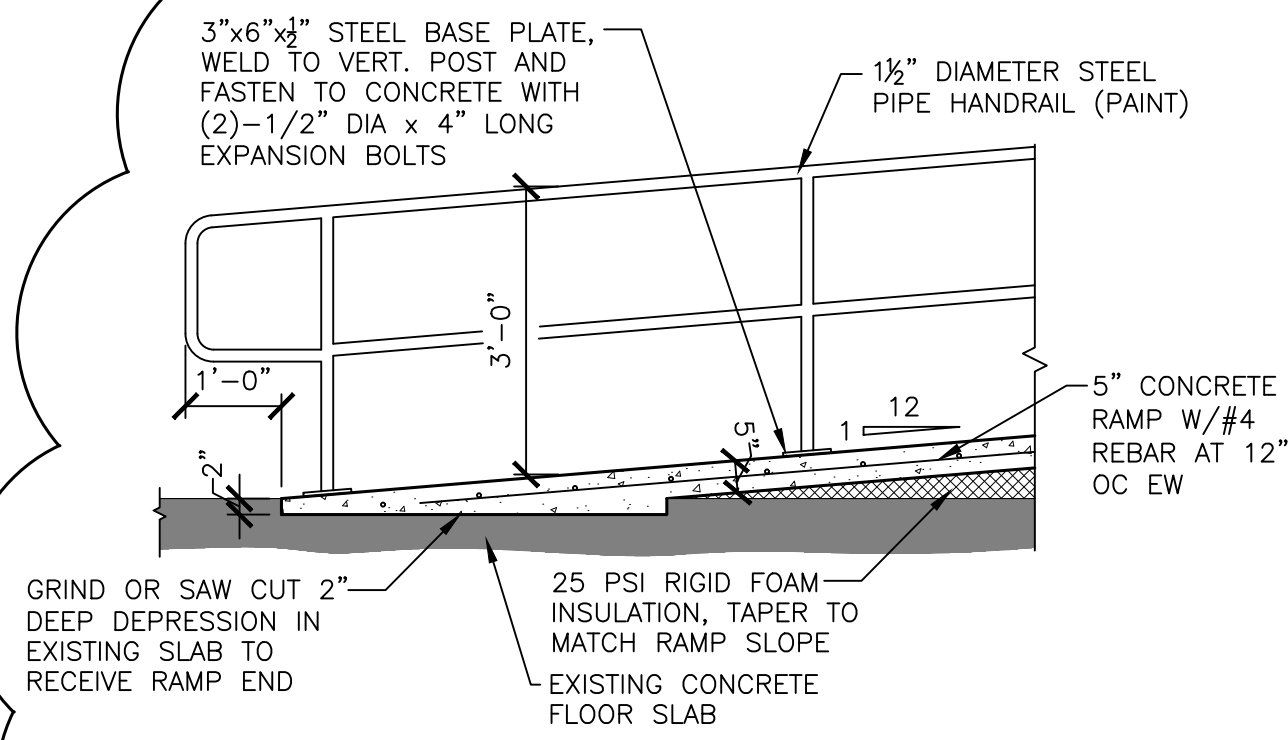


7 SECTION AT INTERIOR RAMP

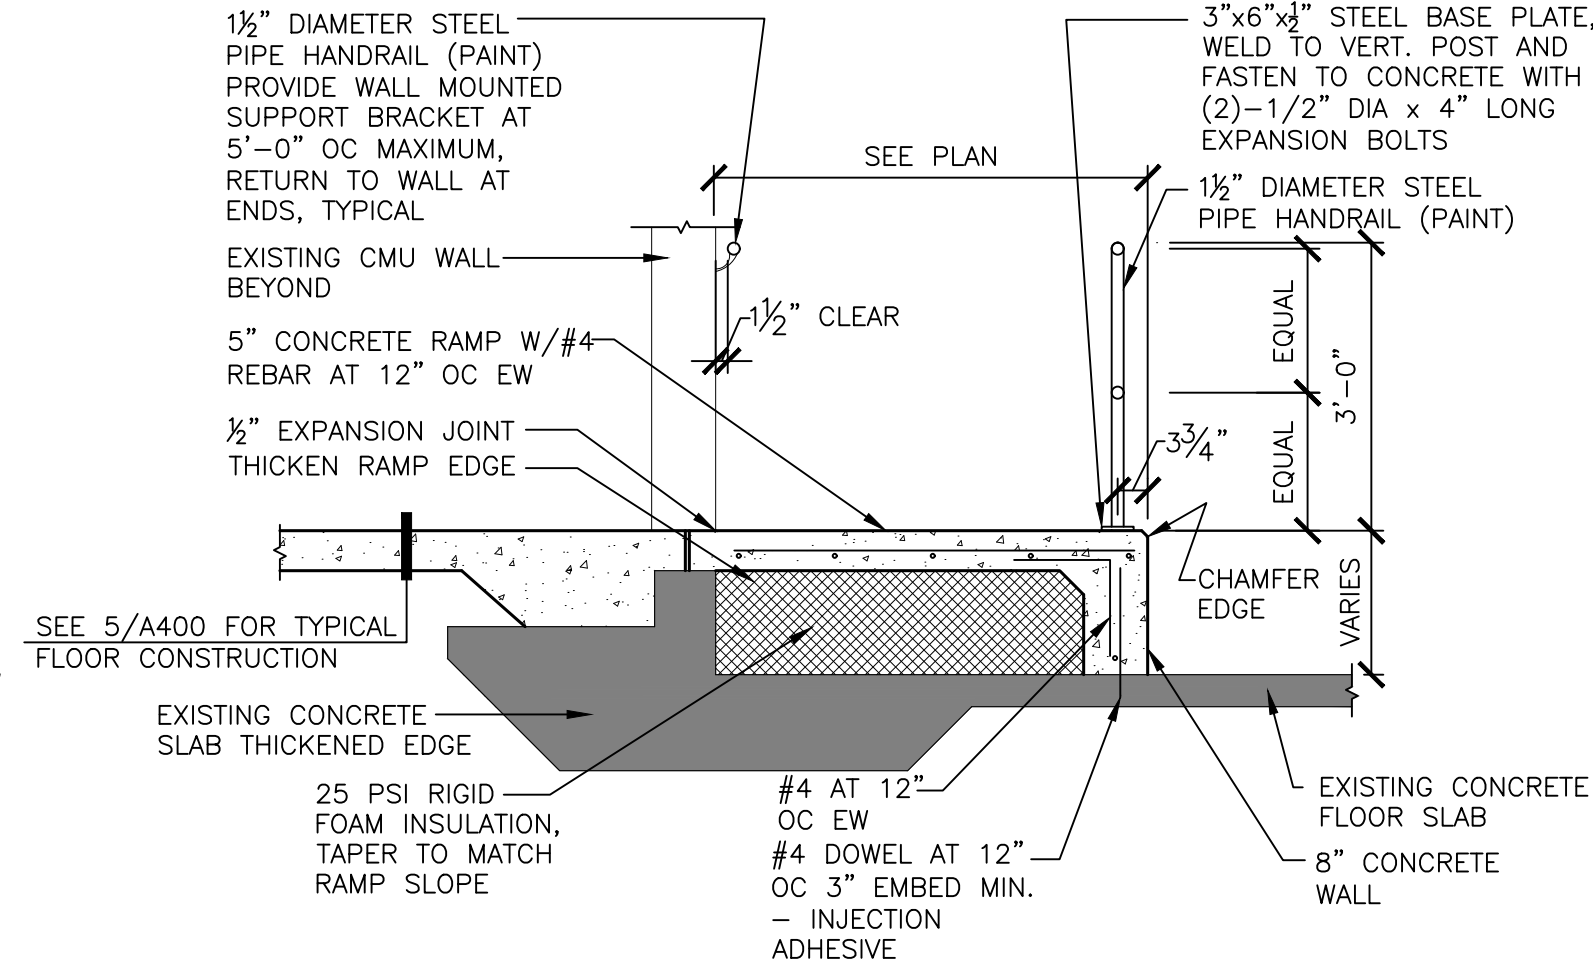


6 SECTION AT STAIR

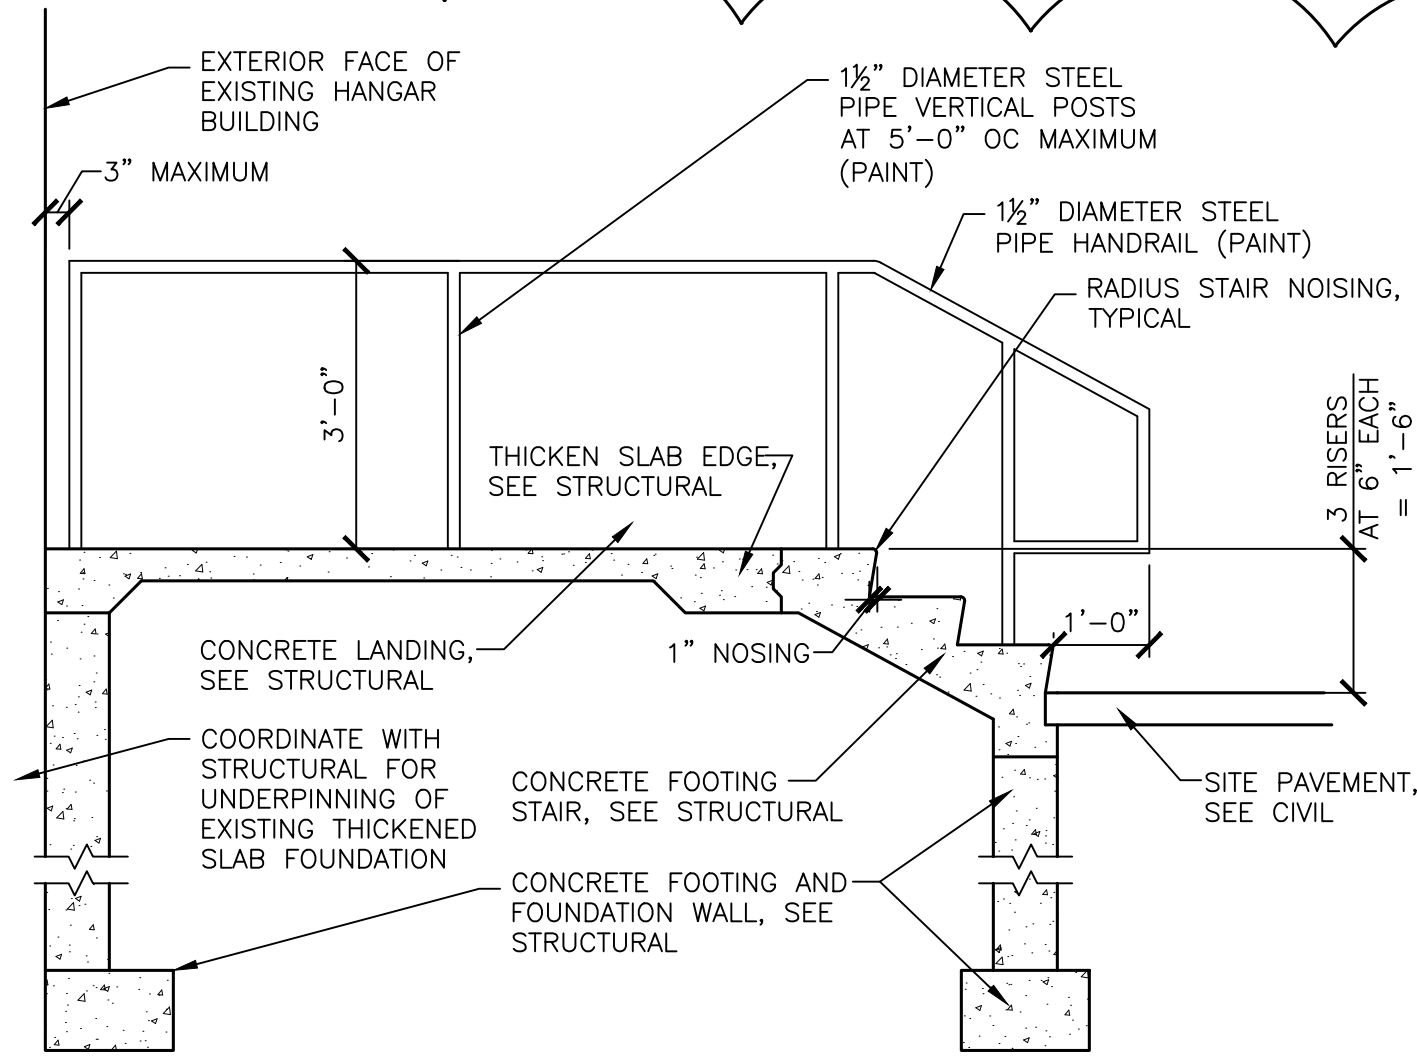


5 SECTION AT STAIR

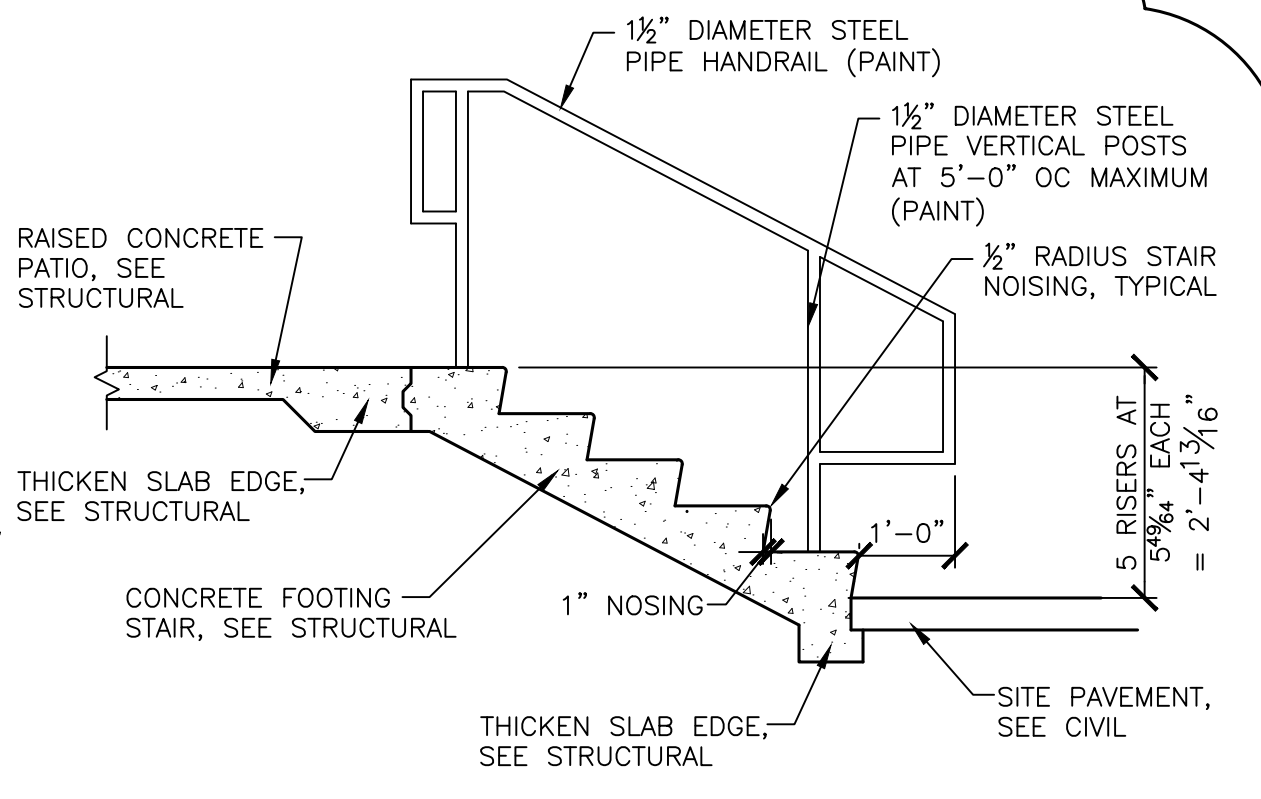


4 WALL SECTION

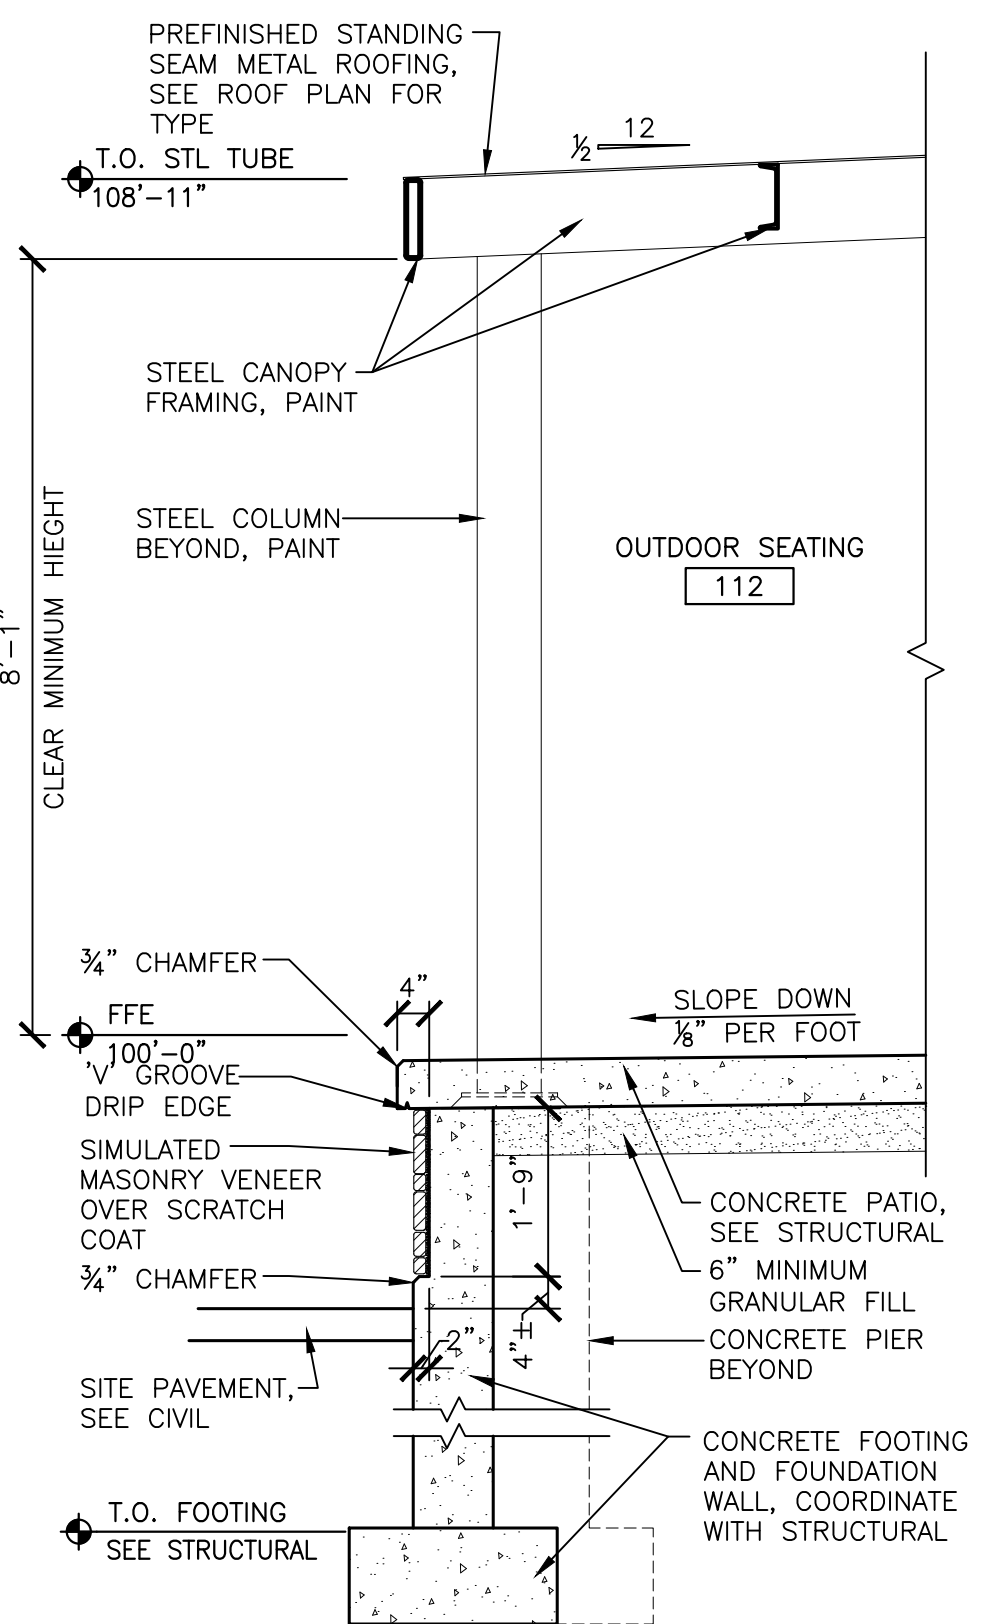


3 WALL SECTION

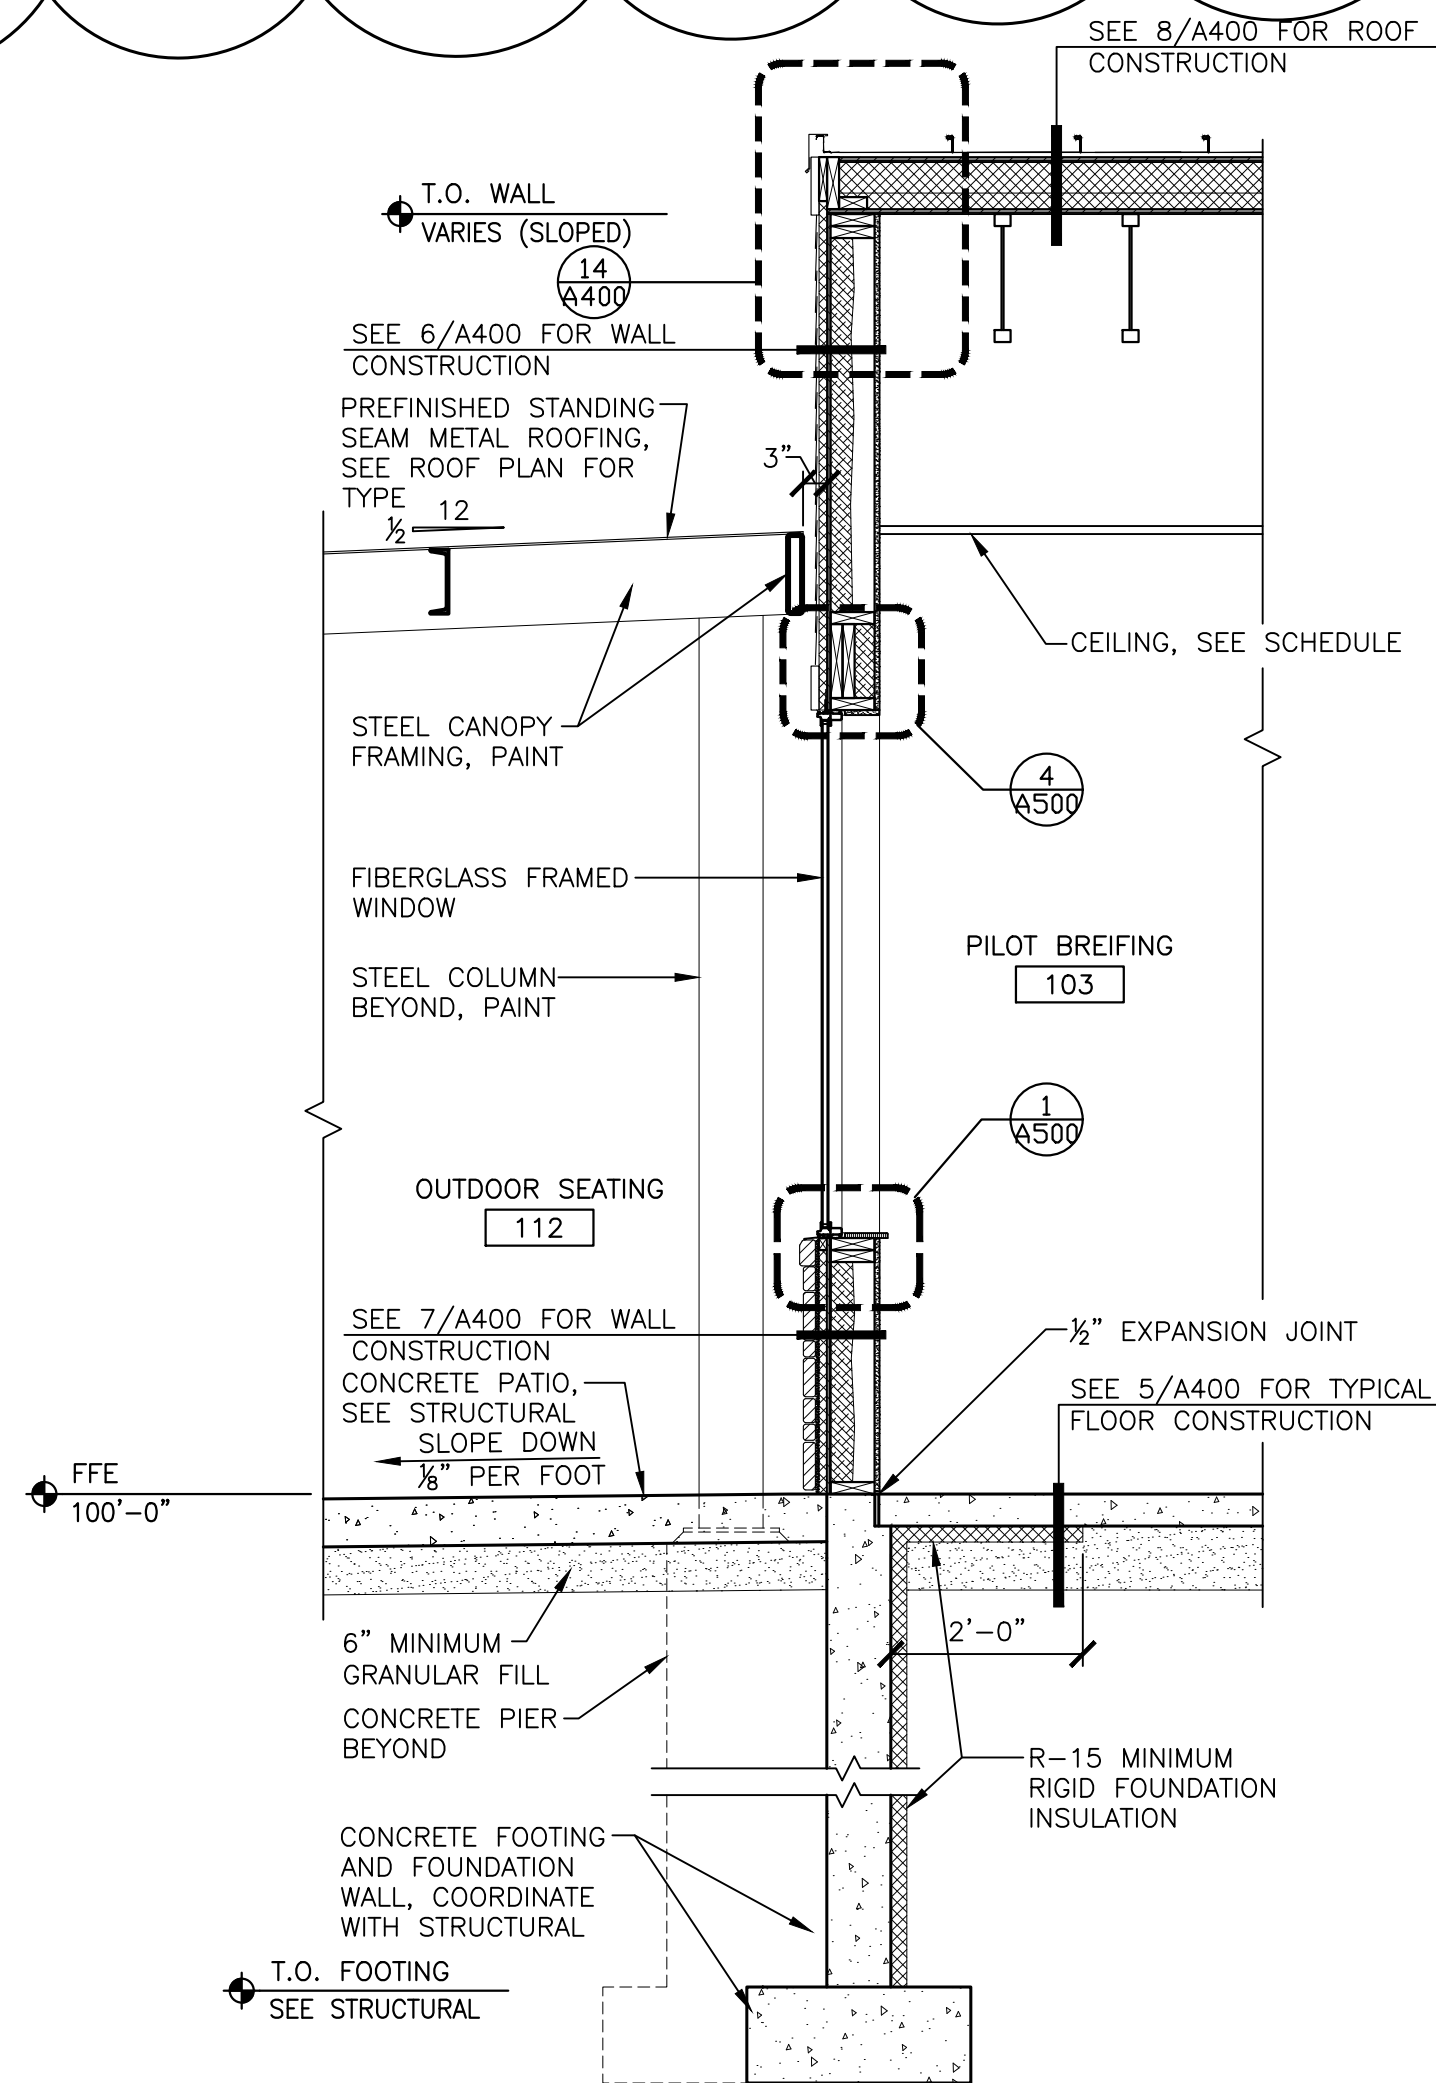

2 WALL SECTION

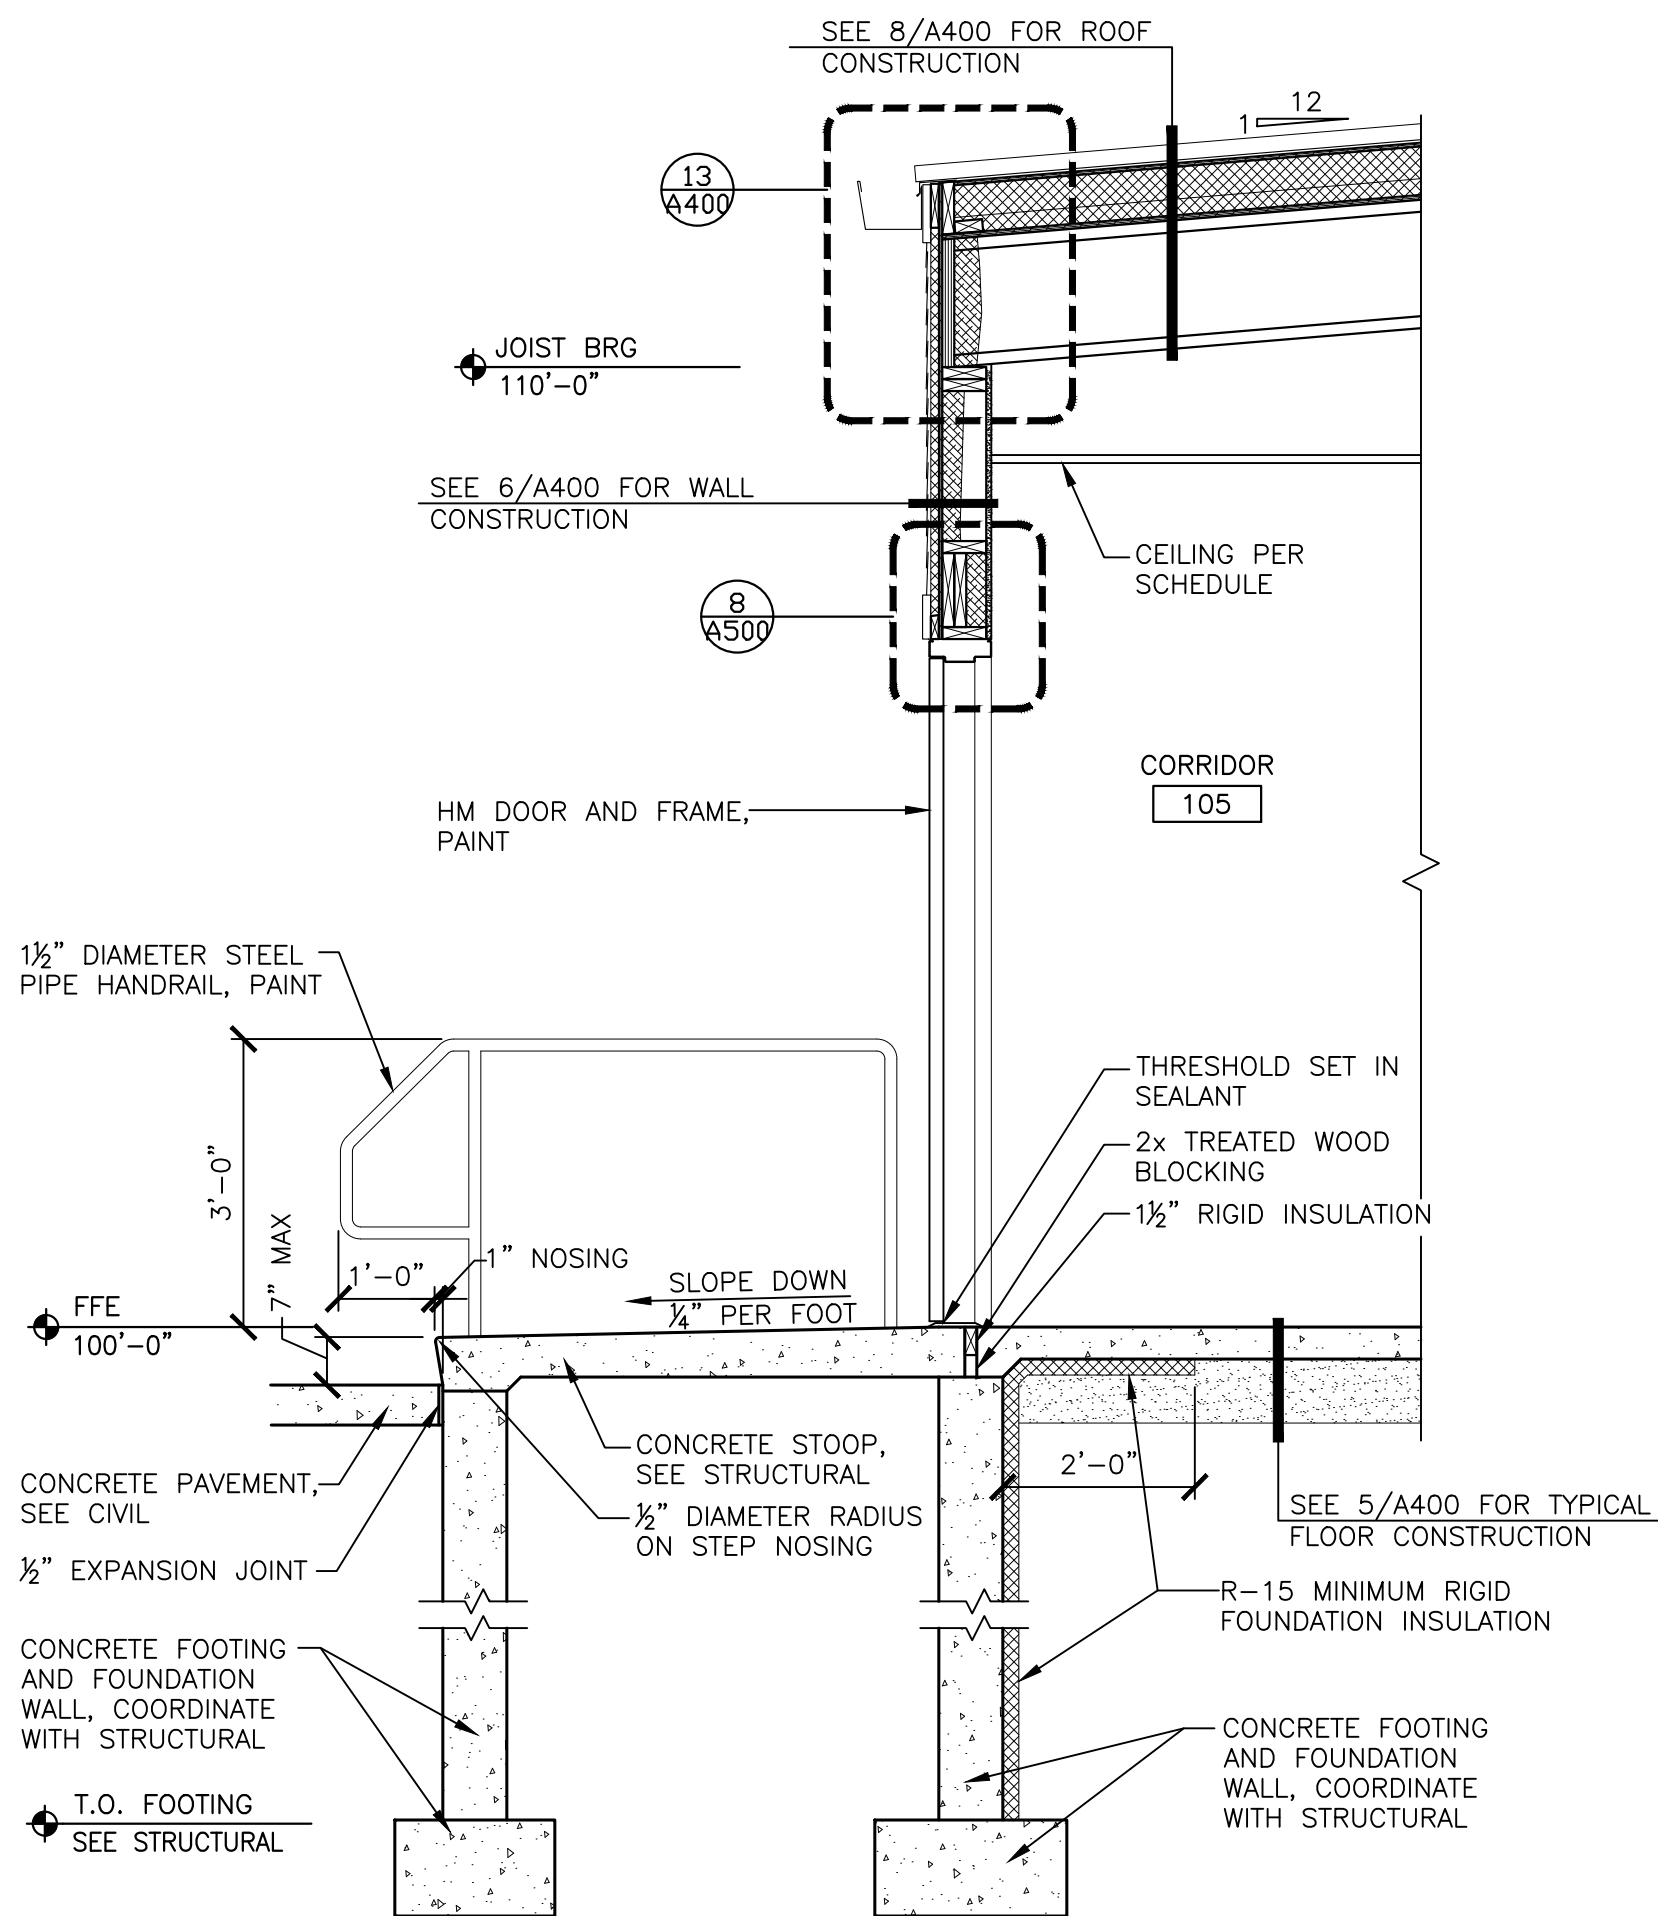

1 WALL SECTION

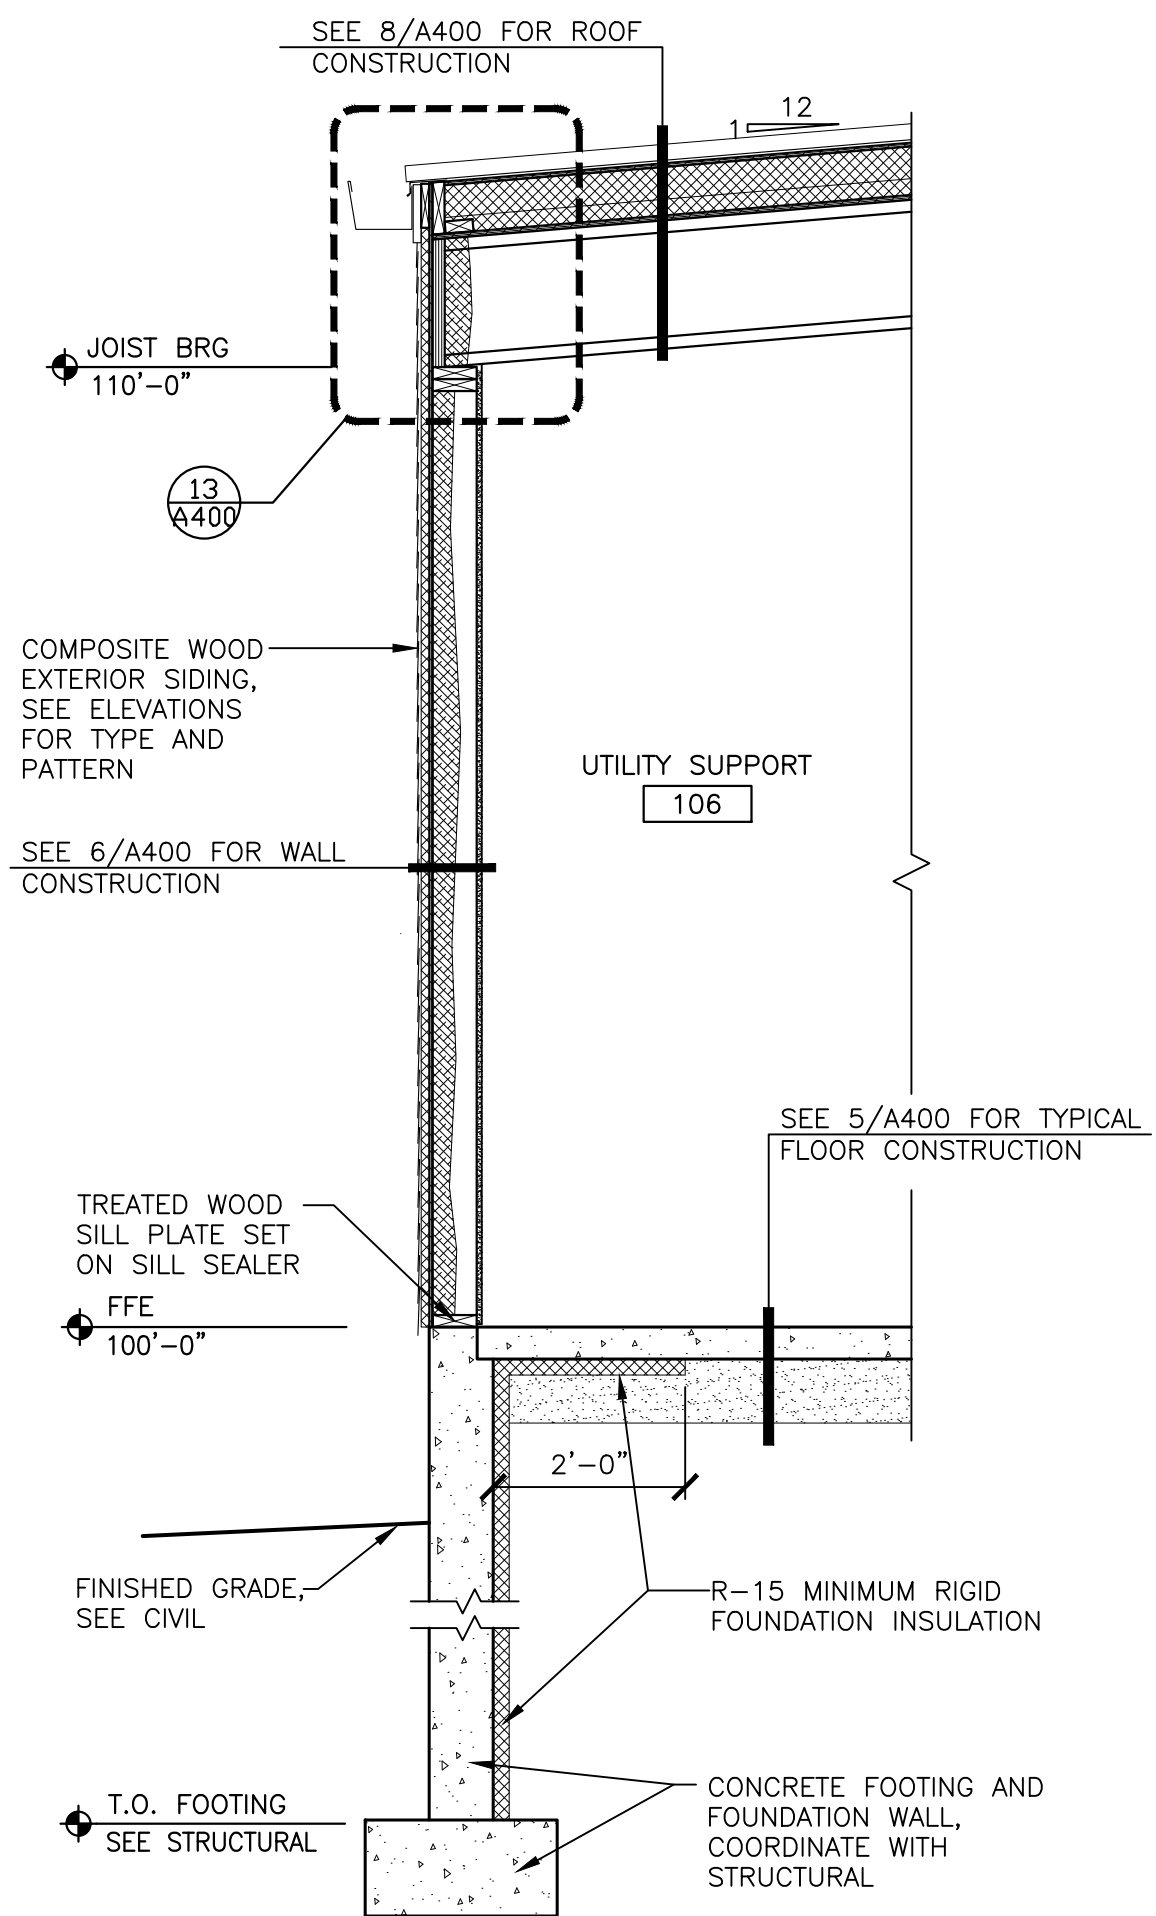

ROOM FINISH SCHEDULE											
NO.	ROOM NAME	FLOOR		BASE	WALL FINISH				CEILING		REMARKS
		MAT'L	FIN		NORTH	EAST	SOUTH	WEST	MAT'L	FIN	
100	VESTIBULE	CONC	PC	VB	PT	PT	PT	PT	GB	PT	Note 1
101	CENTRAL WAITING ROOM	CONC	PC	VB	PT	PT	PT	PT	ACP	—	Note 1, 2
102	OFFICE	CONC	PC	VB	PT	PT	PT	PT	ACP	—	Note 1
103	PILOT BRIEFING	CONC	PC	VB	PT	PT	PT	PT	ACP	—	Note 1
104	CONCESSIONS	CONC	SL	VB	PT	PT	PT	PT	GB	PT	Note 1
105	CORRIDOR	CONC	PC	VB	PT	PT	PT	PT	ACP	—	Note 1, 3
106	UTILITY SUPPORT	CONC	SL	VB	PT	PT	PT	PT	—	—	Note 1
107	FAMILY RESTROOM	CONC	PC	TILE-1	TILE-1/PT	TILE-1/PT	TILE-1/PT	TILE-1/PT	ACP	—	Note 1, 4, 5
108	CORRIDOR	CONC	PC	VB	PT	PT	PT	PT	ACP	—	Note 1, 3
109	FAMILY RESTROOM	CONC	PC	TILE-1	TILE-1/PT	TILE-1/PT	TILE-1/PT	TILE-1/PT	ACP	—	Note 1, 4, 5
110	PILOTS LOUNGE	CONC	PC	VB	PT	PT	PT	PT	ACP	—	Note 1,
111	EXISTING HANGAR	—	—	—	—	—	—	—	—	—	Note 1, 6

ROOM OPENING SCHEDULE														
OPEN NO.	LEAF'S	OPENING					FIRE RATING	FRAME					H.D.W.R. GROUP	REMARKS
		SIZE			TYPE	MAT'L		TYPE	MAT'L	DETAILS				
		WD	HGT	THK						HEAD	JAMB	SILL		
100A	1	3'-0"	7'-0"	1 3/4"	FG1	ALUM	—	ALUM	10/A500	9/A500	—	02		
100B	1	3'-0"	7'-0"	1 3/4"	FG2	ALUM	—	F5	ALUM		—	03	—	
101A	1	3'-0"	7'-0"	1 3/4"	FL	HM	—	F1	HM	5/A500	6/A500	—	04	NOTE 1
101B	1	3'-0"	7'-0"	1 3/4"	FG1	ALUM	—	F3	ALUM	10/A500	9/A500	—	02	—
102A	1	3'-0"	7'-0"	1 3/4"	FL	WD	—	F1	HM	4/A400 SIM	4/A400	—	08	NOTE 1
103	1	3'-0"	7'-0"	1 3/4"	FL	WD	—	F1	HM	4/A400 SIM	4/A400	—	08	NOTE 1
104A	1	4'-0"	7'-0"	1 3/4"	FG1	ALUM	—	F6	ALUM	10/A500	9/A500	—	01	—
104B	1	3'-0"	7'-0"	1 3/4"	FL	HM	—	F1	HM	4/A400 SIM	4/A400	—	09	NOTE 1
105	1	3'-0"	7'-0"	1 3/4"	FL	HM	—	F1	HM	8/A500	7/A500	—	05	NOTE 1
106	1	3'-0"	7'-0"	1 3/4"	FL	WD	—	F1	HM	4/A400 SIM	4/A400	—	09	NOTE 1
107	1	3'-0"	7'-0"	1 3/4"	FL	WD	—	F1	HM	4/A400 SIM	4/A400	—	06	NOTE 1
109	1	3'-0"	7'-0"	1 3/4"	FL	WD	—	F1	HM	4/A400 SIM	4/A400	—	06	NOTE 1
110	1	3'-0"	7'-0"	1 3/4"	FL	WD	—	F1	HM	4/A400 SIM	4/A400	—	07	NOTE 1
111	1	3'-0"	7'-0"	1 3/4"	FL	HM	—	F1	HM			—	04	NOTE 1


*PROVIDE ONE (1) HARDWARE GROUP 10

SCHEDULE NOTES:


- 1.) PAINT HOLLOW METAL DOOR AND FRAME BOTH SIDES
- 2.) SLOPE ACOUSTICAL CEILING, SEE CEILING PLAN
- 3.) PAINT GYPSUM BOARD BULKHEAD
- 4.) PROVIDE COVED TILE WALL BASE AND BULLNOSE WAINSCOT CAP
- 5.) SEE INTERIOR ELEVATIONS FOR HEIGHT OF WALL TILE WAINSCOT
- 6.) PAINT STEEL HANDRAILS

SCHEDULE LEGEND:

ALUM	ALUMINUM
ACP	ACOUSTICAL CEILING PANEL
CONC	CONCRETE
HM	HOLLOW METAL
PC	POLISHED CONCRETE
PT	PAINT
SL	SEALER
VB	VINYL BASE
WD	WOOD

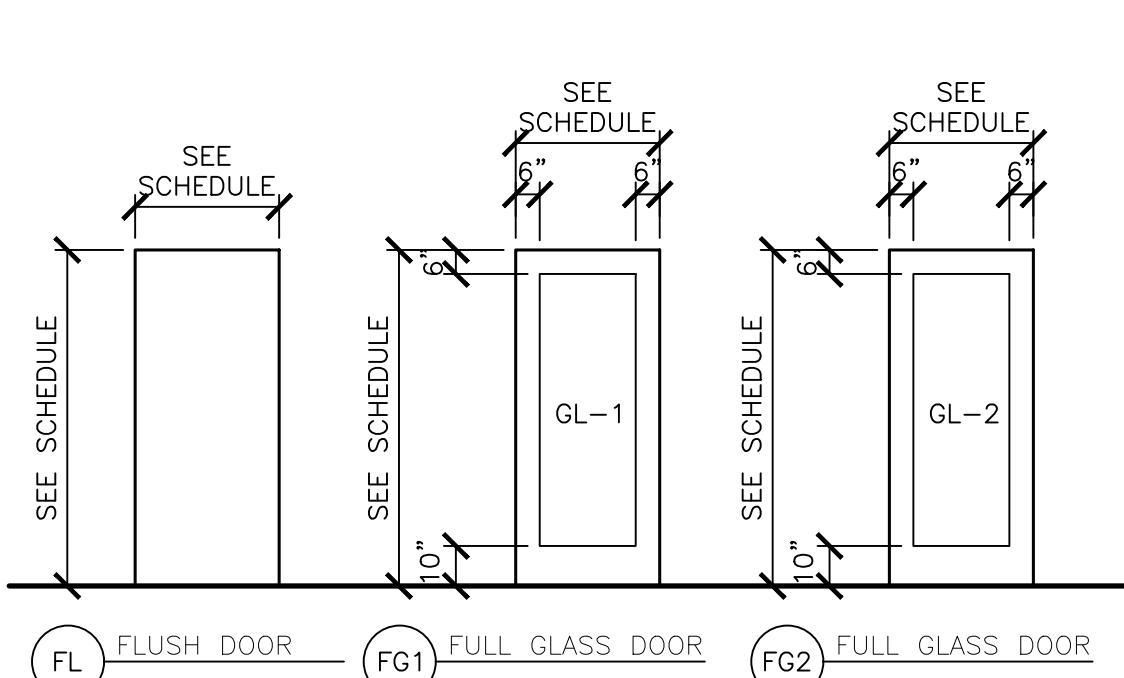


12 DOOR TYPES

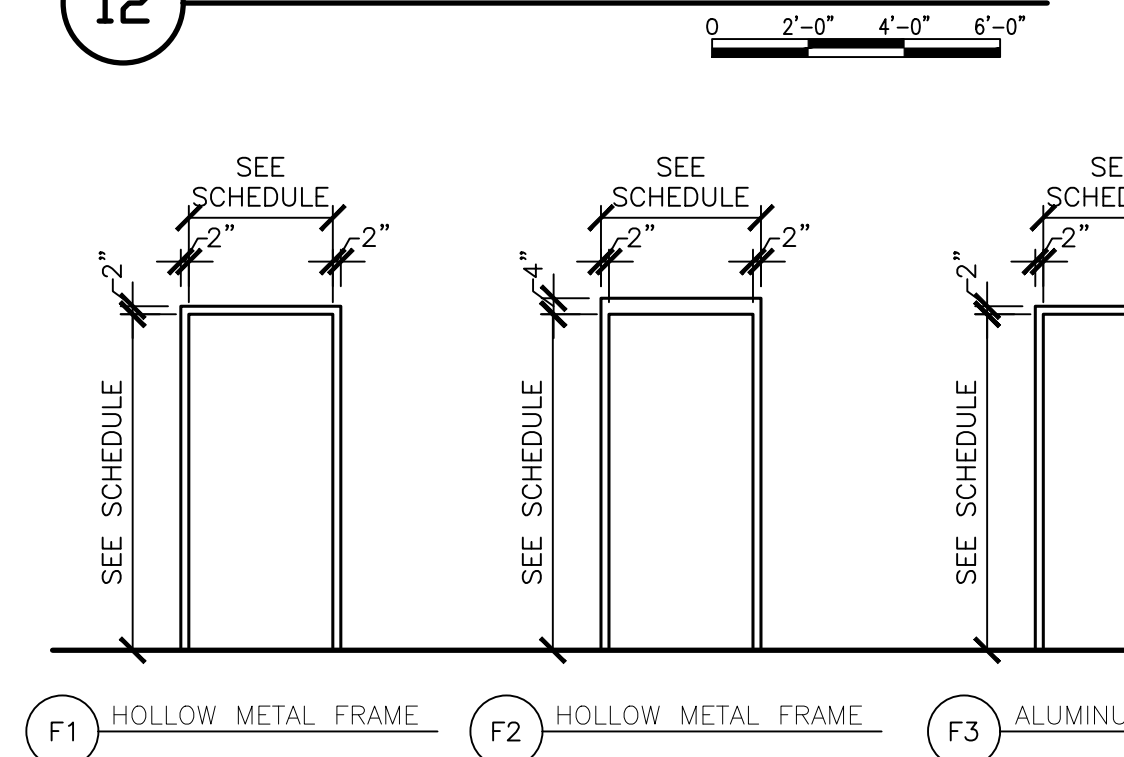


11 FRAME TYPES




13 WINDOW TYPES

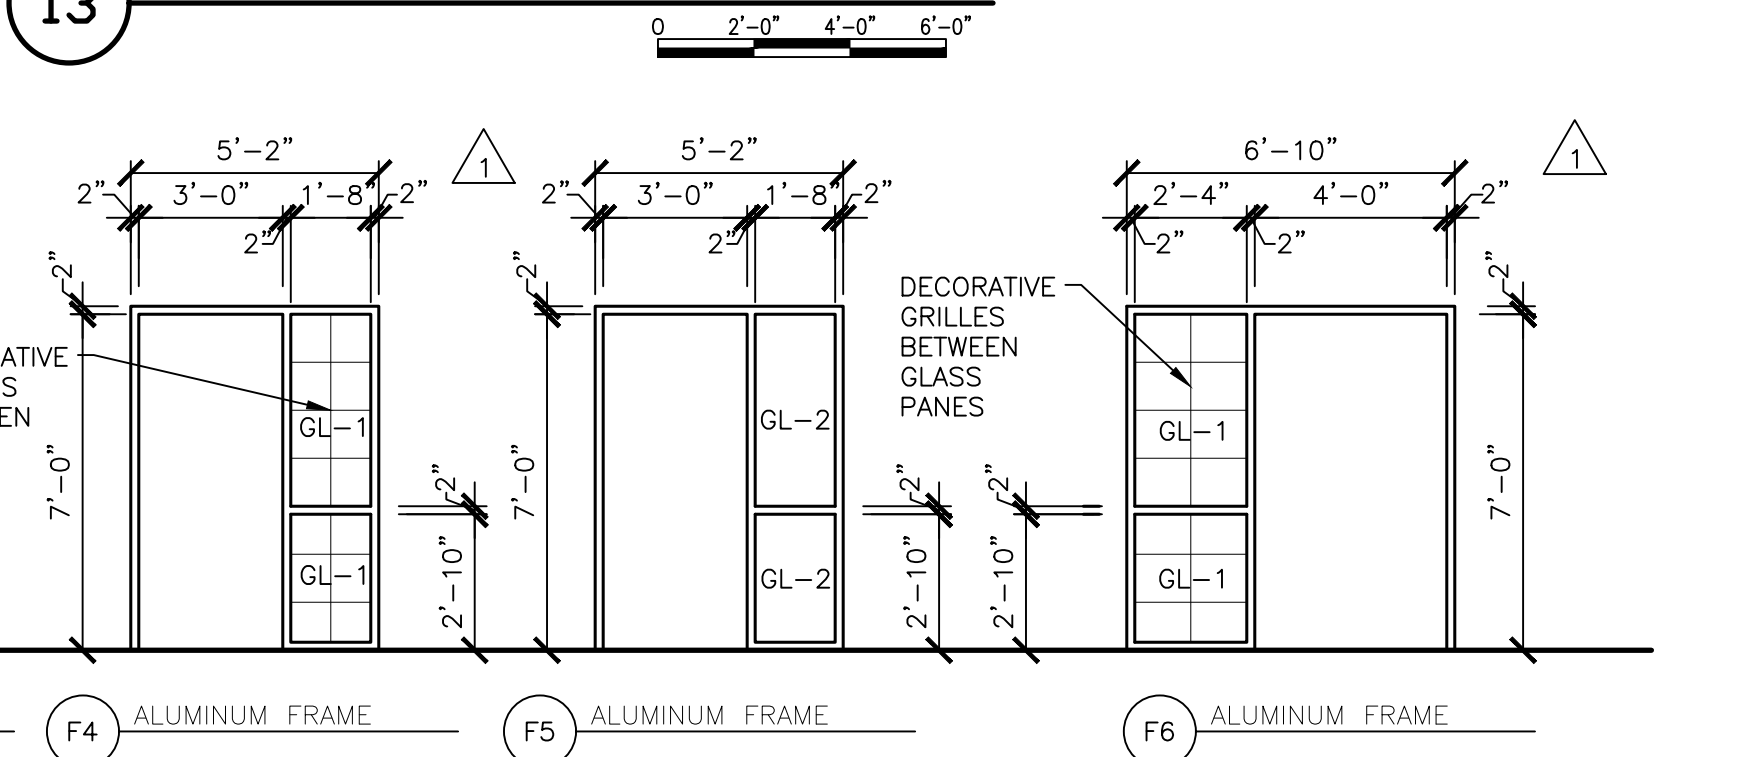


GLASS TYPES	
GL-1	1" THICK, INSULATED, TEMPERED GLASS
GL-2	1/2" THICK TEMPERED GLASS
GL-3	PRE-GLAZED WITH INSULATED GLASS, MULLION BETWEEN PANES

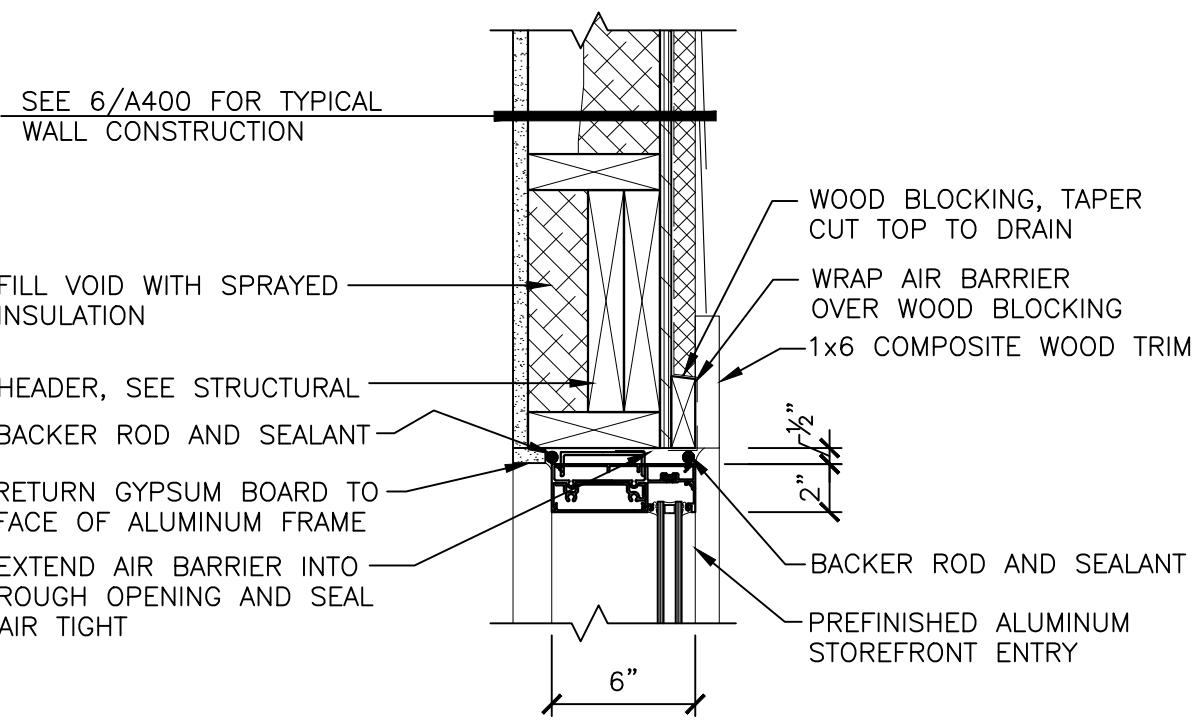


10 EXTERIOR STOREFRONT HEAD

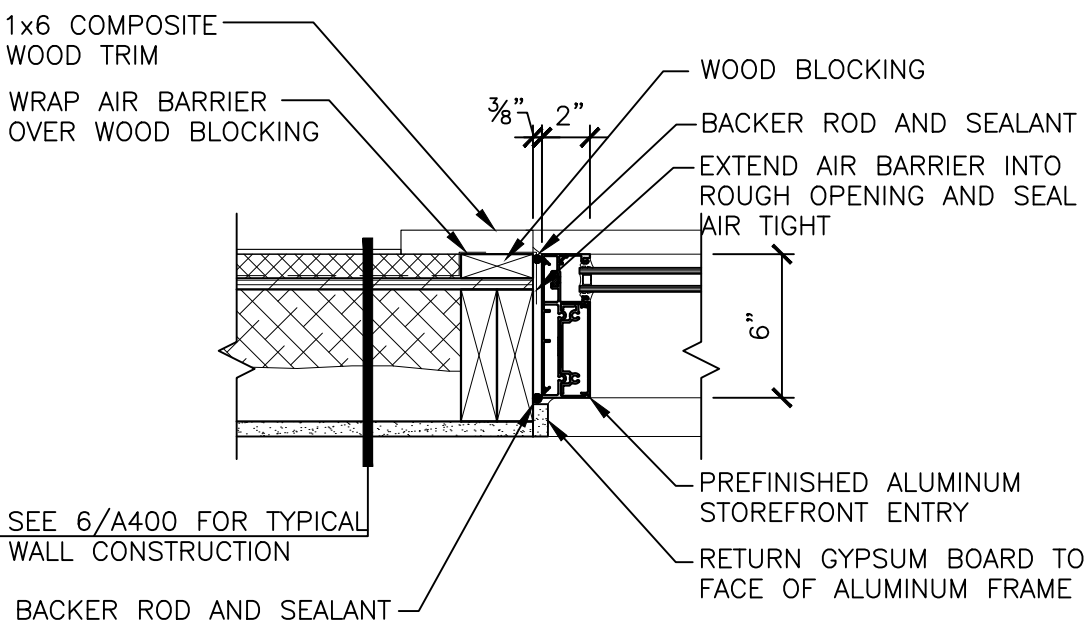


9 EXTERIOR STOREFRONT JAMB

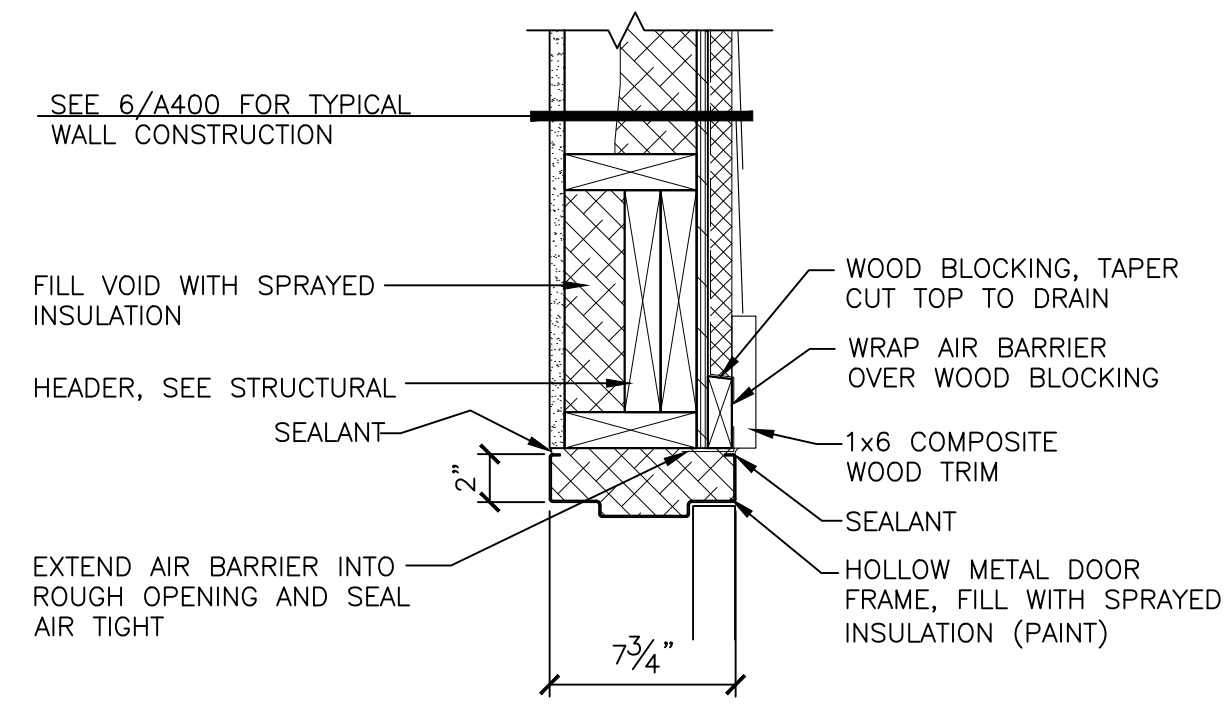


8 EXTERIOR HM DOOR HEAD

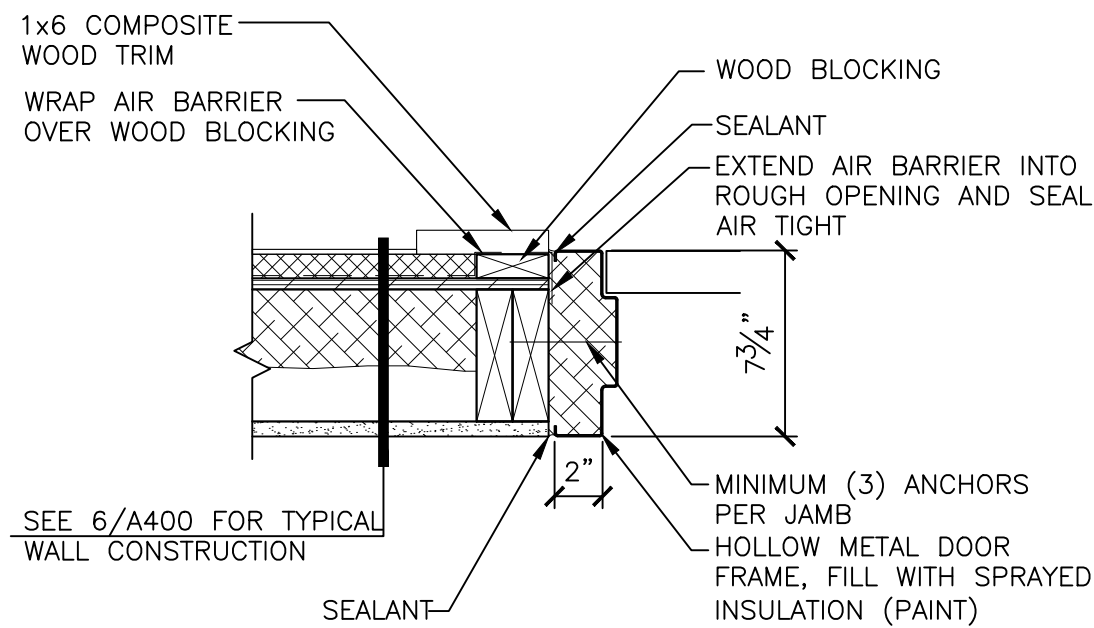


7 EXTERIOR HM DOOR JAMB

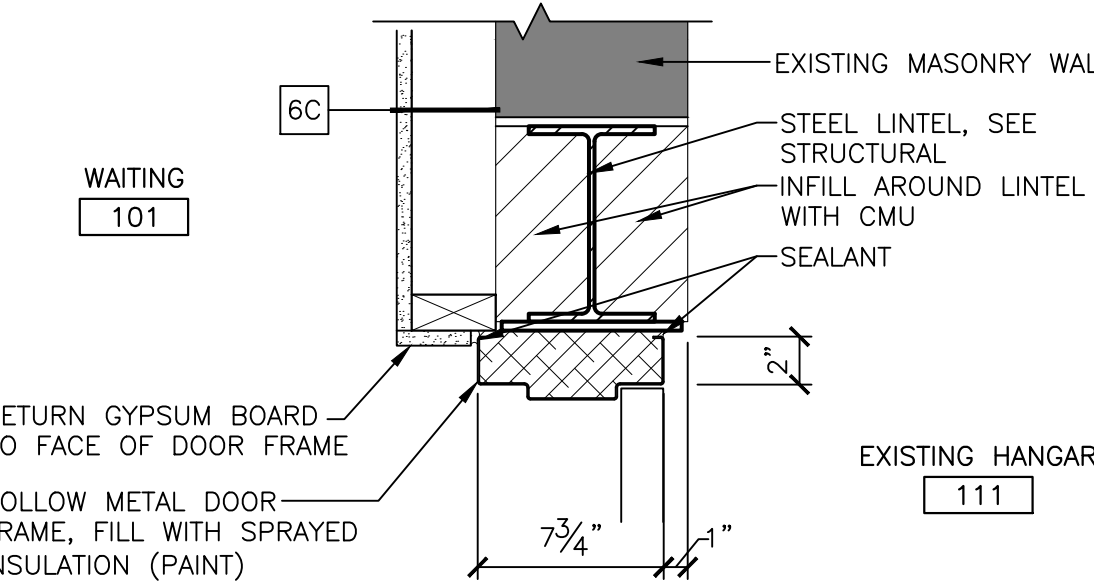


6 HM DOOR HEAD AT EXISTING

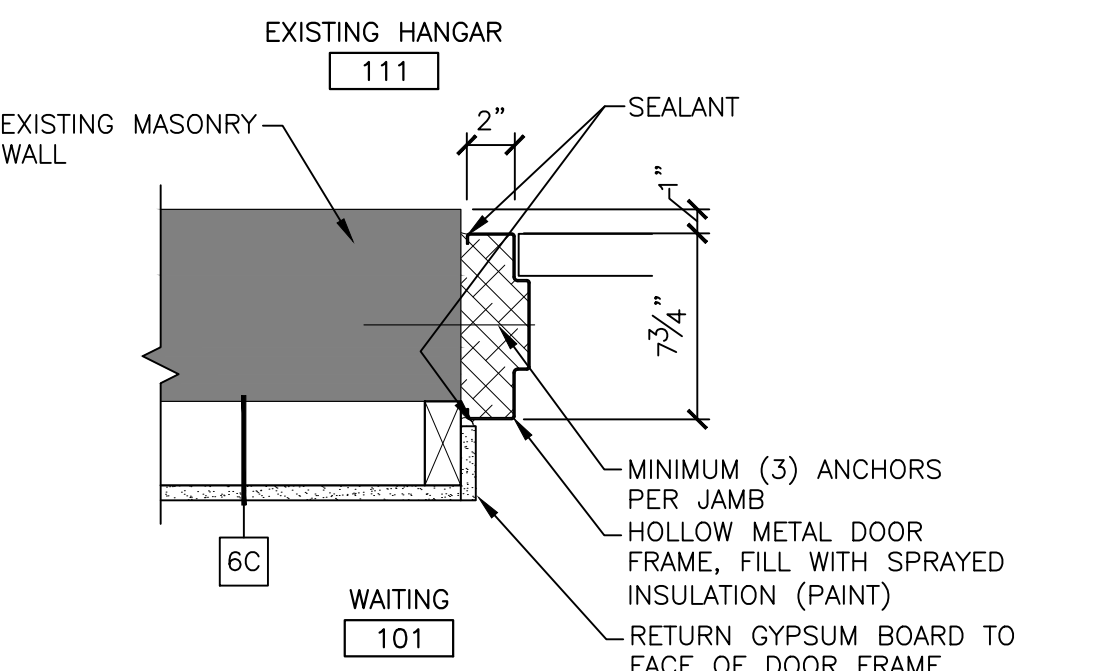



5 HM DOOR JAMB AT EXISTING

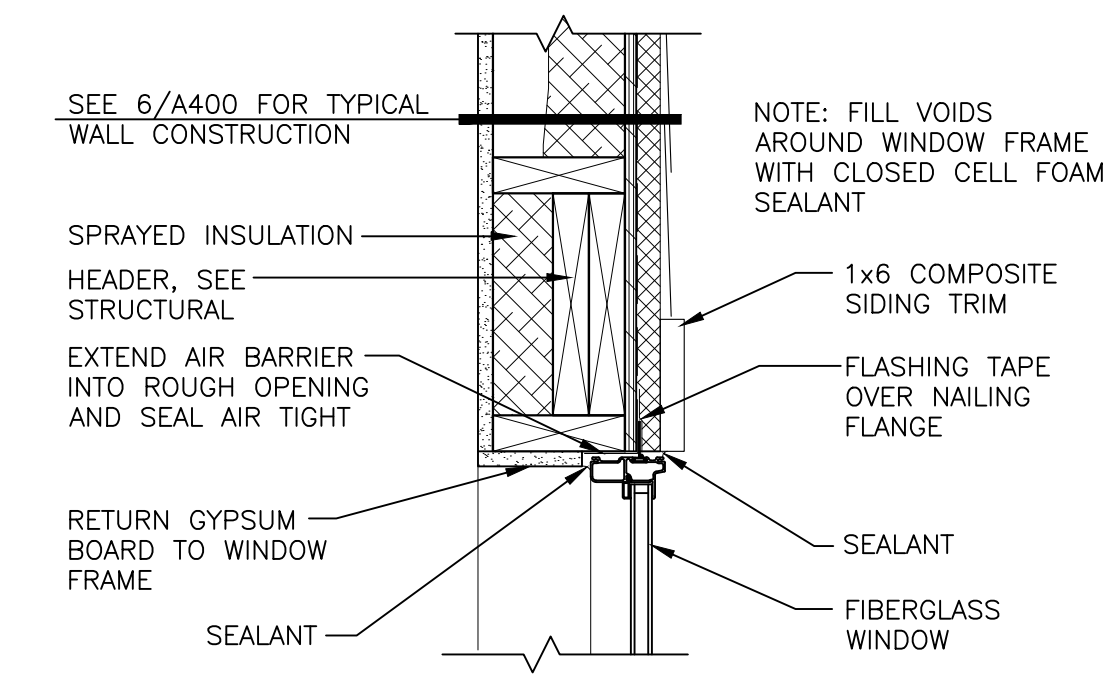


4 FIBERGLASS WINDOW HEAD

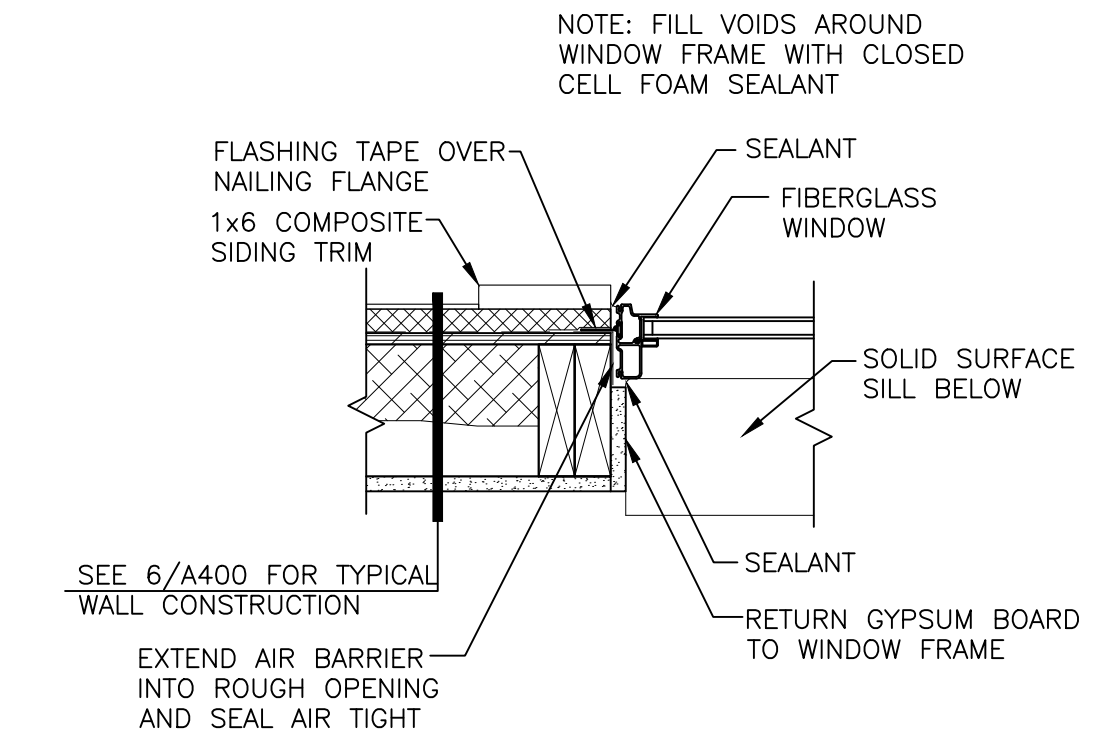

3 FIBERGLASS WINDOW JAMB

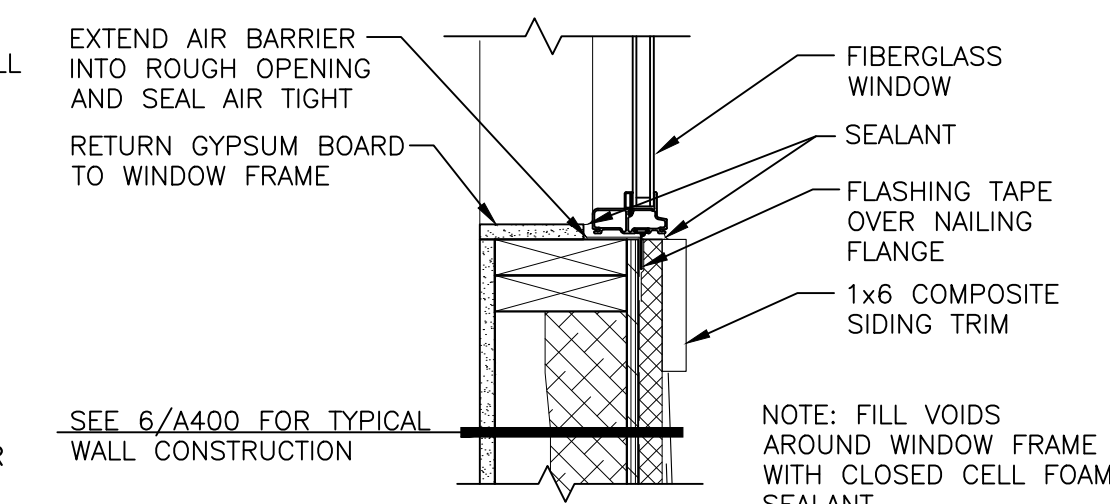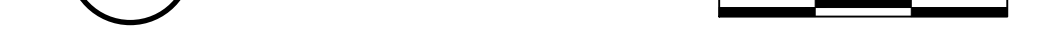

2 FIBERGLASS WINDOW SILL

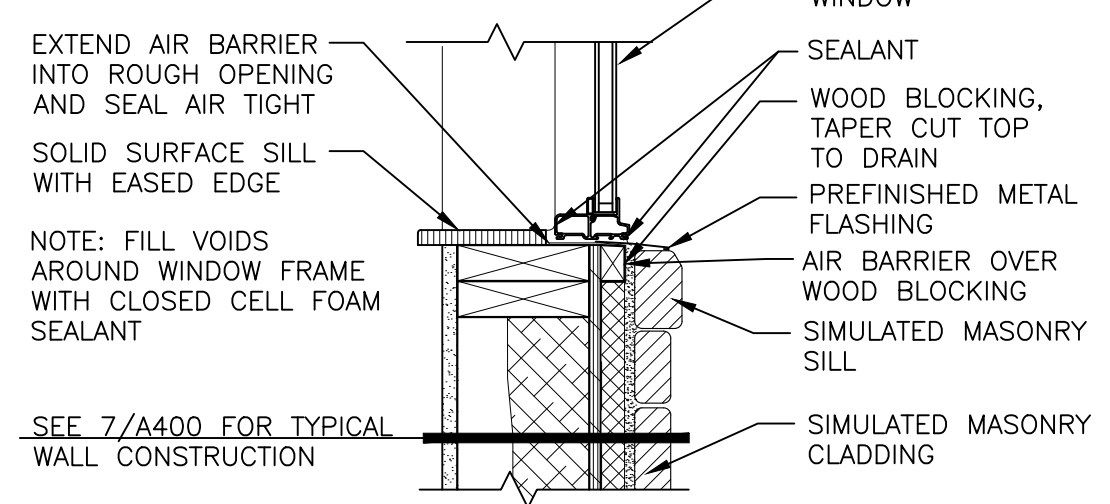

1 FIBERGLASS WINDOW SILL



SEH

I HEREBY CERTIFY THAT THIS PLAN, SPECIFICATION, OR REPORT WAS PREPARED BY ME OR UNDER MY DIRECT SUPERVISION AND THAT I AM A DULY LICENSED ARCHITECT UNDER THE LAWS OF THE STATE OF MINNESOTA.

Scott Blank, AIA

DATE: 5-16-2023 LICENSE NO.: 51092

DULUTH INTERNATIONAL AIRPORT

SKY HARBOR AIRPORT
2023 RECONSTRUCT TERMINAL BUILDING
DULUTH, MN

This drawing is an instrument of service and shall remain the property of Short Elliott Hendrickson, Inc. (SEH). This drawing, concepts and ideas contained herein shall not be used, reproduced, revised, or retained without the express written approval of SEH.

Submission or distribution of this drawing to meet official or regulatory requirements or for purposes in connection with the project is not to be construed as publication in derogation of any of the rights of SEH.

COPYRIGHT © 2023
Short Elliott Hendrickson, Inc.
All Rights Reserved


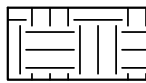




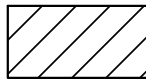

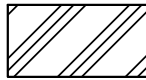
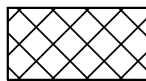
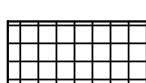
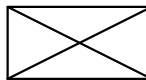
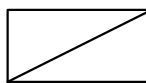

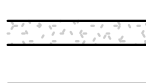










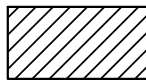


 












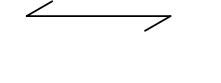

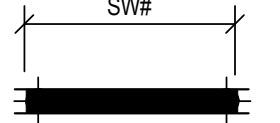
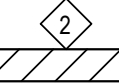
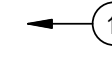







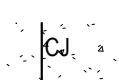
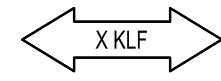
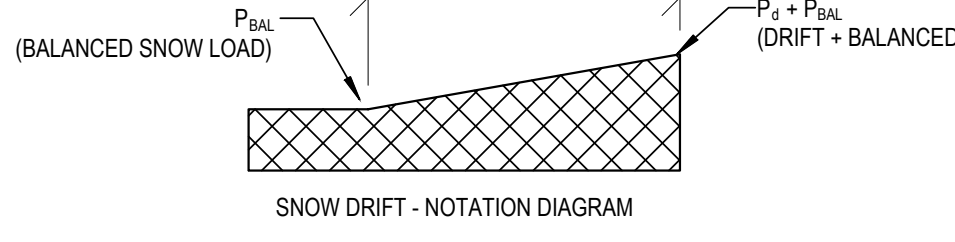
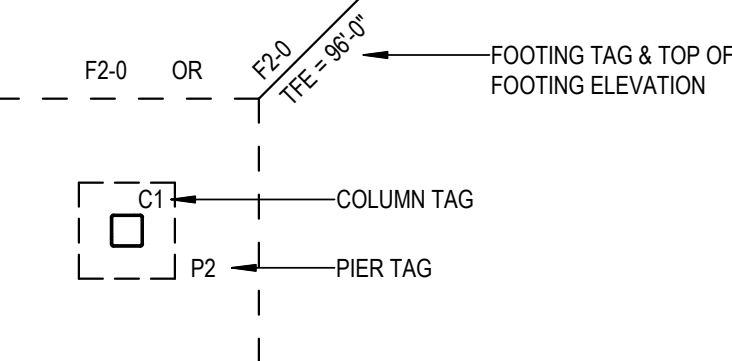
SEH Project	DULAL172133
Checked By	SB
Drawn By	BB

Project Status	Issue Date
CONSTRUCTION	5.16.23
PLANS	

REVISION SCHEDULE		
REV. #	DESCRIPTION	DATE
1	ADDENDUM #1	5.30.2023
2	ADDENDUM #2	6.2.2023

SCHEDULES, DOOR, WINDOW AND FRAME TYPES

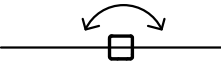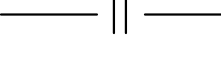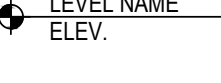A500

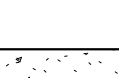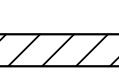 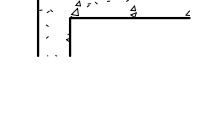ABBREVIATIONS			MATERIAL SYMBOLS			ANNOTATION SYMBOLS			STRUCTURAL SHEET INDEX		
<div><div><div>& L @ ∅ (E) # +/- SQ</div><div>AND ANGLE AT CENTERLINE DIAMETER/ROUND EXISTING POUND/NUMBER PLUS OR MINUS SQUARE</div><div>AB ADD ADDL ADH ADJ ADJA AGGR ALUM ALT ANCH ANG ANOD APPROX ARCH ASPH</div><div>ANCHOR BOLT ADDENDUM ADDITIONAL ADHESIVE ADJUSTABLE ADJACENT AGGREGATE ALUMINUM ALTER OR ALTERNATE ANCHOR ANGLE ANODIZED APPROXIMATE ARCHITECTURAL ASPHALT (PAVING)</div></div><div><div>E EA EF EJ EL ELEC ELEV ENCL EQ EQPT EW EXP EXIST EXT EXTN</div><div>EAST EACH EACH FACE EXPANSION JOINT ELEVATION ELECTRICAL ELEVATION ENCLOSURE EQUAL EQUIPMENT EACH WAY EXPANSION EXISTING EXTERIOR EXTENSION</div><div>FD FFE FH FL FND FR FRP FS FT FTG FV</div><div>FLOOR DRAIN FINISHED FLOOR ELEVATION FLAT HEAD FLOOR FOUNDATION FRAME FIBERGLASS REINFORCED POLYESTER/PLASTIC FOOTING STEP FOOT/FEET FOOTING FIELD VERIFY</div></div><div><div>GA GAL GALV GC GB GEN GP GR</div><div>GAUGE GALLON GALVANIZED GENERAL CONTRACTOR GRADE BEAM GENERATOR GUSSET PLATE GRADE</div></div><div><div>H HC HD HEF HIF HOF HORIZ HR HS HSS</div><div>HEIGHT/HIGH HOLLOW CORE HEAD HORIZONTAL EACH FACE HORIZONTAL INSIDE FACE HORIZONTAL OUTSIDE FACE HORIZONTAL HOUR HEADED STUD HOLLOW STRUCTURAL SHAPE</div></div><div><div>ID IN INFO INSUL INT INV</div><div>INSIDE DIAMETER (DIMENSION) INCH INFORMATION INSULATION INTERIOR INVERT</div></div><div><div>JBE JGBE JST JT</div><div>JOIST BEARING ELEVATION JOIST GIRDER BEARING ELEVATION JOIST JOINT</div></div></div> <div><div>K KG KM KW</div><div>KIPS KILOGRAM KILOMETER KNOCK-OUT KILOWATT</div><div>L L# LB LF LL LLH LLV LOC LONG LTL LVR</div><div>LENGTH/LONG LINTEL POUND LINEAL FOOT LIVE LOAD LONG LEG HORIZONTAL LONG LEG VERTICAL LOCATION LONGITUDINAL LINTEL LOUVER</div><div>MAS MATL MAX MECH MEMB MFR MFG MH MIN MISC MM MTL</div><div>MASONRY MATERIAL MAXIMUM MECHANICAL MEMBRANE MANUFACTURER MANUFACTURING MANHOLE MINIMUM MISCELLANEOUS MILLIMETER METAL</div><div>N NIC NO NOM NS NTS</div><div>NORTH NOT IN CONTRACT NUMBER NOMINAL NO SCALE NOT TO SCALE</div></div> <div><div>OA OC OD</div><div>OVERALL ON CENTER OUTSIDE DIAMETER (DIMENSION)</div><div>OPNG OPP OVHD</div><div>OPENING OPPOSITE OVERHEAD</div><div>PC PCF PERIM PERP PL PLYWD PNL PREFAB PSI PSF</div><div>PRECAST POUNDS PER CUBIC FOOT PERIMETER PERPENDICULAR PLATE PLYWOOD PANEL PREFABRICATED POUNDS PER SQUARE INCH POUNDS PER SQUARE FOOT</div></div> <div><div>QT</div><div>QUARRY TILE</div></div> <div><div>R RAD REF REINF REQ REV RH RLG RM RO RTU</div><div>RISER RADIUS REFERENCE/REFER REINFORCED/REINFORCING REQUIRED REVISED/REVISION ROUND HEAD RAILING ROOM ROUGH OPENING ROOF TOP UNIT</div></div>	<div><div><div> GRAVEL</div><div> SOIL</div><div> BASE COURSE, SUB-BASE, GRAVEL, CRUSHED ROCK</div><div> CONCRETE</div><div> BRICK MASONRY</div><div> CUT STONE, SAND, MORTAR, PLASTER</div><div> CONCRETE MASONRY UNITS</div><div> STEEL</div><div> ALUMINUM (OMIT IN THIN MATERIAL)</div><div> INSULATION BOARD</div><div> RIGID INSULATION</div><div> WOOD FRAMING THROUGH MEMBER</div><div> WOOD FRAMING INTERRUPTED MEMBER</div><div> PLYWOOD</div><div> GYPSUM BOARD</div><div> PARTICLE BOARD</div></div><div><div><div> SCHED SECTION</div><div>SOUTH SCHEDULE SECTION STRUCTURAL ENGINEER OF RECORD SQUARE FOOT SHEET SIMILAR SLOPE SEALANT SHORT LEG HORIZONTAL SHORT LEG VERTICAL SQUARE METER SLAB ON GRADE SPACED SPECIFICATIONS SQUARE STAINLESS STEEL STANDARD STEEL STRUCTURE/STRUCTURAL SUSPEND/SUSPENDED SYMMETRICAL</div><div>T T&B TBE TD TFE THK THR THRD TOS TRANS TSE TWE TYP UNO</div><div>TREAD TOP AND BOTTOM TOP OF BEAM ELEVATION TRENCH DRAIN TOP OF FOOTING ELEVATION THICK/THICKNESS THRESHOLD THREADED TOP OF STEEL TRANSVERSE TOP OF SLAB ELEVATION TOP OF WALL ELEVATION TYPICAL UNLESS NOTED OTHERWISE</div></div><div><div> VAR VARIES</div><div> VEF VERTICAL EACH FACE</div><div> VERT VERTICAL</div><div> VIF VERTICAL INSIDE FACE OR VERIFY IN FIELD</div><div> VL# VENEER LINTEL</div><div> VLE VENEER LEDGE ELEVATION</div><div> VLS VENEER LEDGE STEP</div><div> VOF VERTICAL OUTSIDE FACE</div><div> VOL VOLUME</div></div><div><div> W WEST/WIDTH/WIDE</div><div> WF WIDE FLANGE (STEEL)</div><div> WF WIDE FLANGE (ALUMINUM)</div><div> WITH WITH</div><div> W/O WITHOUT</div><div> WP WATERPROOF</div><div> WPM WATERPROOF MEMBRANE</div><div> WS WATER STOP</div><div> WR WATER RESISTANT</div><div> WT WEIGHT</div><div> WWF WELDED WIRE FABRIC</div></div></div></div> <div><div><div> BEAM CONTINUOUS OVER COLUMN</div><div> BEAM SPLICE</div><div> LEVEL NAME ELEV. LEVEL / ELEVATION REFERENCE</div><div> GRID GRID REFERENCE</div><div> SPAN DIRECTION</div><div> RFI # REVISION CLOUD & TAG</div><div> SW# WOOD WALL SHEARWALL WITH HOLD-DOWN LOCATIONS</div><div> 2 MASONRY SHEARWALL DESIGNATION</div><div> 1 PLAN KEYNOTE</div><div> ### KEYNOTE TAG</div><div> --- EXISTING CONSTRUCTION TO BE DEMOLISHED</div><div> --- EXISTING CONSTRUCTION TO REMAIN</div><div> --- NEW CONCRETE CONSTRUCTION</div><div> --- CONCRETE MASONRY WALL</div><div> ALL DIMENSIONS ARE TO FACE OF FOUNDATION UNLESS NOTED OTHERWISE</div><div> LOCATION OF RE-ENTRANT CORNER BAR</div><div> C/J LOCATION OF CONTROL / CONTRACTION JOINT IN CONCRETE SURFACE</div><div> X KLF UNFACTORED WIND SHEAR LOAD</div><div> P_{DRIFT} P_D + P_{BL} (BALANCED SNOW LOAD) (DRIFT + BALANCEE) SNOW DRIFT - NOTATION DIAGRAM</div><div> F2-0 OR P2-0 T/FEE = 96'-0" FOOTING TAG & TOP OF FOOTING ELEVATION C1 P2 COLUMN TAG PIER TAG</div></div></div> <div><div><div><div><div><div>1</div><div>S101</div></div><div>WALL SECTION NUMBER</div><div>WALL SECTION SHEET</div></div><div><div><div>1</div><div>S101</div></div><div>DETAIL NUMBER</div><div>DETAIL SHEET</div></div><div><div><div>1</div><div>S101</div></div><div>BUILDING SECTION NUMBER</div><div>BUILDING SECTION SHEET</div></div><div><div><div>1</div><div>S101</div></div><div>DETAIL OR SECTION NUMBER</div><div>DETAIL OR SECTION SHEET</div></div><div><div><div>1</div><div>S101</div></div><div>EXTERIOR ELEVATION NUMBER</div><div>EXTERIOR ELEVATION SHEET</div></div><div><div><div>X</div><div>A101</div></div><div>INTERIOR ELEVATION NUMBER</div><div>INTERIOR ELEVATION SHEET</div></div></div></div></div>										

S
SCHD
SECT
SER
SF
SHT
SIM
SL
SLNT
SLH
SLV
SM
SOG
SP
SPEC
SQ
SS
STD
STEEL
STRUC
SUSP
SYM

SCHEDULE
SECTION
STRUCTURAL ENGINEER OF RECORD
SQUARE FOOT
SHEET
SIMILAR
SLOPE
SEALANT
SHORT LEG HORIZONTAL
SHORT LEG VERTICAL
SQUARE METER
SLAB ON GRADE
SPACED
SPECIFICATIONS
SQUARE
STAINLESS STEEL
STANDARD
STEEL
STRUCTURE/STRUCTURAL
SUSPEND/SUSPENDED
SYMMETRICAL

T
T&B
TBE
TD
TFE
THK
THR
THRD
TOS
TRANS
TSE
TWE
TYP

TREAD
TOP AND BOTTOM
TOP OF BEAM ELEVATION
TRENCH DRAIN
TOP OF FOOTING ELEVATION
THICK/THICKNESS
THRESHOLD
THREADED
TOP OF STEEL
TRANSVERSE
TOP OF SLAB ELEVATION
TOP OF WALL ELEVATION
TYPICAL

UNO

UNLESS NOTED OTHERWISE

VAR
VEF
VERT
VIF
VL#
VLE
VLS
VOF
VOL

VARIES
VERTICAL EACH FACE
VERTICAL
VERTICAL INSIDE FACE OR
VERIFY IN FIELD
VENEER LINTEL
VENEER LEDGE ELEVATION
VENEER LEDGE STEP
VERTICAL OUTSIDE FACE
VOLUME

W
W
WF
W/
WITH
W/O
WP
WPM
WS
WR
WT
WWF

WEST/WIDTH/WIDE
WIDE FLANGE (STEEL)
WIDE FLANGE (ALUMINUM)
WITH
WITHOUT
WATERPROOF
WATERPROOF MEMBRANE
WATER STOP
WATER RESISTANT
WEIGHT
WELDED WIRE FABRIC



I HEREBY CERTIFY THAT THIS PLAN, SPECIFICATION, OR REPORT WAS PREPARED BY ME OR UNDER MY DIRECT SUPERVISION AND THAT I AM A DULY LICENSED ENGINEER UNDER THE LAWS OF THE STATE OF MINNESOTA.



BENJAMIN A. WOLF
DATE 5/16/2023 LICENSE NO. 40807



DULUTH INTERNATIONAL AIRPORT

SKY HARBOR AIRPORT
2023 RECONSTRUCT TERMINAL BUILDING
DULUTH, MN

This drawing is an instrument of service and shall remain the property of Short Elliott Hendrickson, Inc. (SEH). This drawing, concepts and ideas contained herein shall not be used, reproduced, revised, or retained without the express written approval of SEH.

Submission or distribution of this drawing to meet official or regulatory requirements or for purposes in connection with the project is not be construed as publication in derogation of any of the rights of SEH.

COPYRIGHT © 2023
Short Elliott Hendrickson, Inc.
All Rights Reserved

SEH Project
Checked By
Drawn By

DULAL172133
BW
JS

Project Status
CONSTRUCTION PLANS

Issue Date
5/16/2023

REVISION SCHEDULE

REV. #	DESCRIPTION	DATE
1	ADDENDUM #2	6.2.2023

GENERAL ABBREVIATIONS AND SYMBOLS

S001

COLUMN SCHEDULE					
MARK	DESIGNATION	BASE PLATE	ANCHOR RODS	TOP PLATE	NOTES
C1	HSS8x8x1/4	14"x14"x1/2" THICK	(4) 3/4"Ø	N/A	SEE DETAILS
C2	HSS8x4x1/4	SEE DETAILS	(4) 3/4"Ø	N/A	SEE DETAILS

FOOTING SCHEDULE		
MARK	SIZE	REINFORCING
F1	CONT. 1'-4" x 10" DEEP	(2) CONT. #4 REBAR, BOTTOM
F2	CONT. 2'-0" x 1'-0" DEEP	(3) CONT. #5 REBAR, BOTTOM
F3	CONT. 3'-0" x 1'-0" DEEP	(4) CONT. #5 REBAR, BOTTOM
F4	2'-6" x 2'-6" x 1'-0" DEEP	(4) #5 REBAR EACH WAY, BOTTOM
F5	3'-0" x 3'-0" x 1'-0" DEEP	(4) #5 REBAR EACH WAY, BOTTOM


FOUNDATION PLAN NOTES:

(TYPICAL UNLESS NOTED OTHERWISE)

- FINISH LOWER LEVEL ELEVATION = 100'-0" (U.N.O.)
(ELEVATIONS AT PERIMETER - SEE CIVIL FOR SPOT ELEVATIONS)
- FORM CONTRACTION JOINTS (C.J.) OR SAWCUT WITHIN 18 HOURS OF CONCRETE PLACEMENT - SEE D/S501
MAXIMUM SPACING OF CONTRACTION JOINTS TO BE 15'-0"
- VERIFY ALL DIMENSIONS WITH ARCHITECTURAL DRAWINGS.
- VERIFY ALL SIZES AND LOCATIONS OF OPENINGS WITH ARCHITECTURAL DRAWINGS.
- TOP OF FOOTING ELEVATION (TFE) =
INTERIOR: 98'-0" U.N.O.
EXTERIOR: 95'-0" U.N.O.
- DESIGN ALLOWABLE SOIL BEARING CAPACITY: (REF. GEOTECH REPORT)
MAIN BUILDING ELEMENTS: 2,500 psf
- STEPPED FOOTING DETAIL - SEE C/S501. USE WHERE NEEDED TO MAINTAIN BOTTOM OF FOOTING DEPTH OF 5'-0" MIN. BELOW GRADE.
- CONTRACTOR OPTIONS AT MECHANICAL & ELECTRICAL LINES THROUGH FOUNDATION - SEE A/S501 AND B/S501.
- TFE= TOP OF FOOTING ELEVATION
TSE= TOP OF SLAB ELEVATION
TPE= TOP OF PIER ELEVATION
TWE= TOP OF WALL ELEVATION
FS= FOOTING STEP
CJ= CONTROL JOINT
- Fx DENOTES FOOTING TYPE.
REF. SCHEDULES ON THIS SHEET AND DETAILS.
- CONTRACTOR TO IMMEDIATELY CONTACT STRUCTURAL ENGINEER FOR FIELD VERIFICATION IF EXISTING CONDITIONS VARY FROM THOSE INDICATED IN THESE DOCUMENTS. ASSUMPTIONS MADE HERE WITHIN HAVE BEEN BASED UPON LIMITED EXISTING DOCUMENTATION.
- SEE DETAIL H/S501 FOR TYPICAL STOOP DETAIL.
- SEE DETAIL G/S501 FOR TYPICAL CONCRETE WALL CORNER REINFORCING.
- SEE DETAIL F/S501 FOR TYPICAL REINFORCING AT PENETRATION CAST INTO CONCRETE WALL OR SLAB.
- DESIGNATED SHEARWALL HOLD-DOWN TO FOUNDATION WALL - SEE FRAMING PLAN AND SHEARWALL SECTIONS AND DETAILS.

FOUNDATION PLAN KEYNOTES:

- PROVIDE (1) #4 REBAR x 2'-0" LONG AT EACH RE-ENTRANT CORNER AND WHERE CONTROL JOINTS TERMINATE AWAY FROM SLAB EDGE. SEE DETAIL E/S501.
- HSS4x4x3/8 POST.
- DRAIN LOCATION FOR SERVICE BASIN - SEE PLUMBING AND ARCHITECTURAL DRAWINGS.
- (3) 2x6 POST.
- TYPICAL PATIO PIERS: 1'-8" x 1'-8" CONCRETE PIER
EXTEND TO FROST FOOTING EL. (AS SHOWN ON PLAN)
(8) #6 REBAR VERTICAL
#3 TIES AT 12" OC PLUS (3) AT 2" OC AT TOP
- FLOOR DRAIN - SEE MECHANICAL DRAWINGS.
- 6" CONCRETE RAMP AND STAIR ON GRADE. REINFORCE WITH #4 REBAR AT 12" OC EW. PROVIDE MIN. 12" WIDE THICKENED EDGES AT ALL EDGES OF RAMP AND AT HEIGHT TRANSITIONS. THICKENED EDGE SHALL EXTEND MIN. 12" BELOW ADJACENT FINISHED GRADE OR AT TOP OF SLAB, WHICHEVER IS LOWER. REINFORCE THICKENED EDGE WITH (2) #5 REBAR TOP AND BOTTOM. SEE DETAIL F/S504.
- 4" CONCRETE LANDING AND RAMP WITH 6" EDGE WALLS. RIGID INSULATION TO FILL BETWEEN EXISTING SLAB AND CONCRETE. REINFORCE WITH #4 REBAR AT 12" OC EACH WAY, DOWELED TO SLAB AT EDGES. CUT EXISTING SLAB DOWN 2" AT BASE OF RAMP TO CREATE SMOOTH TRANSITION. SEE ARCH SECTION.

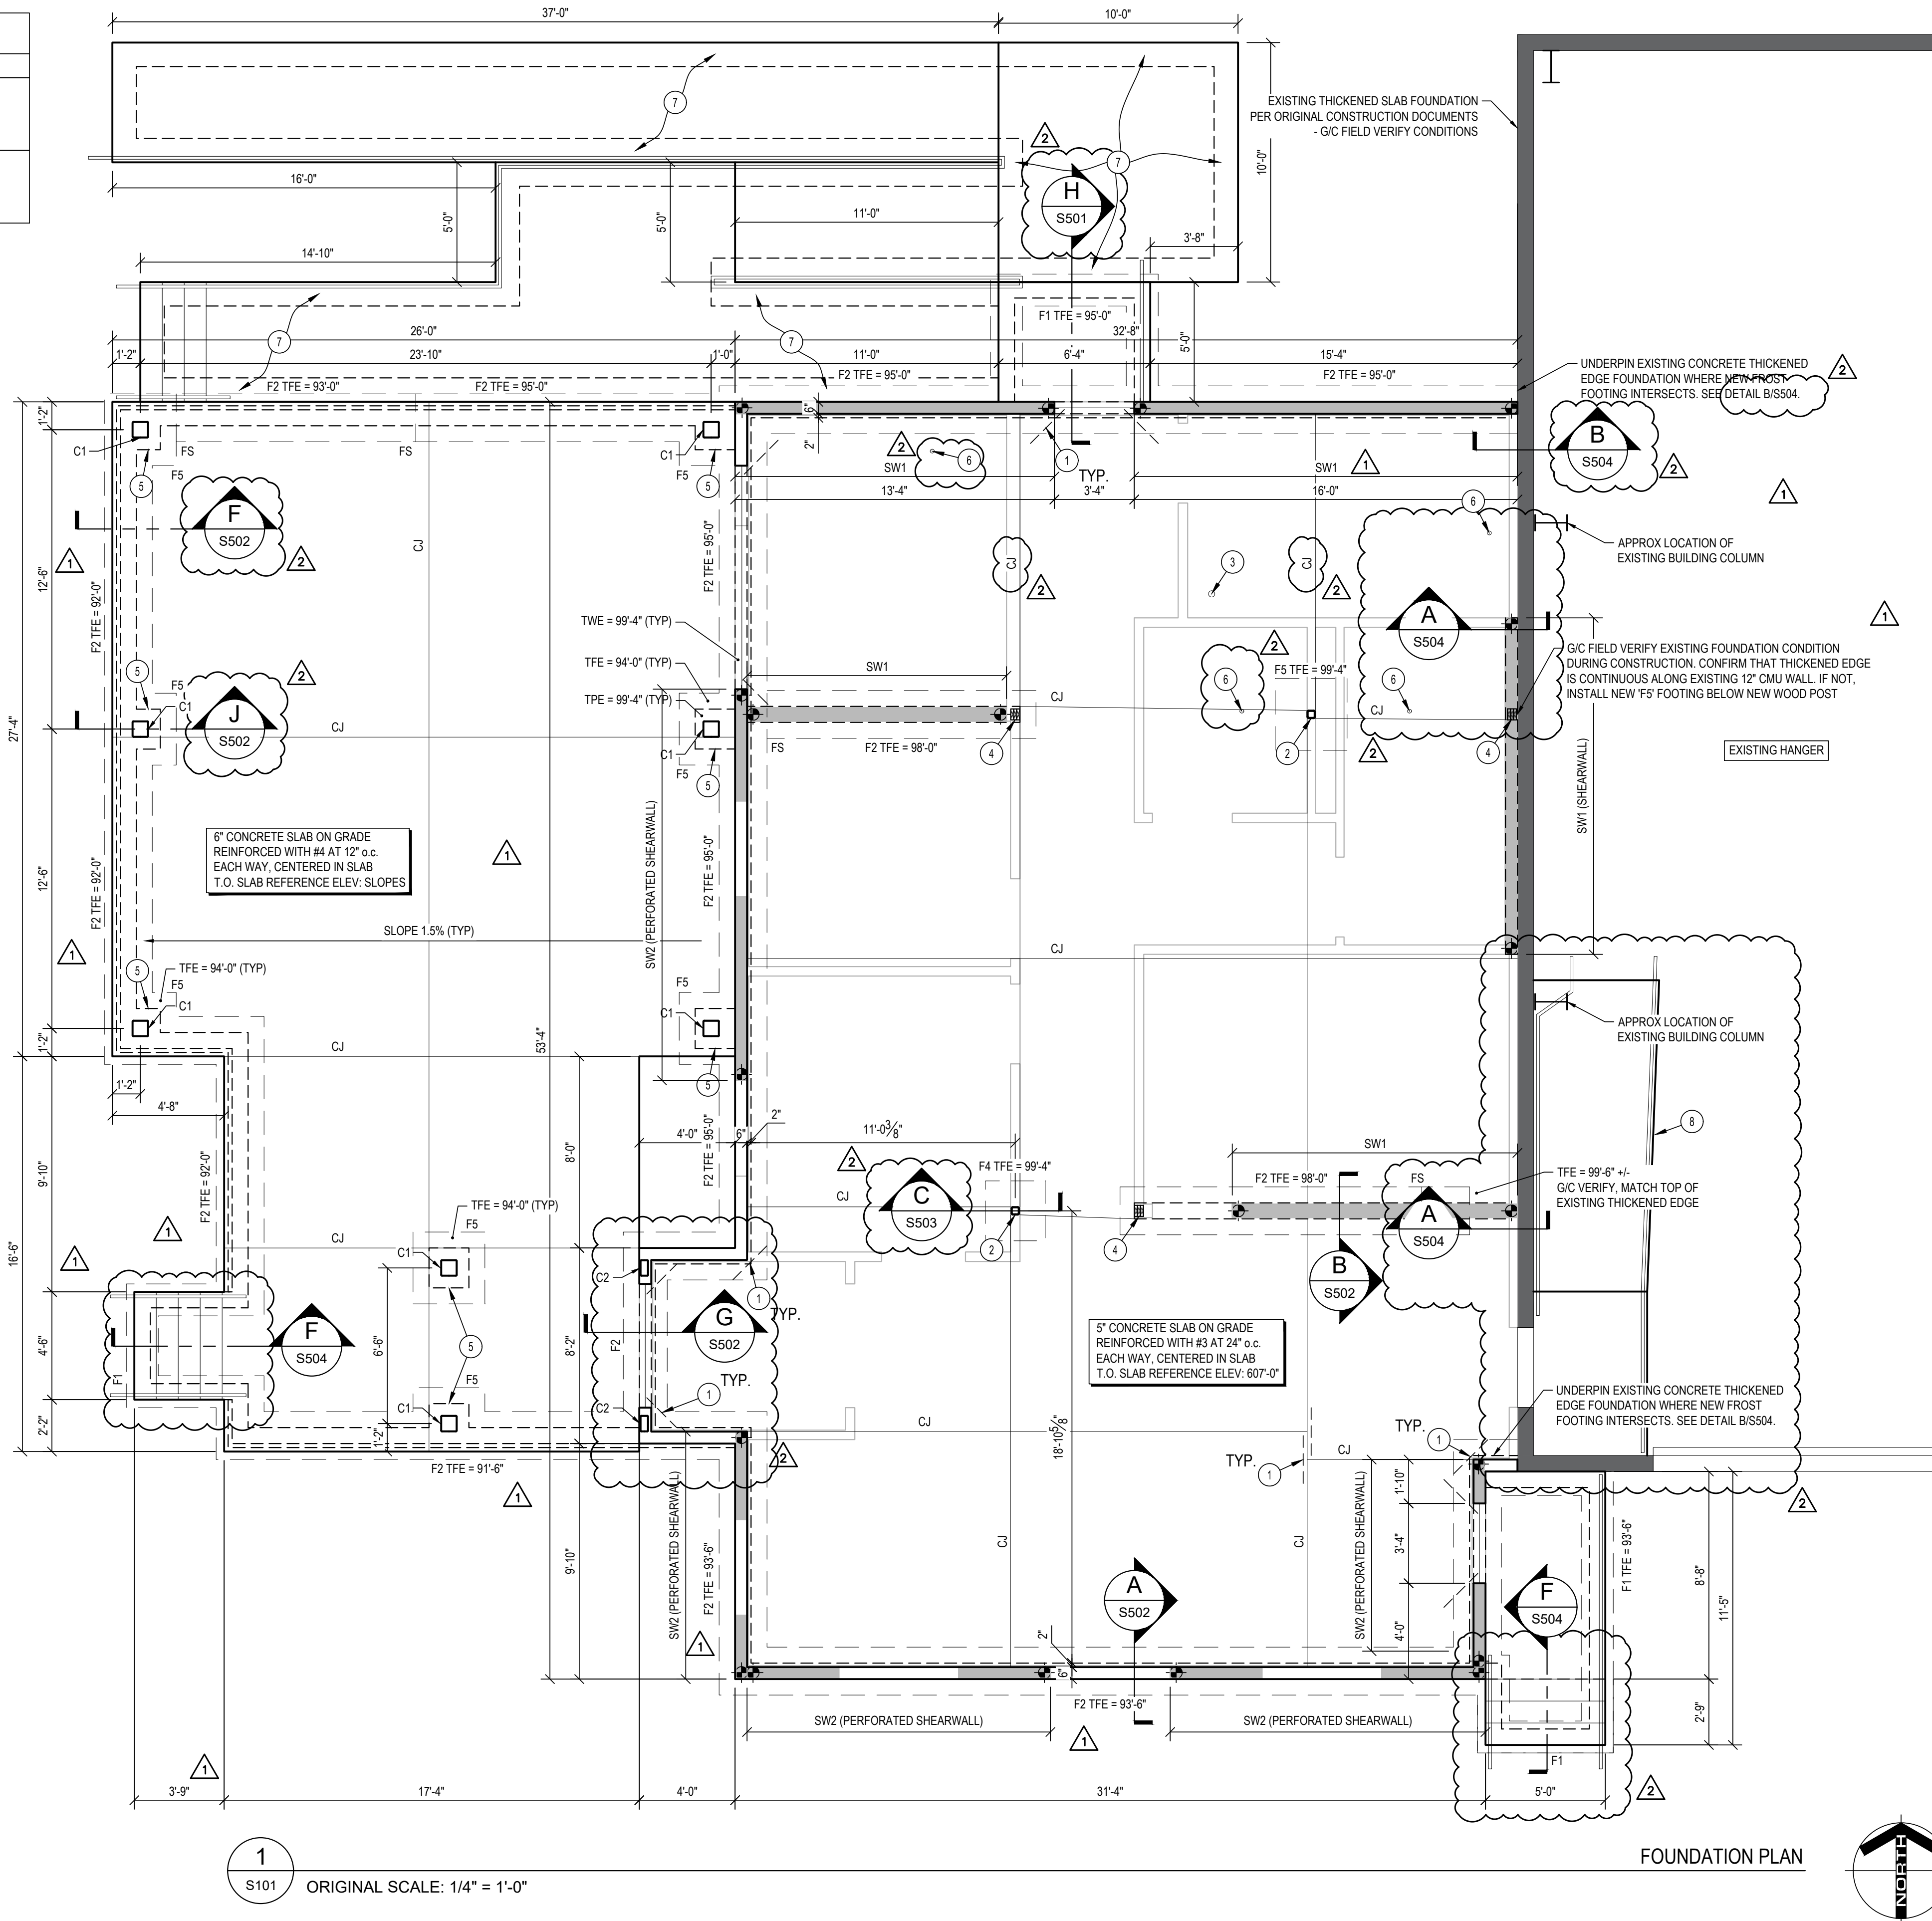

I HEREBY CERTIFY THAT THIS PLAN, SPECIFICATION, OR REPORT WAS PREPARED BY ME OR UNDER MY DIRECT SUPERVISION AND THAT I AM A DULY LICENSED ENGINEER UNDER THE LAWS OF THE STATE OF MINNESOTA.

B.C. Wolf
BERKAMIN A. WOLF
DATE 5.16.2023 LICENSE NO. 40807



SKY HARBOR AIRPORT
2023 RECONSTRUCT TERMINAL BUILDING
DULUTH, MN

This drawing is an instrument of service and shall remain the property of Short Elliott Hendrickson, Inc. (SEH). This drawing, concepts and ideas contained herein shall not be used, reproduced, revised, or retained without the express written approval of SEH.


Submission or distribution of this drawing to meet official or regulatory requirements or for purposes in connection with the project is not to be construed as publication in derogation of any of the rights of SEH.

SEH Project DULAL172133
Checked By BW
Drawn By JS

Project Status Issue Date
CONSTRUCTION PLANS 5.16.2023

REVISION SCHEDULE		
REV. #	DESCRIPTION	DATE
1	ADDENDUM #1	5.30.2023
2	ADDENDUM #2	6.2.2023

FOUNDATION PLAN

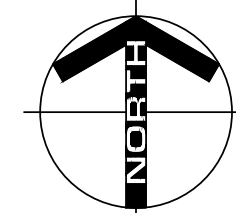

S101

SHEARWALL SCHEDULE												
MARK	SHEATHING	THICKNESS	NAILS	SPACING		ANCHOR RODS			HOLD-DOWNS			
				EDGE	INTER.	SIZE	SPACING	EMBED.	POST	TYPE	ANCHORS	EMBED.
SW1	APA STRUCT I PLYWOOD SHEATHING OUTSIDE FACE	7/16" MIN.	8d	6" o.c.	12" o.c.	5/8" DIA.	48" MAX.	7" MIN.	(2) 2x STUDS MINIMUM	SIMPSON HDU2-SDS2.5 HOLD-DOWN EA. END	5/8" DIA. 16" LONG HEADED ROD	12" MIN. - ADHESIVE ANCHOR IN EXISTING (NOTE 6)
SW2 (PERFORATED SHEARWALL)	APA STRUCT I PLYWOOD SHEATHING OUTSIDE FACE	7/16" MIN.	8d	6" o.c.	12" o.c.	5/8" DIA.	48" MAX.	7" MIN.	(2) 2x STUDS MINIMUM	SIMPSON HDU8-SDS2.5 HOLD-DOWN EA. END	7/8" DIA. 32" LONG HEADED ROD	28" MIN. (NOTE 6)

- SHEARWALL FRAMING TO BE 2x6 AT 16" o.c. UNLESS NOTED OTHERWISE. PROVIDE 2x BLOCKING FOR ALL JOINTS IN SHEATHING.
- SHEARWALL FRAMING SHALL BE SPRUCE PINE FIR (SPF) GRADE No 2 OR ANOTHER SPECIES WITH SPECIFIC GRAVITY OF 0.42 OR GREATER.
- AT PERFORATED SHEARWALLS PROVIDE 2x BLOCKING (WITH NAILING AS INDICATED FOR PANEL EDGES) AT LEAST 2 FRAMING SPACES (MIN. 32") EACH SIDE OF EACH WINDOW AT HEAD AND SILL (SEE DIAGRAM BELOW FOR ILLUSTRATION)
- PROVIDE LVL RIM BOARD ALONG EXTERIOR BEARING WALLS ABOVE SHEARWALLS. CONTINUE SHEARWALL SHEATHING UP TO ROOF DECK.
- ANCHOR RODS INDICATED AS HEADED MAY CONSIST OF THREADED ROD WITH STANDARD HEX NUT TACK WELDED TO EMBEDDED END.
- INDICATED EMBEDMENT IS INTENDED TO DEVELOP LAP WITH WALL REINFORCING BARS. ADD 2 ADDITIONAL #5 REBAR ADJACENT TO ANCHOR ROD IF WALL REBAR IS NOT PRESENT AT ANCHOR LOCATION.

HEADER / JAMB SCHEDULE		
MARK	HEADER	JAMB
H1	(2) 2x10	(1) 2x TO BRG (1) 2x FULL HT
H2	(3) 1 3/4" x 14" LVL	(3) 2x TO BRG (2) 2x FULL HT
H3	(2) 1 3/4" x 14" LVL	(3) 2x TO BRG (2) 2x FULL HT

- NOTES:
- CONTINUOUS 2x TOP AND BOTTOM PLATE AT HEADERS TYPICAL. SEE DETAIL H1/S503.

I-JOIST FRAMING SCHEDULE					
MARK	JOIST DEPTH	JOIST DESIGNATION	ALT. DESIGNATION	SPACING	WEB STIFFENERS
J1	16"	APA PRI-40	TJI 230	24" o.c.	YES
J2	16"	APA PRI-70	TJI 360	24" o.c.	YES
J3	16"	APA PRI-70	TJI 360	16" o.c.	YES

- NOTES:
- JOIST DESIGNATIONS NOTED 'PRI-XX' ARE TO BE JOISTS MEETING ALL CRITERIA OF APA DOCUMENT PRI-400, PERFORMANCE STANDARD FOR APA EWS I-JOIST.

ROOF FRAMING NOTES:


(TYPICAL UNLESS NOTED OTHERWISE)

- TYPICAL ROOF JOIST BEARING ELEVATION = SLOPES
- ROOF JOISTS:
 - SPACE JOISTS AT 2'-0" o.c. MAX. U.N.O.
 - ATTACHMENT OF JOISTS TO DOUBLE TOP PLATE:
TYPICAL JOISTS: SIMPSON H2 HURRICANE TIE EACH SIDE
- JOIST LOADING/SPACING:
 - REF. THIS SHEET FOR DESIGN DEAD LOADS AND SNOW LOAD / SNOW DRIFT.
 - DESIGN DEAD LOAD = 20PSF
- ROOF SHEATHING:
 - 5/8" APA RATED SHEATHING. MINIMUM 40/20 APA RATING.
- DIAPHRAGM NAILING:
 - UNBLOCKED DIAPHRAGM, WITH 10d NAILS AT 6" o.c. AT PANEL EDGES, 12" o.c. IN FIELD.
- SEE ARCHITECTURAL DRAWINGS FOR DIMENSIONS TO WALL OPENINGS AND FOR LOCATIONS OF PARTITION WALLS NOT NOTED.
- JOIST SUPPLIER SHALL VERIFY ALL JOIST END TO END LENGTHS AND BEARING CONDITIONS.
- DASHED WALLS SHOWN ARE MAIN LEVEL WALLS (BELOW).
- ⤴ INDICATES BEAM CANTILEVERED OVER COLUMN.

ROOF FRAMING PLAN KEYNOTES:


- HATCHED AREA REPRESENTS SLIDING SNOW FROM EXISTING UPPER ROOF. APPLY 37PSF ACROSS 15' OF NEW ROOF.
- EXISTING PASSAGE DOOR TO HANGER: CUT MASONRY ABOVE TO EXTEND OPENING HIGHER. INSTALL NEW W8x18 LINTEL WITH 5/16" THK BOTTOM PLATE AT HEAD. 6" x 6" x 3/8" THK BEARING PLATE EACH END. SEE DETAILS D/S504 AND C/S504.
- HSS4x4x3/8 STEEL POST WITH SADDLE AT TOP. SEE DETAIL D/S503.
- (3) 2x6 POST (LUMBER N-PLY, SPF No. 1/No. 2).
- TJI JOIST MINIMUM BEARING LENGTH = 3 1/2".
- 2x10 AT 16" OC (D, FIR L No. 2).

- REPLACE EXISTING 2x4 PARTITION WALL WITH INSULATED 2x8 WALL (SPF No. 1/No. 2) AT 16" OC. SECURE TO TOP OF EXISTING CMU WITH PRESSURE TREATED 2x8. INSTALL HURRICANE TIE EACH STUD TO NEW ROOF JOIST.
- WITHIN WALL AND ABOVE TREATED 2x8 PLATE, INSTALL (2) 1 3/4" x 7 1/4" LVL FLATWISE. CONTINUOUS BETWEEN PRE-ENGINEERED METAL BUILDING (PEMB) COLUMNS. SECURE TO EACH PEMB COLUMN WITH 6" x 4" x 3/16" THK WELDED CLIP PLATE WITH (6) 3" LONG SDS SCREWS.
- FABRICATE SLOPED STIFFENED SEAT TO SUPPORT EXISTING BUILDING ROOF PURLIN WHERE EXISTING MONOSLOPE BEAM WILL BE REMOVED. FABRICATE 5" LONG STIFFENED SEAT WITH 4" WIDE x 1/4" THK SEAT PLATE, 6" DEEP x 1/4" THK VERTICAL PLATE AND 1/4" THK STIFFENER AT MIDDLE. WELD TO STEEL COLUMN WITH 1/4" FILLET WELD ALL AROUND.

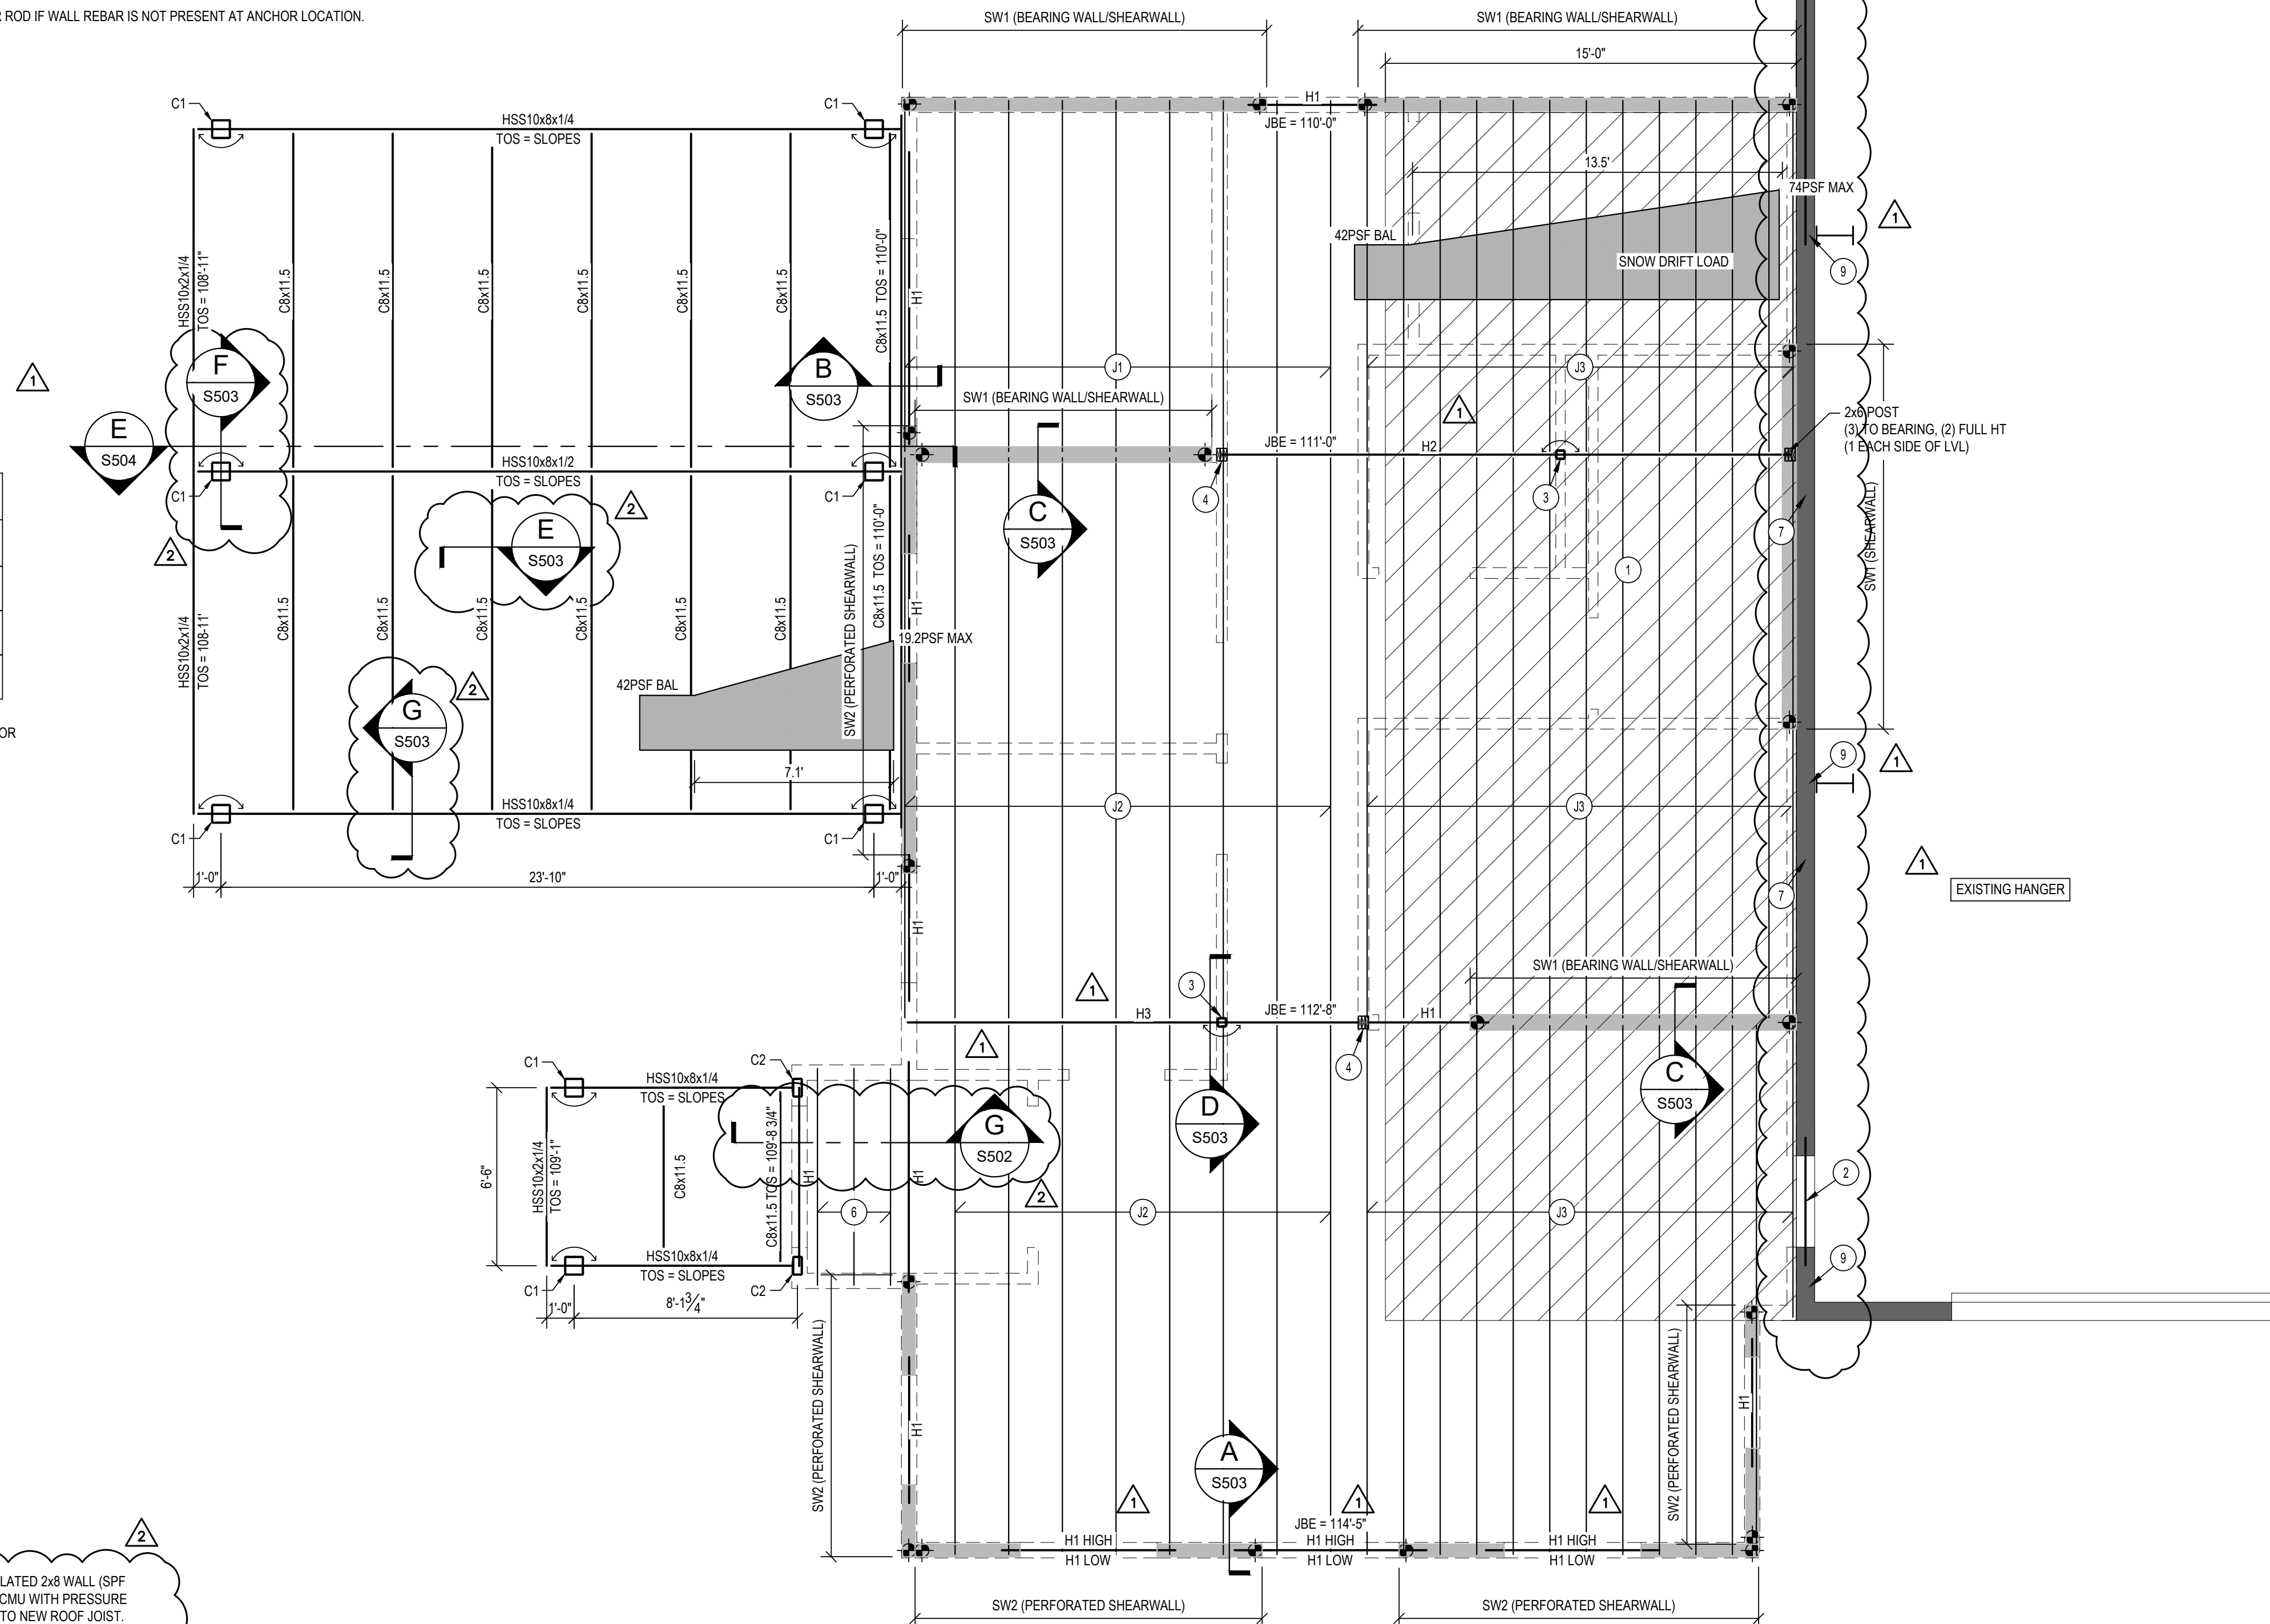

1
S201 ORIGINAL SCALE: 1/4" = 1'-0"

ROOF FRAMING PLAN

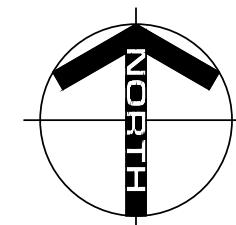

I HEREBY CERTIFY THAT THIS PLAN, SPECIFICATION, OR REPORT WAS PREPARED BY ME OR UNDER MY DIRECT SUPERVISION AND THAT I AM A DULY LICENSED ENGINEER UNDER THE LAWS OF THE STATE OF MINNESOTA.

B. C. YF
BERKAMIN A. WOLF
DATE 5.16.2023 LICENSE NO. 40807



SKY HARBOR AIRPORT
2023 RECONSTRUCT TERMINAL BUILDING
DULUTH, MN

This drawing is an instrument of service and shall remain the property of Short Elliott Hendrickson, Inc. (SEH). This drawing, concepts and ideas contained herein shall not be used, reproduced, revised, or retained without the express written approval of SEH.

Subsmission or distribution of this drawing to meet official or regulatory requirements or for purposes in connection with the project is not to be construed as publication in derogation of any of the rights of SEH.

COPYRIGHT © 2023
Short Elliott Hendrickson, Inc.
All Rights Reserved




SEH Project DULAL172133
Checked By BW
Drawn By JS

Project Status Issue Date
CONSTRUCTION PLANS 5.16.2023


REVISION SCHEDULE		
REV. #	DESCRIPTION	DATE
1	ADDENDUM #1	5.30.2023
2	ADDENDUM #2	6.2.2023

ROOF FRAMING PLAN


S201

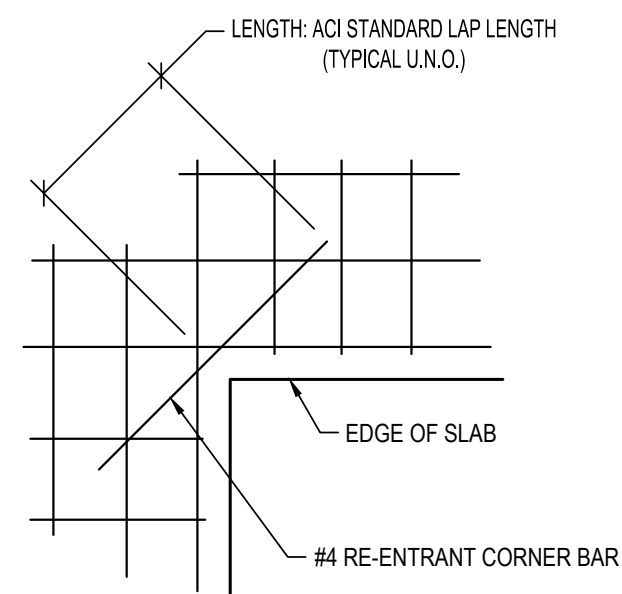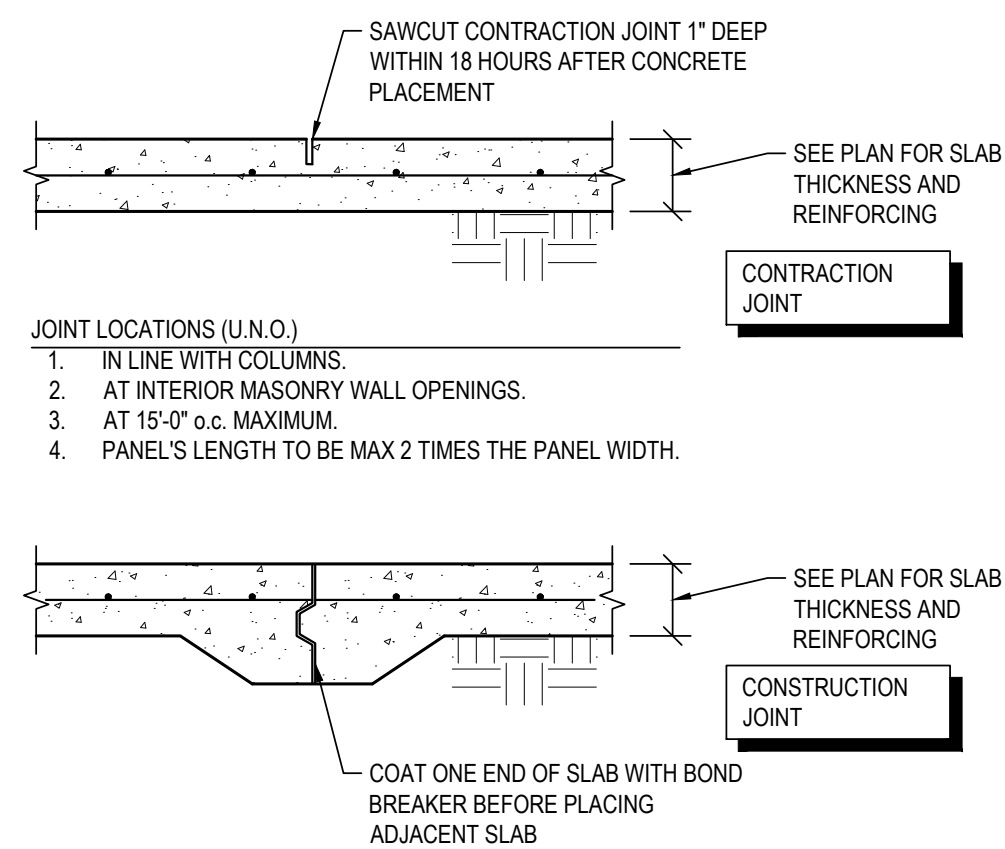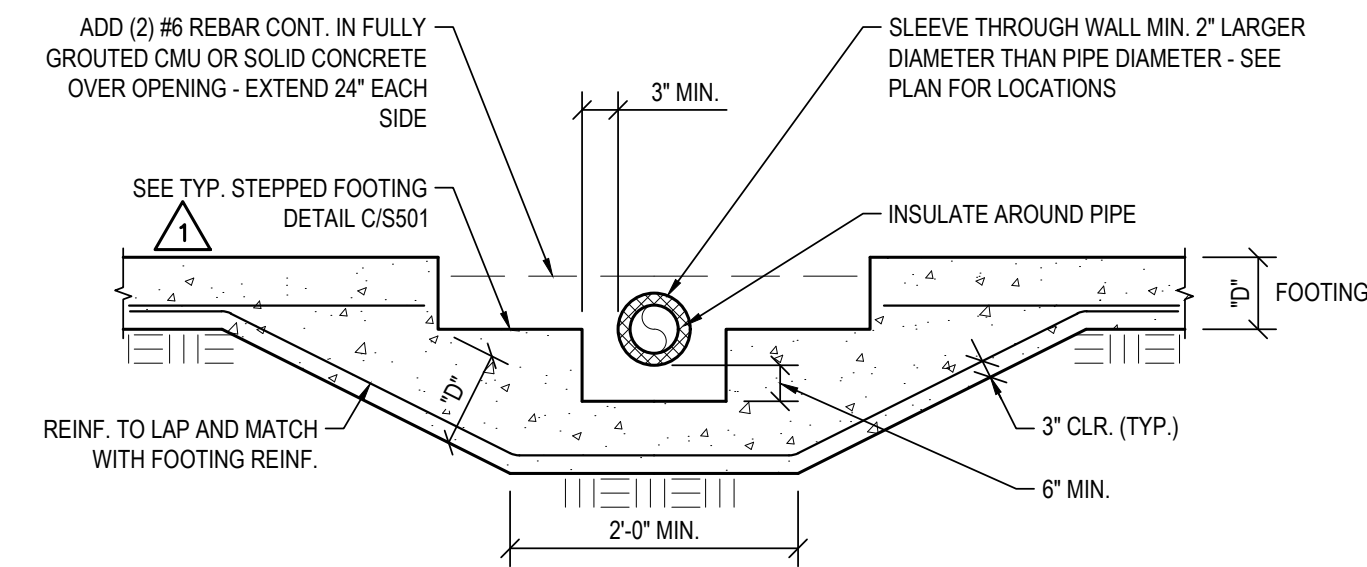



WHEN SLAB HAS BOTTOM REINFORCEMENT
LAYER ONLY, PLACE DIAGONAL BARS AT
MID-SPAN.

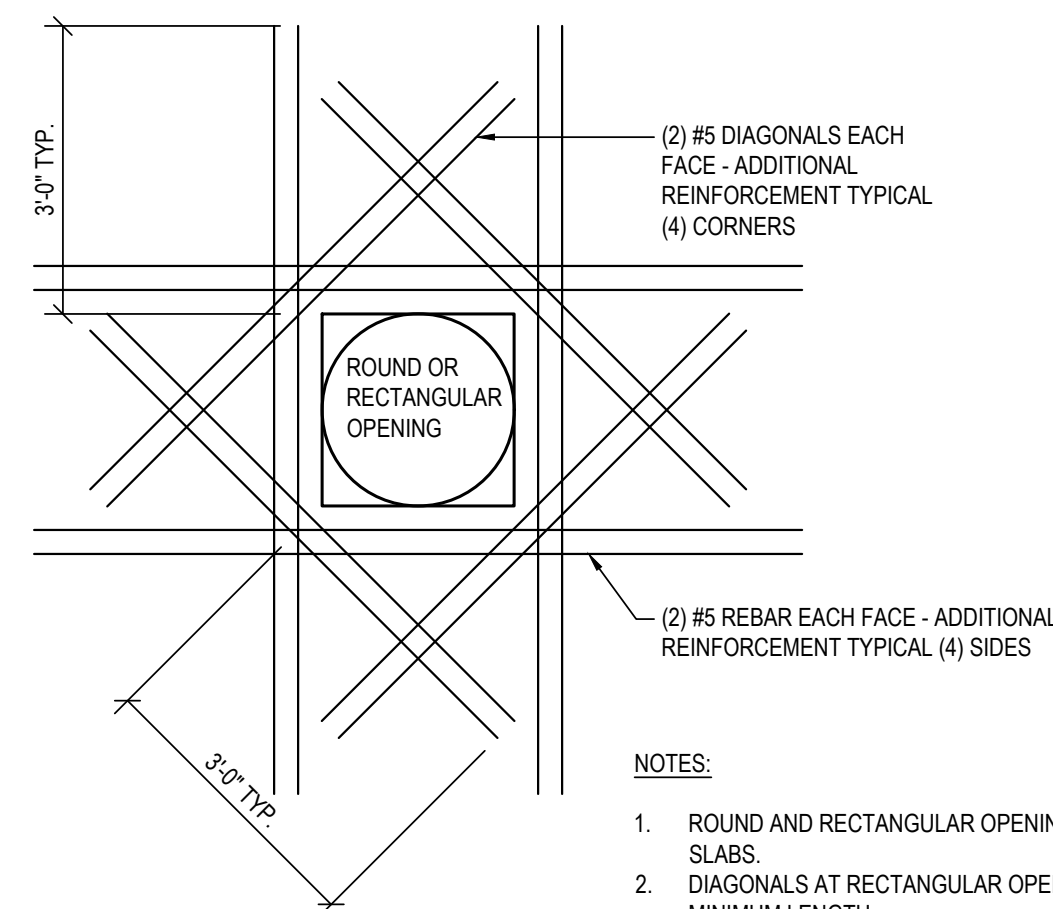


1. ROUND AND RECTANGULAR OPENINGS, WALL AND FLOOR SLABS.
2. DIAGONALS AT RECTANGULAR OPENINGS SHALL BE 6'-0" MINIMUM LENGTH.

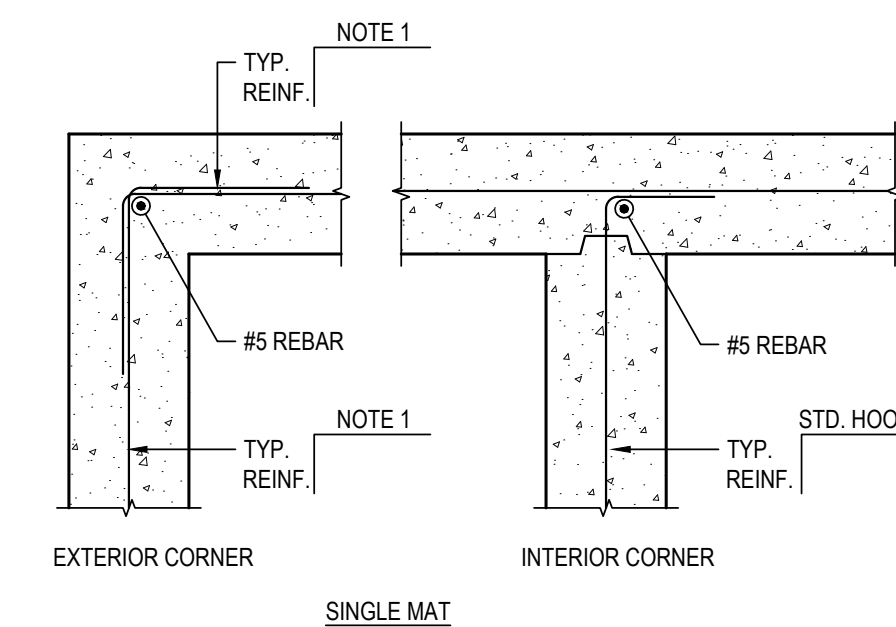


1. 90° HOOK SHALL BE OF SUFFICIENT LENGTH TO PROVIDE THE HORIZONTAL BAR LAP LENGTH SHOWN IN THE SPLICE LAP TABLE BELOW.
2. TYPICAL FOR ALL CORNERS UNLESS OTHERWISE SHOWN ON THE PLANS.

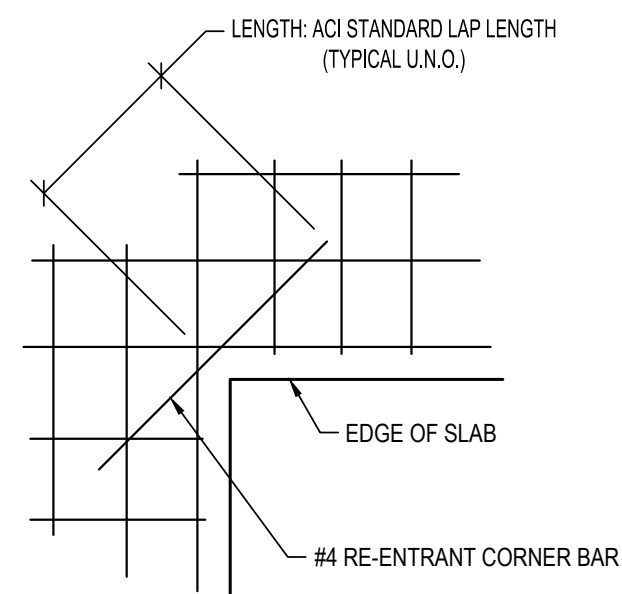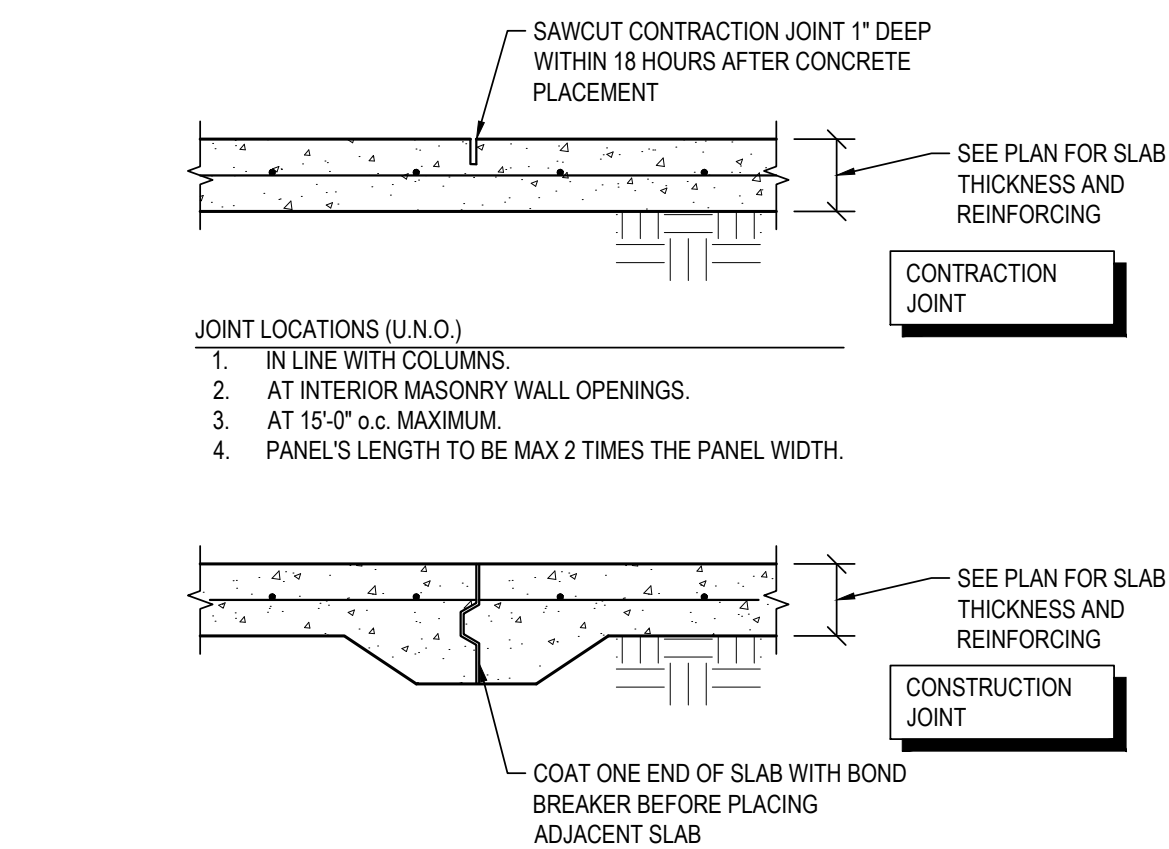









WHEN SLAB HAS BOTTOM REINFORCEMENT
LAYER ONLY, PLACE DIAGONAL BARS AT
MID-SPAN.

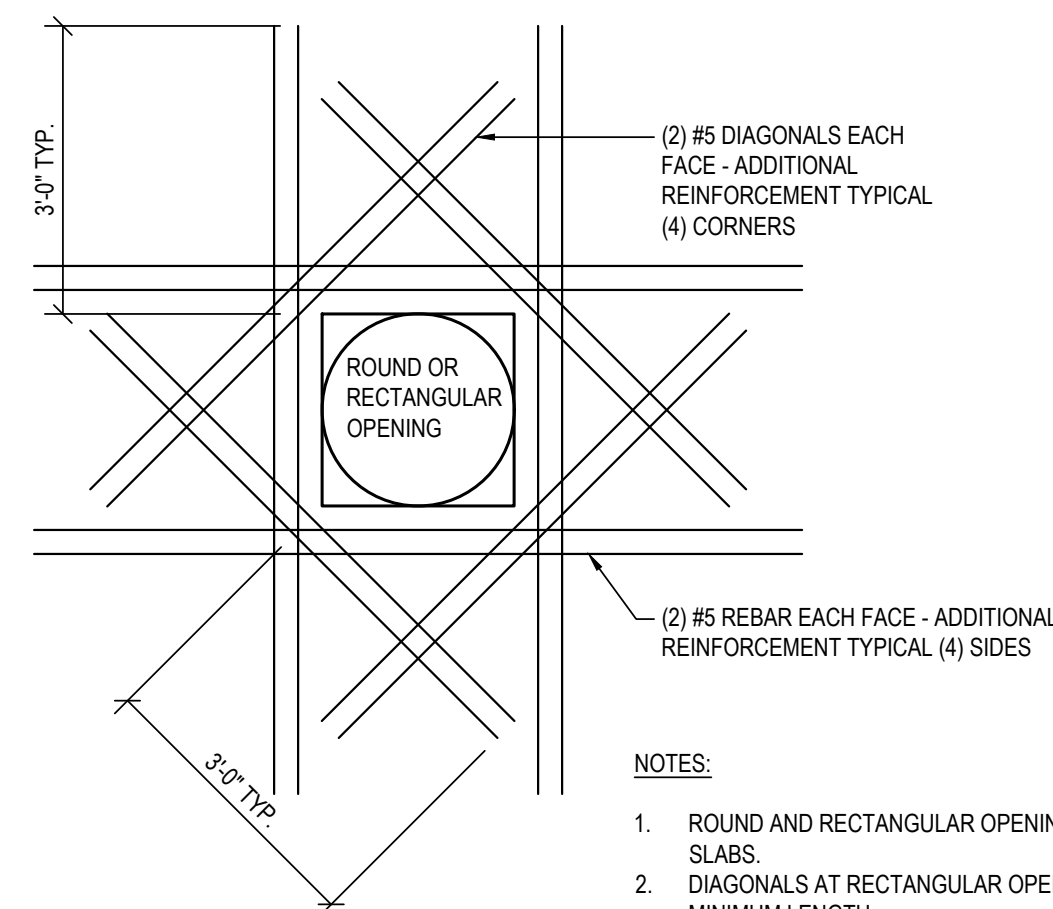


1. ROUND AND RECTANGULAR OPENINGS, WALL AND FLOOR SLABS.
2. DIAGONALS AT RECTANGULAR OPENINGS SHALL BE 6'-0" MINIMUM LENGTH.

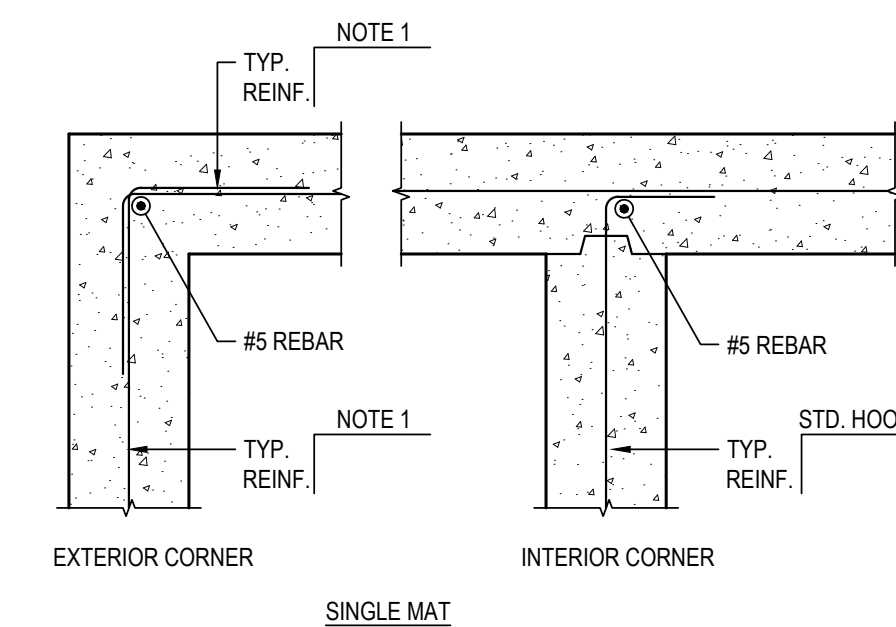


1. 90° HOOK SHALL BE OF SUFFICIENT LENGTH TO PROVIDE THE HORIZONTAL BAR LAP LENGTH SHOWN IN THE SPLICE LAP TABLE BELOW.
2. TYPICAL FOR ALL CORNERS UNLESS OTHERWISE SHOWN ON THE PLANS.

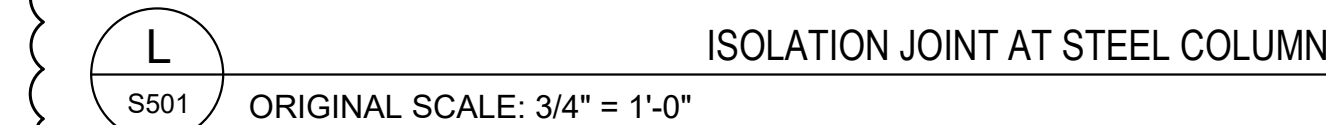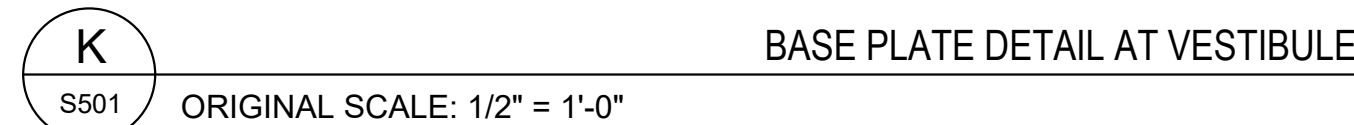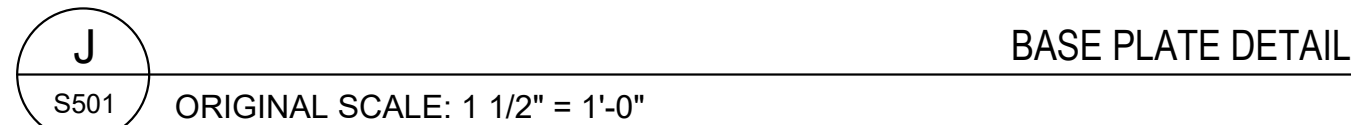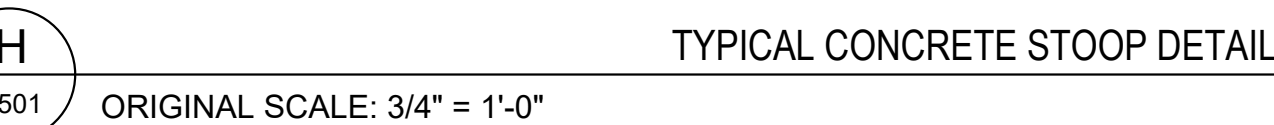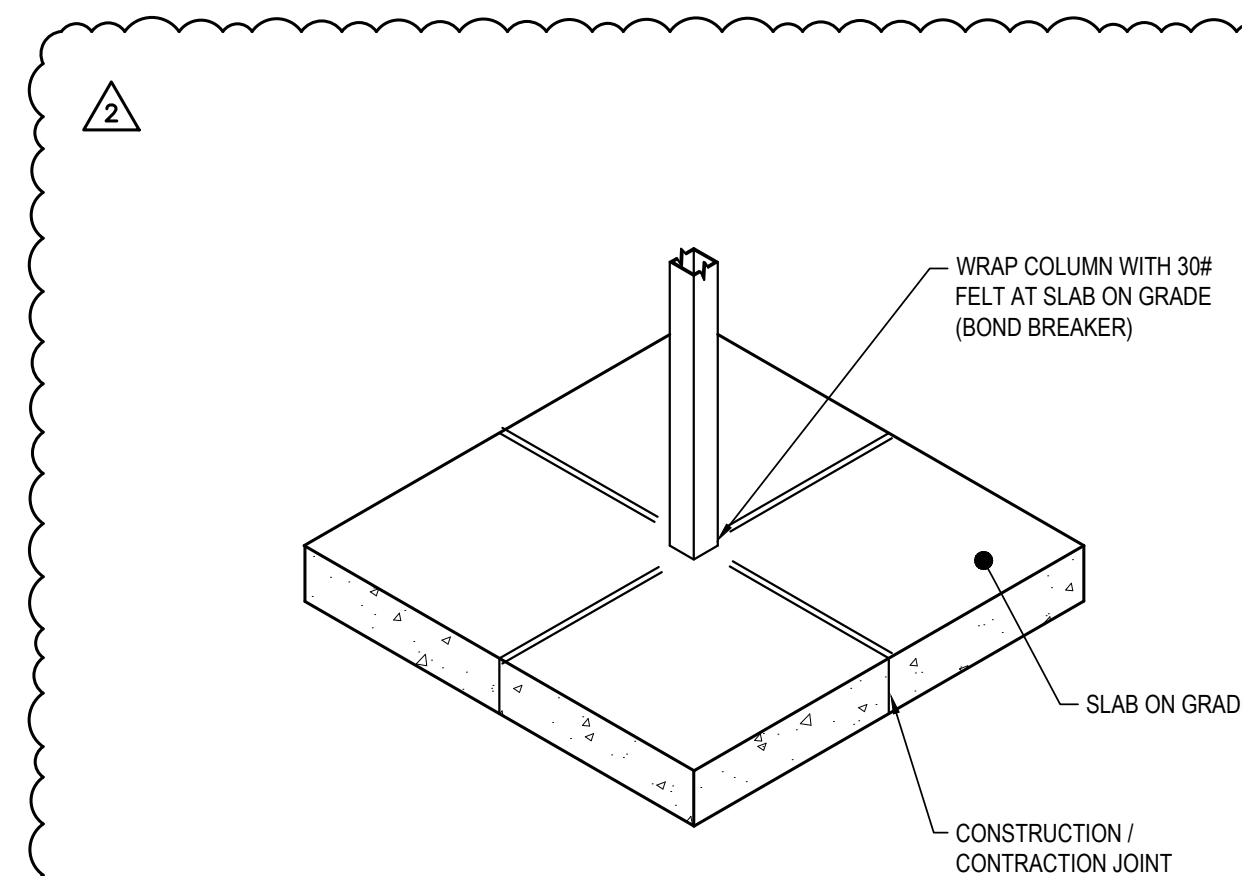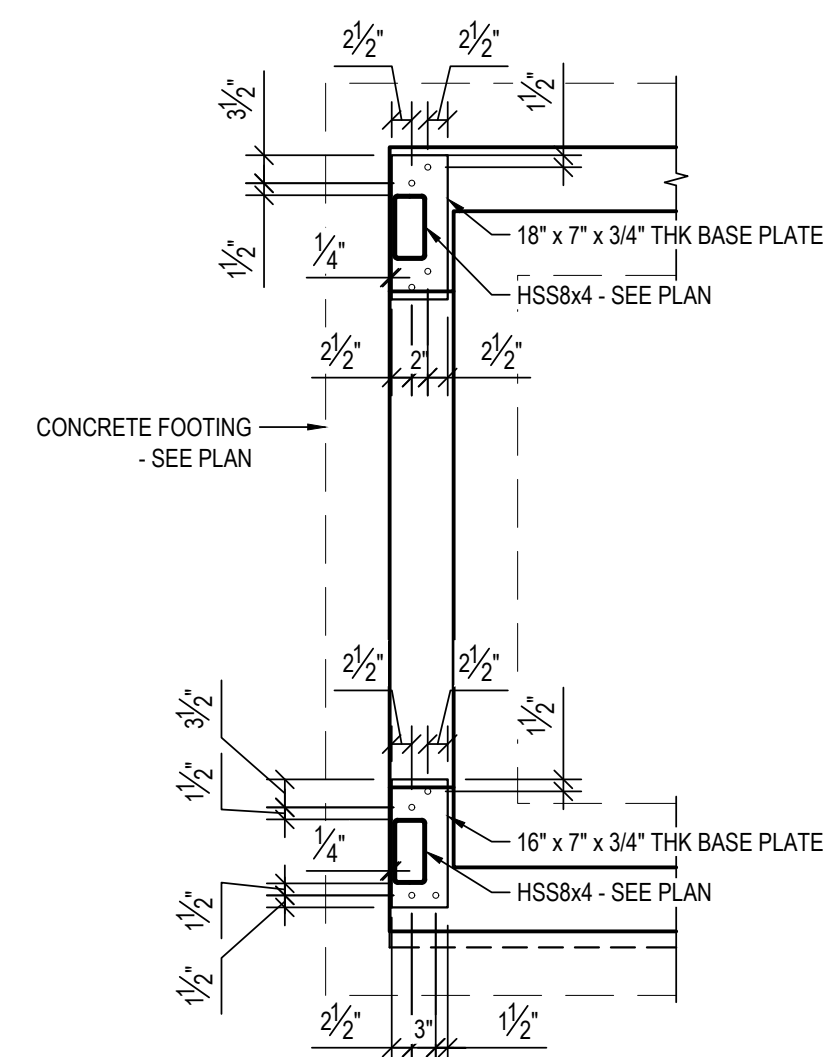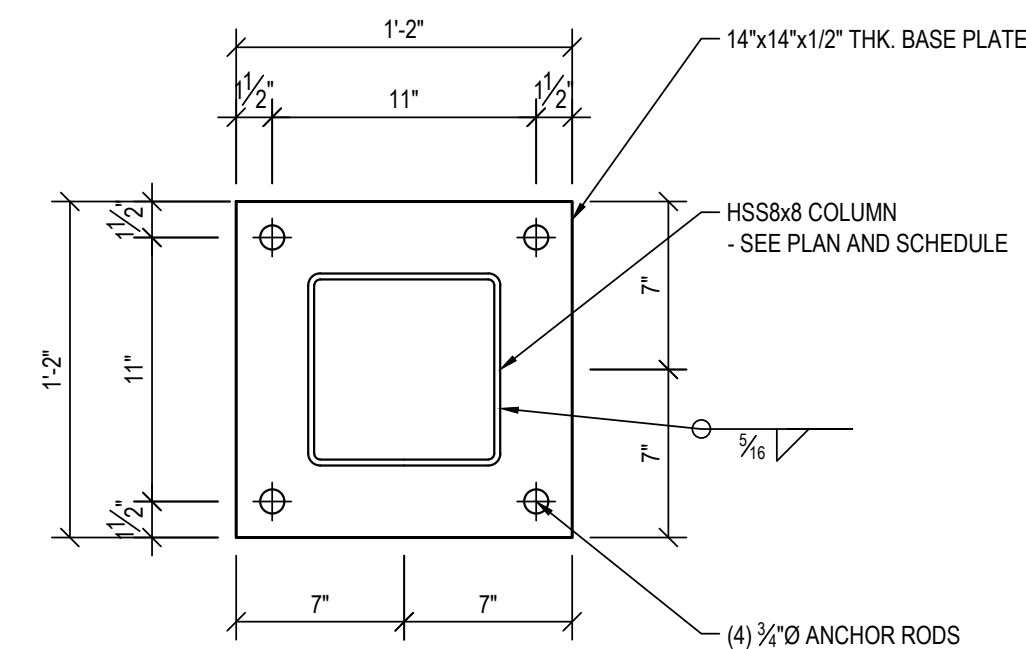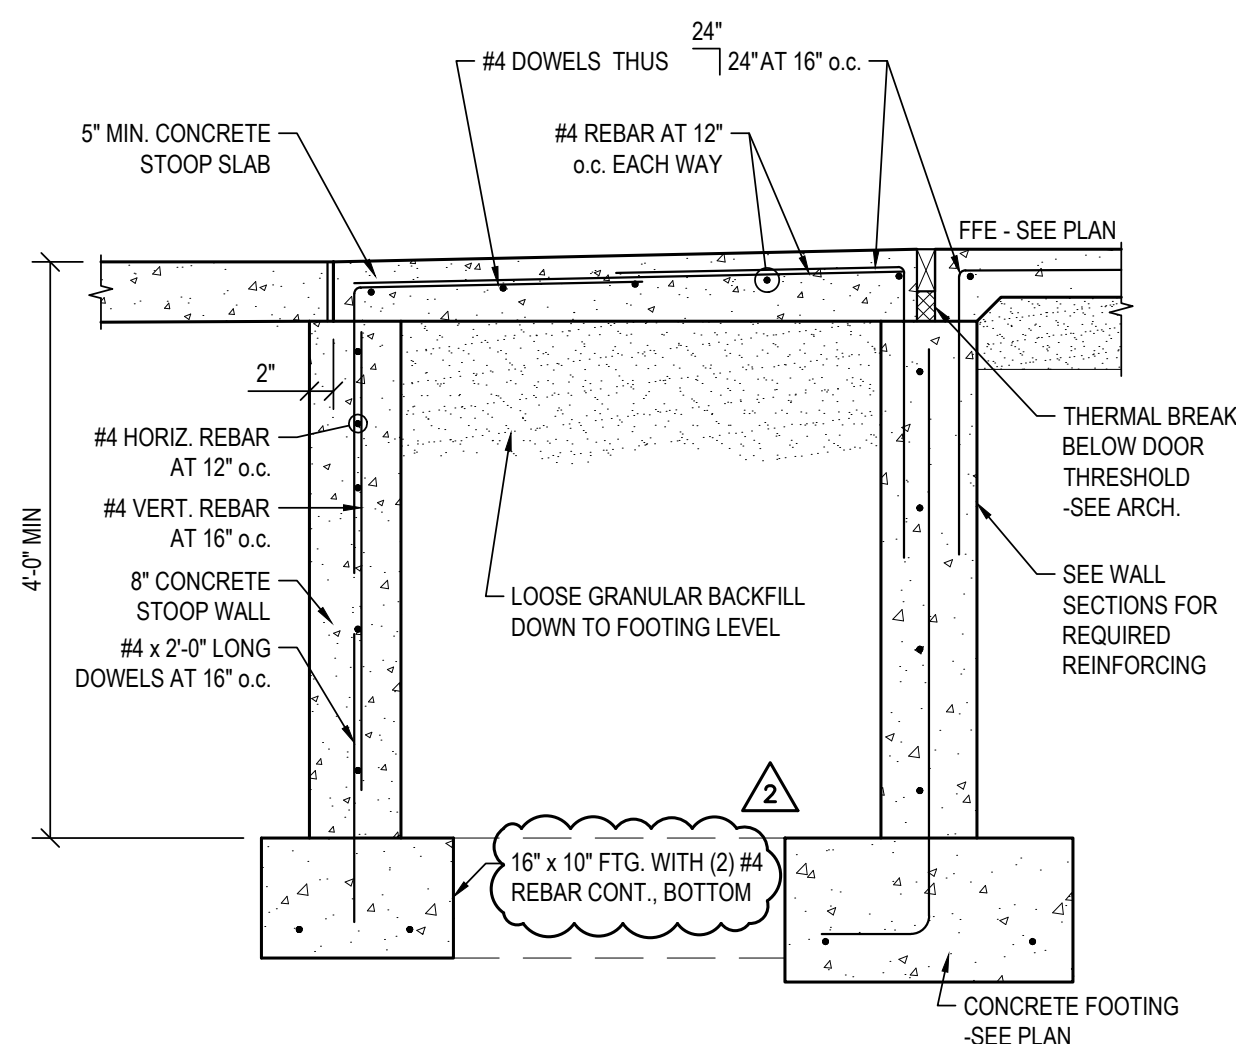

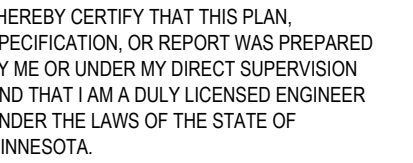

B. A. Wolf
BENJAMIN A. WOLF
DATE 5.16.2023 LICENSE NO. 40807

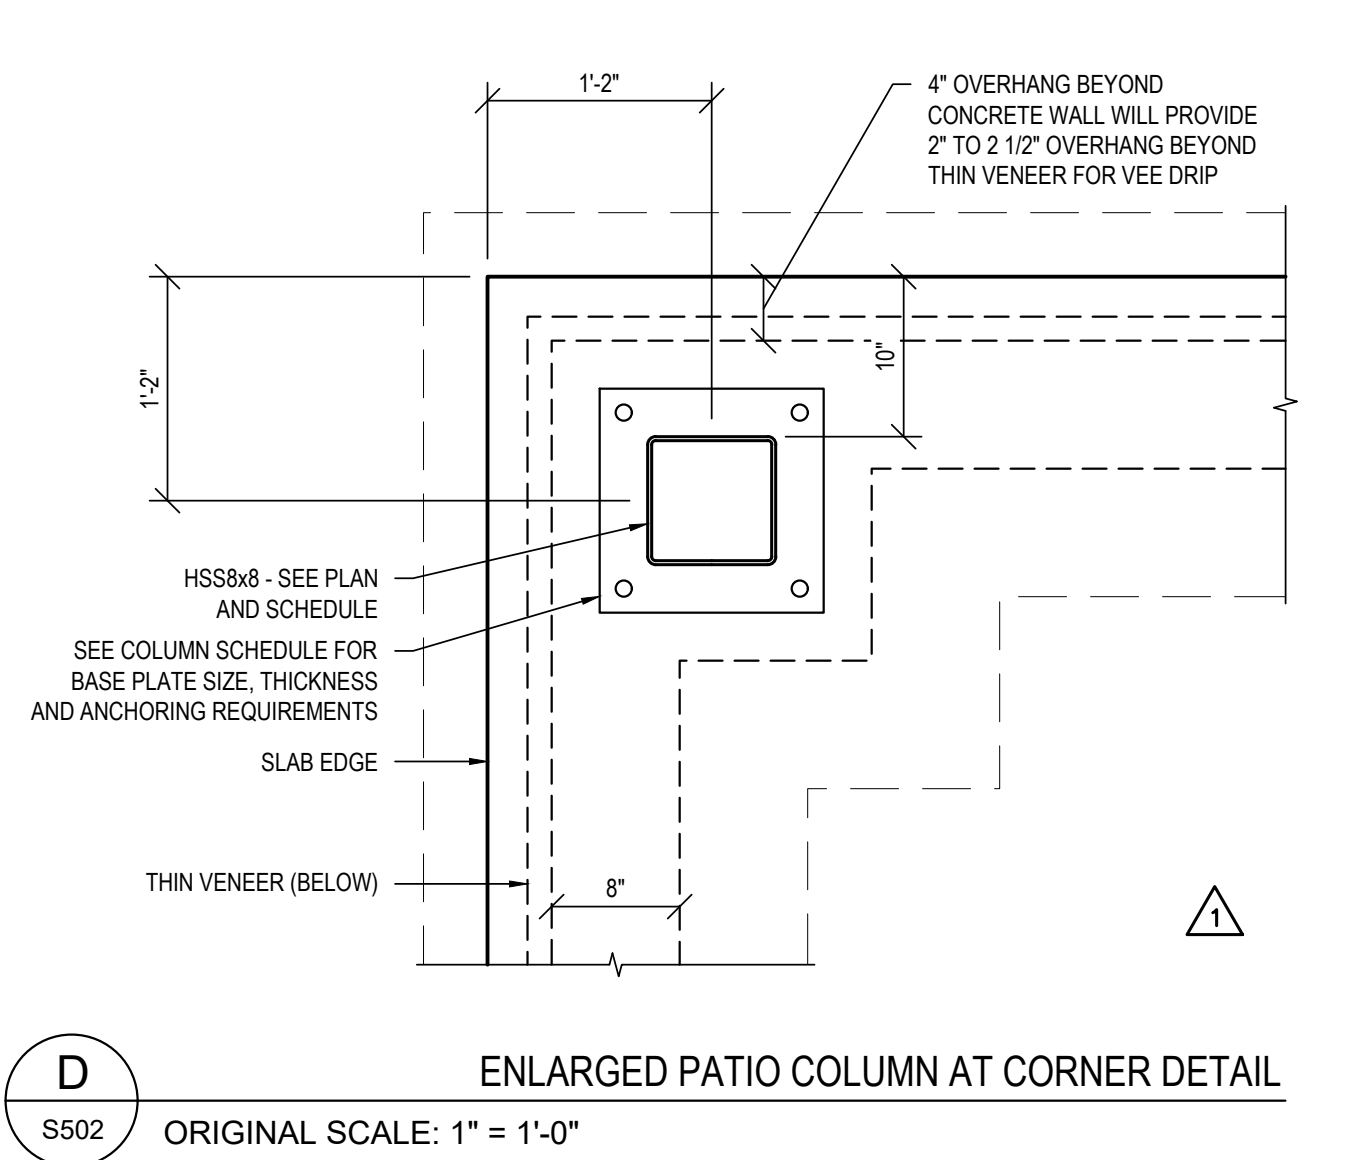

D ENLARGED PATIO COLUMN AT CORNER DETAIL
S502 ORIGINAL SCALE: 1" = 1'-0"



PATIO EDGE
THIN VENEER
- SEE ARCH

4" OH

8"

NOSING OF FIRST STEP
1" FORWARD FROM
FACE OF WALL

TSE = 99'-10"

2'-2"

4" 8"

FACE OF CONCRETE
WALL

4" 8"

FACE OF BUILDING AND
CONCRETE WALL

THIN VENEER

INSULATION - SEE ARCH

2x6

15/32" SHTG

THIN VENEER ON
BUILDING

HSS8x4 COLUMN
- SEE PLAN

HSS8x8 - SEE PLAN

TPE = 99'-2 1/2"

PIER - SEE DETAIL E/S504

H PATIO EDGE DETAIL AT FRONT ENTRY
S502 ORIGINAL SCALE: 1/2" = 1'-0"

DOSE 111, MIN

This drawing is an instrument of service and shall remain the property of Short Elliott Hendrickson, Inc. (SEH). This drawing, concepts and ideas contained herein shall not be used, reproduced, revised, or retained without the express written approval of SEH.

Submission or distribution of this drawing to meet official or regulatory requirements or for purposes in connection with the project is not to be construed as indication in derogation of any of the rights of SEH.

COPYRIGHT © 2023
Short Elliott Hendrickson, Inc.
All Rights Reserved

Submission or distribution of this drawing to meet
 trial or regulatory requirements or for purposes in
 connection with the project is not to be construed as
 publication in derogation of any of the rights of SEH.


SEH Project DULAI_172133
Checked By BW
Drawn By JS

Project Status	Issue Date
CONSTRUCTION PLANS	5.16.2023


REVISION SCHEDULE		
REV. #	DESCRIPTION	DATE
1	ADDENDUM #1	5.30.2023
2	ADDENDUM #2	6.2.2023

FOUNDATION DETAILS


S502

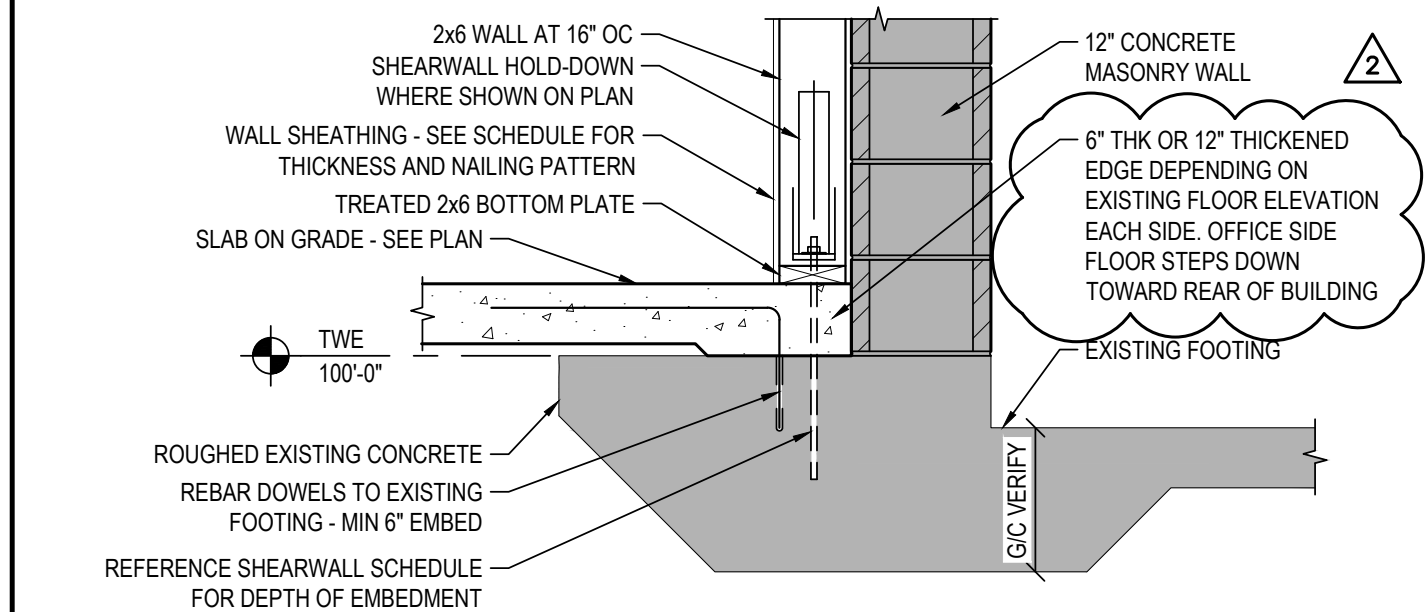


A TYPICAL FOUNDATION SECTION AT EAST WALL
S504 ORIGINAL SCALE: 3/4" = 1'-0"

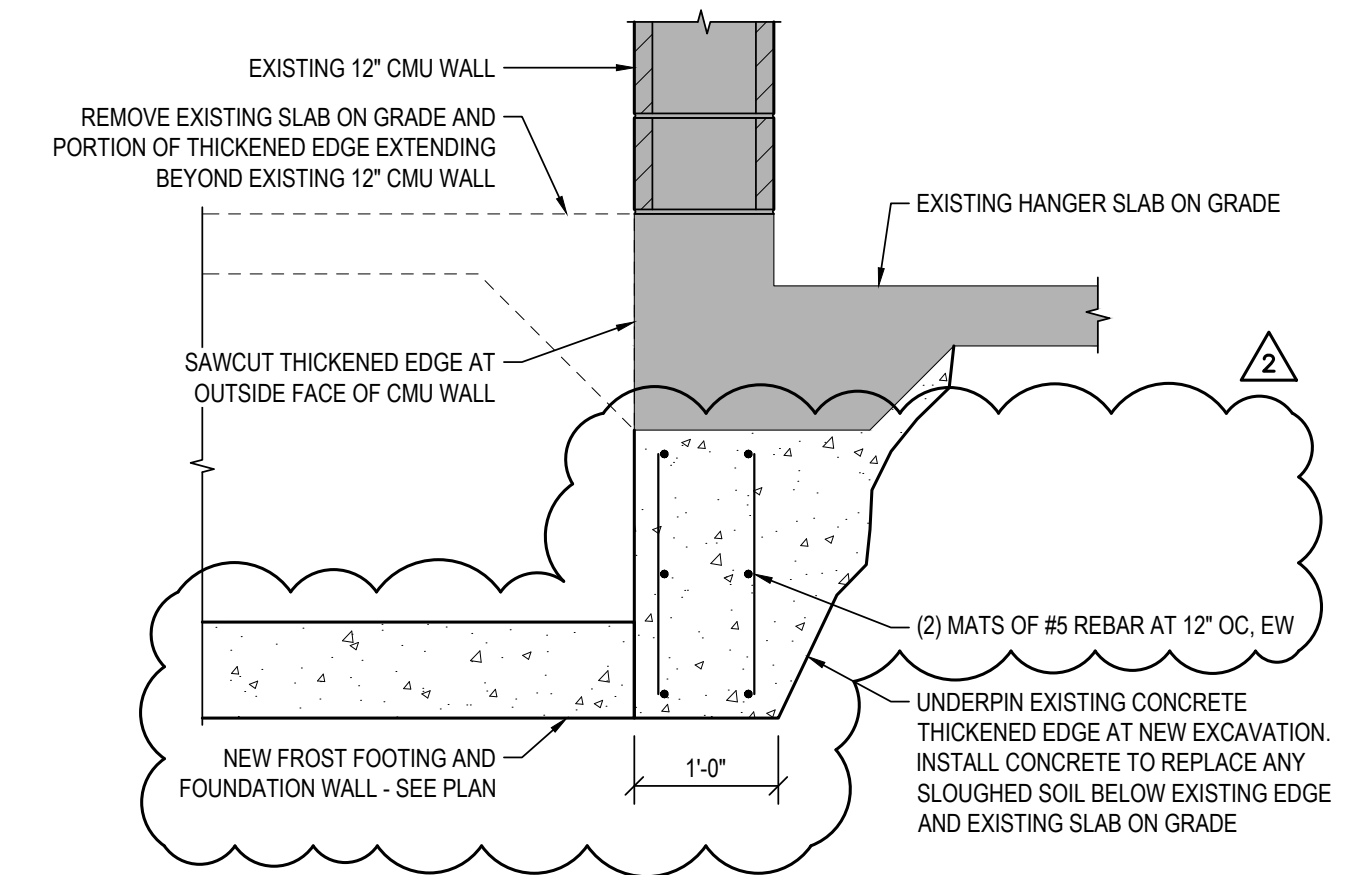


B CONCRETE FOOTING UNDERPIN DETAIL
S504 ORIGINAL SCALE: 3/4" = 1'-0"

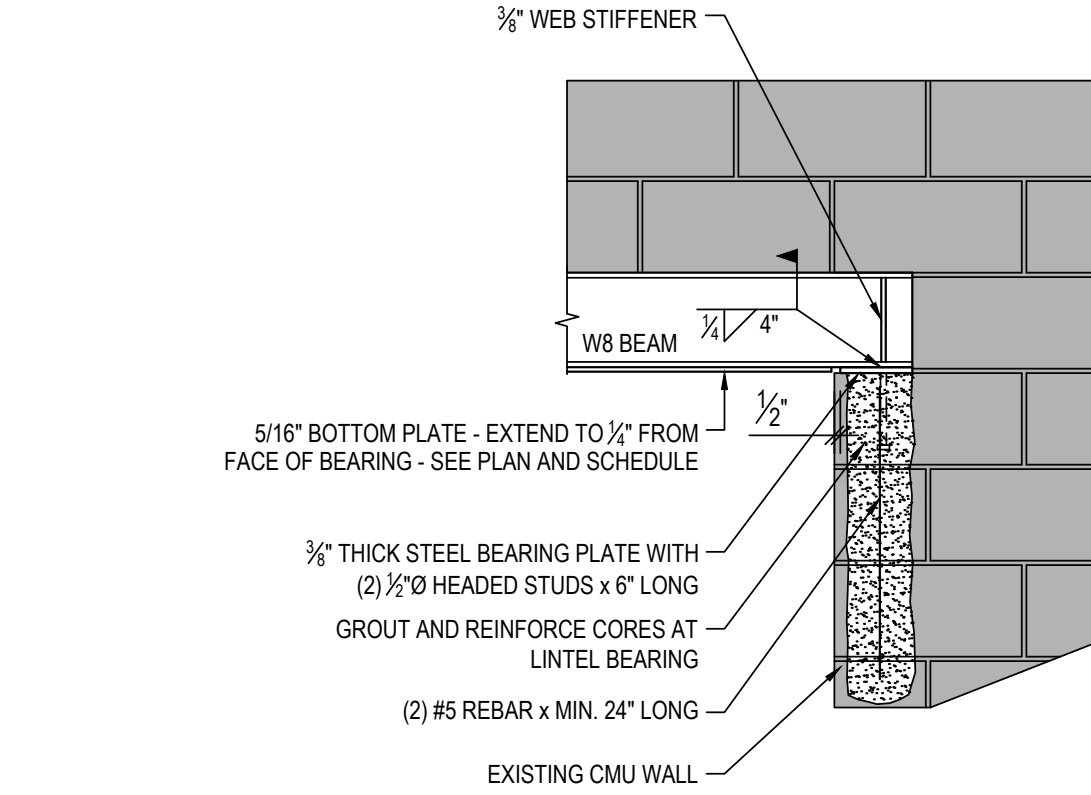


C STEEL LINTEL ELEVATION AT EXISTING PASSAGE DOOR TO HANGER
S504 ORIGINAL SCALE: 3/4" = 1'-0"

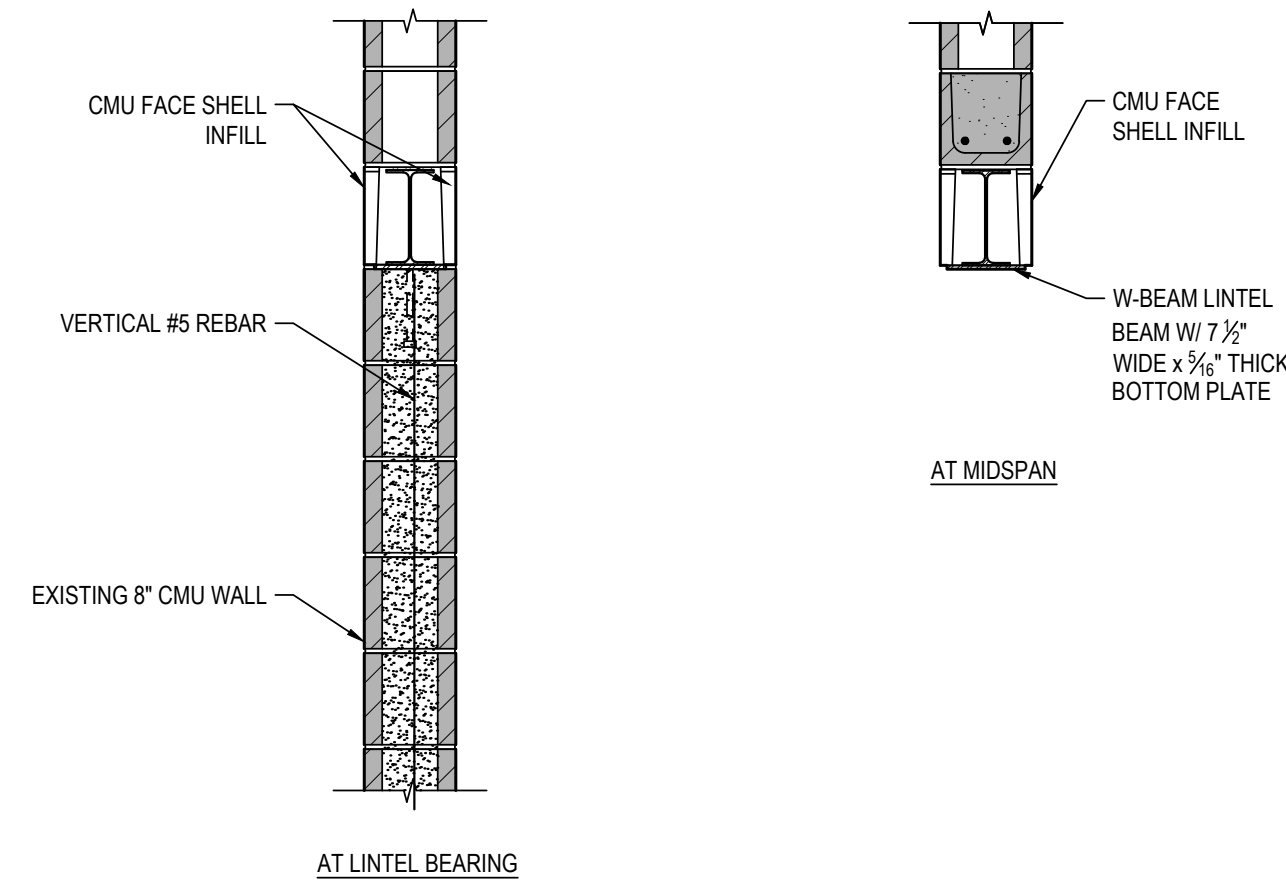


D STEEL LINTEL SECTIONS AT EXISTING HANGER
S504 ORIGINAL SCALE: 3/4" = 1'-0"

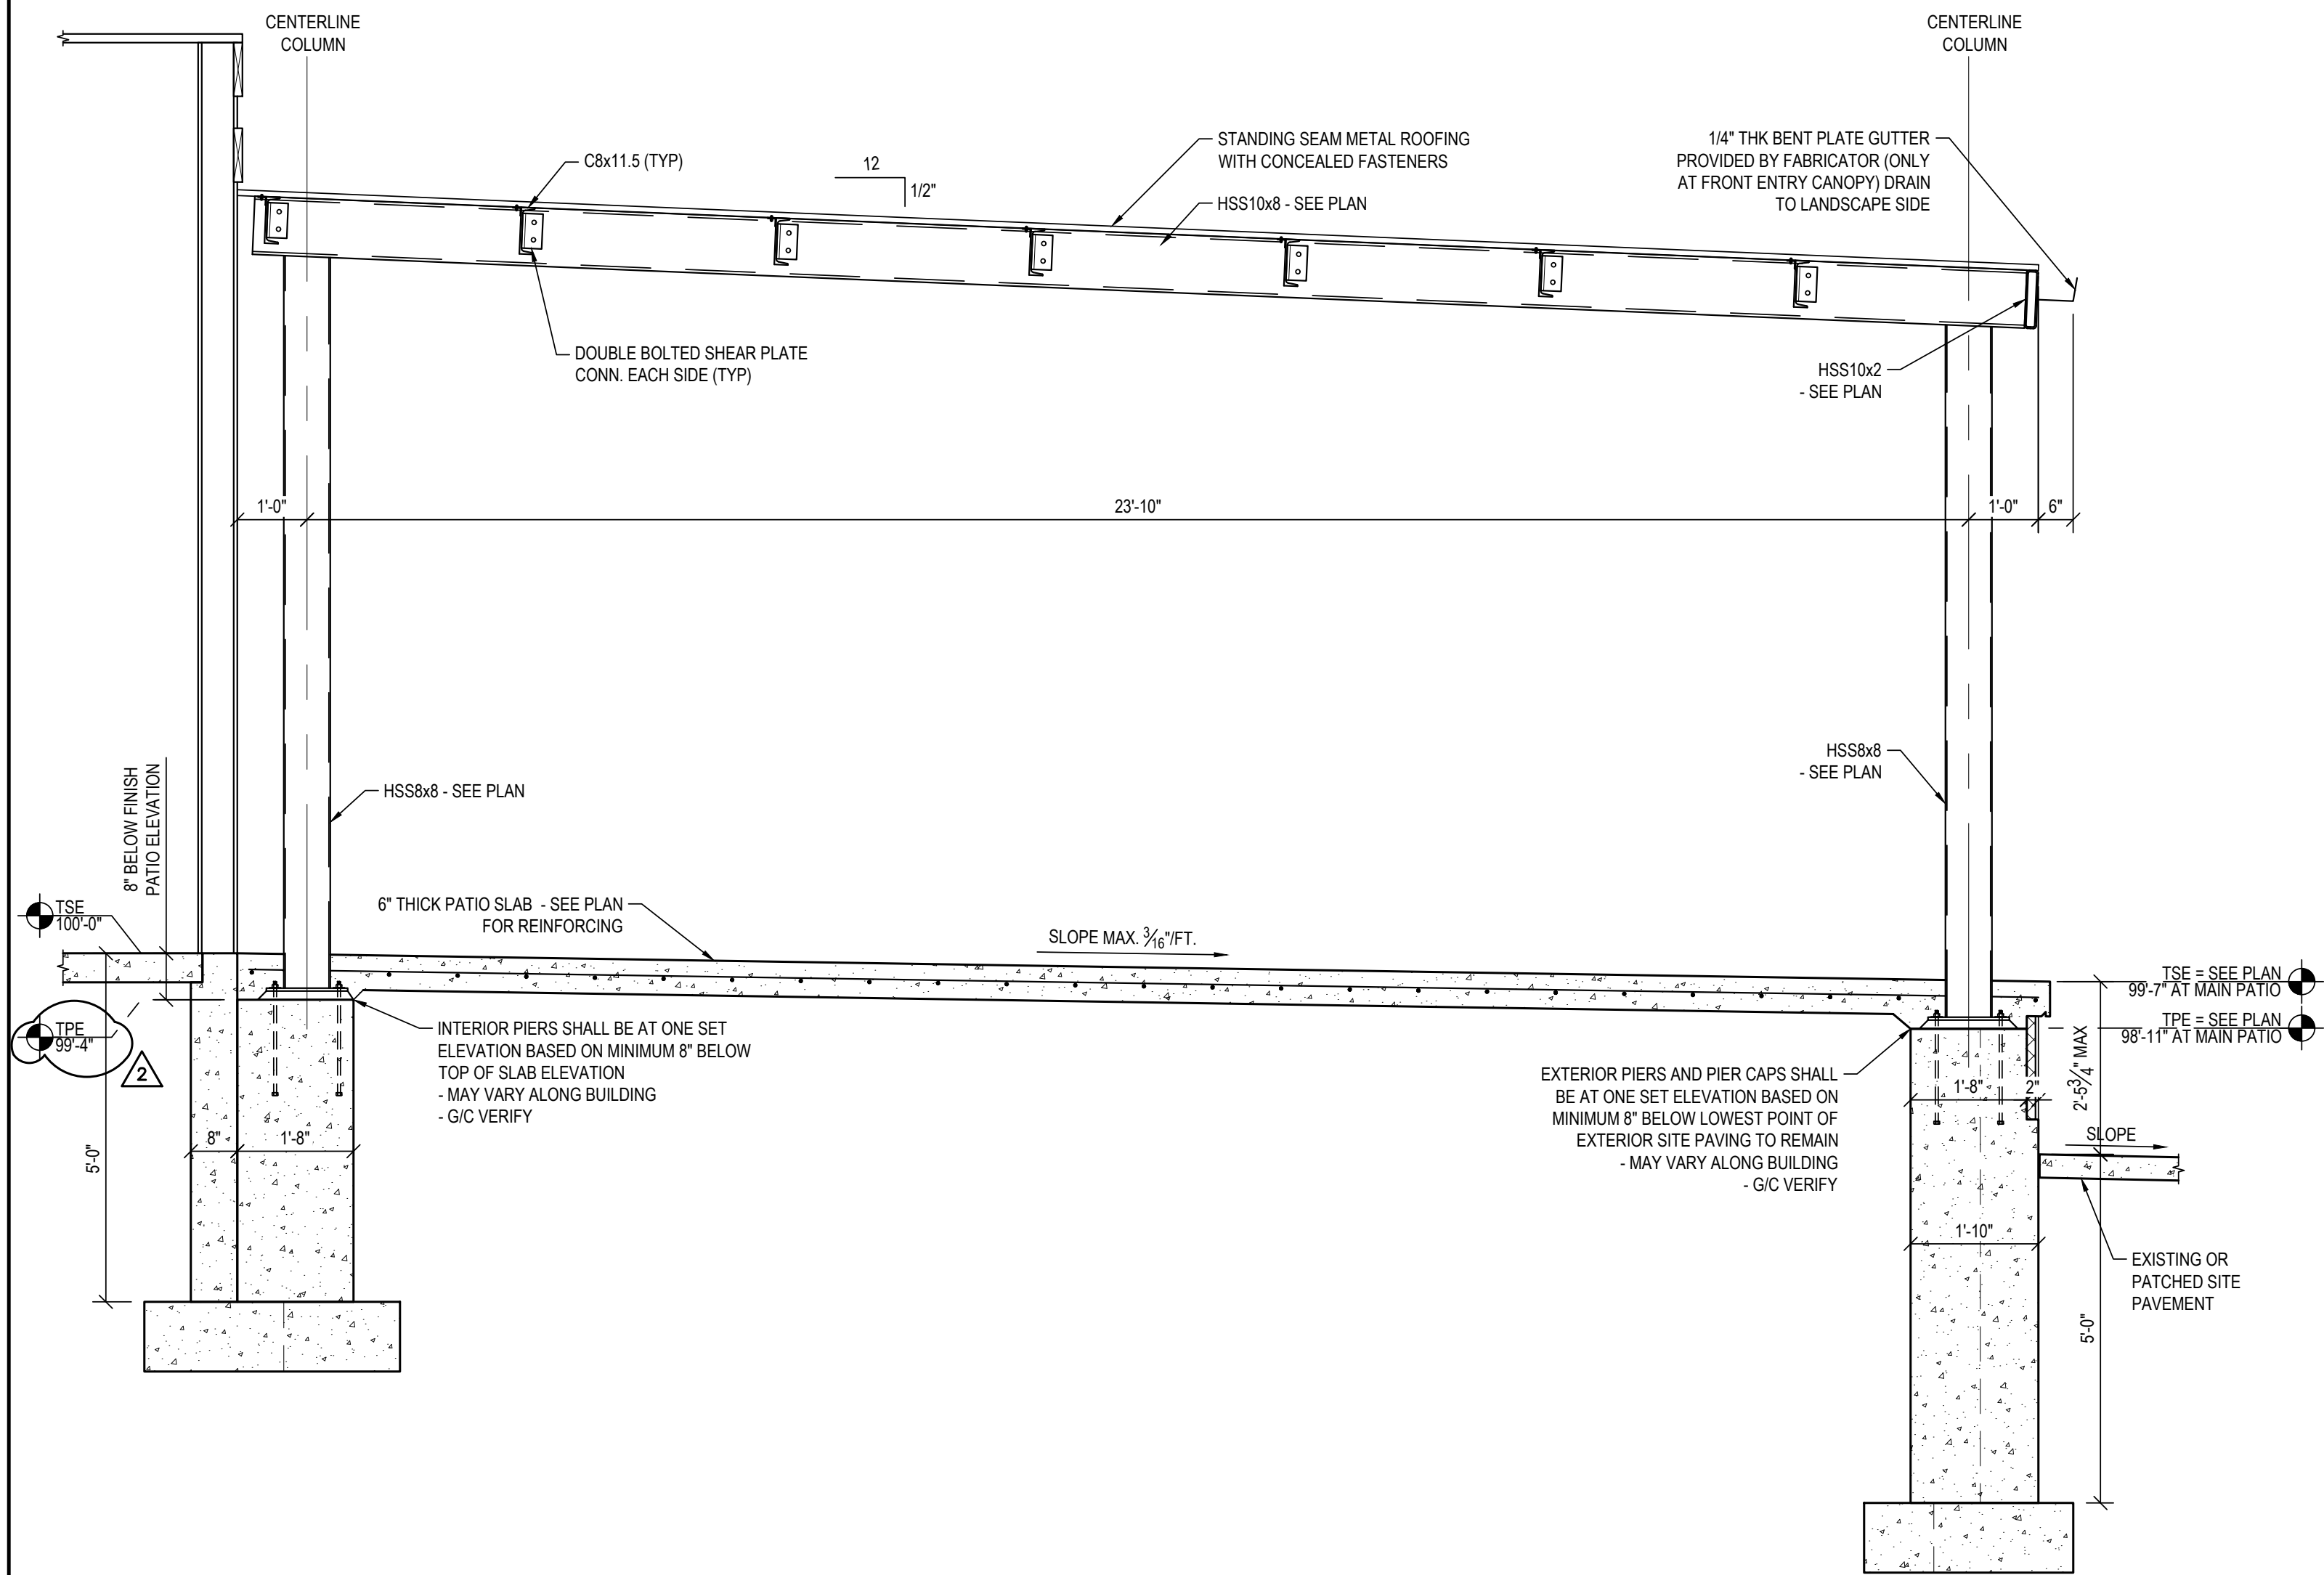

E SECTION THROUGH CANOPY
S504 ORIGINAL SCALE: 1/2" = 1'-0"

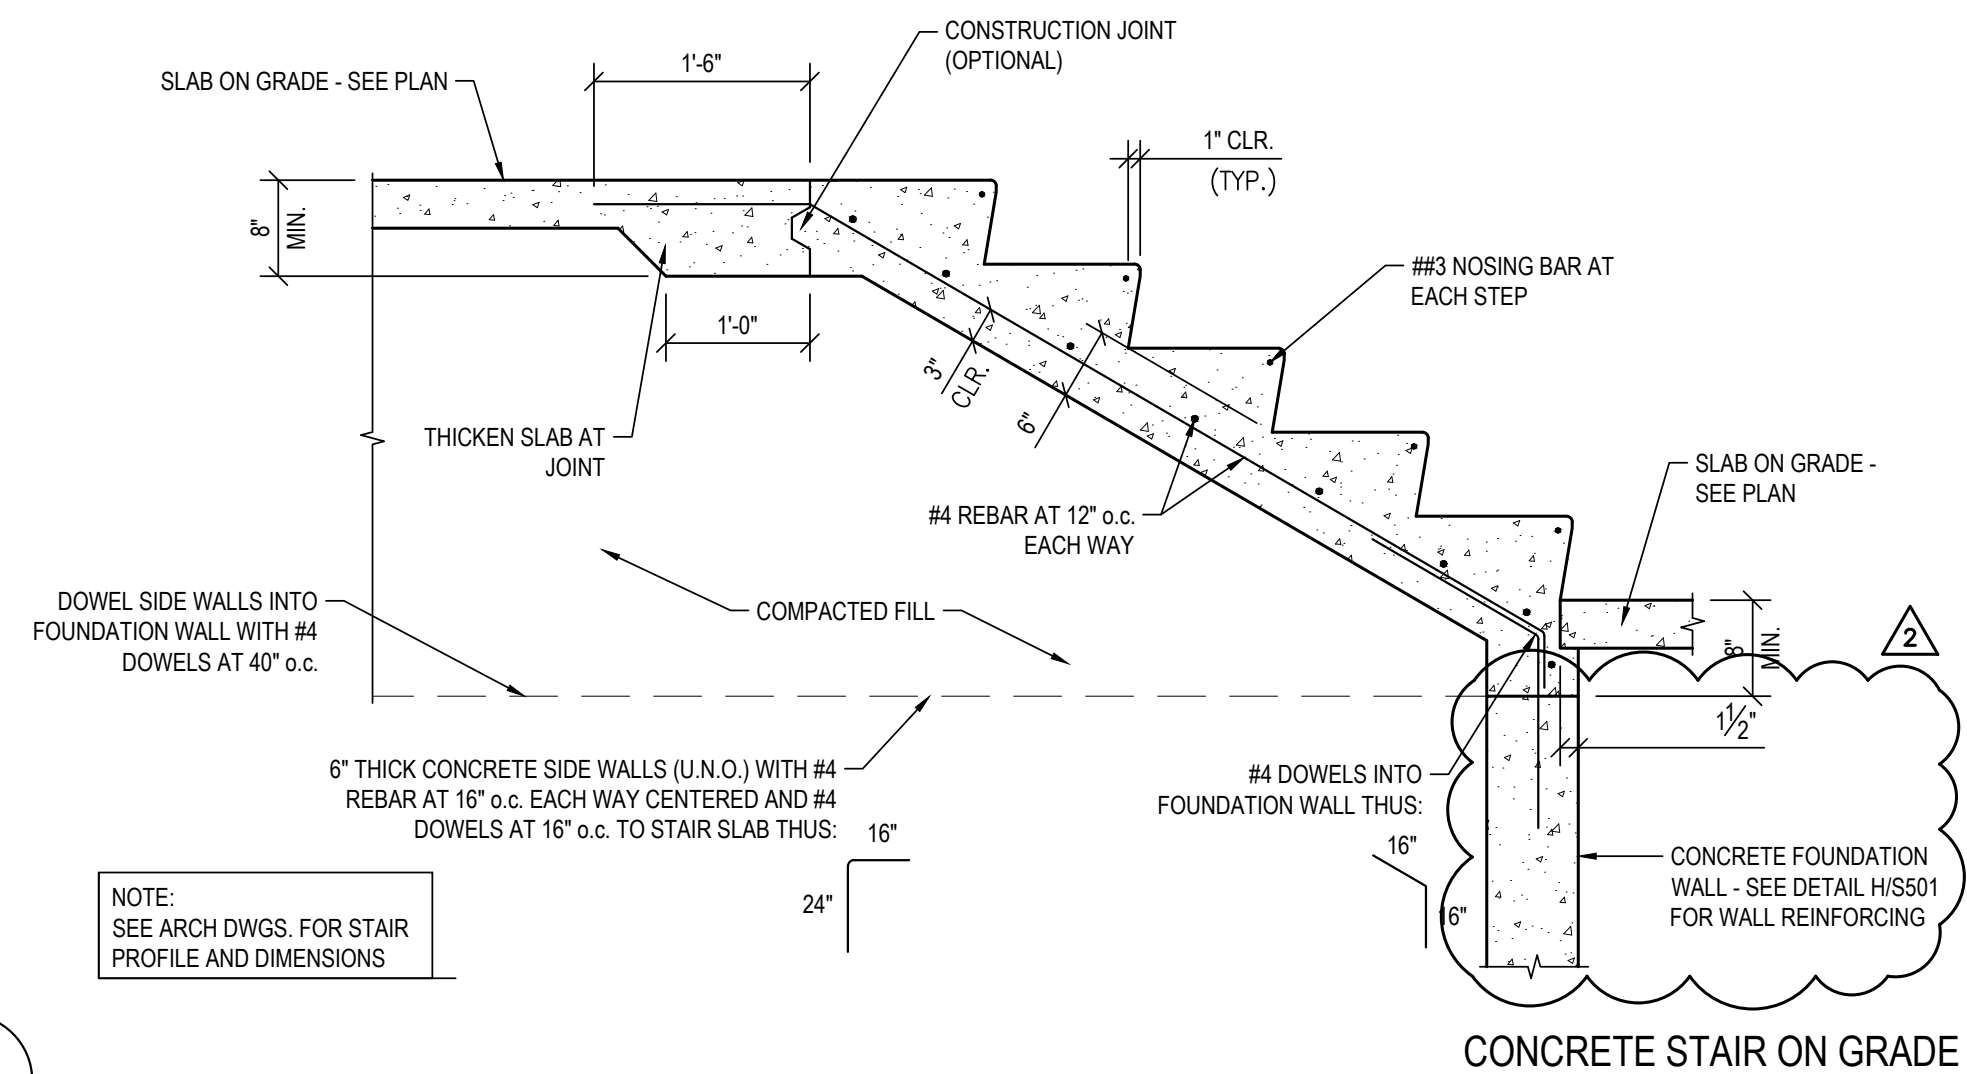

F CONCRETE STAIR ON GRADE
S504 ORIGINAL SCALE: 3/4" = 1'-0"

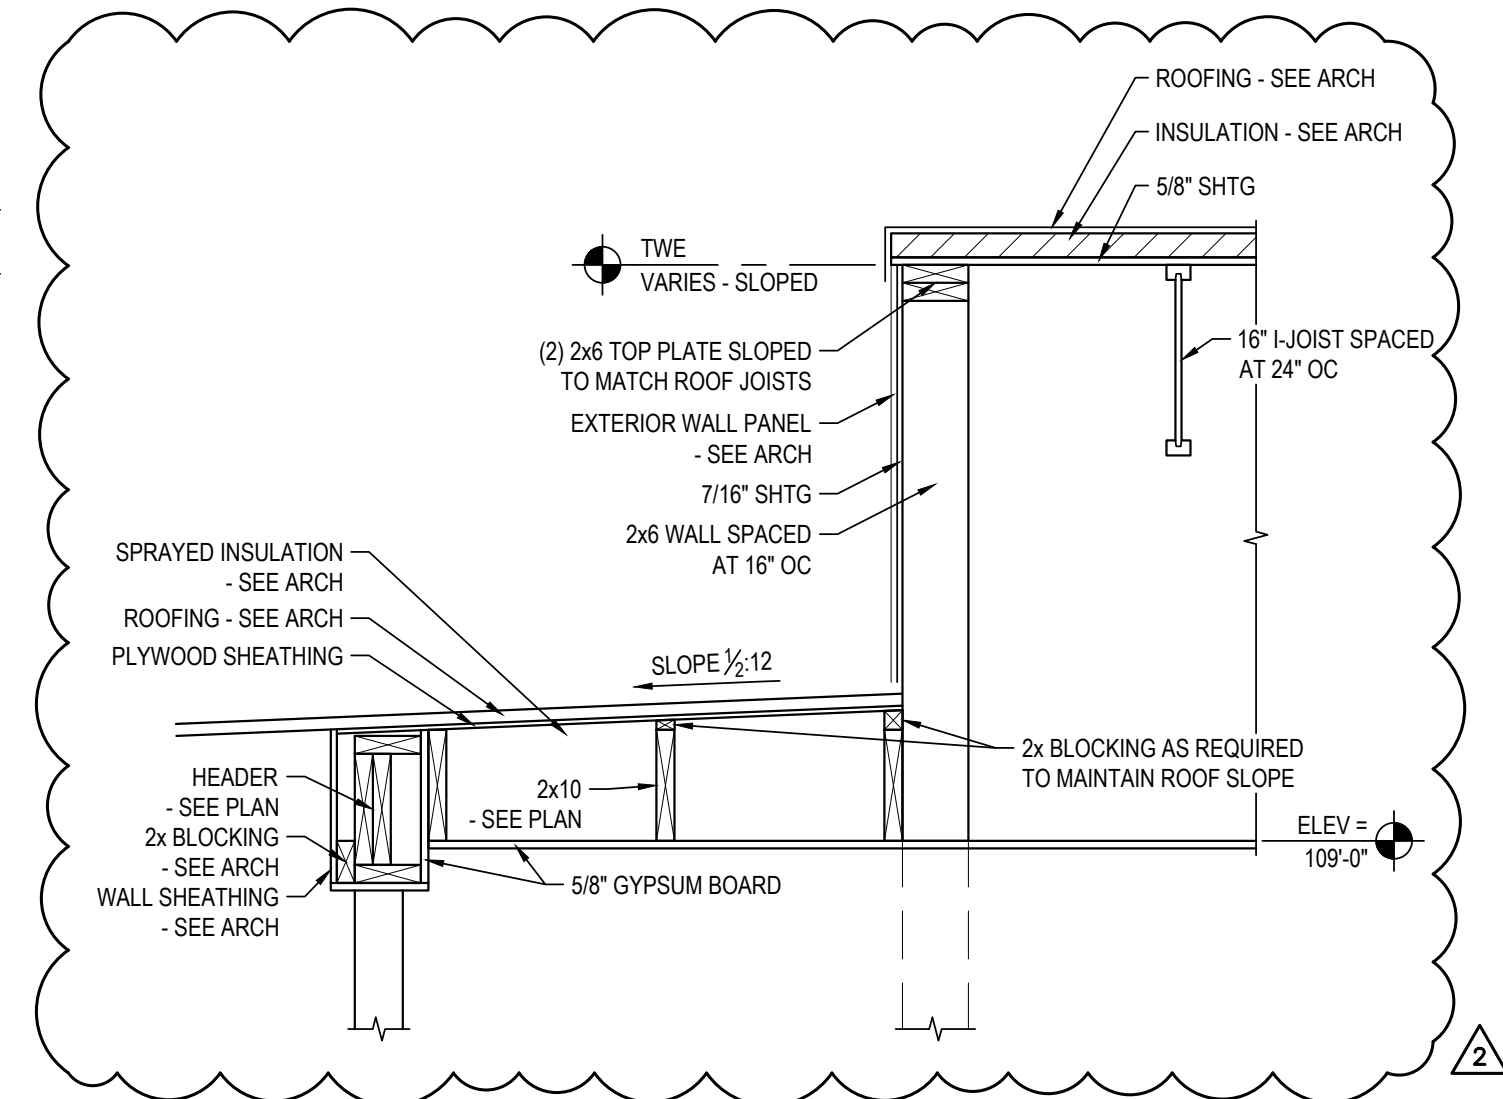

G VESTIBULE SECTION
S504 ORIGINAL SCALE: 3/4" = 1'-0"

△
ADDED SHEET AND REVISED SECTION THROUGH CANOPY



SEH

I HEREBY CERTIFY THAT THIS PLAN, SPECIFICATION, OR REPORT WAS PREPARED BY ME OR UNDER MY DIRECT SUPERVISION AND THAT I AM A DULY LICENSED ENGINEER UNDER THE LAWS OF THE STATE OF MINNESOTA.

B. C. Wolf
BERKAMIN A. WOLF
DATE 5.16.2023 LICENSE NO. 40807



DULUTH INTERNATIONAL AIRPORT

SKY HARBOR AIRPORT
2023 RECONSTRUCT TERMINAL BUILDING
DULUTH, MN

This drawing is an instrument of service and shall remain the property of Short Elliott Hendrickson, Inc. (SEH). This drawing, concepts and ideas contained herein shall not be used, reproduced, revised, or related without the express written approval of SEH.

Submission or distribution of this drawing to meet official or regulatory requirements or for purposes in connection with the project is not to be construed as publication in derogation of any of the rights of SEH.

SEH Project DULAL172133
Checked By BW
Drawn By JS

Project Status Issue Date
CONSTRUCTION PLANS 5.16.2023

REVISION SCHEDULE		
REV. #	DESCRIPTION	DATE
1	ADDENDUM #1	5.30.2023
2	ADDENDUM #2	6.2.2023

STRUCTURAL DETAILS

S504